

86980


STATE OF WISCONSIN

I NEAL SPERHAKE, do hereby certify that on the FIFTEENTH day of NOVEMBER, 1962, I established the NORTH ONE SIXTEENTH CORNER BETWEEN SECTIONS 24, TOWNSHIP 34 NORTH, RANGE 13EAST, AND, 19 TOWNSHIP 34 NORTH, RANGE 14 EAST, Fourth Principal Meridian, as described hereon.

Resident Witnesses:


Richard Piontek - Waubeno.
David Pichotta - Waubeno.

R13E

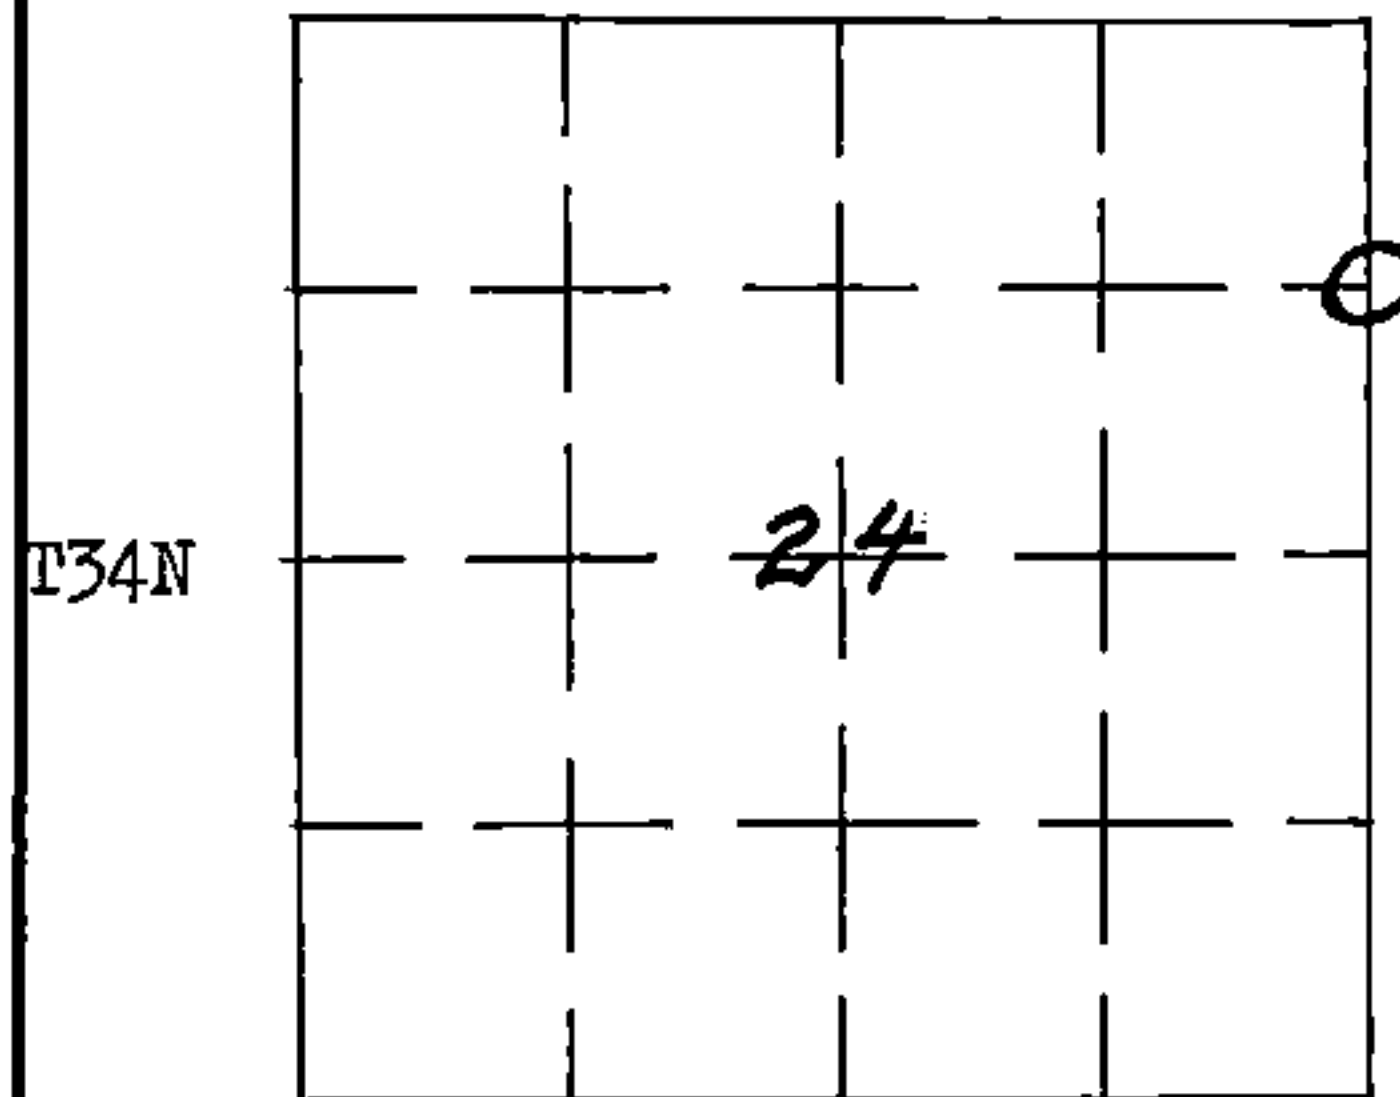

0 = Corner Monument Restored

REGISTER'S OFFICE
FOREST COUNTY, WIS.

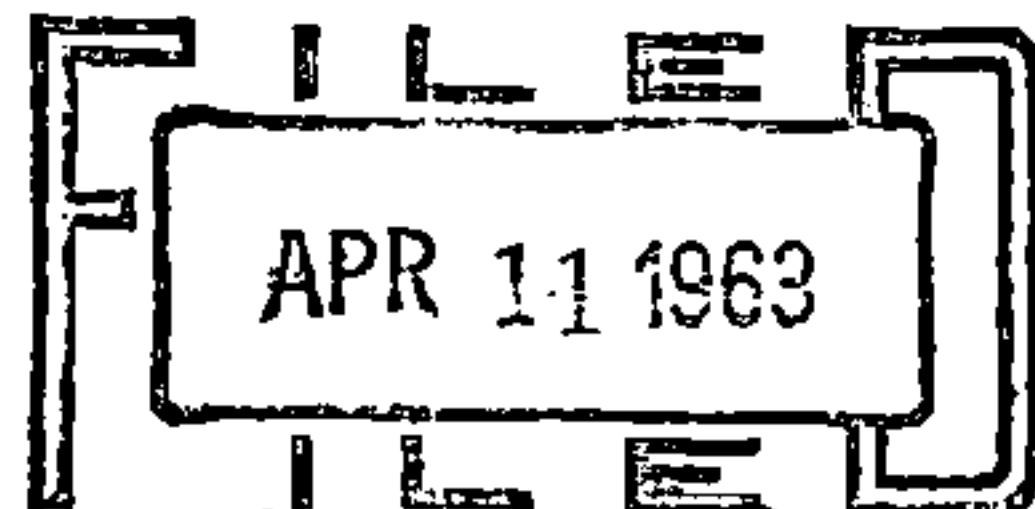

At 2 o'clock P.M.
Karl A. Unger Register of Deeds

This corner can also be described as either the North 1/8 th or the North Quarter-Quarter Section Corner between Section 24, T34N-R13E, and, 19, T34N-R14E, 4th P.M.

History.

There is no record of this corner having ever been previously established.

Description of monument and accessories I established to perpetuate the location of this corner.

At the point determined for the location of the corner I emplaced a:

"GALVANIZED IRON PIPE, THREE FEET LONG, ONE INCH IN DIAMETER, WITH AN ALUMINUM CAP DENOTED AS, 'KIMBERLY-CLARK CORP T34N N 1/16 BTWN 24 & 19 R13-14E SPERHAKE RLS 463 11-15-62".

The pipe is witnessed by:

Maple 6 N30°W 15 1/2 links. (Scribed S24 BT).
Basswood 8 N89°E 18 links. (Scribed S19 BT).

Description as to how corner was located.

Since both the quarter section corner one quarter mile south, and the section corner one quarter mile north have been previously located, with a distance between them of 40.12 1/2 chains, the 1/16th corner was set 20.06 1/4 chains from either corner, on a straight line between them.

Dated at _____, Wis., this _____ day of _____, 19____

Signature Neal Sperhake Title Registered Land Surveyor Registration No. S-463

~~Office of Register of Deeds~~, County of Forest, I hereby certify that the within instrument was ~~signed and sworn to~~ signed and sworn to on the 11th day of April, 19 63

at ~~xxx~~ xxxx ~~xxx~~ xx.

Adeline De Noble
Notary ~~(REGISTERED)~~ Public
Forest County, Wisconsin

~~My~~ My commission expires ~~xxxx~~ February 6, 1966

Surveyor's Seal

43413243000