

CERTIFIED LAND CORNER RESTORATION

Index No. V-35

State of Wisconsin }
County of Forest } ss.

History of original corner establishment:



I Thomas R. Arnett, do hereby certify that on the 18th day of September, 19 75, I found evidence of the M.C. corner of sections 30 & 31 on Pikerel Lake West end of section line Township 34, North, Range 13 E, Fourth Principal Meridian, as described hereon; and that from this evidence I established a new monument and accessories as described hereon to perpetuate the original location of this corner.

Description of corner evidence found:

1 3/4" iron pipe with brass cap set by General Land Office in 1928
1 1/2" iron pipe found

Resident witnesses:

Herbert Wagoner


Description of monument and accessories I established to perpetuate the original location of this corner.

Left monument set by Gen. Land Office

Ties:

Hemlock	16	N64W	3.76 feet	(lawn tree no BT blaz
Hemlock	12	N60 1/2 E	19.13 feet	(lawn tree no BT blaz
Hemlock	8	S11W	15.02 feet	(lawn tree no BT blaz

FORM 985 H. C. MILLER CO., MILWAUKEE.

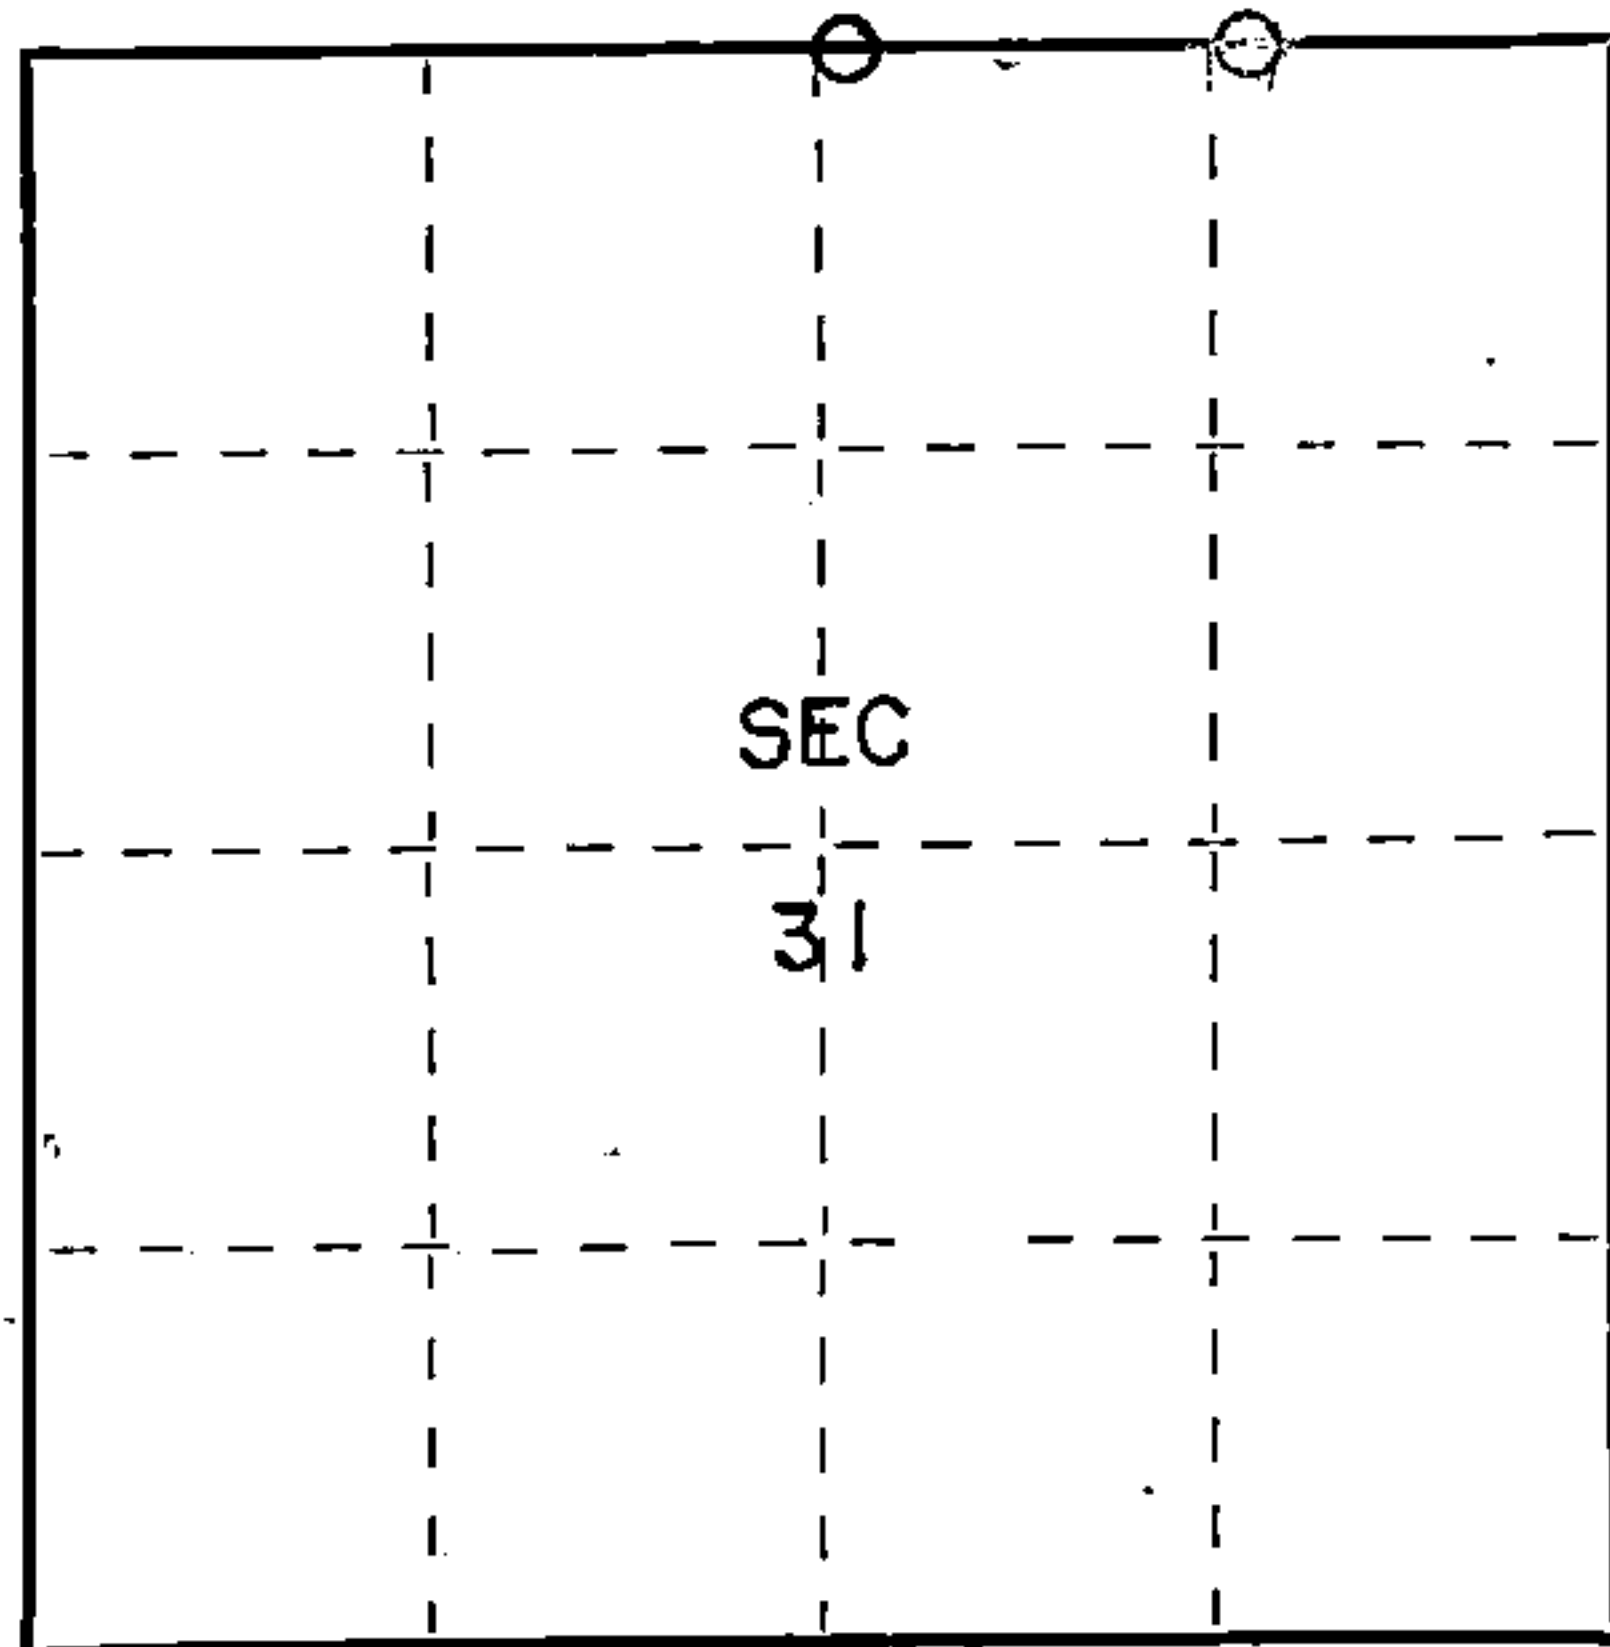

○ = Corner monument restored.

Dated at Crandon, Wis., this 11th day of November, 1975.

Signature Thomas R. Arnett Title Land Surveyor Registration No. S-887
(County Surveyor, Registered Land Surveyor, or other duly authorized official)

Office of Register of Deeds, County of Forest, I hereby certify that the within instrument was filed in this office for record on the 11th day of November, 1975 at 4 o'clock P.M.

Eugene Stutzman Document Number 108209
(Register of Deeds)

By _____ Deputy

43413300019