


**ORIGINAL ON FILE IN CO CLERK'S OFFICE
COPY HERE FOR REFERENCE**


FIELD SURVEY NOTES
PRESERVATION OF LANDMARKS
(Pursuant to Section 59.635(7) Wisconsin Statutes
E-D-707-69

State of Wisconsin / Department of Transportation


COUNTY FOREST		
TOWN FREEDOM, WAPENO		
HIGHWAY STN 32		
SECTION 1	TOWNSHIP T 34 N	RANGE R 14 E
TYPE OF LANDMARK R.R. SPIKE & AGREES WITH USFS		

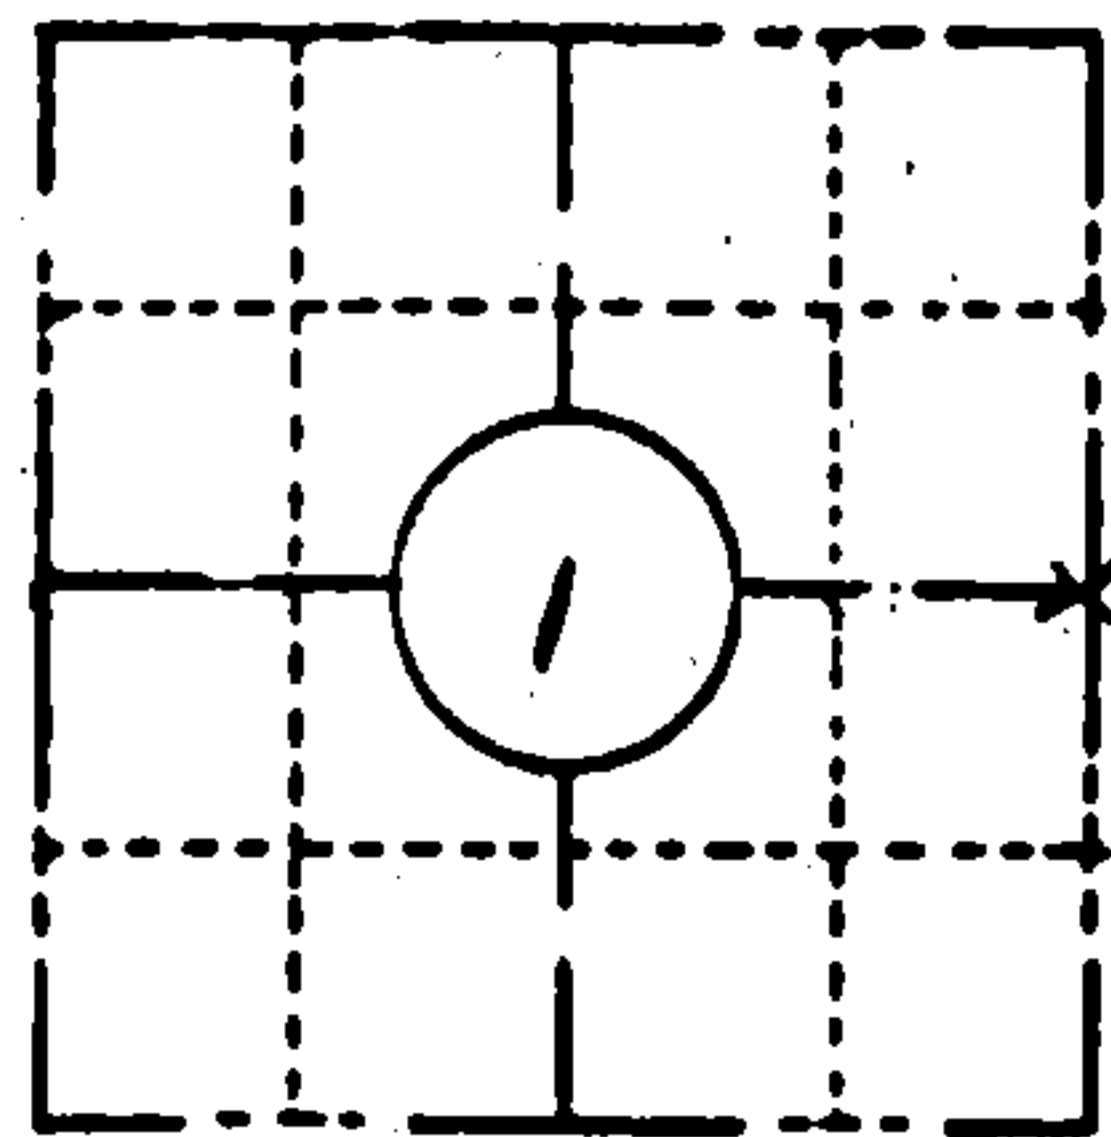

LOCATION SKETCH
(Location of landmark indicated by "x")

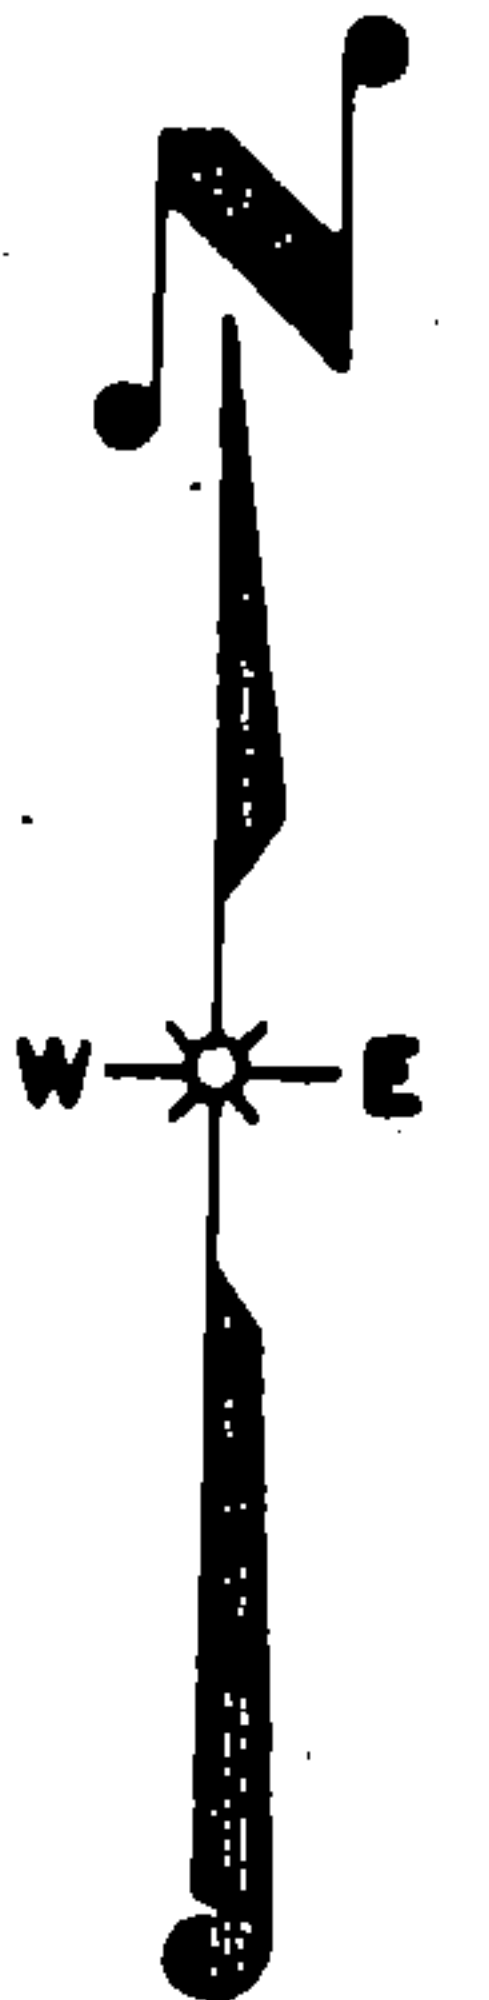

This space for copy of field notes or ties to the above described landmarks
REFERENCE MONUMENTS.

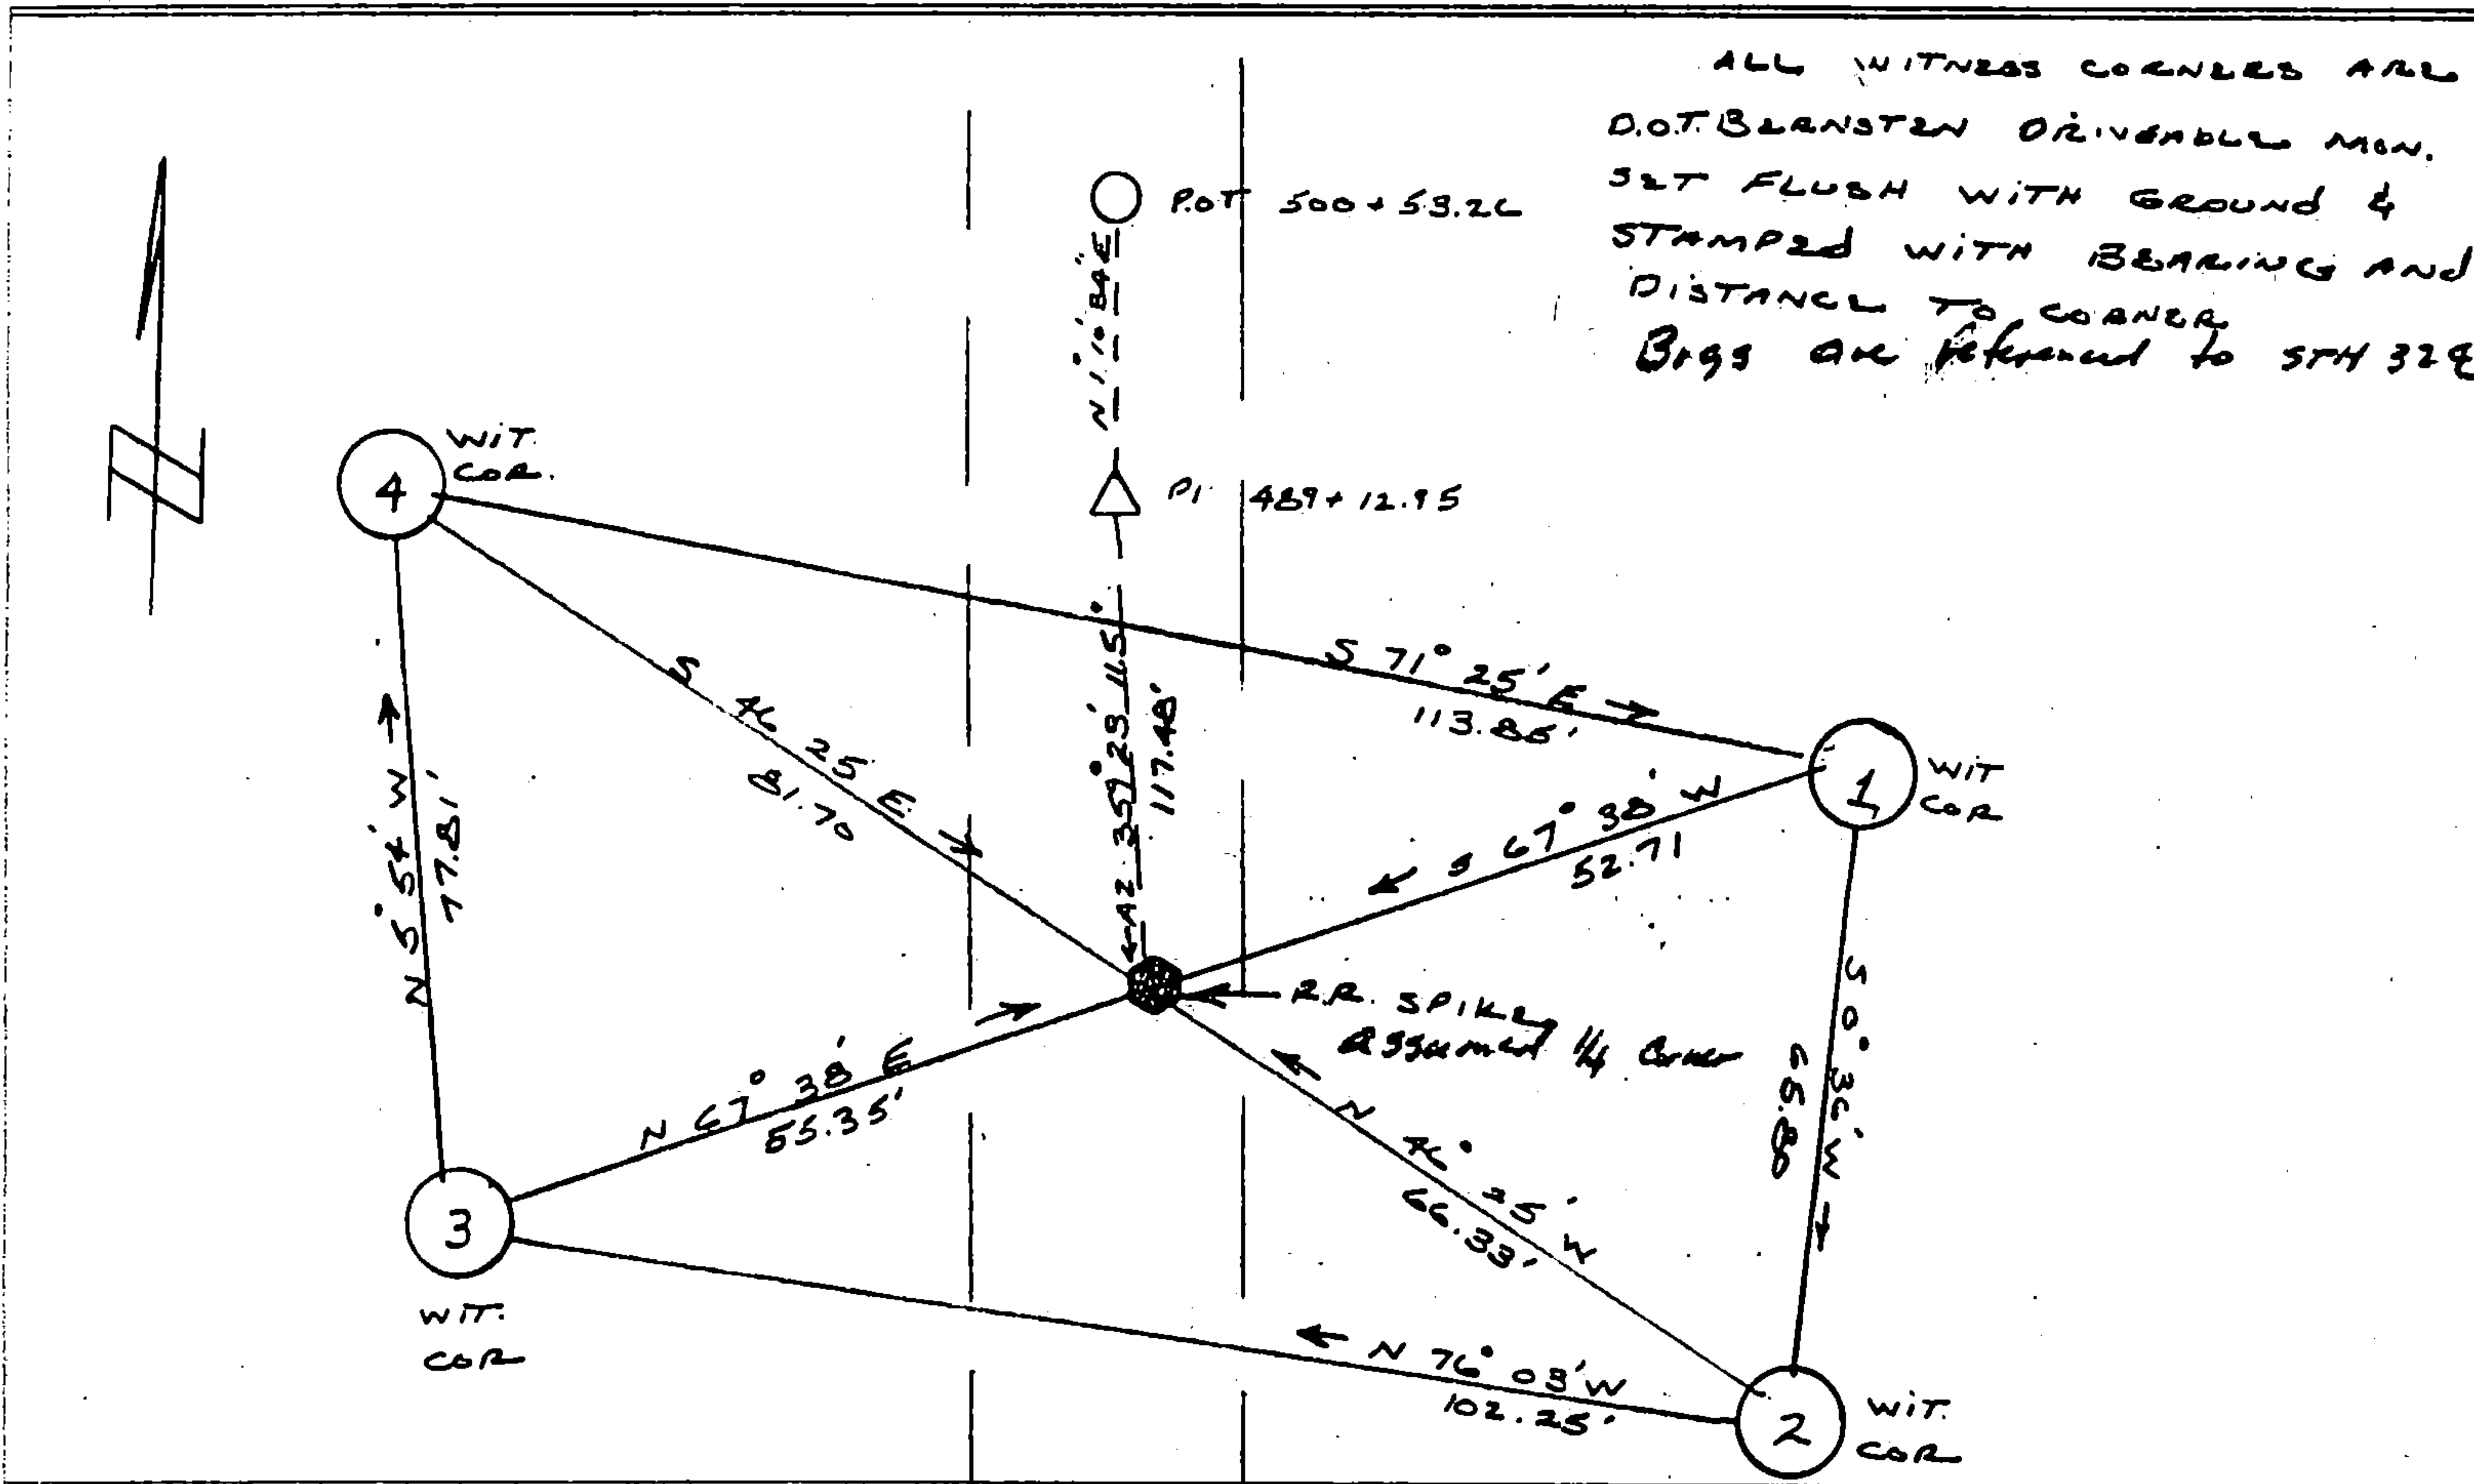

FILED UNDER PROJECT 9131-03-70			COUNTY CLERK'S OFFICE COUNTY OF Forest WISCONSIN } 55	
DISTRICT OFFICE NUMBER 03-07	CITY RHINELANDER	COUNTY ONEIDA	DATE RECEIVED FOR RECORD 7-10-85	DATE COPY SENT TO COUNTY SURVEYOR N/A
LOCATED OR ESTABLISHED BY NAME ROBERT B. JOHNSON			SIGNATURE OF COUNTY CLERK Dora C. James	
TITLE SURVEY CREW CHIEF DATE 5-20-85 <i>Under the direct supervision of MICHAEL HESS 502899</i>				