

CERTIFIED LAND CORNER RESTORATION

State of Wisconsin }
County of Forest } ss.

I Jean F. Resvick, do hereby certify that on the 5th day of May, 1978, I found evidence of the West quarter corner of Section 2 Township 34 North Range 14 East, Fourth Principal Meridian, as described hereon; and that from this evidence I established a new monument and accessories as described hereon to perpetuate the original location of this corner:

Description of original monument and accessories and subsequent restorations:

Surveyed in 1859 by James McBride
South corrected between Sections 2 and 3, 38.5 chains set quarter corner post.
Hemlock 10, N20E, 9 links
Hemlock 6, S43W, 15 links
N.H. Smith in 1923 replaced old post with iron stake in road.

Description of corner evidence found:


At road intersection north, south, west and fence east found iron stake, 14 inches long, 1 1/4 inches in diameter

Description of monument and accessories I established to perpetuate the location of this corner:

Replaced iron stake with 2 inch, inside diameter, galvanized iron pipe, 3 feet long, filled with concrete, with brass cap stamped:
T34N, R14E, 1/4, S3, S2, 1978, S-802

Blazed and scribed the following bearing trees:

Maple 13, N71E, 49.80 feet
Maple 19, S20E, 45.71 feet
Maple 9, S47W, 117.39 feet
Northeast corner of house bears N55W
Monument 0.8 feet below surface of road.

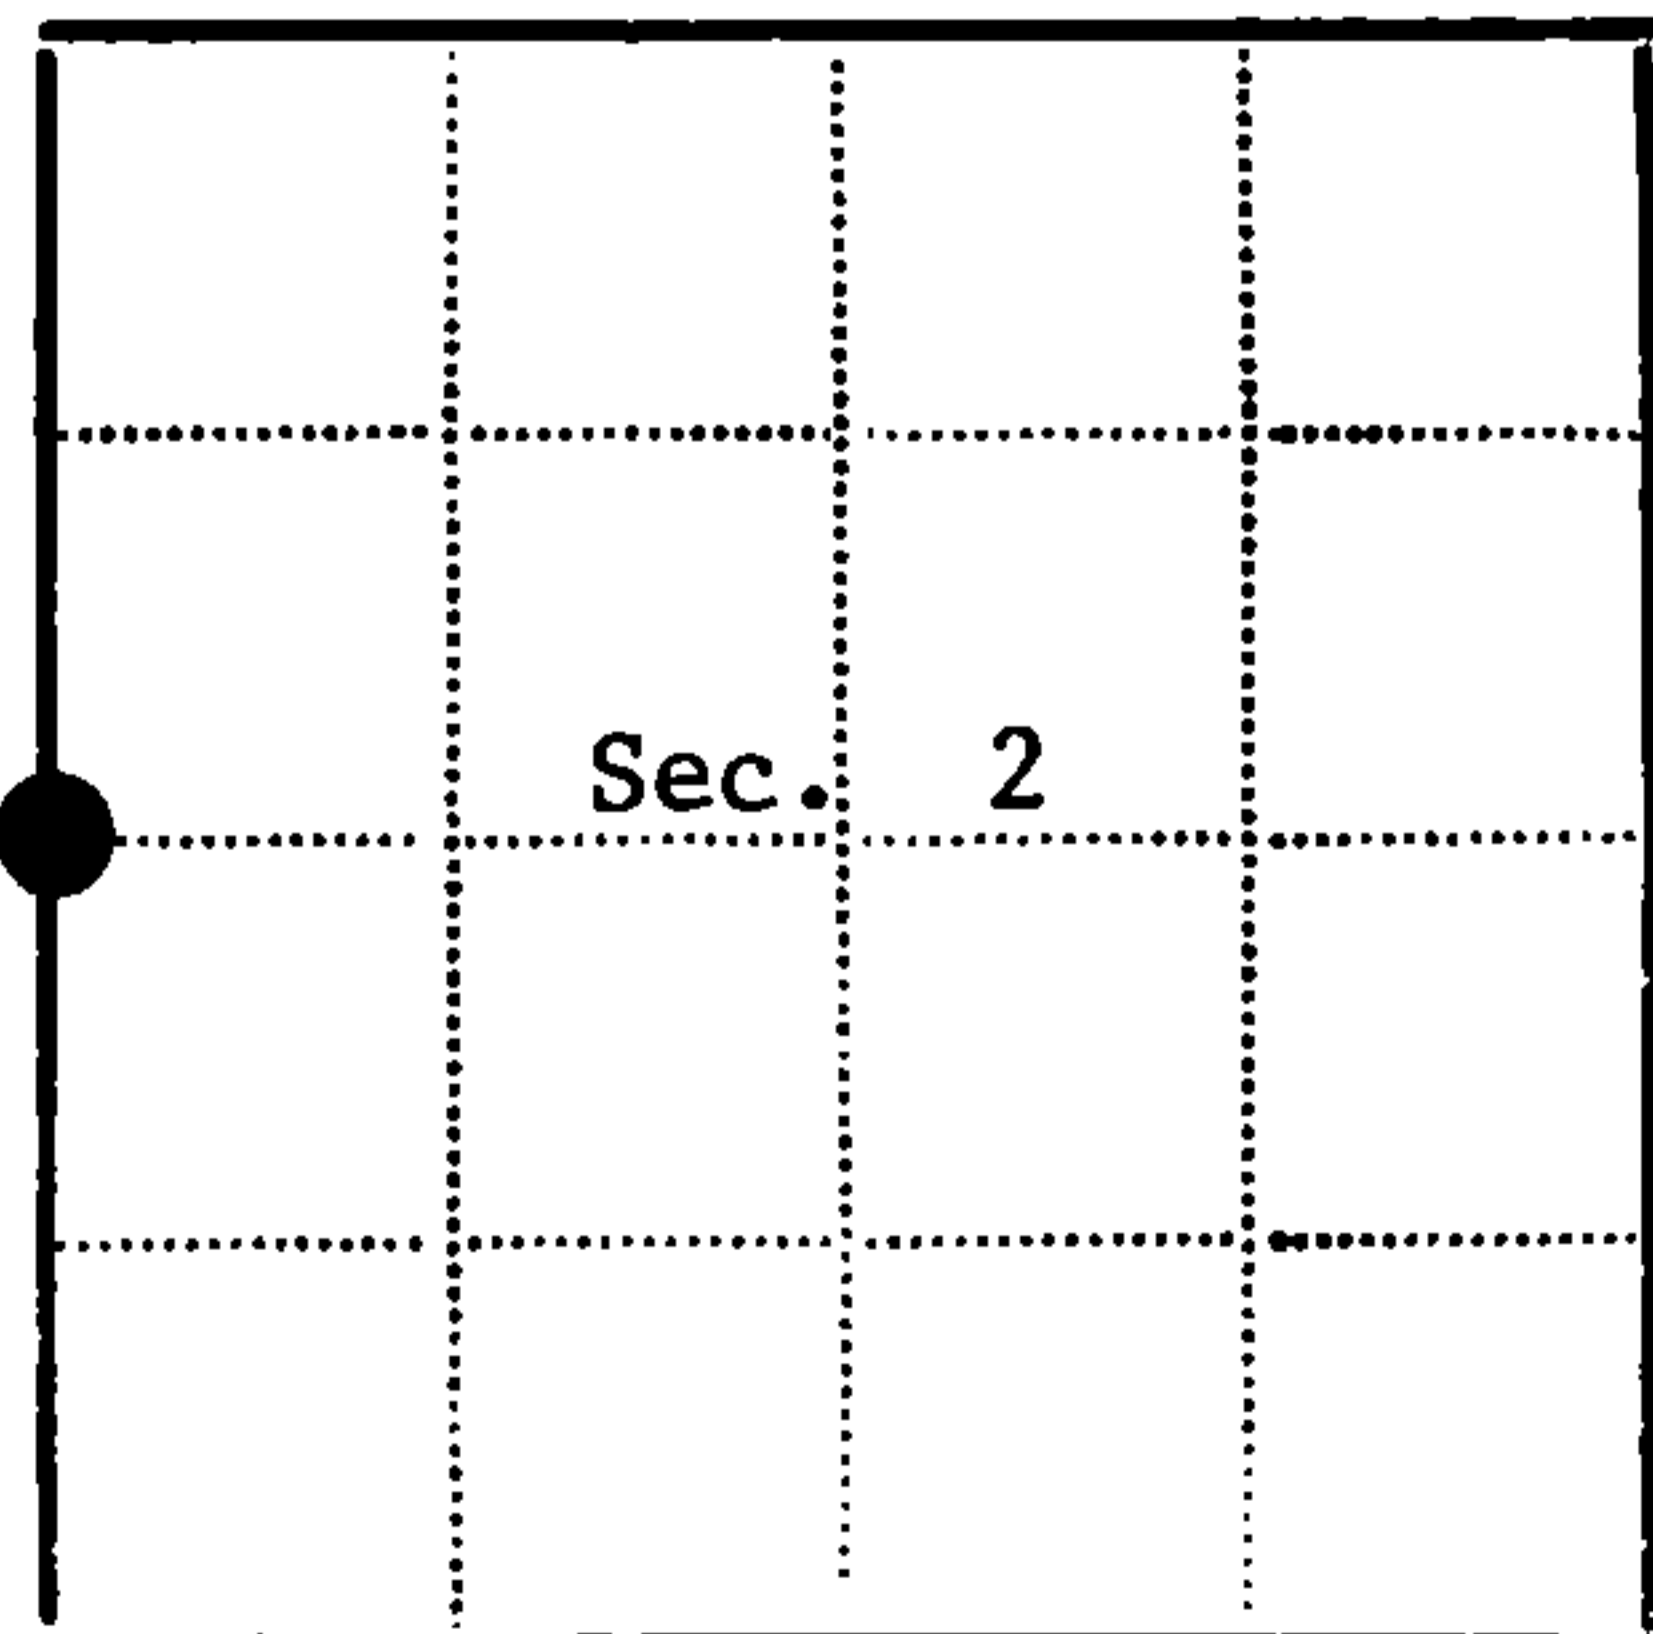

● - Corner monument restored
□ -

Resident witnesses.....

Dated at Rhinelander Wisconsin, this 17 day of May 1978....

Signature *Jean F. Resvick* Title Land Surveyor
(County Surveyor, Registered Land Surveyor, or other duly authorized official)

Surveyors Registration No. S-802 DOCUMENT NUMBER 114054

Office of Register of Deeds County of Forest

I hereby certify that the within instrument was filed in this office for record on the 20th day of June 1978, and was filed in Book No. Page No. of County Records.

Signature *Eugene Stutzman* Title Register of Deeds

Township 34 North Range 14 East Section 2 Index No. C-17 Page No.

C-17