

CERTIFIED LAND CORNER RESTORATION

Index No. **E 9**


State of Wisconsin }  
County of Forest } ss.

I, Jean F. Resvick, do hereby certify that on the 3rd day of June, 19 64, I found evidence of the Northeast section corner of Section 8 Township 34, North, Range 14 East, Fourth Principal Meridian, as described hereon; and that from this evidence I established a new monument and accessories as described hereon to perpetuate the original location of this corner.

Resident witnesses:

David Seaberg

Stanley Novak

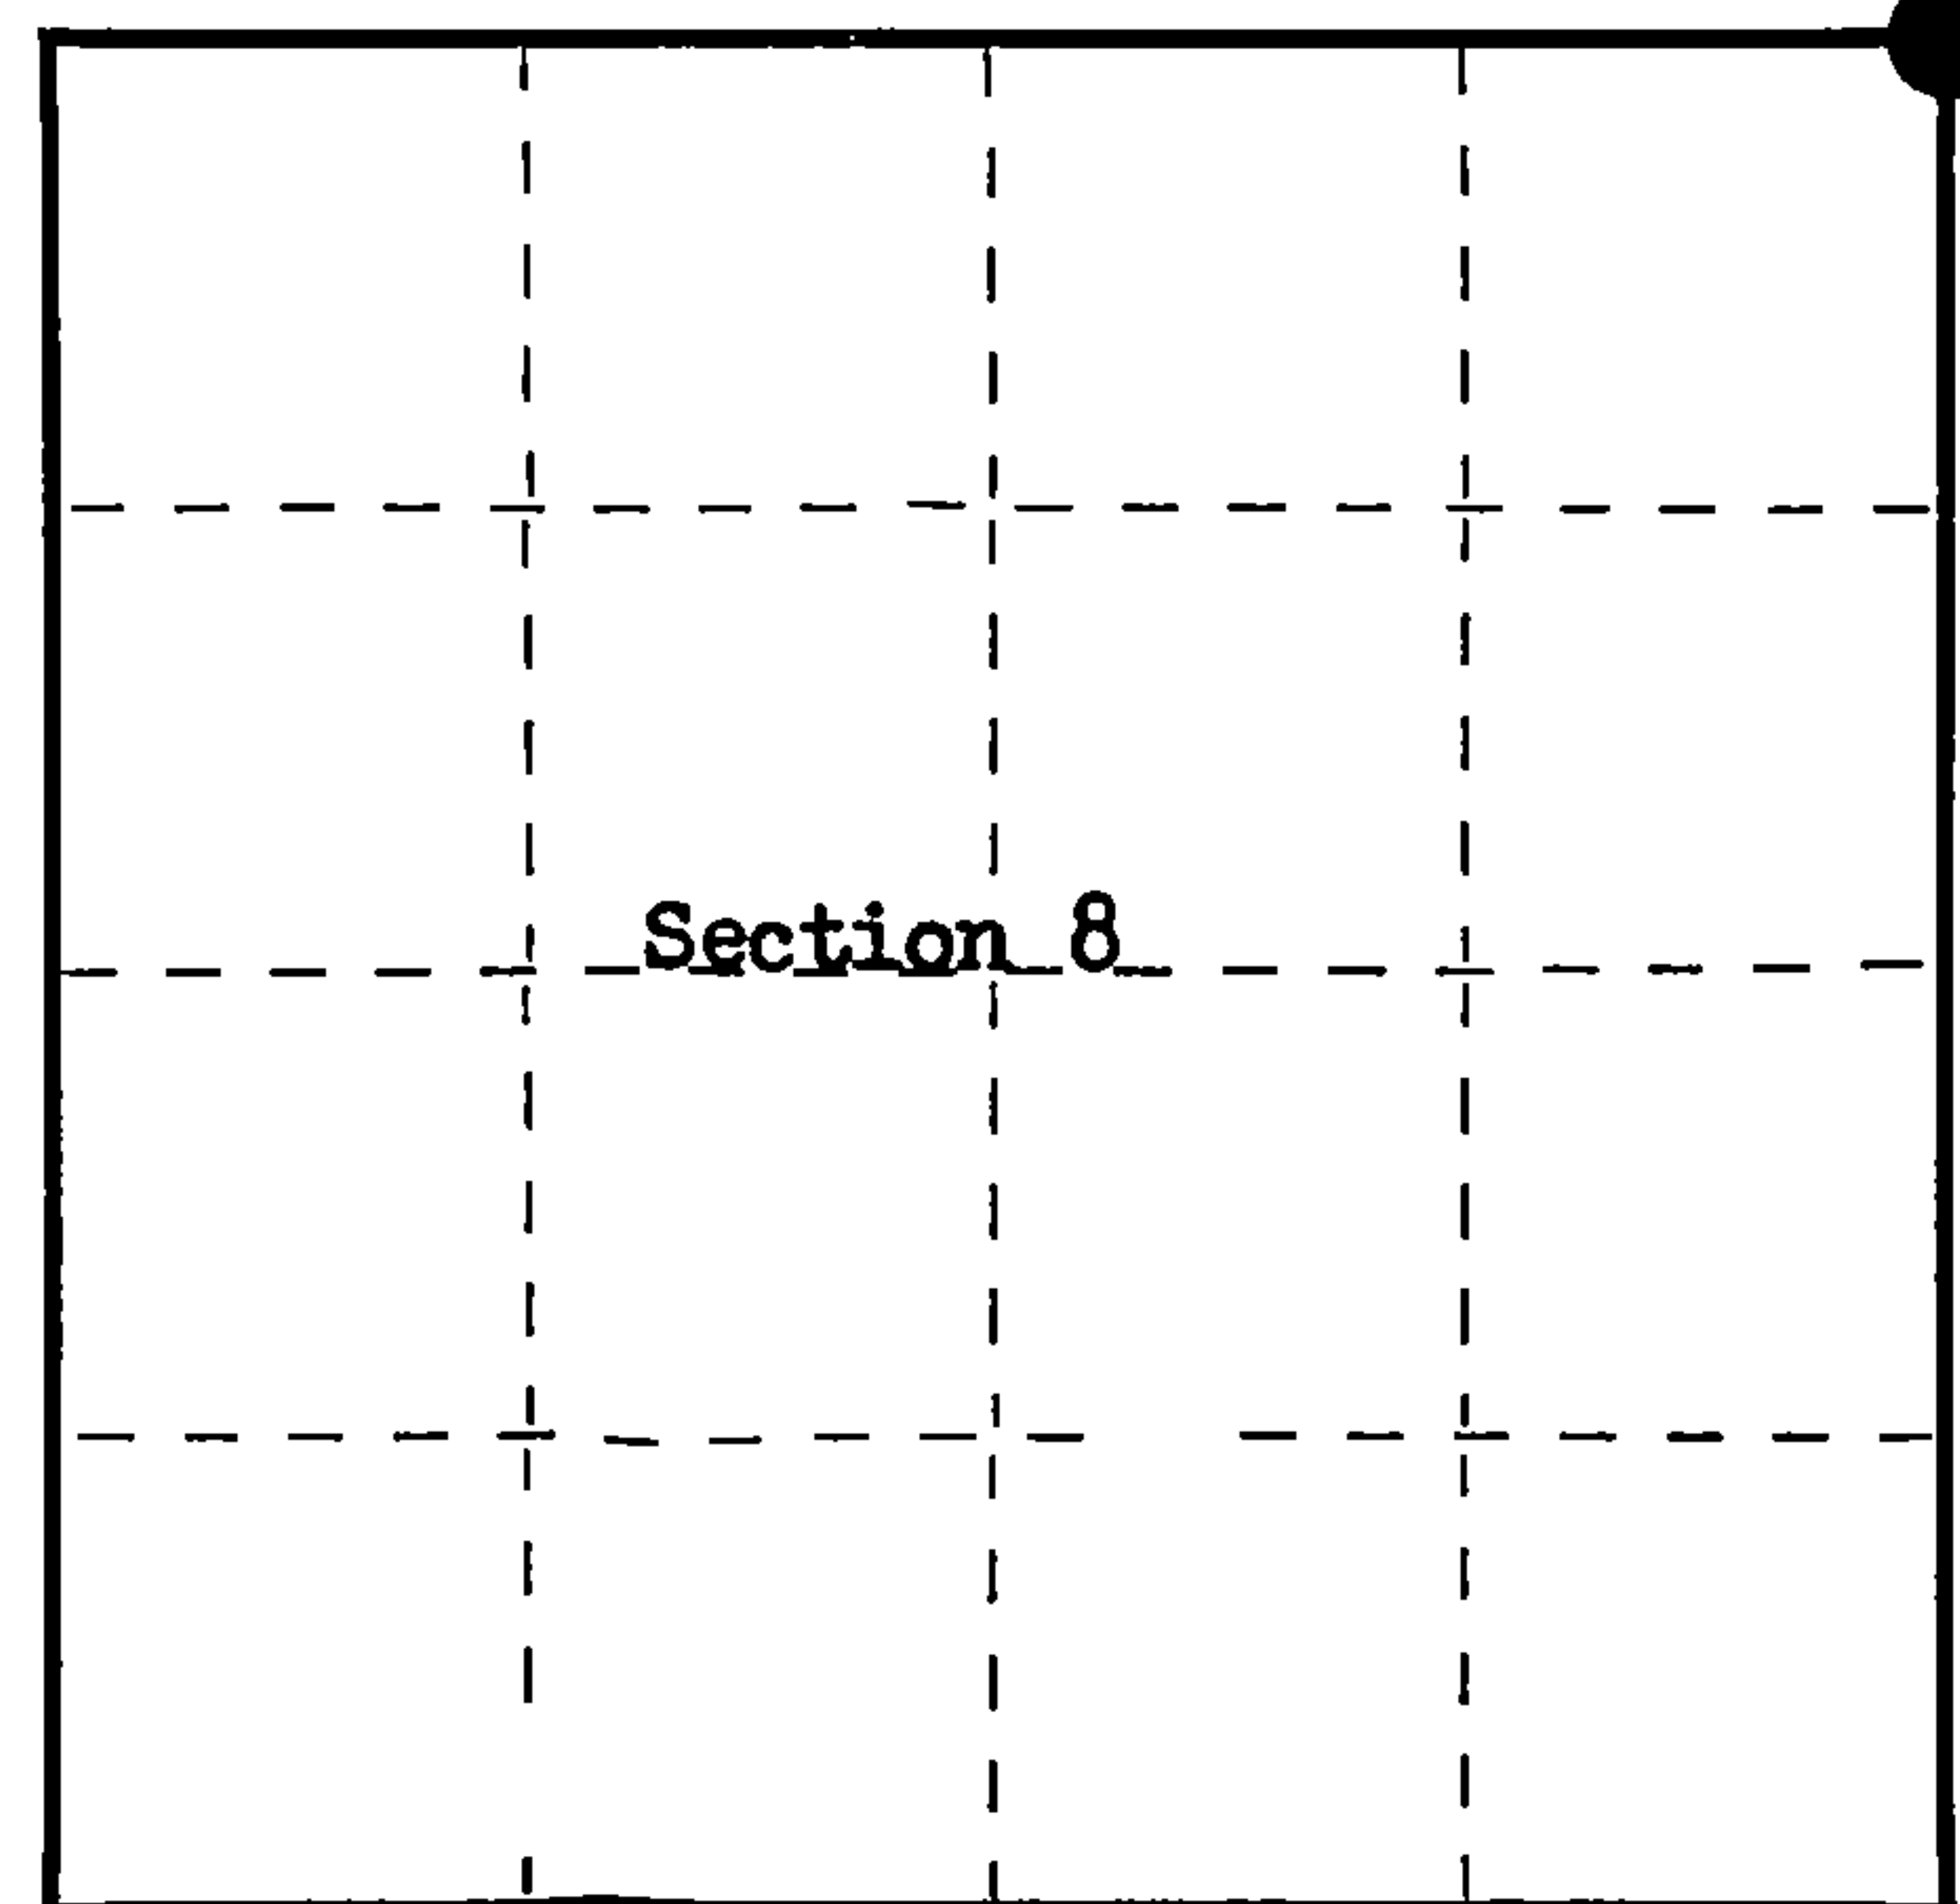

○ = Corner monument restored.

History of original corner establishment:


Survey in 1859 by James McBride  
80.00 chains north between Sections 8 & 9 set post  
Hemlock 10", N5°E, 57 lks.  
Hemlock 10", S60°E, 70 lks.  
Birch 12", S12°W, 51 lks.  
Ironwood 8", N28°W, 44 lks.

Description of corner evidence found:

Post set by D. Seaberg to mark point of post found in 1962  
Hemlock stump and fallen snag, 15", S60°E, 46.2 feet, old face blaze  
Hemlock stump 14", N5°E, 37.60 ft.

Description of monument and accessories I established to perpetuate the original location of this corner.

Replaced post with 2-inch inside diameter galvanized iron pipe flanged at bottom, filled with concrete, with brass cap stamped:

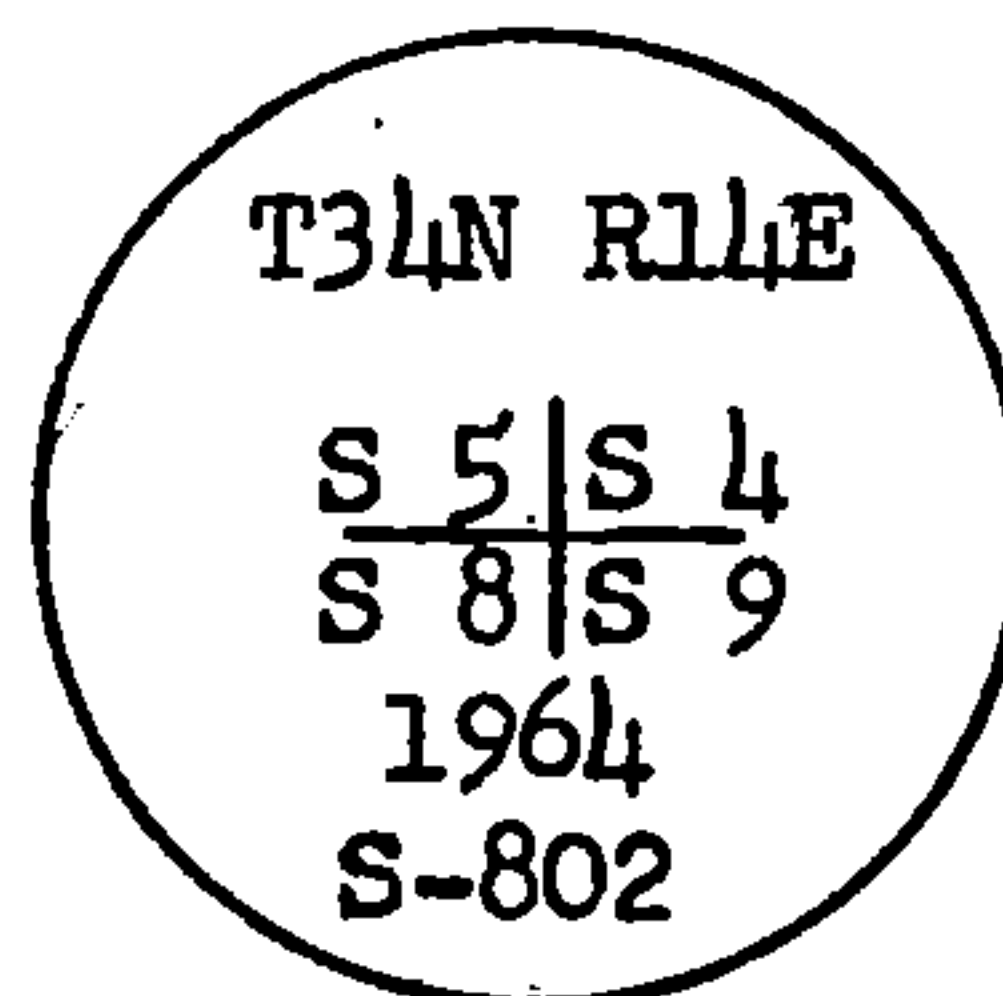

from which the following blazed and scribed bearing trees bear:

Maple 5", S13°E, 17.65 ft. (26.74 lks)  
Maple 6", S54°W, 35.82 ft. (54.27 lks)  
Cherry 4", N50°W, 19.75 ft. (29.92 lks)  
Maple 3", N49°E, 32.20 ft. (48.79 lks)

Dated at Rhineland, Wis., this 3rd day of August, 19 64

Signature Jean F. Resvick Title Cadastral Surveyor Registration No. S-802  
(County Surveyor, Registered Land Surveyor, or other duly authorized official)

Office of Register of Deeds, County of Forest, I hereby certify that the within instrument was filed in this office for record on the 21 day of Oct., 19 64 at 11 o'clock A. M. Doc. #89305 Vol. 1 Page **E-9 CORNER RESTORATIONS**

Anna Peterson  
(Register of Deeds)

By \_\_\_\_\_ Deputy

FORM 985 H. C. MILLER CO., MILWAUKEE

000050HH2H