


R.O.D.

U. S. PUBLIC LAND SURVEY MONUMENT RECORD

INSTRUCTIONS: This record shall show the location of the corner and shall include all of the following nine elements (a through i).

- (a) Identify the corner by reference to the U.S. public land survey system.
- = Corner monument restored.

Quarter Corner to Sections 9 and 10, T.34N., R.14E.

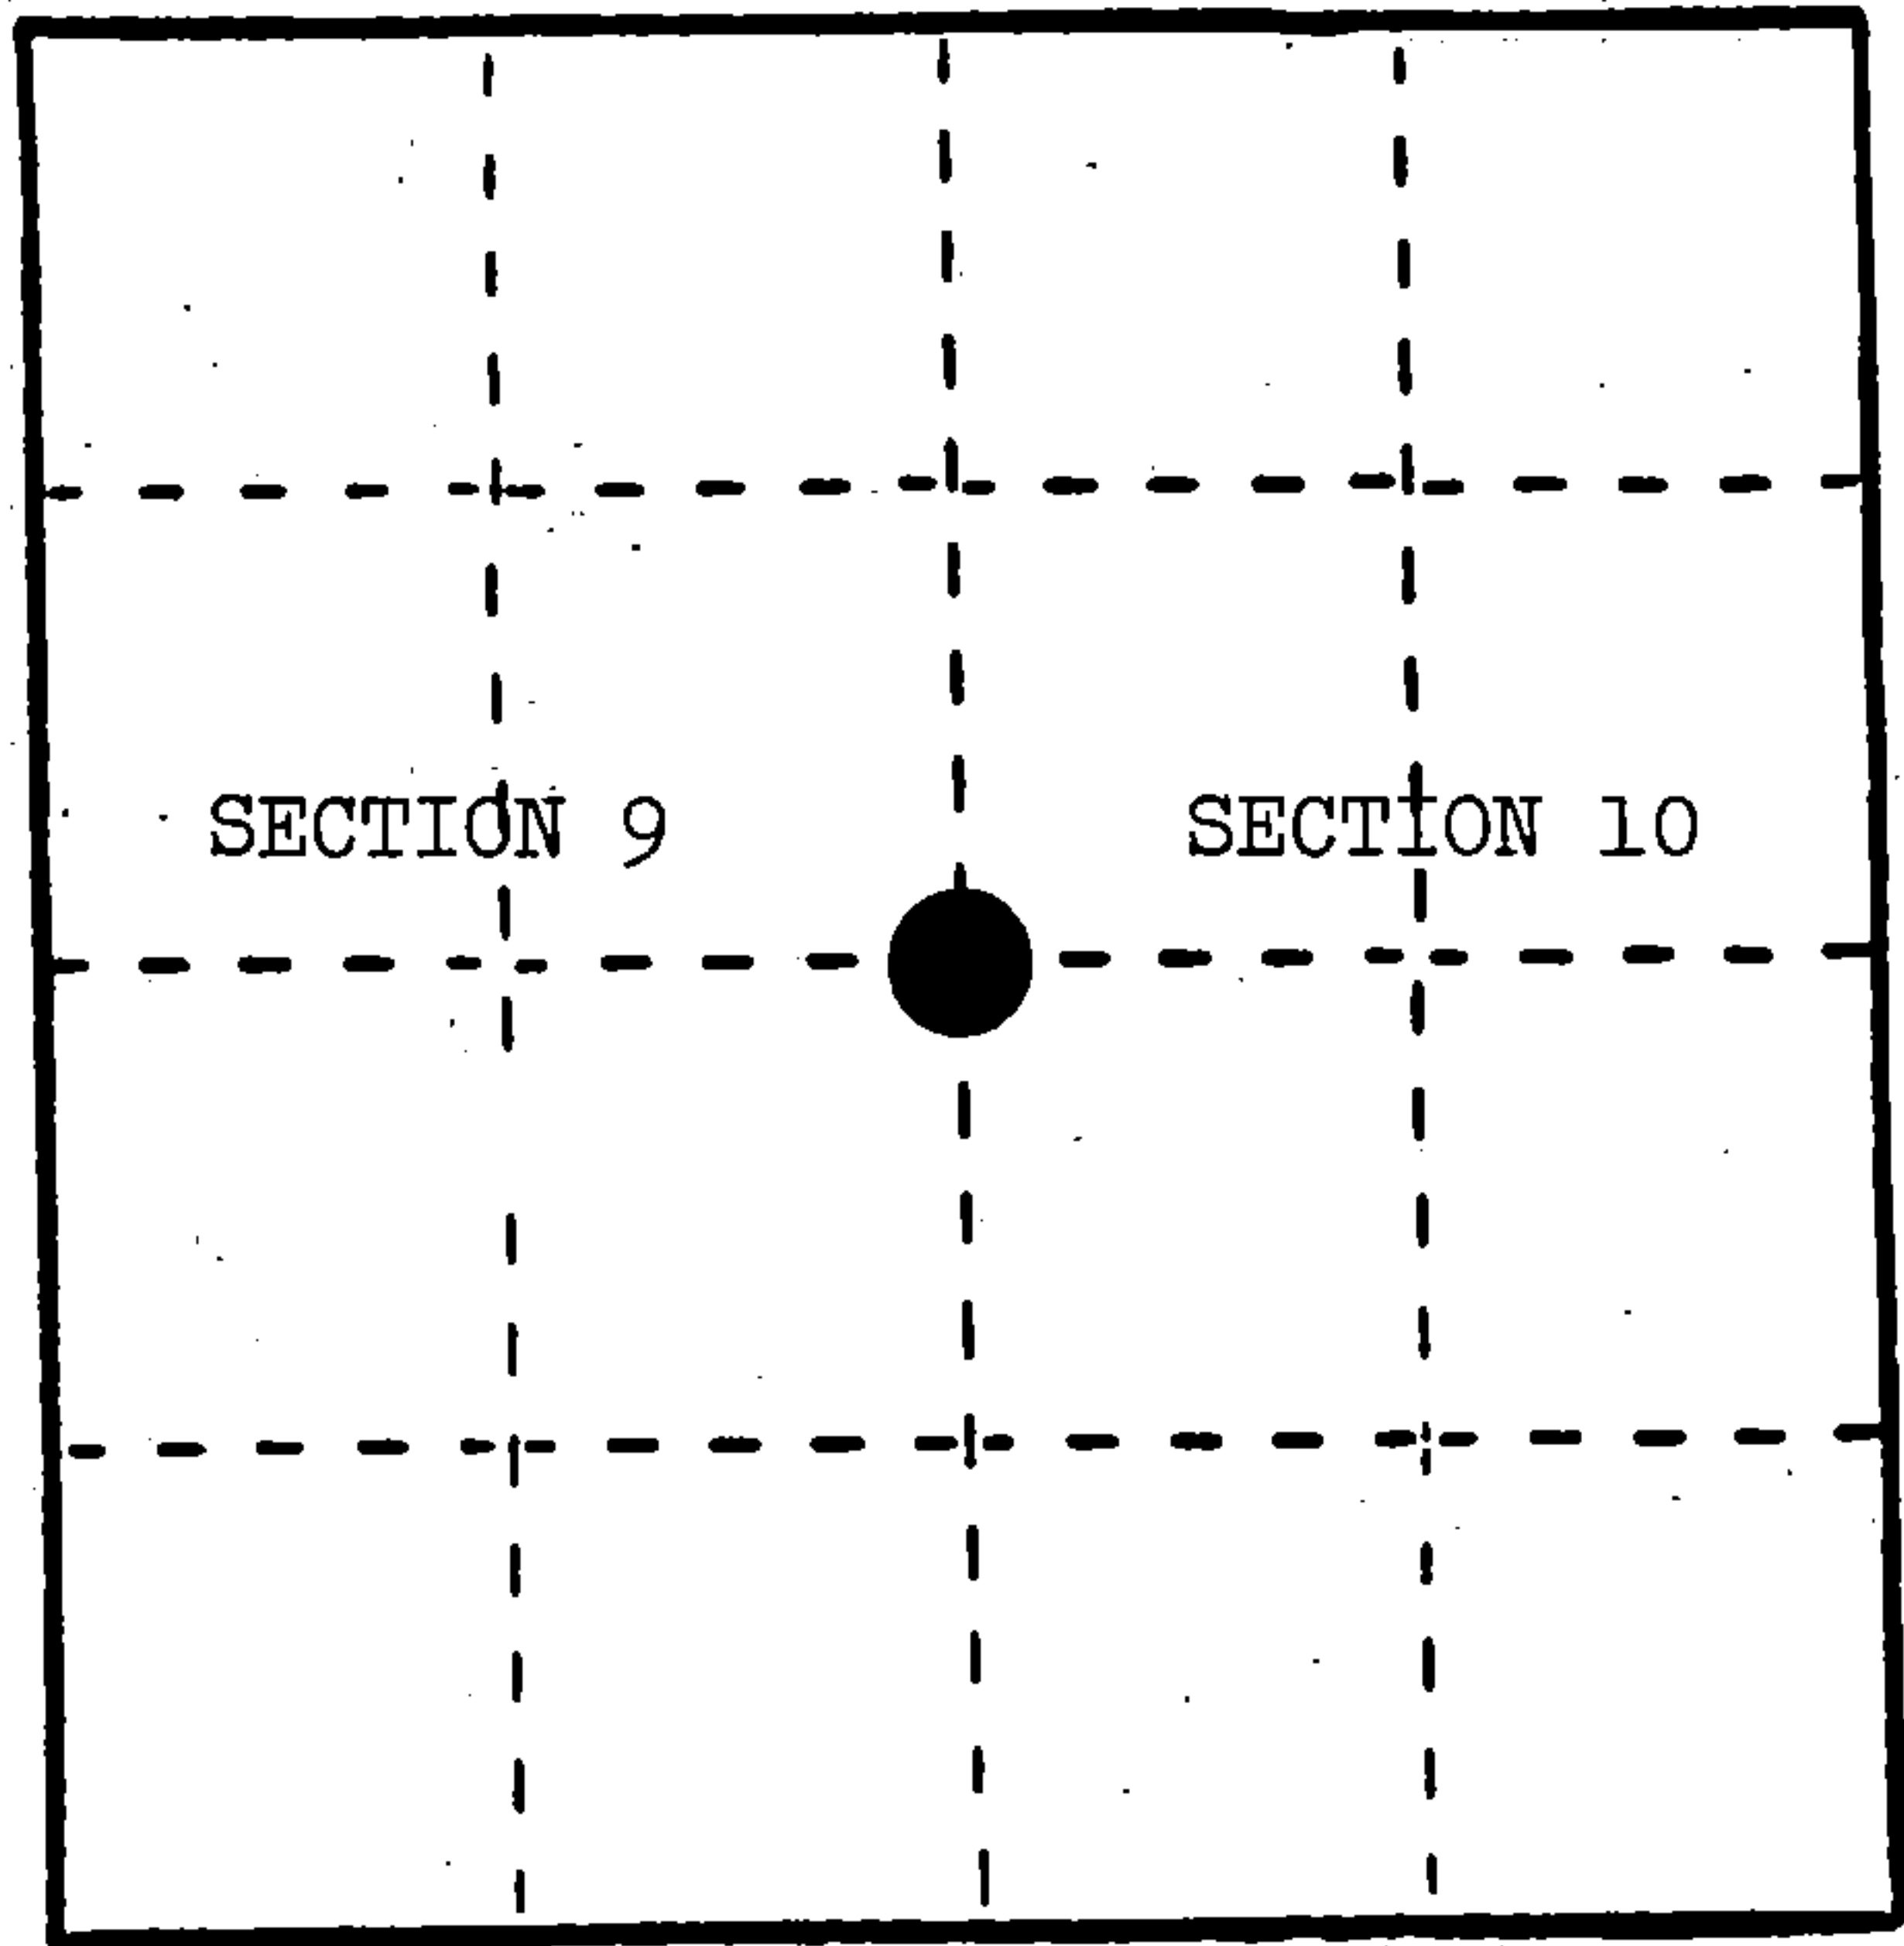

- (b) Describe any record evidence, monument evidence, occupational evidence, testimonial evidence or any other material evidence you considered, and whether the monument was found or placed.

In 1859, James McBride set quarter post and made the following BTs: Hemlock, 10", N.43°W., 12 links; Hemlock, 8", N.84°E., 14 links.

In 1906, N. Smith found post and one BT standing. Set new BTs: Hemlock, 10", S.57°E., 51 links; Birch, 30", S.84¼°W., 51 3/4 links.


In 1937, A. Vronch found Pine post and put tag on Maple, 8", S.40°E., 47 links.

In 1986, Alan Harrison used retracement of Smith's survey of Section 10 to set position of corner. Could find no evidence of existing corner as area was burned extensively years prior.

- (c) In the plan view drawing below, provide reference ties to at least 4 witness monuments, or, if the location is within a municipality, to at least 2 witness monuments. (Witness monuments shall be made of concrete, natural stone, iron or other equally durable material.) Describe witness monuments.

- (d) Show a plan view drawing depicting the relevant monuments and reference ties which is sufficient in detail to enable accurate relocation of the corner monument if the corner monument is disturbed. Indicate north.

- 2" x 36" aluminum monument stamped to identify the corner location.
- Balsam, 11", N.19°E., 6.90 feet
- Sugar, 6", S.74°W., 67.82 feet
- Sugar, 8", N.55°W., 71.73 feet
- Steel Sign Post, Southeast, 0.74 feet

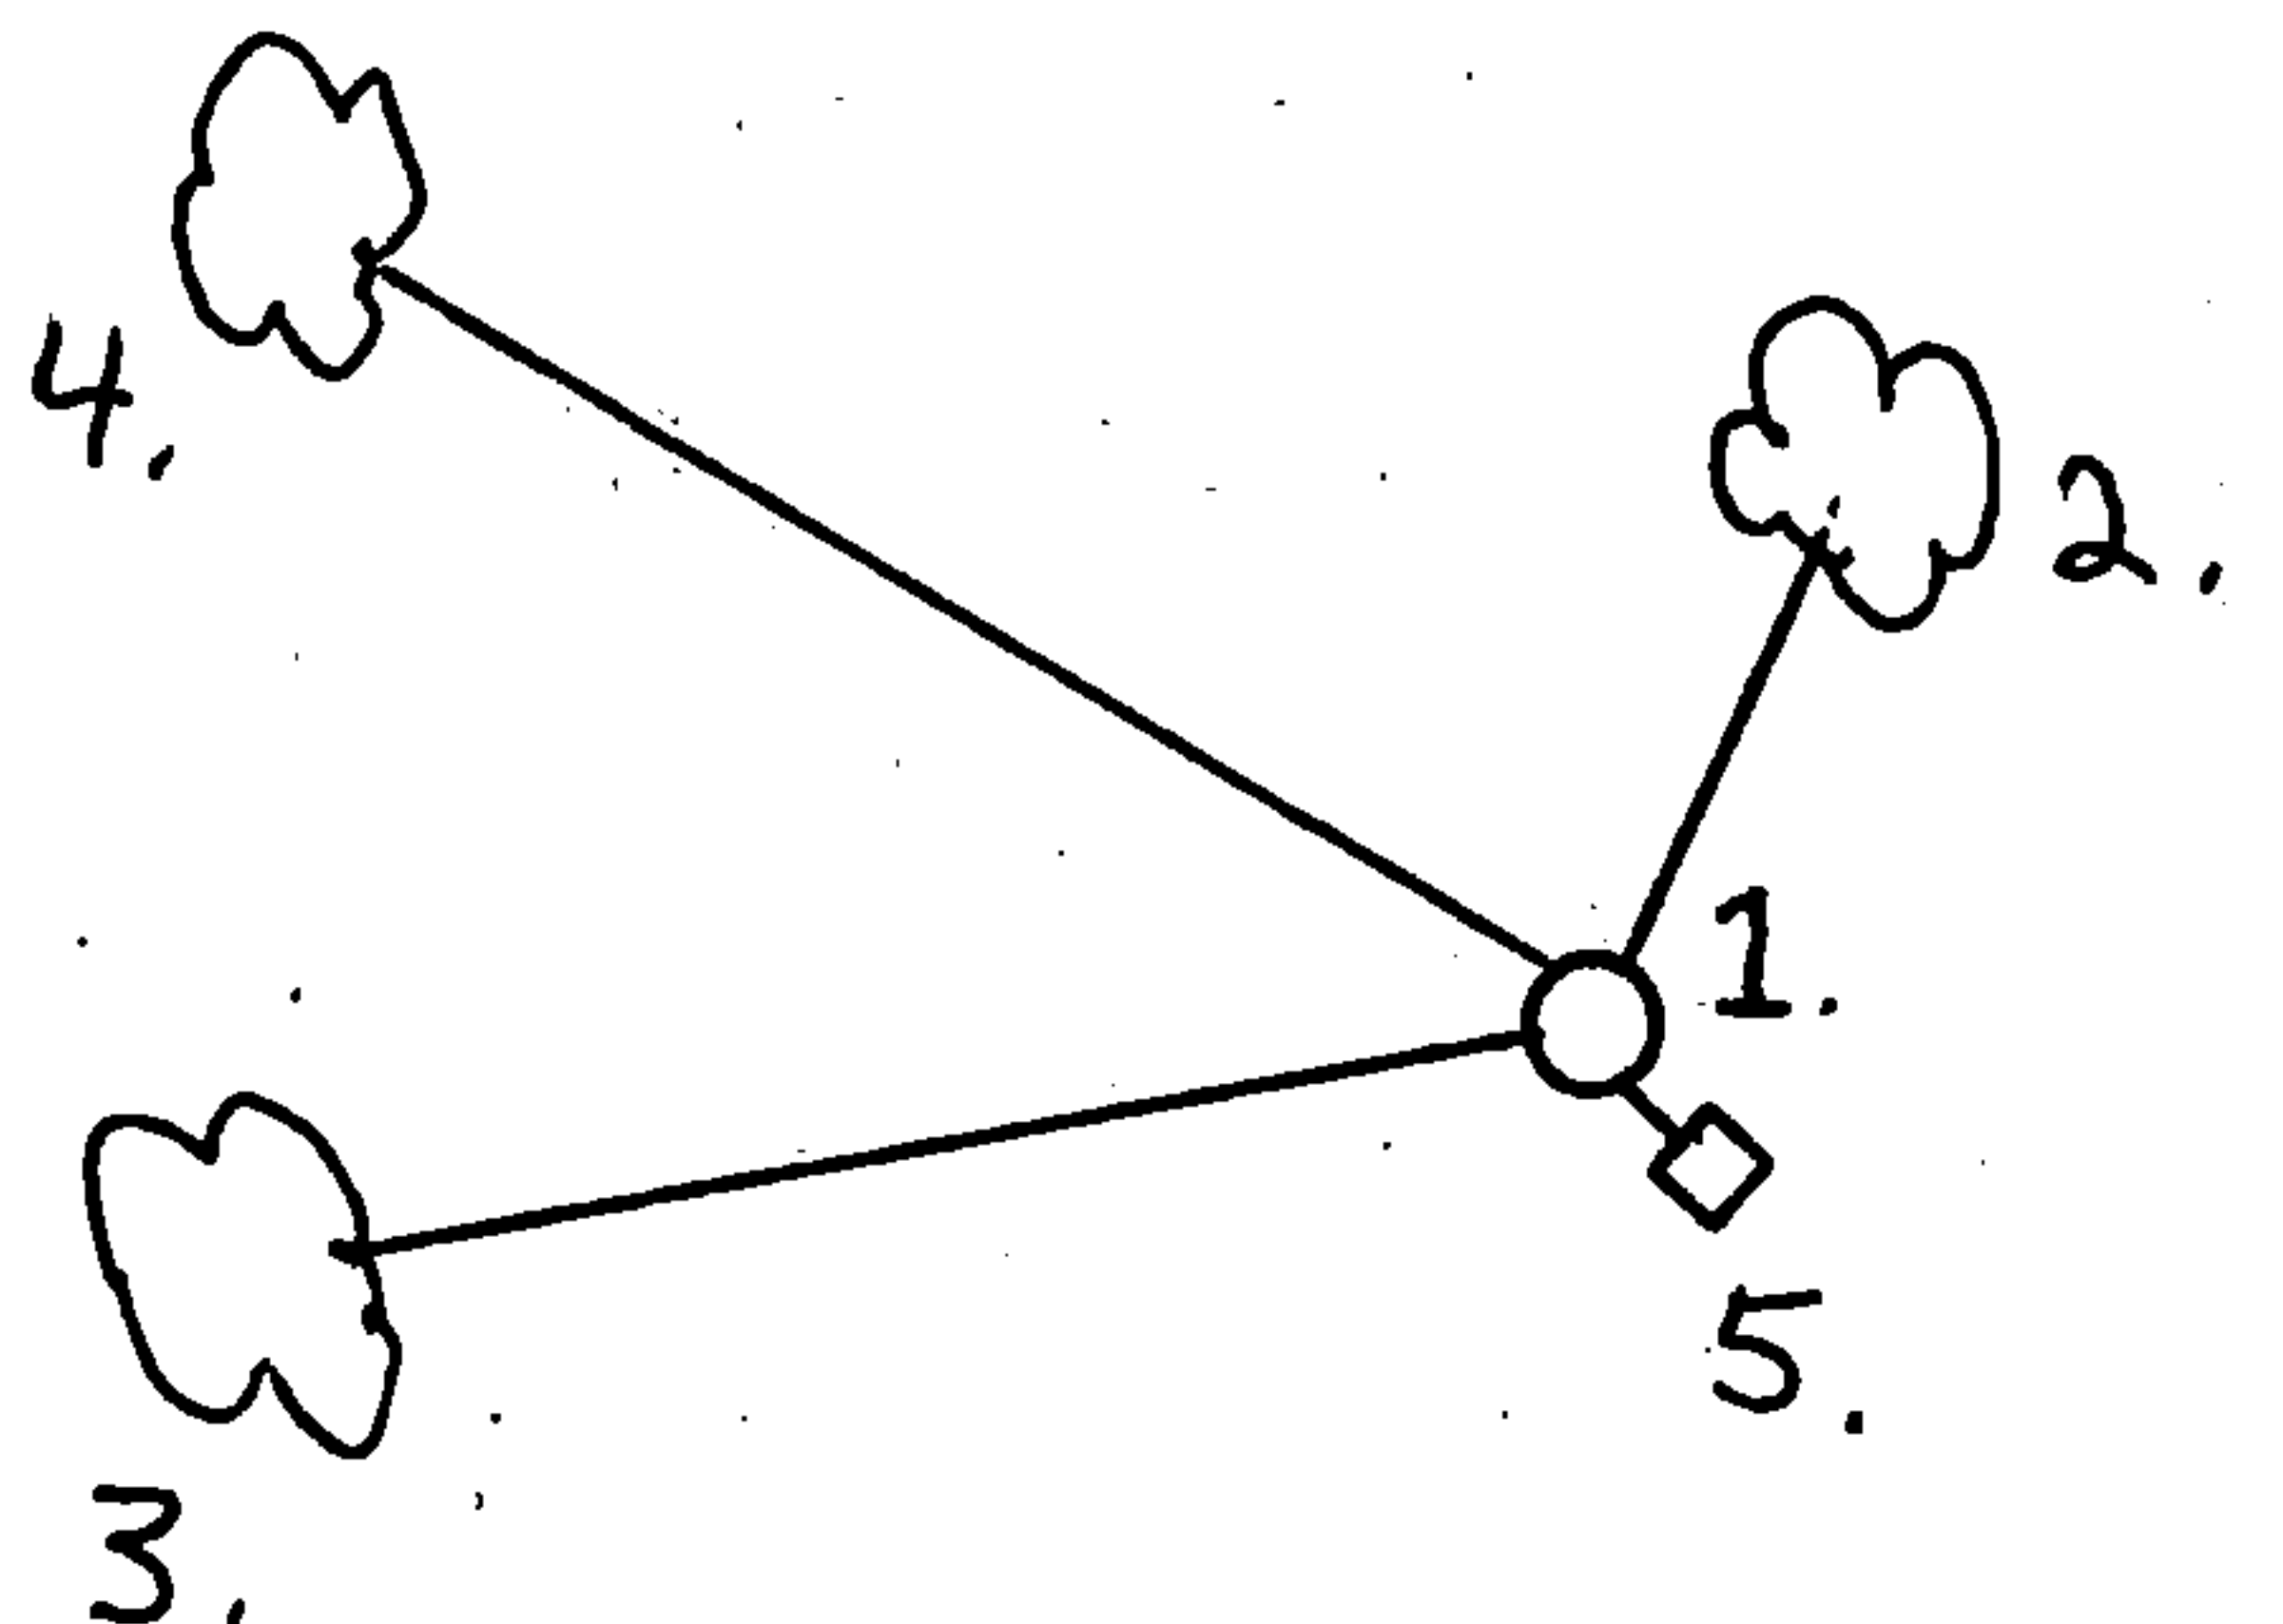

REGISTER'S OFFICE
 Forest County, Wis.
 Received for record this 3rd day
 of December A.D., 1986 at
1:30 o'clock P.M. and recorded
 in Vol. CORNER RESTORATIONS
 page G-13
Paul A. Schumacher
 Register of Deeds

(e) Describe any material discrepancy between the location of the corner as restored or reestablished and the location of that corner as previously restored or reestablished by distance and direction. Show the discrepancy on the plan view drawing under (d), above. Show the distances between the corner as previously restored or reestablished and (1) the corner as restored or reestablished, and (2) to at least 2 of the witness monuments shown on the drawing in (d), above.

None.


(f) Was the corner restored through acceptance of (1) an obliterated evidence location, or, (2) a found perpetuated location?

(1) an obliterated evidence location.

(g&h) Was the corner reestablished through lost corner proportionate methods? If so, show the method, including the directions and distances to other public land survey corners used as evidence or used for proportioning in determining the corner location?

No.

Affix Land Surveyor Seal

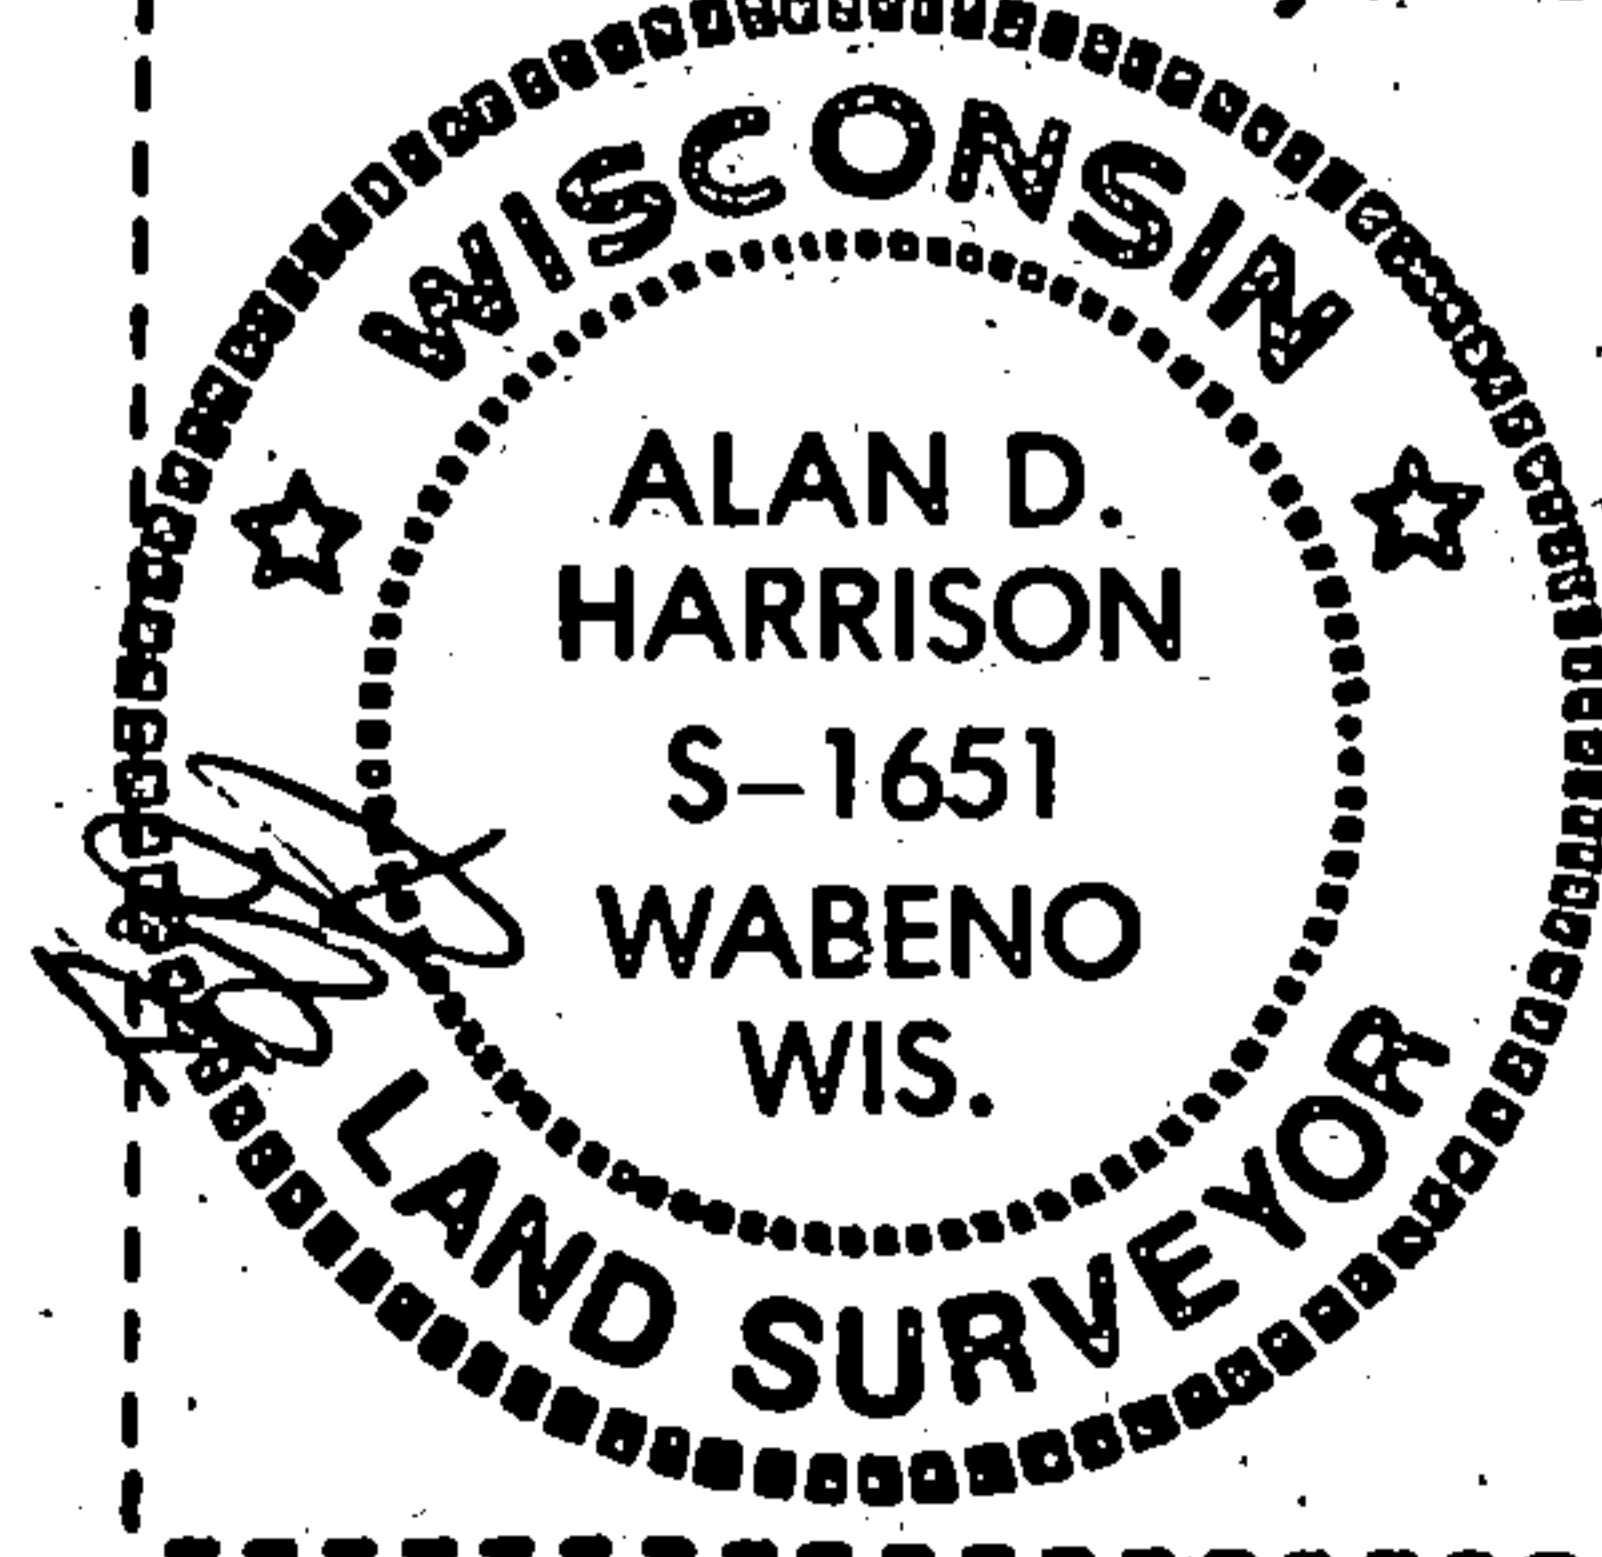

(i) I, Alan D. Harrison
(type or print name) certify that the corner location shown
on this record was determined by me or under my direction and
control and that this U.S. Public Land Survey Monument Record is
correct and complete to the best of my knowledge and belief.

Signature

Date

11/14/86