


U. S. PUBLIC LAND SURVEY MONUMENT RECORD

INSTRUCTIONS: This record shall show the location of the corner and shall include all of the following nine elements (a through i).

- (a) Identify the corner by reference to the U.S. public land survey system.
○ = Corner monument restored.

CENTER EAST 1/16 CORNER TO SECTION 12,
TWP. 34 N., R.14 E.

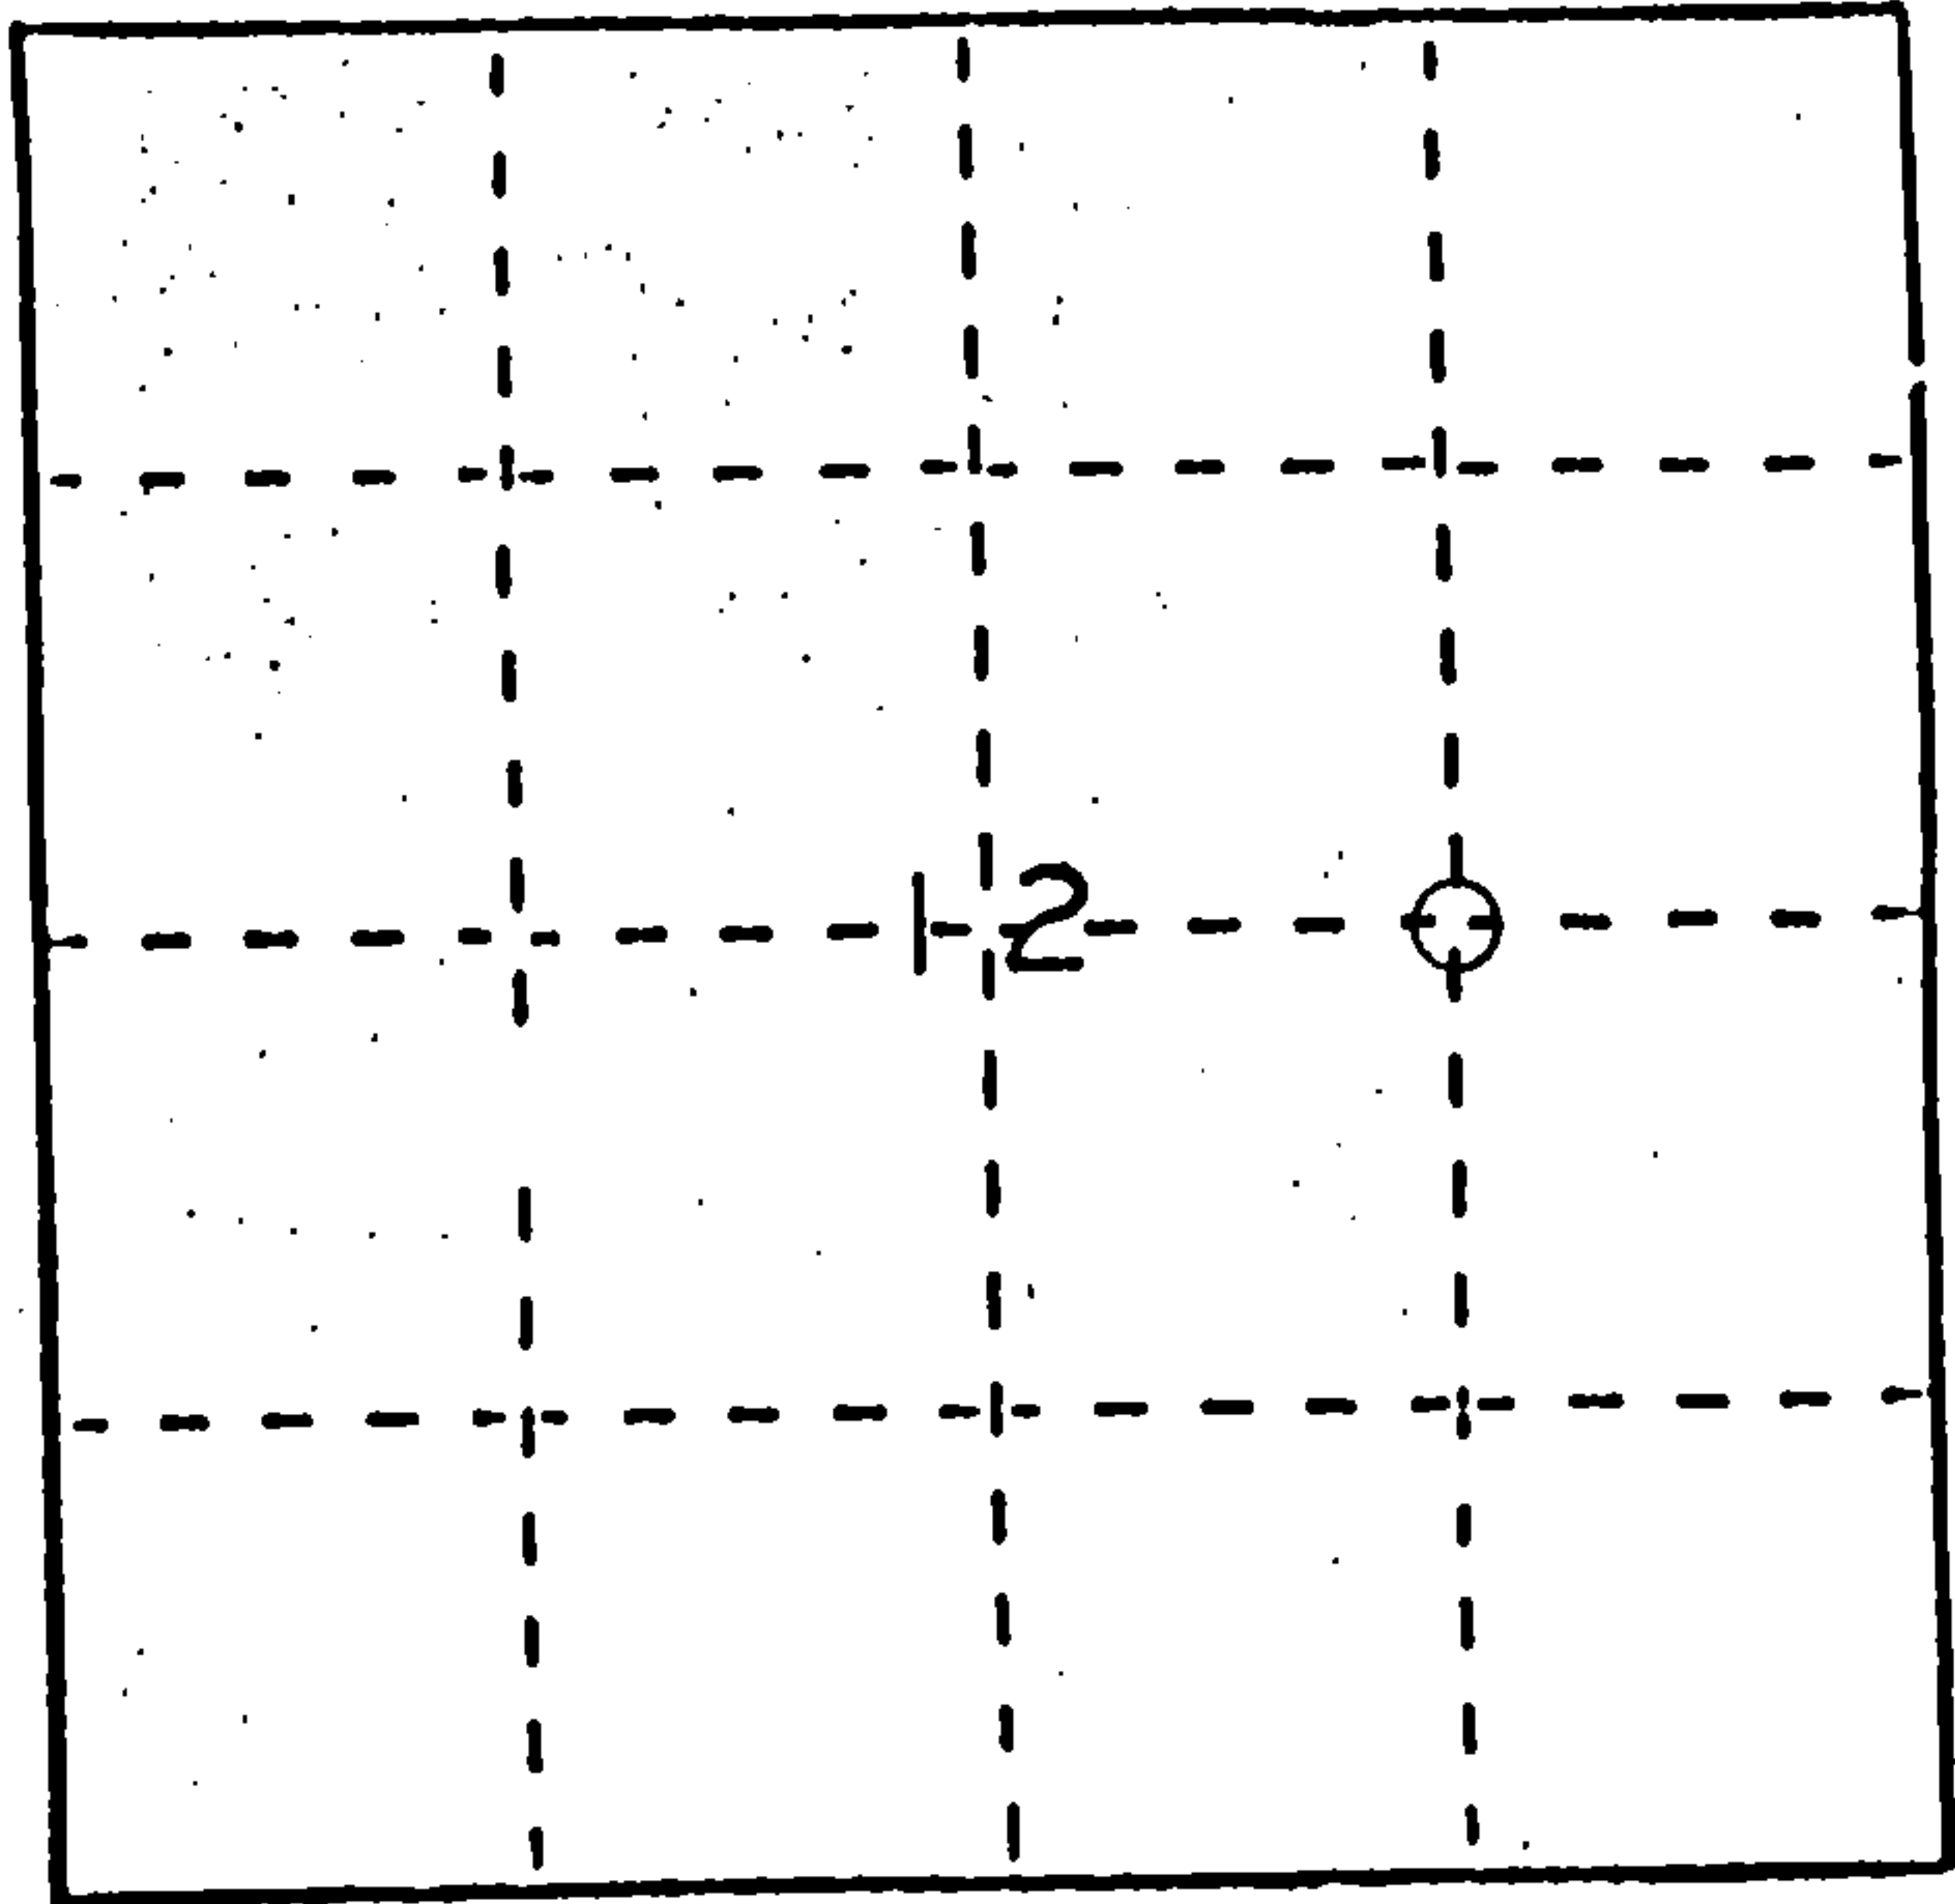

- (b) Describe any record evidence, monument evidence, occupational evidence, testimonial evidence or any other material evidence you considered, and whether the monument was found or placed.

1857 & 1859 ORIGINAL SURVEY OF SECTION 12
1982 SUBDIVISION OF SECTION 12, BY STEFAN R.L.S. NO. S-1558,
SET 2" DIA. ALUMINUM MONUMENT AT CENTER EAST 1/16 CORNER
B.T.s SUGAR MAPLE 9" S.25° E. 33.57FT., SUGAR MAPLE 9" S.9° W.
52.6 FT., SUGAR MAPLE 7" N.51° W. 17.25 FT.
WITNESS STEEL SIGN POST WEST 4.32 FT.
1989 DOBBRATZ R.L.S. NO. S-973. FOUND B.T.s AND POST AS NOTED BY STEFAN
IN 1982, NO MONUMENT FOUND!

- (c) In the plan view drawing below, provide reference ties to at least 4 witness monuments, or, if the location is within a municipality, to at least 2 witness monuments. (Witness monuments shall be made of concrete, natural stone, iron or other equally durable material.)
Describe witness monuments.

- (d) Show a plan view drawing depicting the relevant monuments and reference ties which is sufficient in detail to enable accurate relocation of the corner monument if the corner monument is disturbed. Indicate north.

REGISTER'S OFFICE
Forest County, Wis.


Received for record this 26th day
of February A.D. 1990 at

10:10 o'clock A.M. and recorded
in Vol. CORNER RESTORATIONS
page G-24

Paul Schenk
Register of Deeds

- B.T.s SUGAR MAPLE 9" S.25° E. 33.57FT. (EXISTING) ①
SUGAR MAPLE 9" S.9° W. 52.6 FT. (EXISTING) ②
SUGAR MAPLE 7" N.51° W. 17.25 FT. (EXISTING) ③
WITNESS MONUMENTS STEEL SIGN POST WEST 4.32 FT. (EXISTING) ④
1" X 36" ALUMINUM MONUMENT 1.28 FT. ⑤
SOUTH OF CENTER EAST 1/16 CORNER,
STAMPED TO IDENTIFY CORNER

NOTE! UNABLE TO SET MONUMENT AT TRUE CORNER
DUE TO BOULDER 10" BELOW SURFACE!
SET 1" DIAMETER IRON PIPE IN ROCK
PILE OVER BOULDER AT TRUE CORNER.

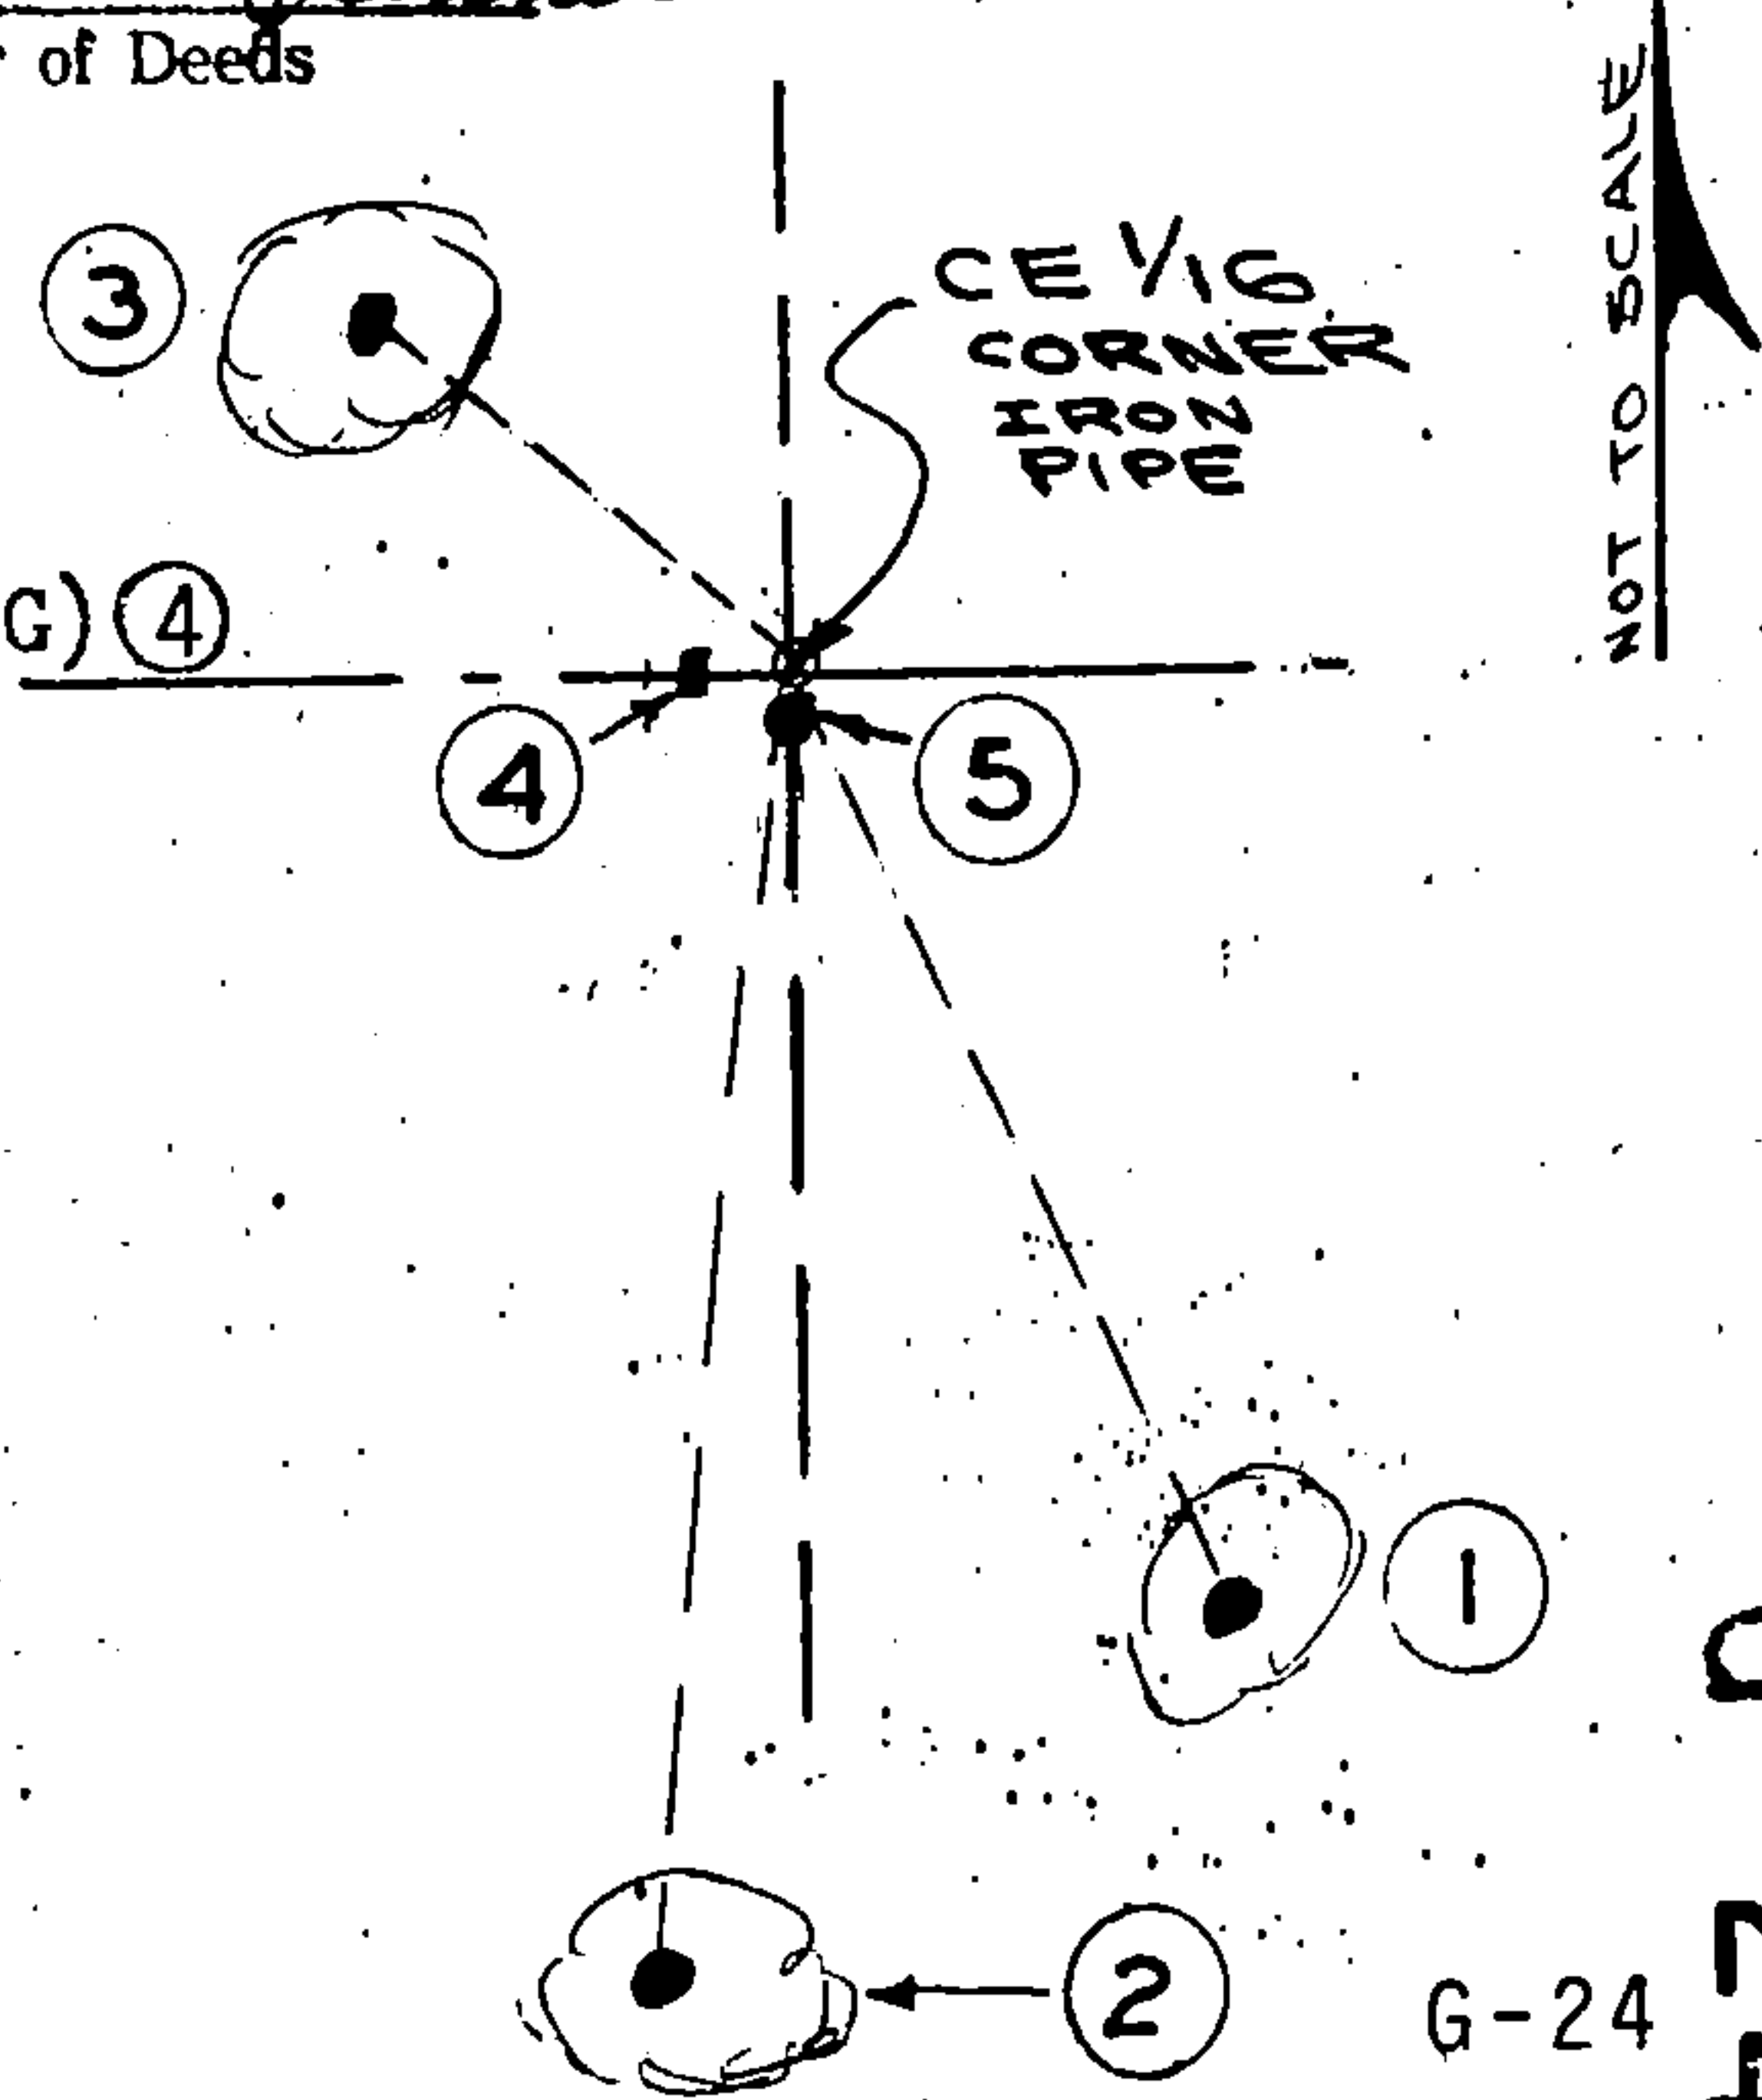

43414122010


G-24

(e) Describe any material discrepancy between the location of the corner as restored or reestablished and the location of that corner as previously restored or reestablished by distance and direction. Show the discrepancy on the plan view drawing under (d), above. Show the distances between the corner as previously restored or reestablished and (1) the corner as restored or reestablished, and (2) to at least 2 of the witness monuments shown on the drawing in (d), above.

(f) Was the corner restored through acceptance of (1) an obliterated evidence location, or, (2) a found perpetuated location?

(2) FOUND PERPETUATED LOCATION

(g) Was the corner reestablished through lost corner proportionate methods? If so, show the method, including the directions and distances to other public land survey corners used as evidence or used for proportioning in determining the corner location?

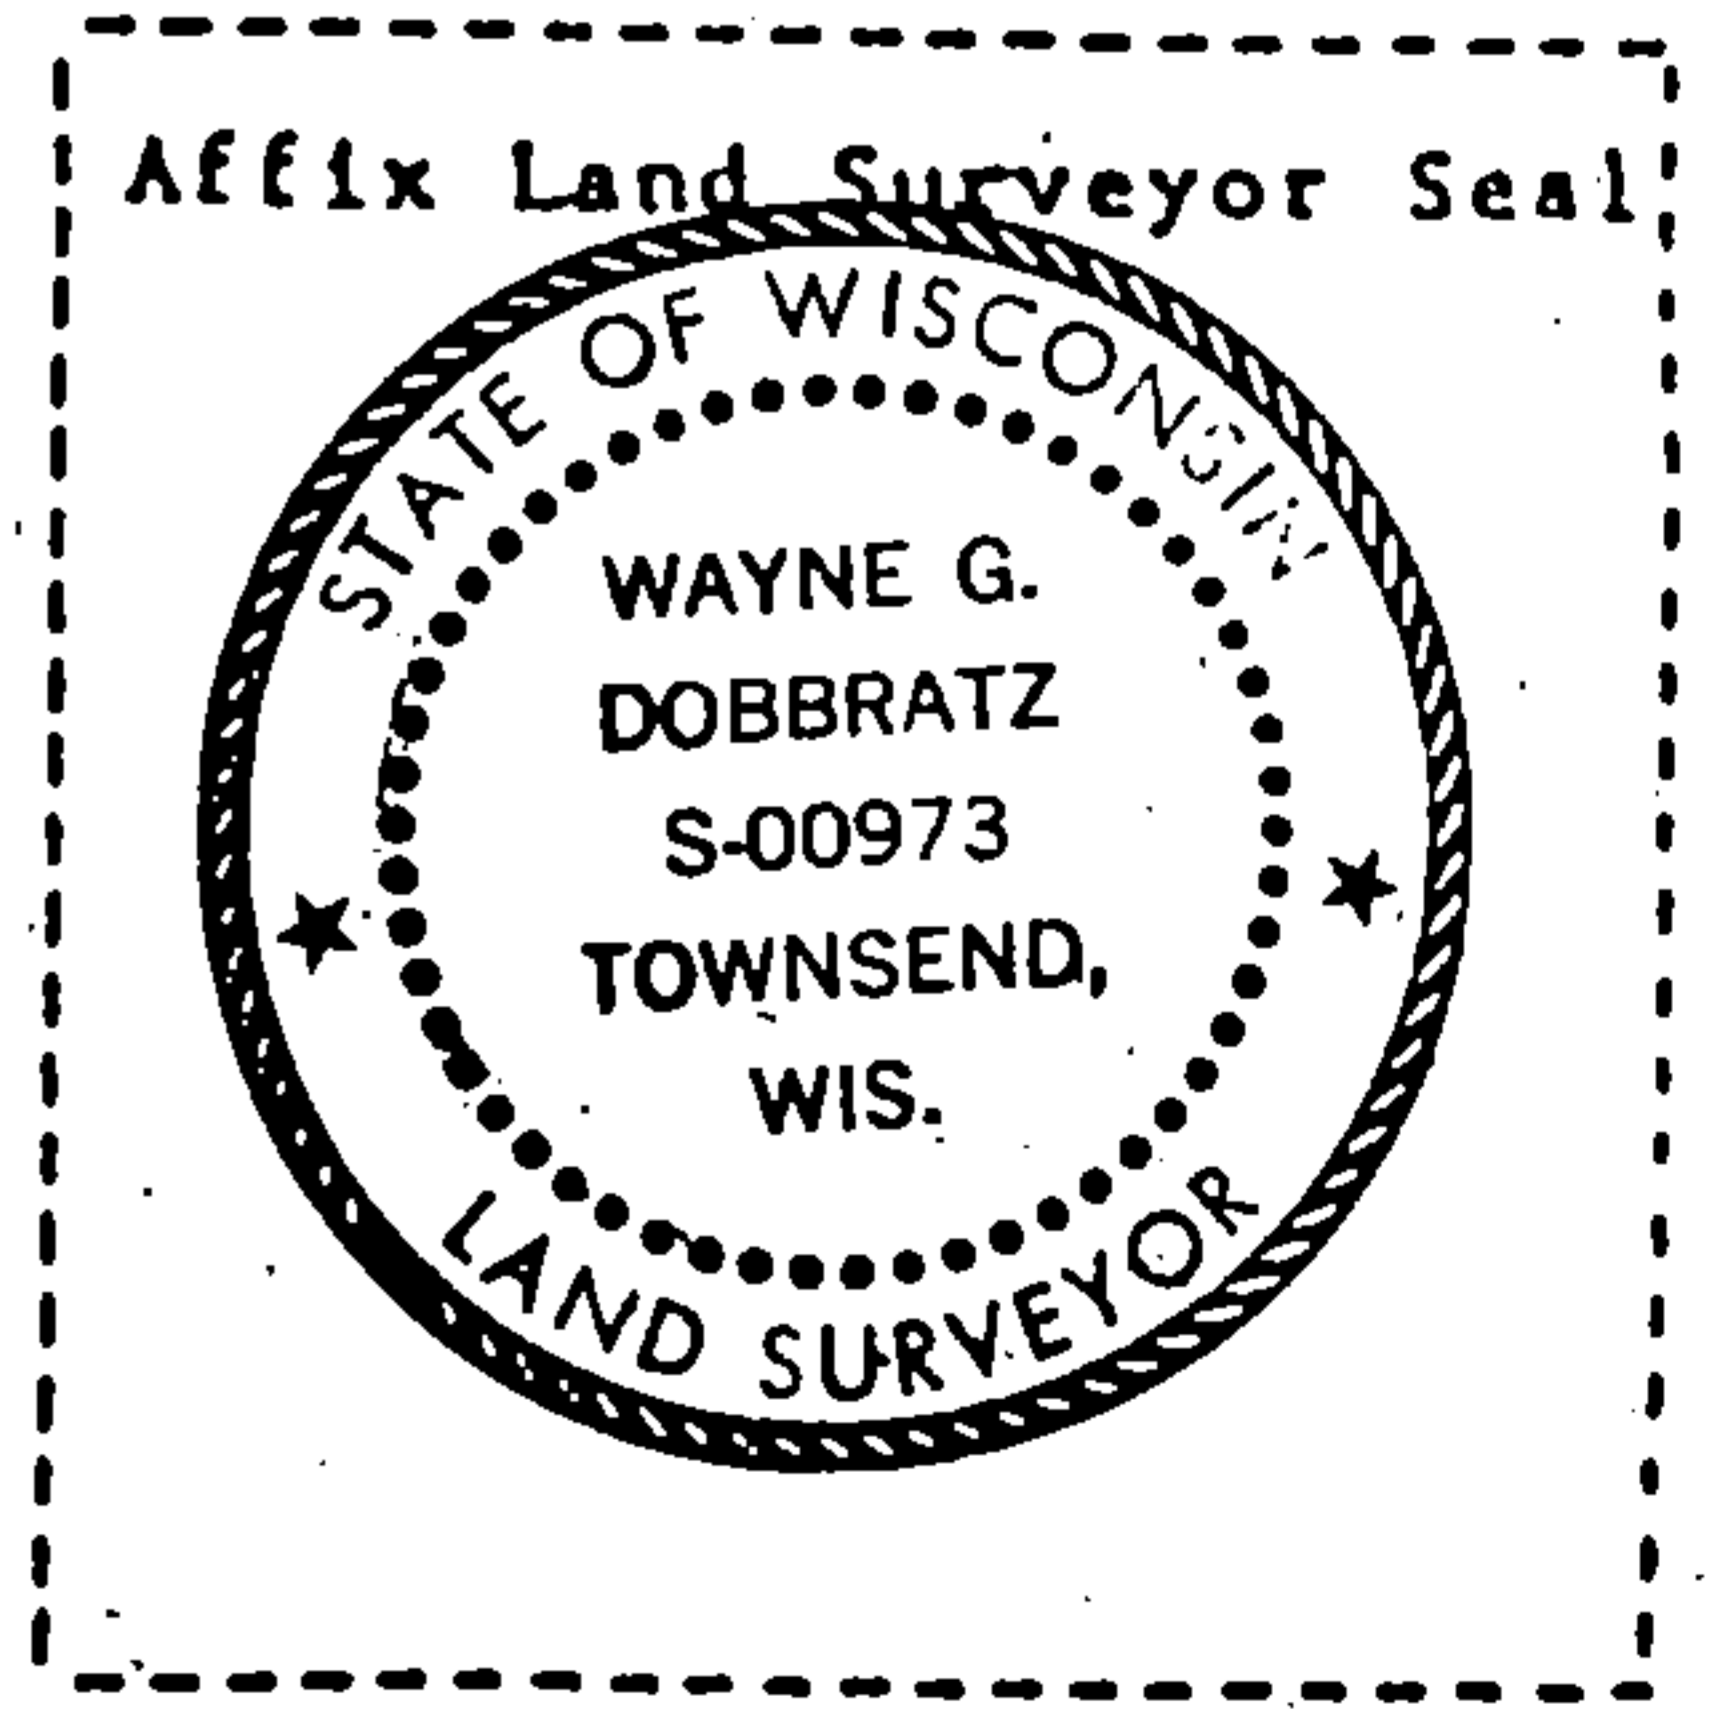

(1) I, WAYNE G. DOBBRATZ
(type or print name) certify that the corner location shown on this record was determined by me or under my direction and control and that this U.S. Public Land Survey Monument Record is correct and complete to the best of my knowledge and belief.

Wayne G. Dobbratz 9/18/89
Signature Date

CERTIFICATE READY FOR FILING: Dale B. Staeger
District Ranger