


U. S. PUBLIC LAND SURVEY MONUMENT RECORD

INSTRUCTIONS:

This record shall show the location of the corner and shall include all of the following nine elements (a through i).

- (a) Identify the corner by reference to the U.S. public land survey system.
○ = Corner monument restored.

Quarter Corner to Sections 13 and 14,
T.34N., R.14E., Forest County, WI.

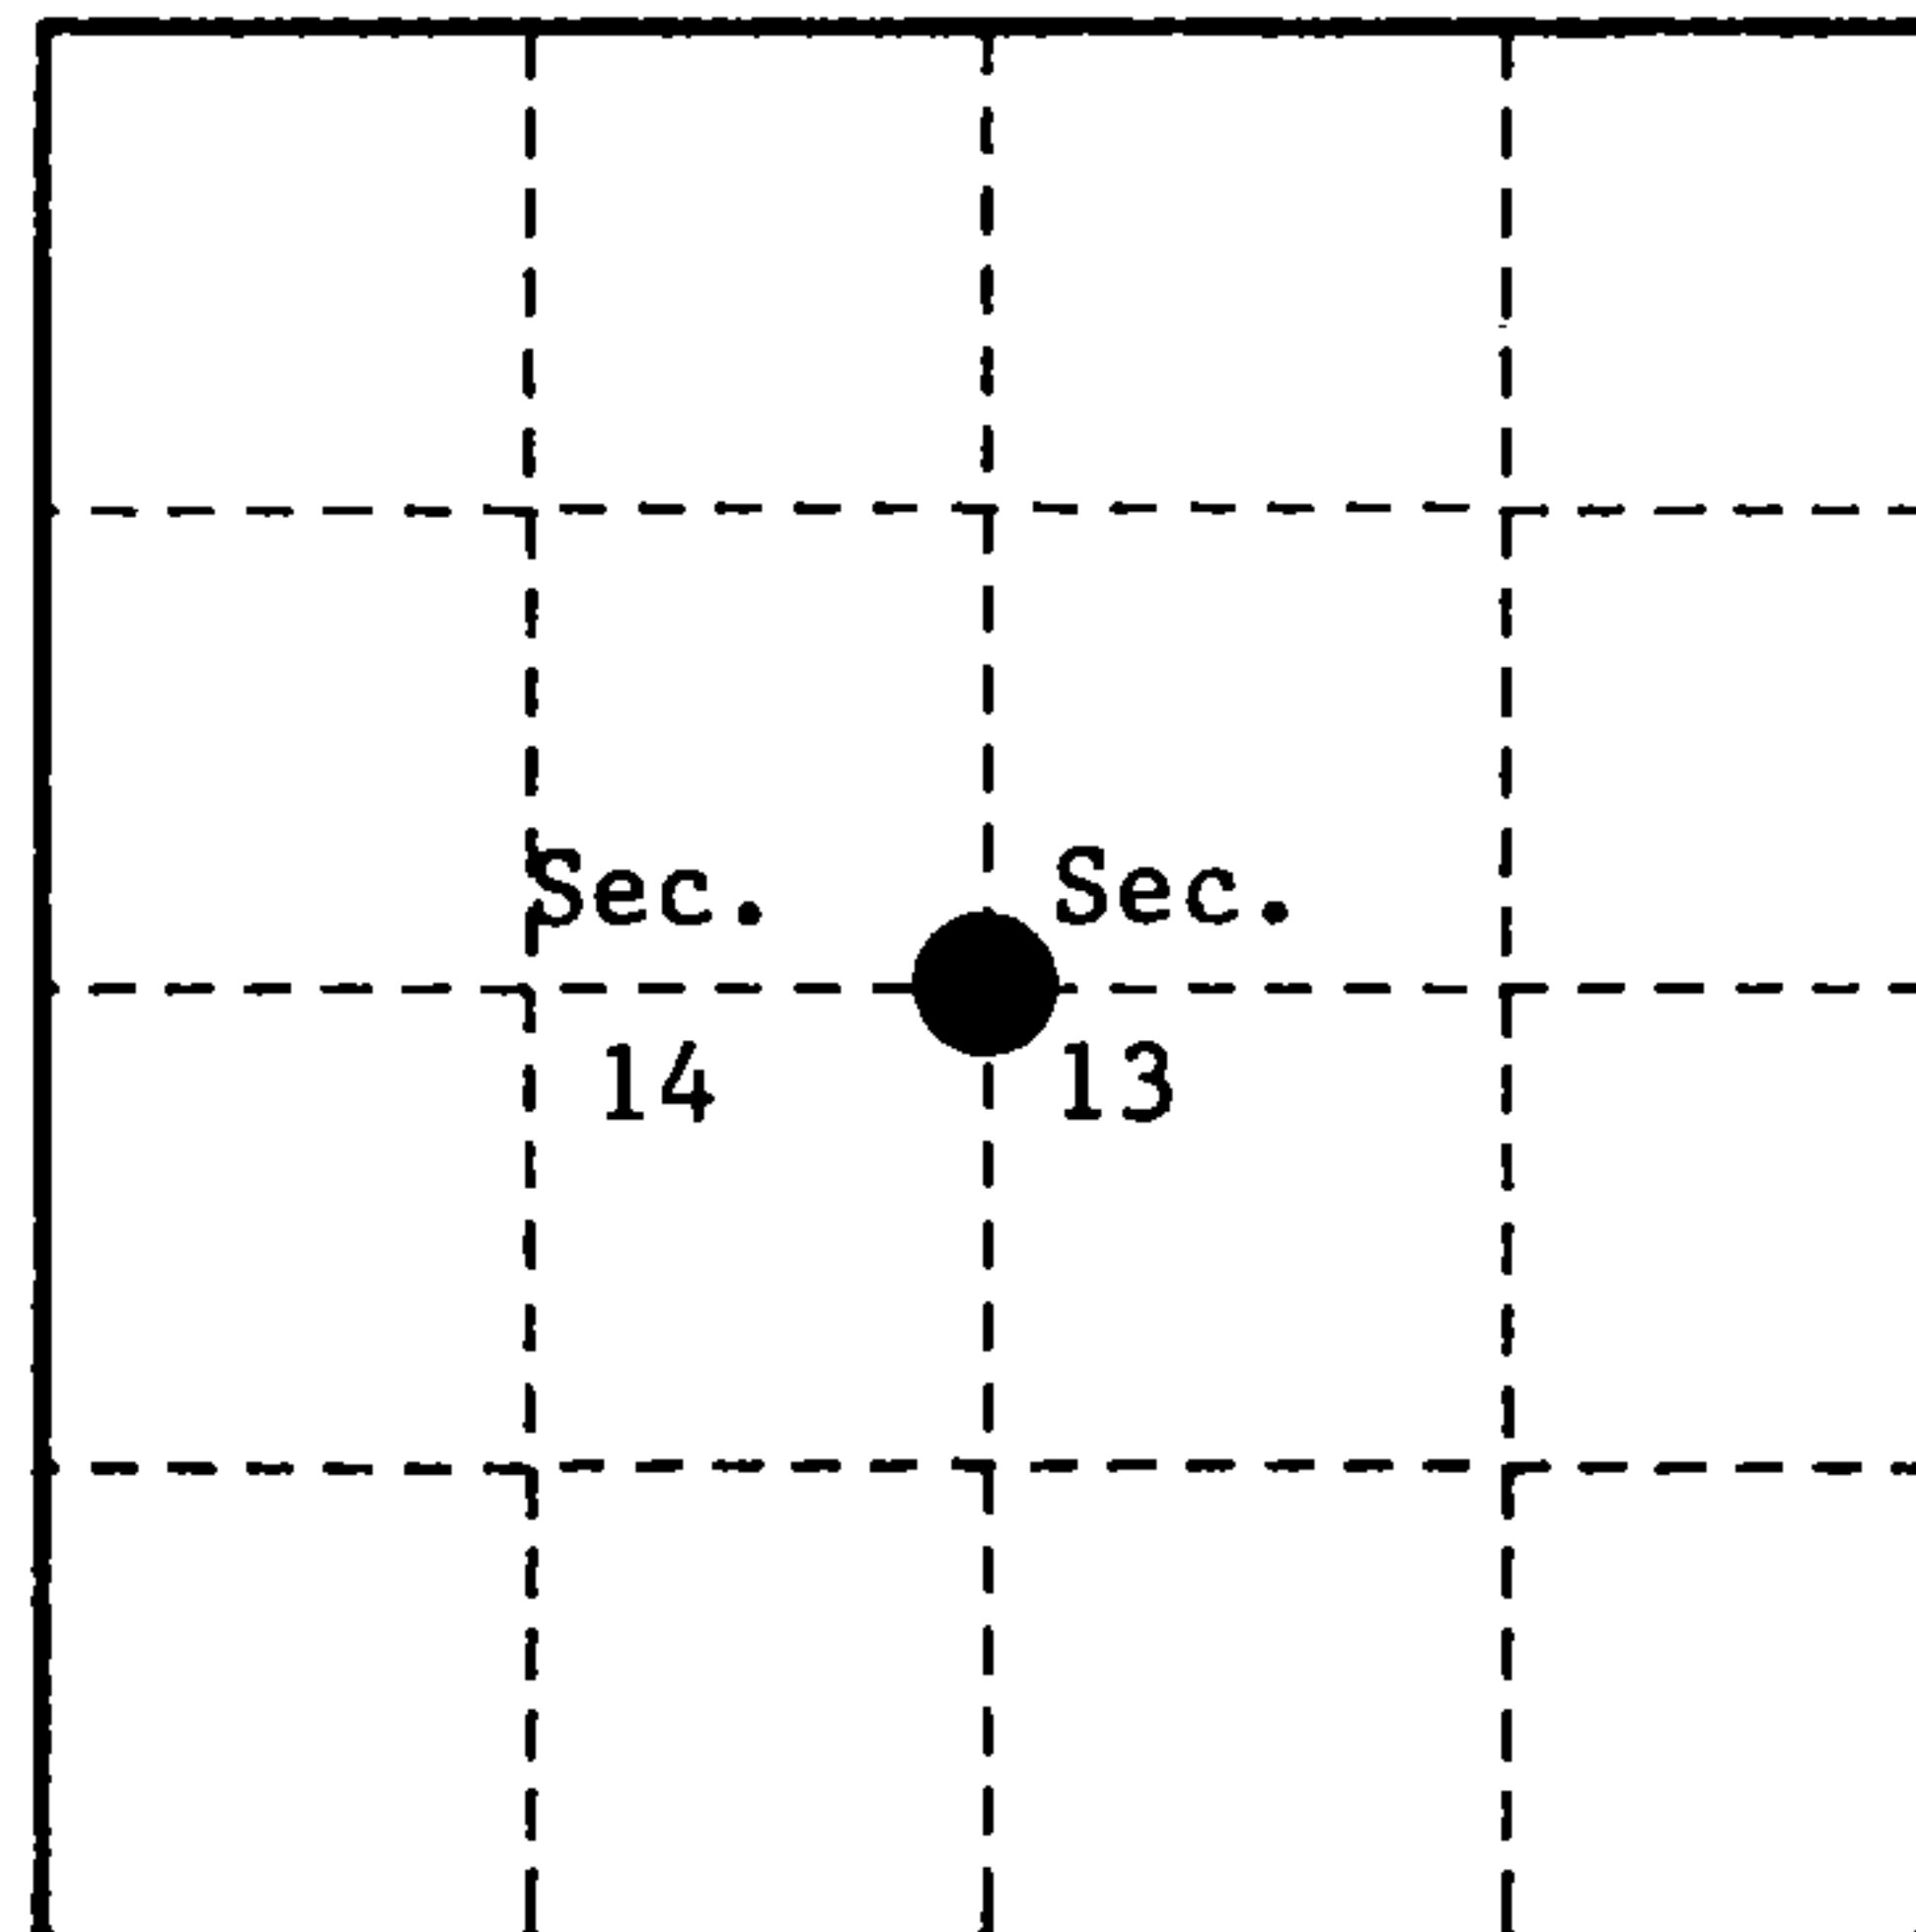

- (b) Describe any record evidence, monument evidence, occupational evidence, testimonial evidence or any other material evidence you considered, and whether the monument was found or placed.


Original survey in 1859 by James McBride. Set wood post and the following bearing trees; Sugar, 14", N.26°E., 48 links, Sugar, 7", S.65°W., 14 links.

In 1981, Milo Stefan, R.L.S., talked to local landowner Ed Rommel who stated that the corner is in the center-line of Range Line Road and on line with a fence line that bears West. Stefan accepted this evidence as the best available, and set a 2" x 30" aluminum monument with a tablet stamped to identify the corner. Made the following new bearing trees; Red Pine, 4", N.53°E., 42.23 feet, Red Pine, 4", S.37°E., 49.51 feet, Sugar, 6", N.47°W., 91.59 feet.

On October 6, 1993 Alan Harrison, R.L.S., found the monument and bearing trees as noted above. Removed the monument for road construction.

On August 27, 1994, Alan Harrison, R.L.S., set a railroad spike flush with a new blacktop road surface and set a 2 1/2" x 36" aluminum reference monument, East, 30.00 feet. Set a Steel Sign Post, 0.50 feet East of Reference Monument.

- (c) In the plan view drawing below, provide reference ties to at least 4 witness monuments, or, if the location is within a municipality, to at least 2 witness monuments. (witness monuments shall be made of concrete, natural stone, iron or other equally durable material.)

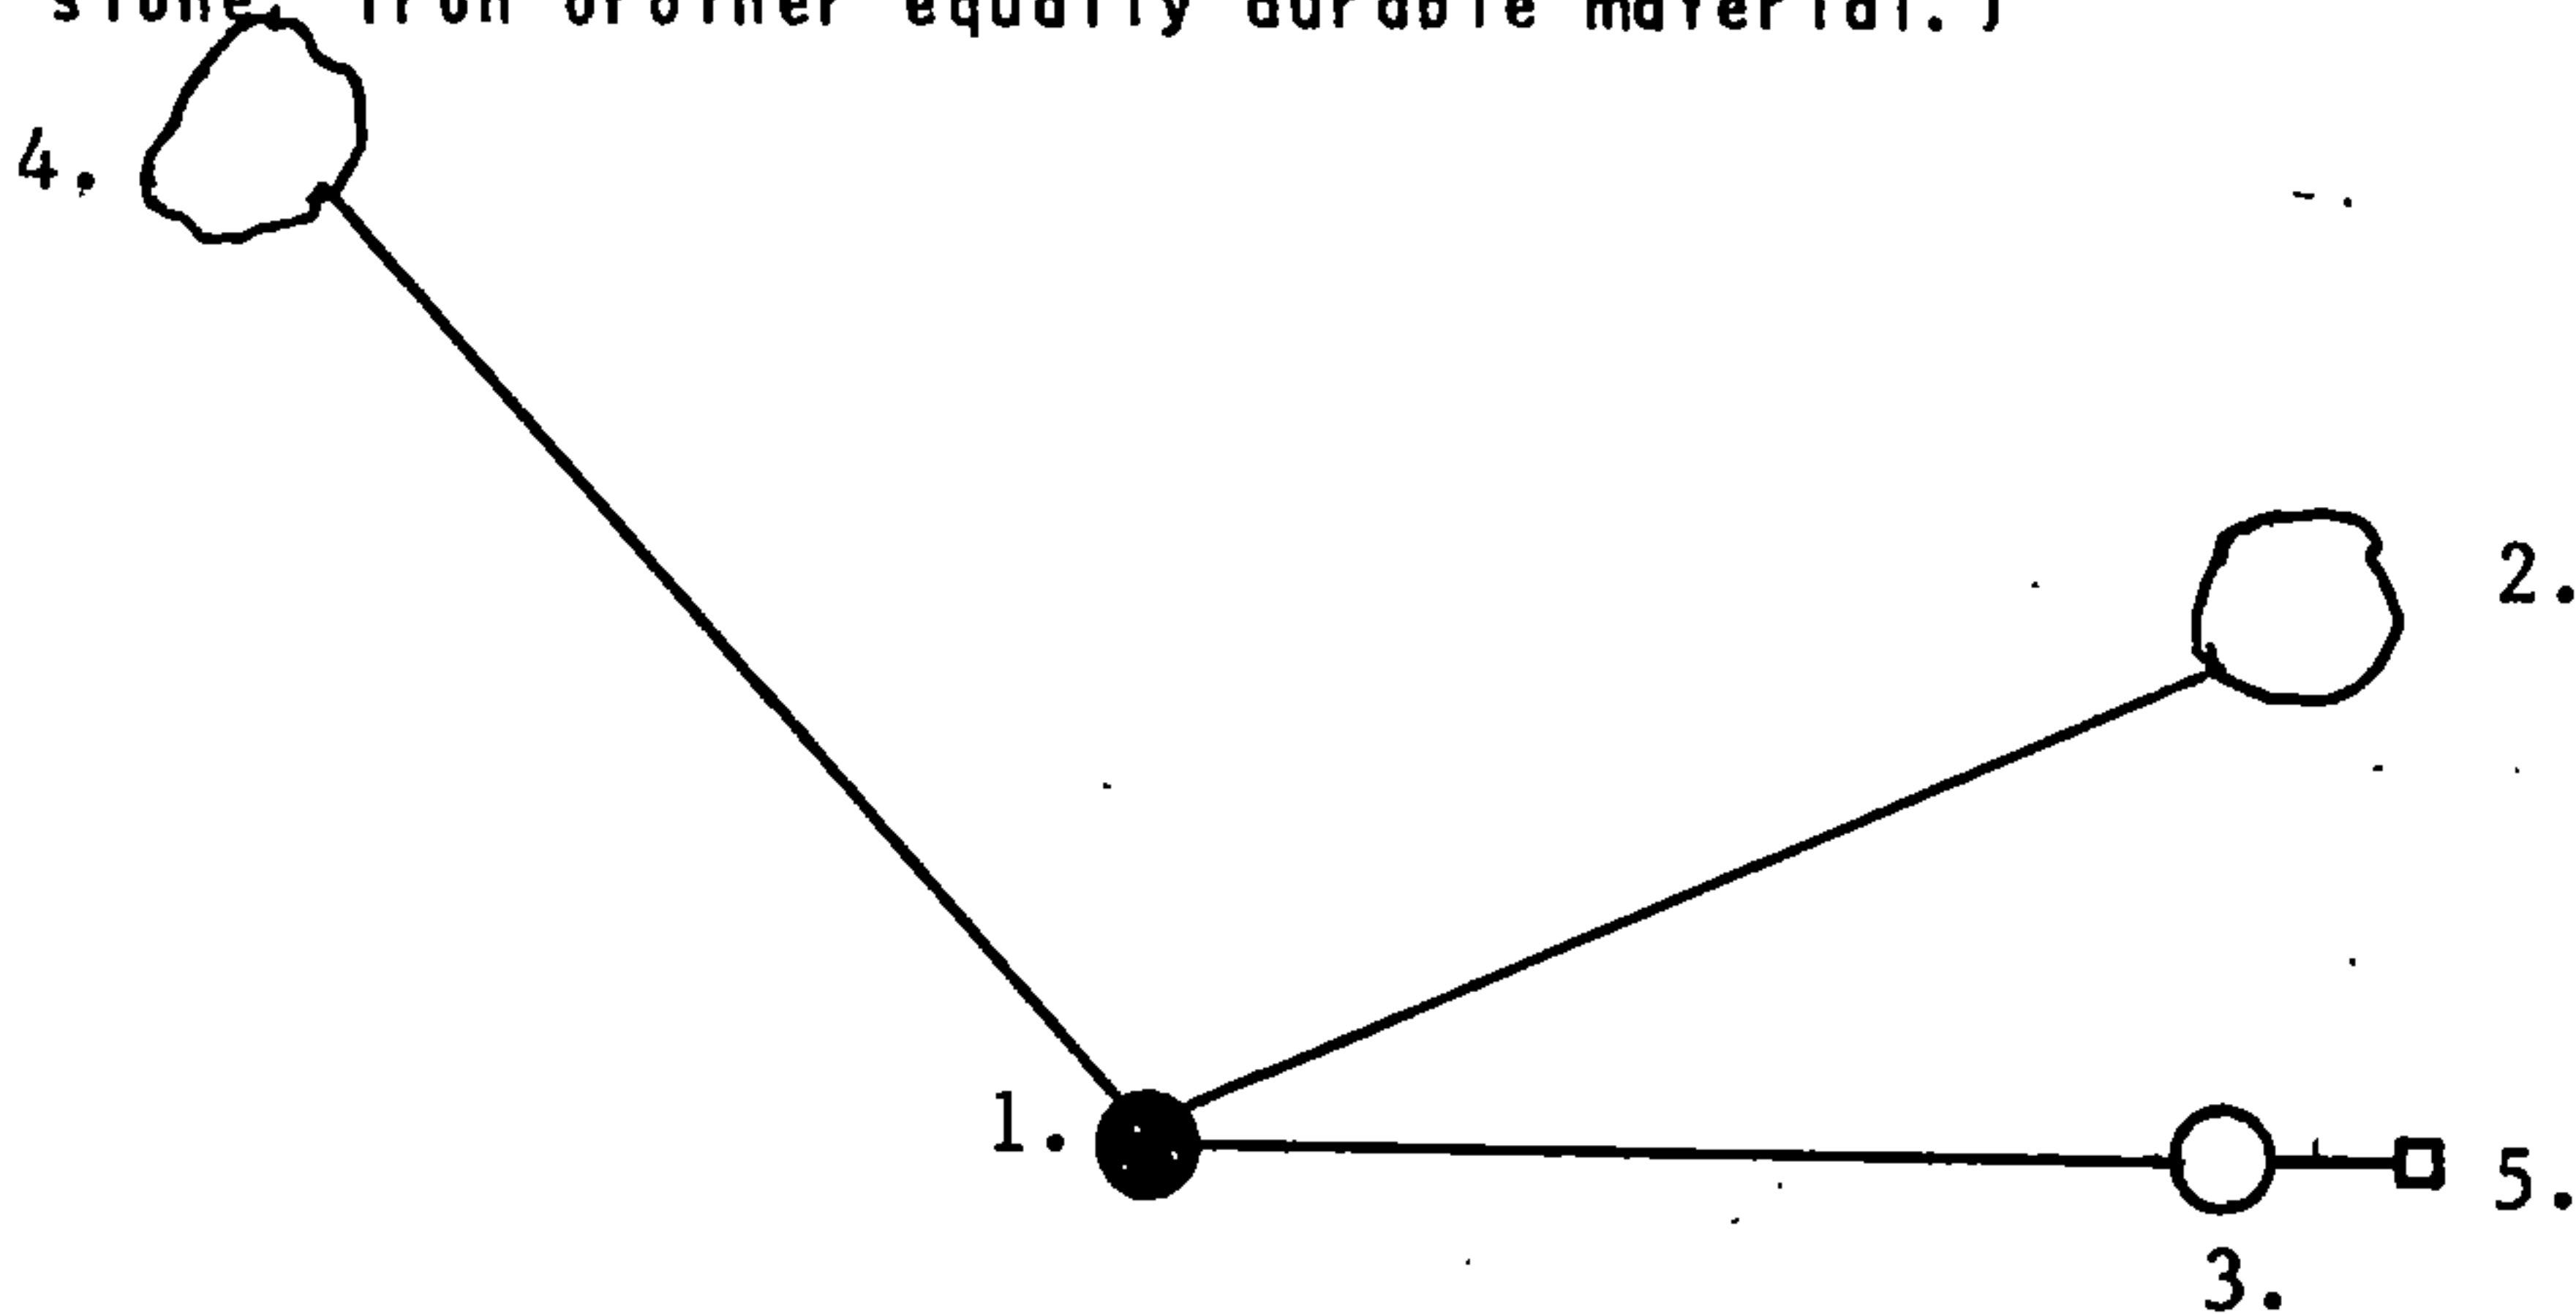

- (d) Show a plan view drawing depicting the relevant monuments and reference ties which is sufficient in detail to enable accurate relocation of the corner monument if the corner monument is disturbed. Indicate north.

1. Railroad spike in blacktop.
2. Red Pine, 4", N.53°E., 42.23 feet.
3. 2 1/2" x 36" Reference Monument, East, 30.00 feet.
4. Sugar, 6", N.47°W., 91.59 feet.
5. Steel Sign Post, 0.50 feet, East of Reference Monument.

(e) Describe any material discrepancy between the location of the corner as restored or reestablished and the location of that corner as previously restored or reestablished by distance and direction. Show the discrepancy on the plan view drawing under (d), above. Show the distances between the corner as previously restored or reestablished and (1) the corner as restored or reestablished, and (2) to at least 2 of the witness monuments shown on the drawing in (d), above.

None


(f) Was the corner restored through acceptance of (1) an obliterated evidence location, or, (2) a found perpetuated location?

(2)

(g & h) Was the corner reestablished through lost corner proportionate methods? If so, show the method, including the directions and distances to other public land survey corners used as evidence or used for proportioning in determining the corner location?

No

REGISTER'S OFFICE
Forest County, Wis.
Received for record this 23rd day
of November A.D., 1994 at
9:00 o'clock A.M. and recorded
in Vol. Case Restorations
page 34-11, L-21
Leah Chittenden
Deputy
Register of Deeds

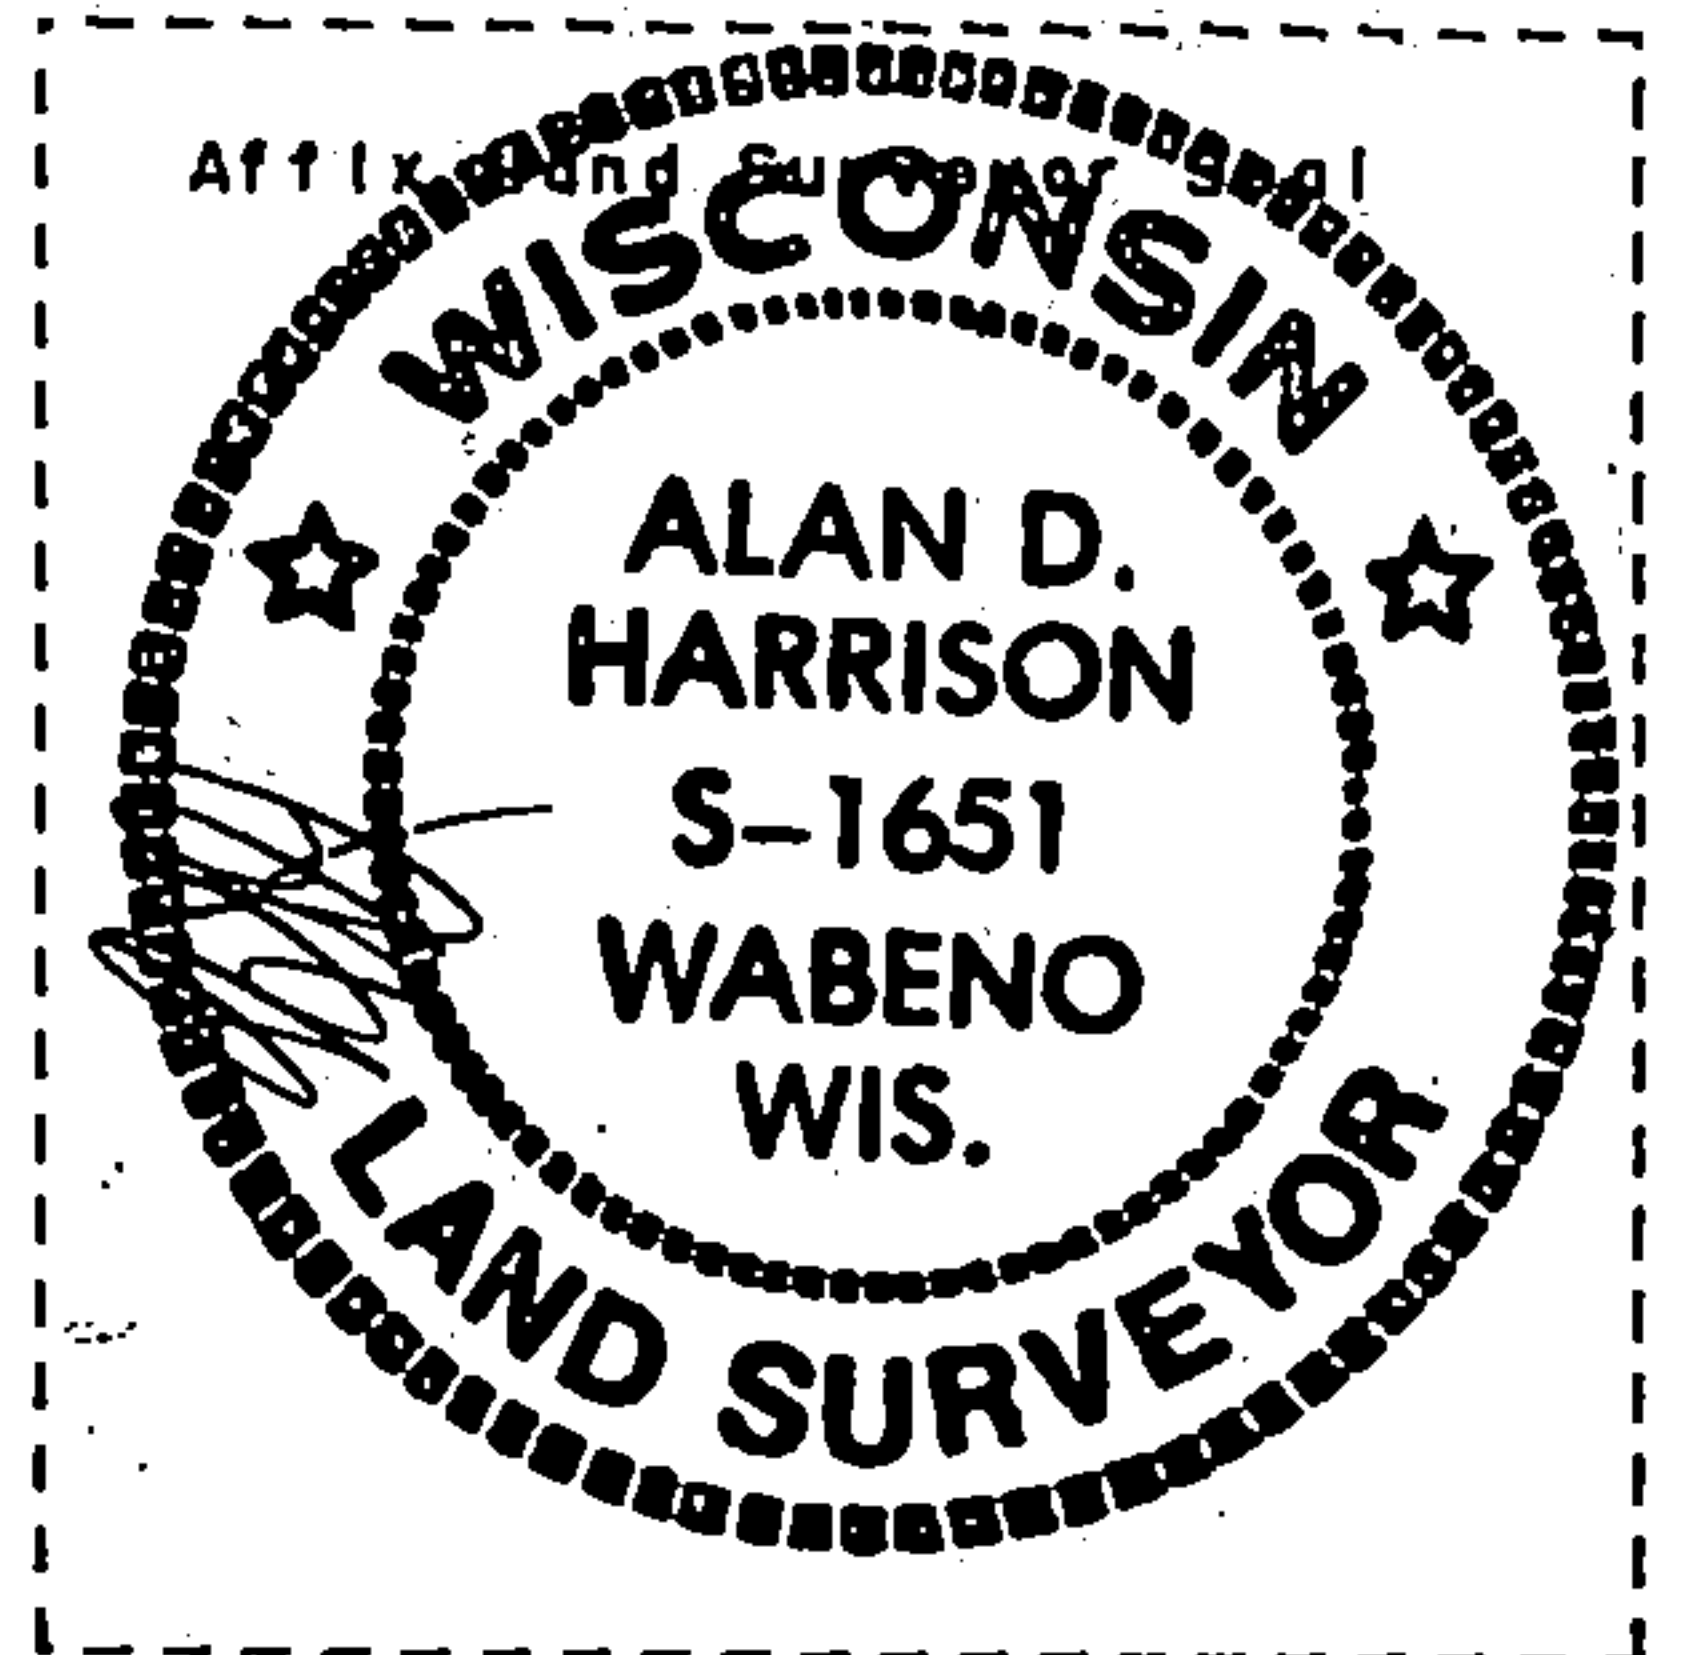

(1) I, Alan D. Harrison
(type or print name) certify that the corner location shown
on this record was determined by me or under my direction and
control and that this U.S. Public Land Survey Monument Record is
correct and complete to the best of my knowledge and belief.

Alan D. Harrison 10/31/94
Signature Date

CERTIFICATE READY FOR FILING: *Sue Vap*
District Ranger