

R.O.D.

DOCUMENT NUMBER


139370

U. S. PUBLIC LAND SURVEY MONUMENT RECORD.

INSTRUCTIONS: This record shall show the location of the corner and shall include all of the following nine elements (a through i).

- (a) Identify the corner by reference to the U.S. public land survey system.
- = Corner monument restored.

Corner common to Sections 26-27-34-35, T.34N., R.14E., Forest County, Wisconsin.

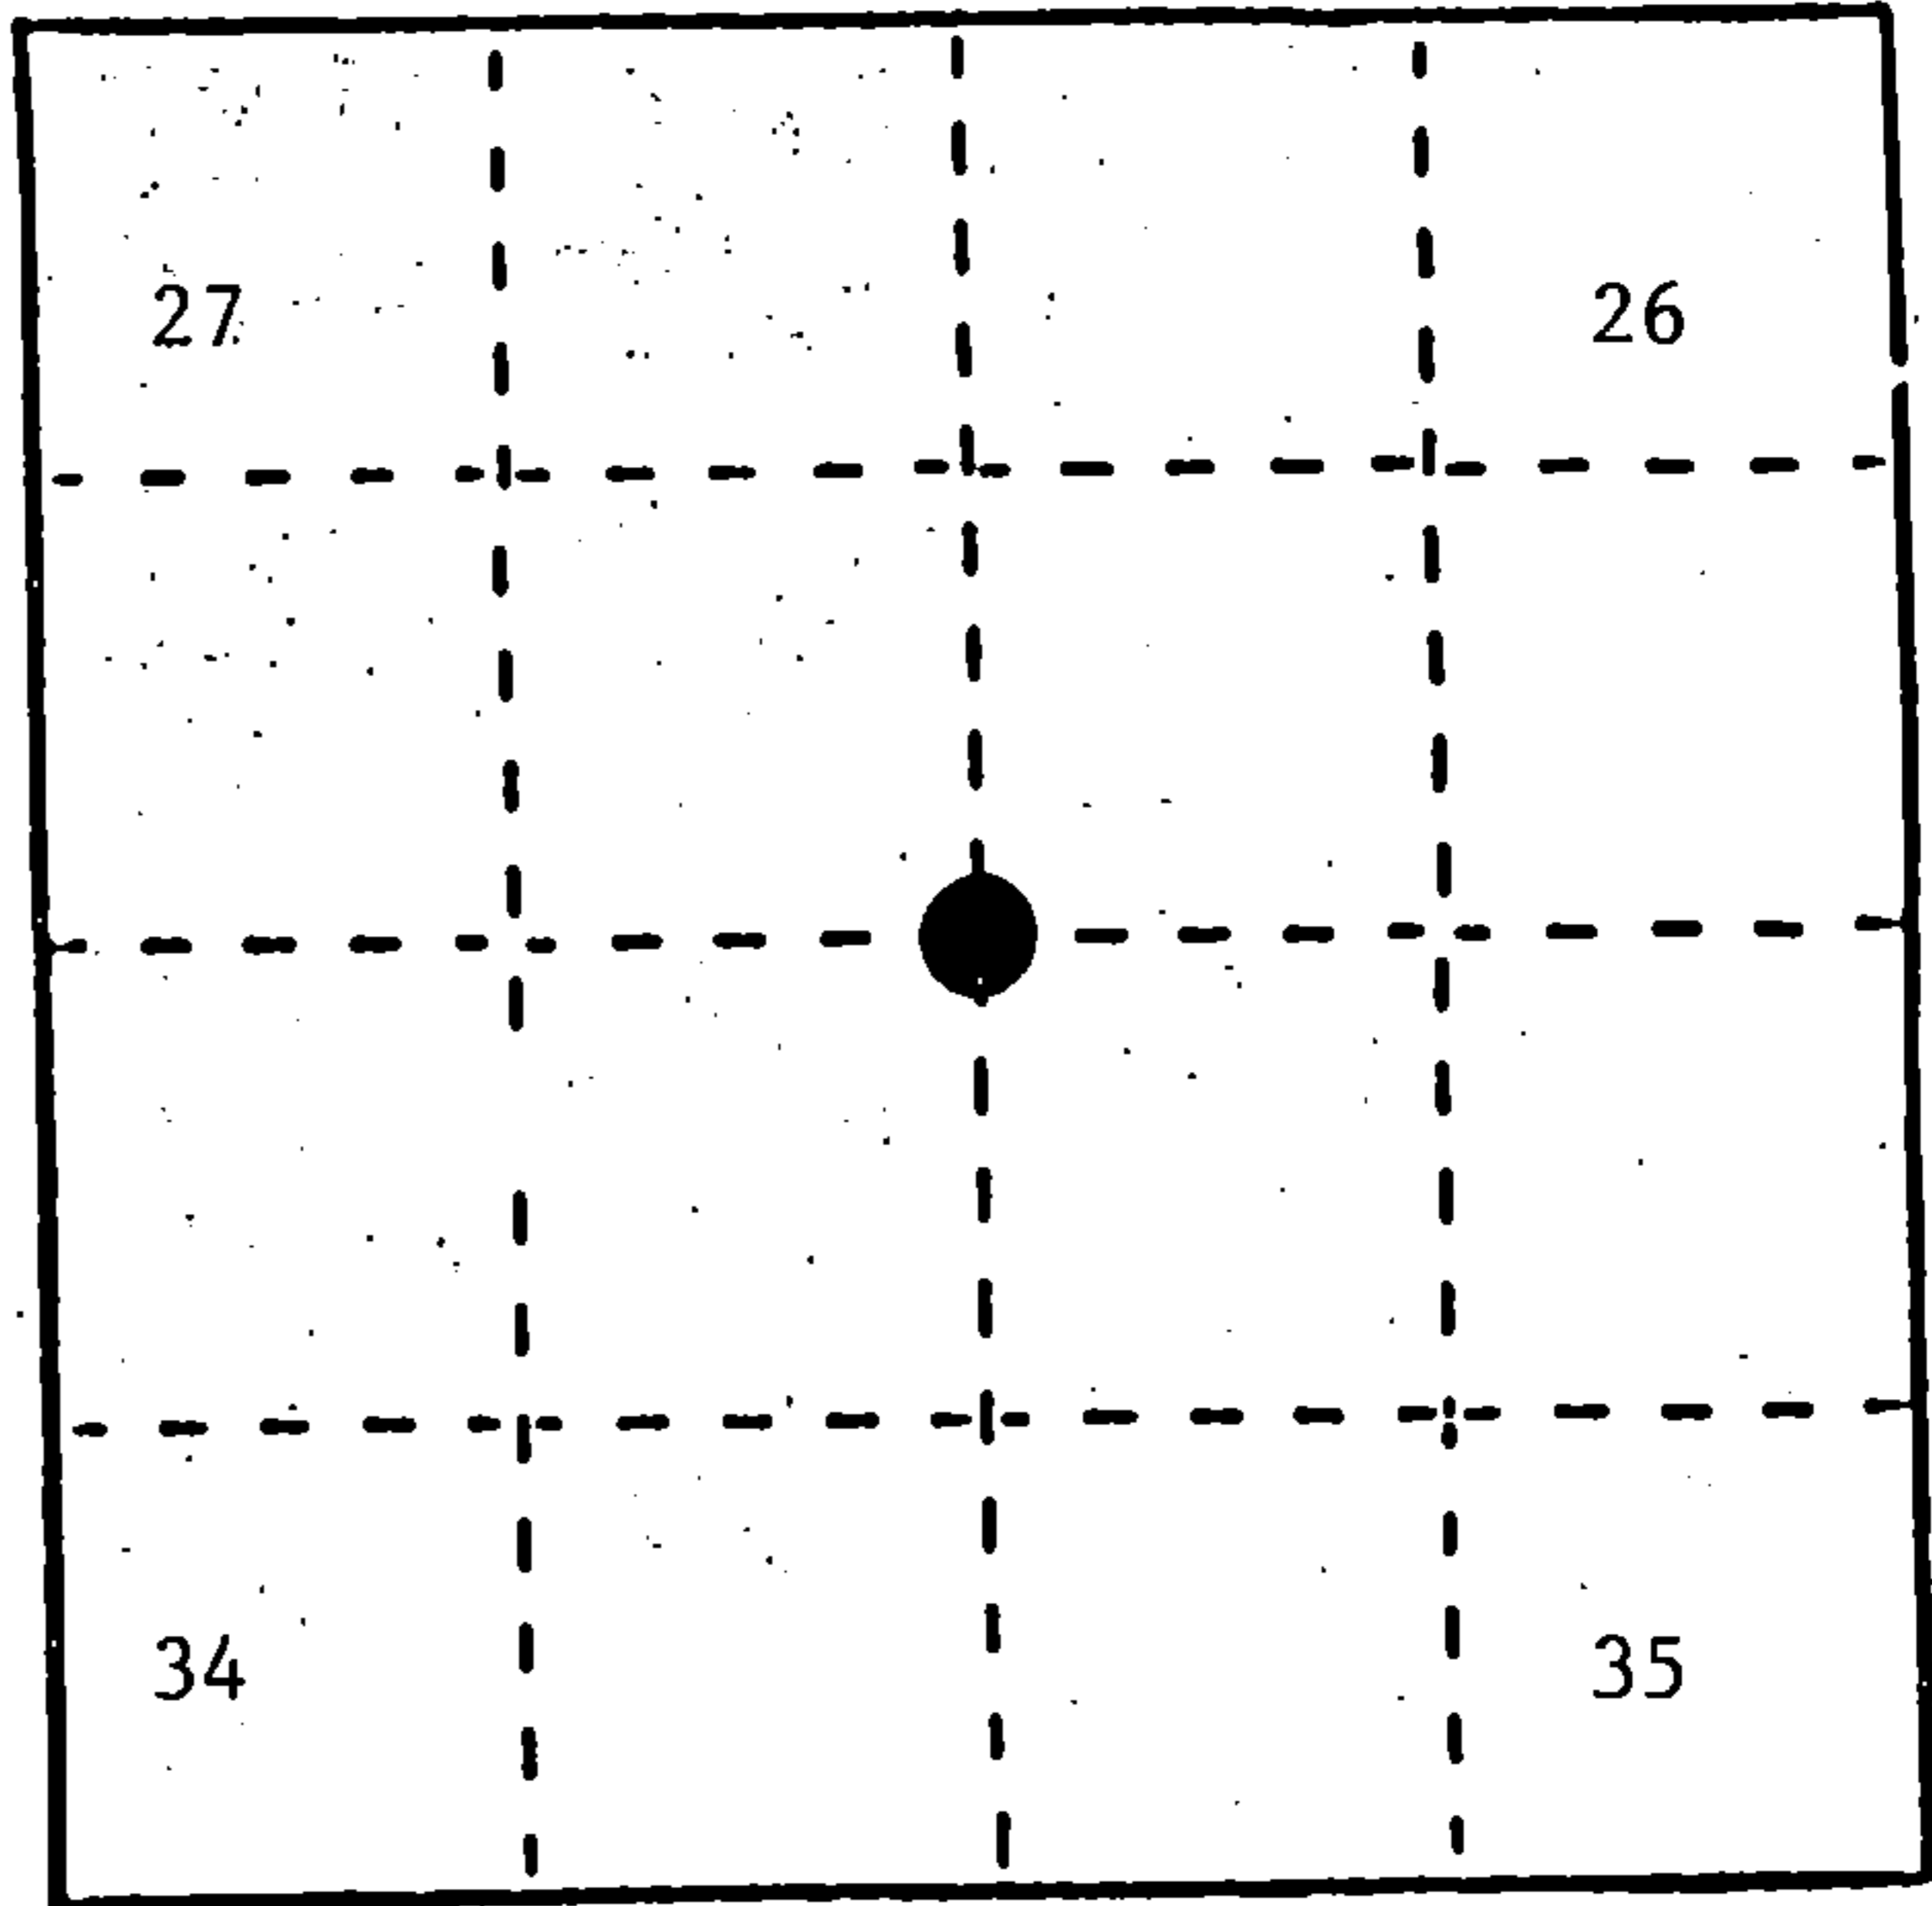

- (b) Describe any record evidence, monument evidence, occupational evidence, testimonial evidence or any other material evidence you considered, and whether the monument was found or placed.

In 1859, James McBride set wood post and made the following B.T.'s: Birch, 36", N.33°W., 13 links (8.58 feet); Hemlock, 12", N.48°E., 41 links (27.06 feet); Hemlock, 7", S.05°E., 24 links (15.84 feet); Sugar, 7", S.42°W., 15 links (9.90 feet).

In 1907, J. Melendy found original B.T.'s. He set a 4" x 4" Hemlock post and added the following B.T.'s: Maple, 10", N.74 1/2°W., 12.95 feet; Maple, 12", S.47 1/4°W., 27.80 feet.


In 1909, N. Smith found post set by Melendy. Original bearing trees okay. He added the following new B.T.: Hemlock, 16", N.80°-50'E., 34.76 feet.

In 1987, Al Harrison set traverse station in E of Town Road, off E of road north and old fence 24.80 feet south. Original corner and B.T.'s would fall in road right-of-way. Distance east and south to one quarter corner fits Melendy's 1907 distance within 0.10 feet. Accepted E of roads and fence line south as best evidence of corner location.

- (c) In the plan view drawing below, provide reference ties to at least 4 witness monuments, or, if the location is within a municipality, to at least 2 witness monuments. (Witness monuments shall be made of concrete, natural stone, iron or other equally durable material.) Describe witness monuments.

- (d) Show a plan view drawing depicting the relevant monuments and reference ties which is sufficient in detail to enable accurate relocation of the corner monument if the corner monument is disturbed. Indicate north.

1. Railroad spike in E of surfaced road marking corner location.
2. 2 1/2" x 36" aluminum monument, witness corner, South, 23.16 feet.
3. Sugar, 4", S.06°E., 37.84 feet.
4. Sugar, 14", N.66°W., 94.75 feet.
5. Sugar, 4", N.13°W., 86.89 feet.
6. Steel Sign Post, 6 feet, South, 23.86 feet.

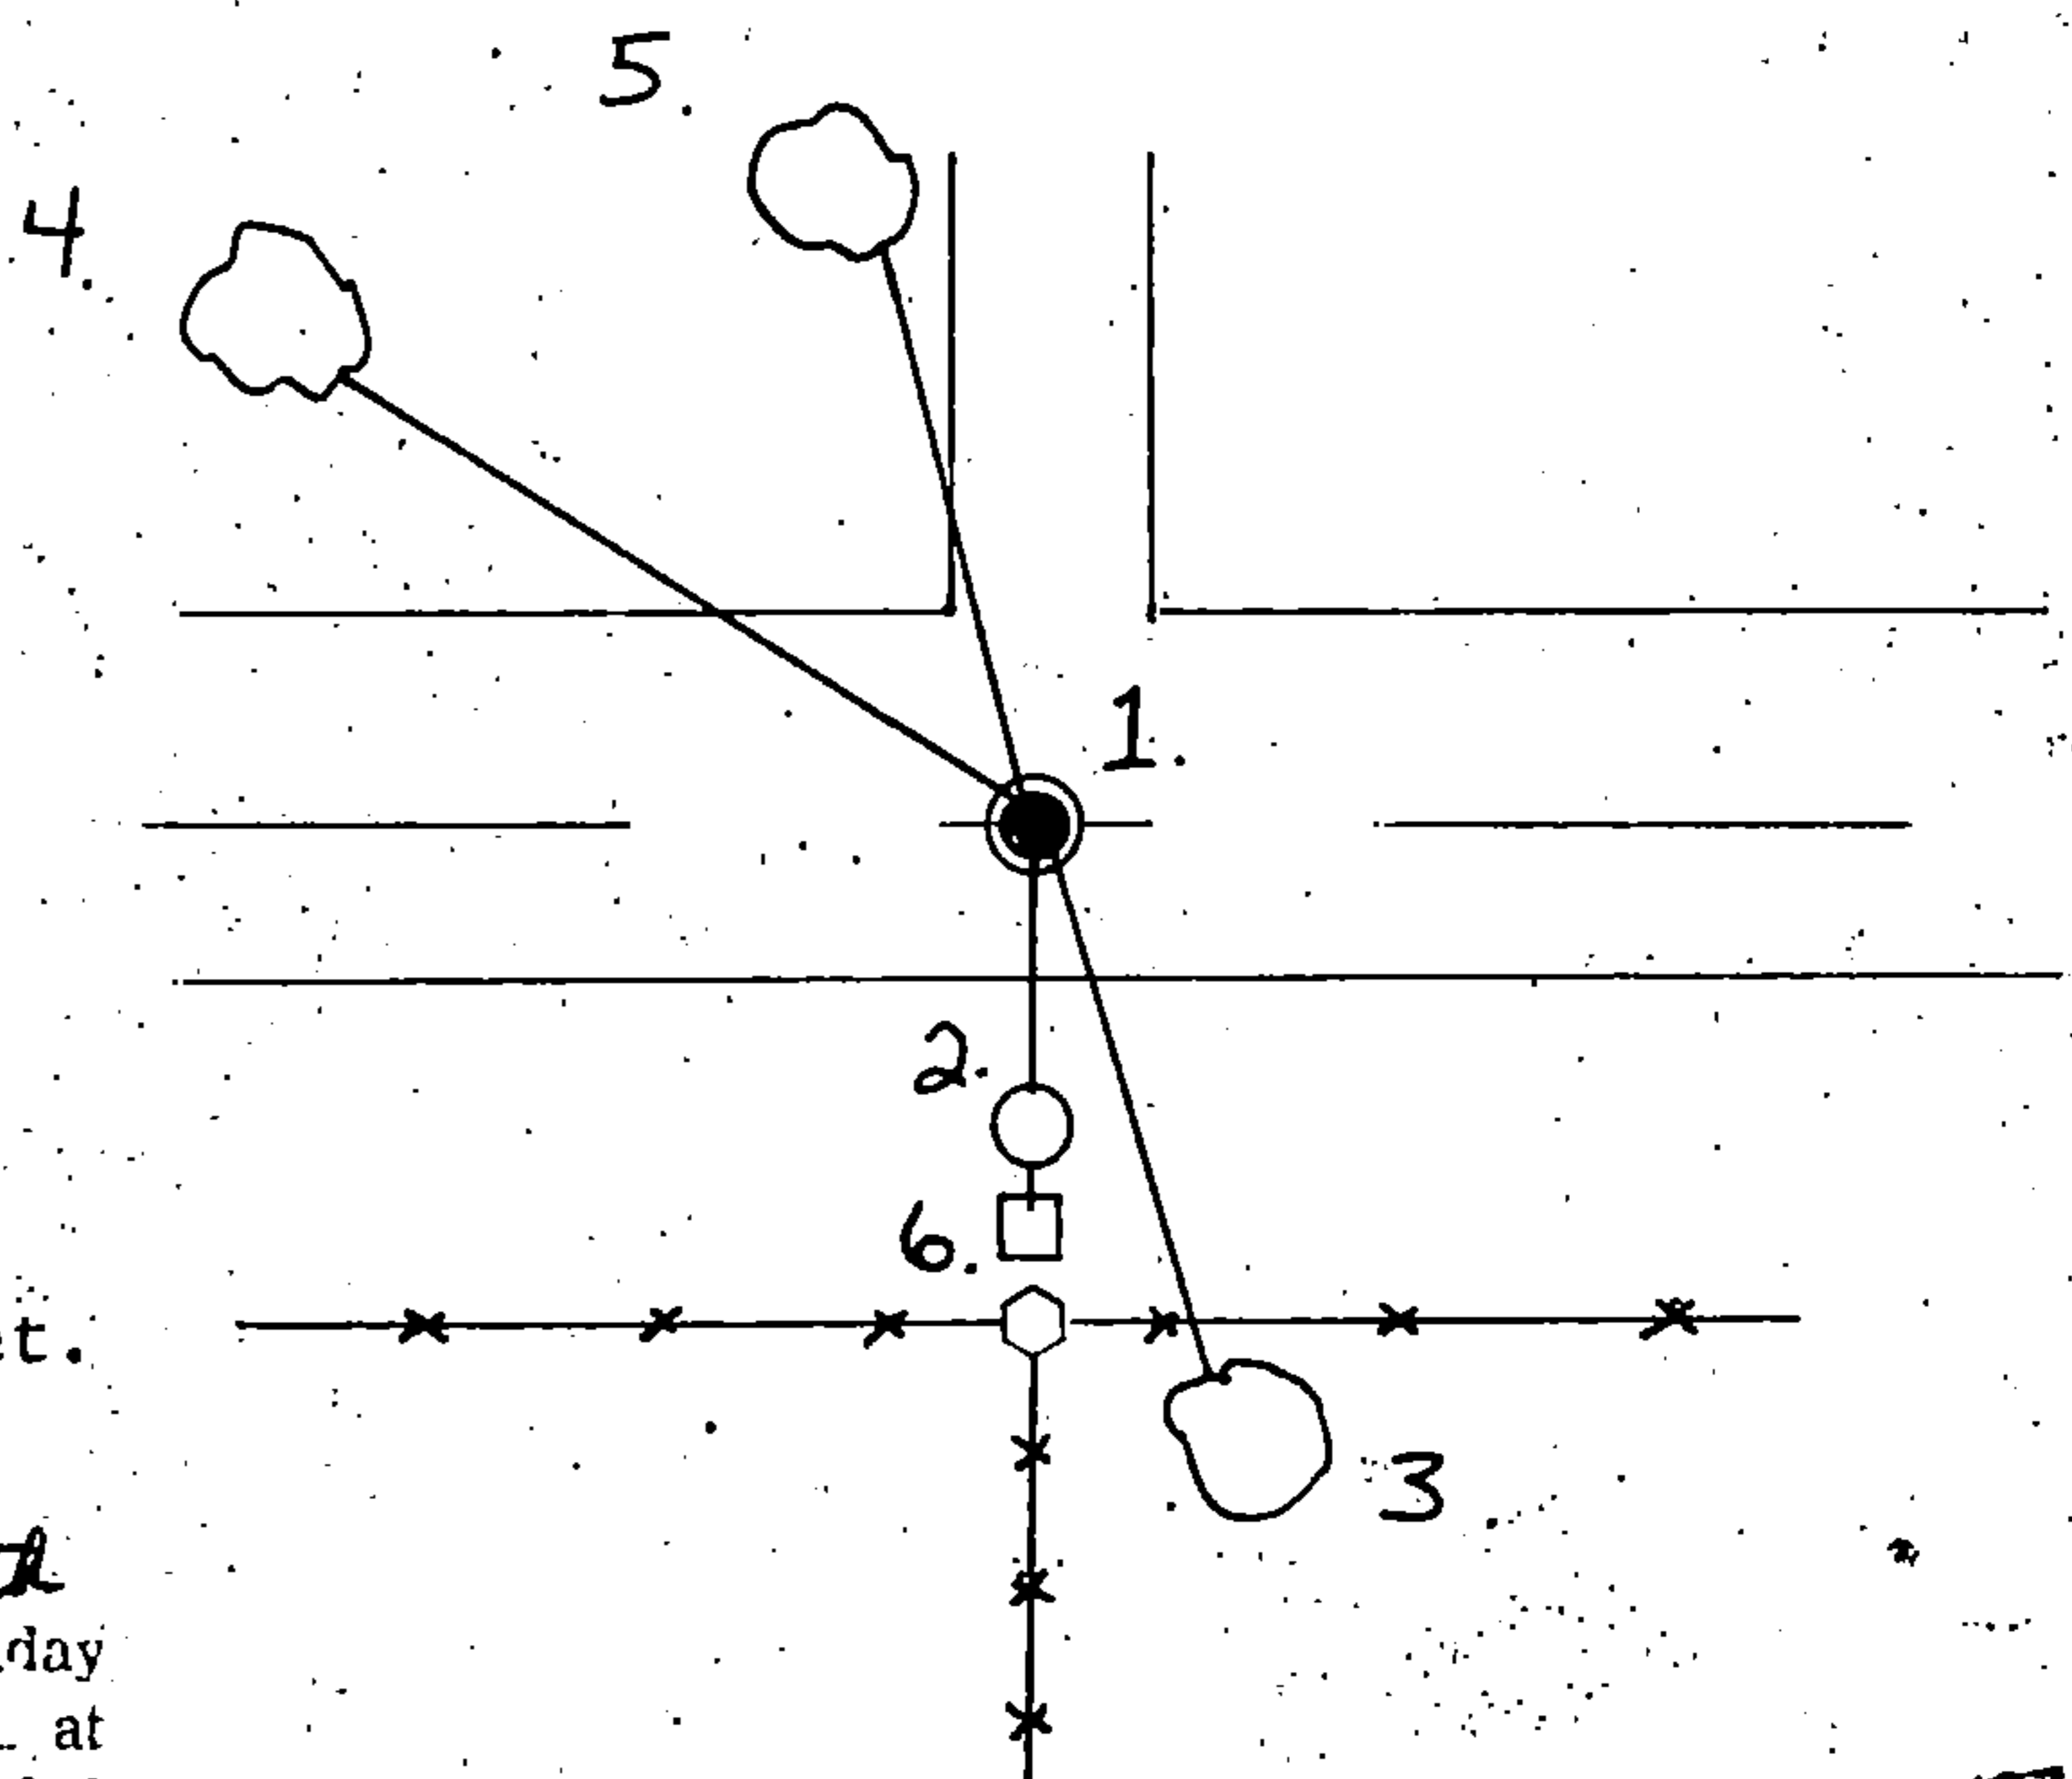

REGISTER'S OFFICE
Forest County, Wis.

Received for record this 29th day of March A.D., 1990 at 10:00 o'clock A.M. and recorded in Vol. CORNER RESTORATIONS page V-17

Paul Hechenbrenner
Register of Deeds

V17

(e) Describe any material discrepancy between the location of the corner as restored or reestablished and the location of that corner as previously restored or reestablished by distance and direction. Show the discrepancy on the plan view drawing under (d), above. Show the distances between the corner as previously restored or reestablished and (1) the corner as restored or reestablished, and (2) to at least 2 of the witness monuments shown on the drawing in (d), above.

None.

(f) Was the corner restored through acceptance of (1) an obliterated evidence location, or, (2) a found perpetuated location?


(1) an obliterated evidence location

(g&h) Was the corner reestablished through lost corner proportionate methods? If so, show the method, including the directions and distances to other public land survey corners used as evidence or used for proportioning in determining the corner location?

No.

(i) I, Alan D. Harrison
(type or print name) certify that the corner location shown on this record was determined by me or under my direction and control and that this U.S. Public Land Survey Monument Record is correct and complete to the best of my knowledge and belief.

Alan D. Harrison 3/12/90
Signature Date

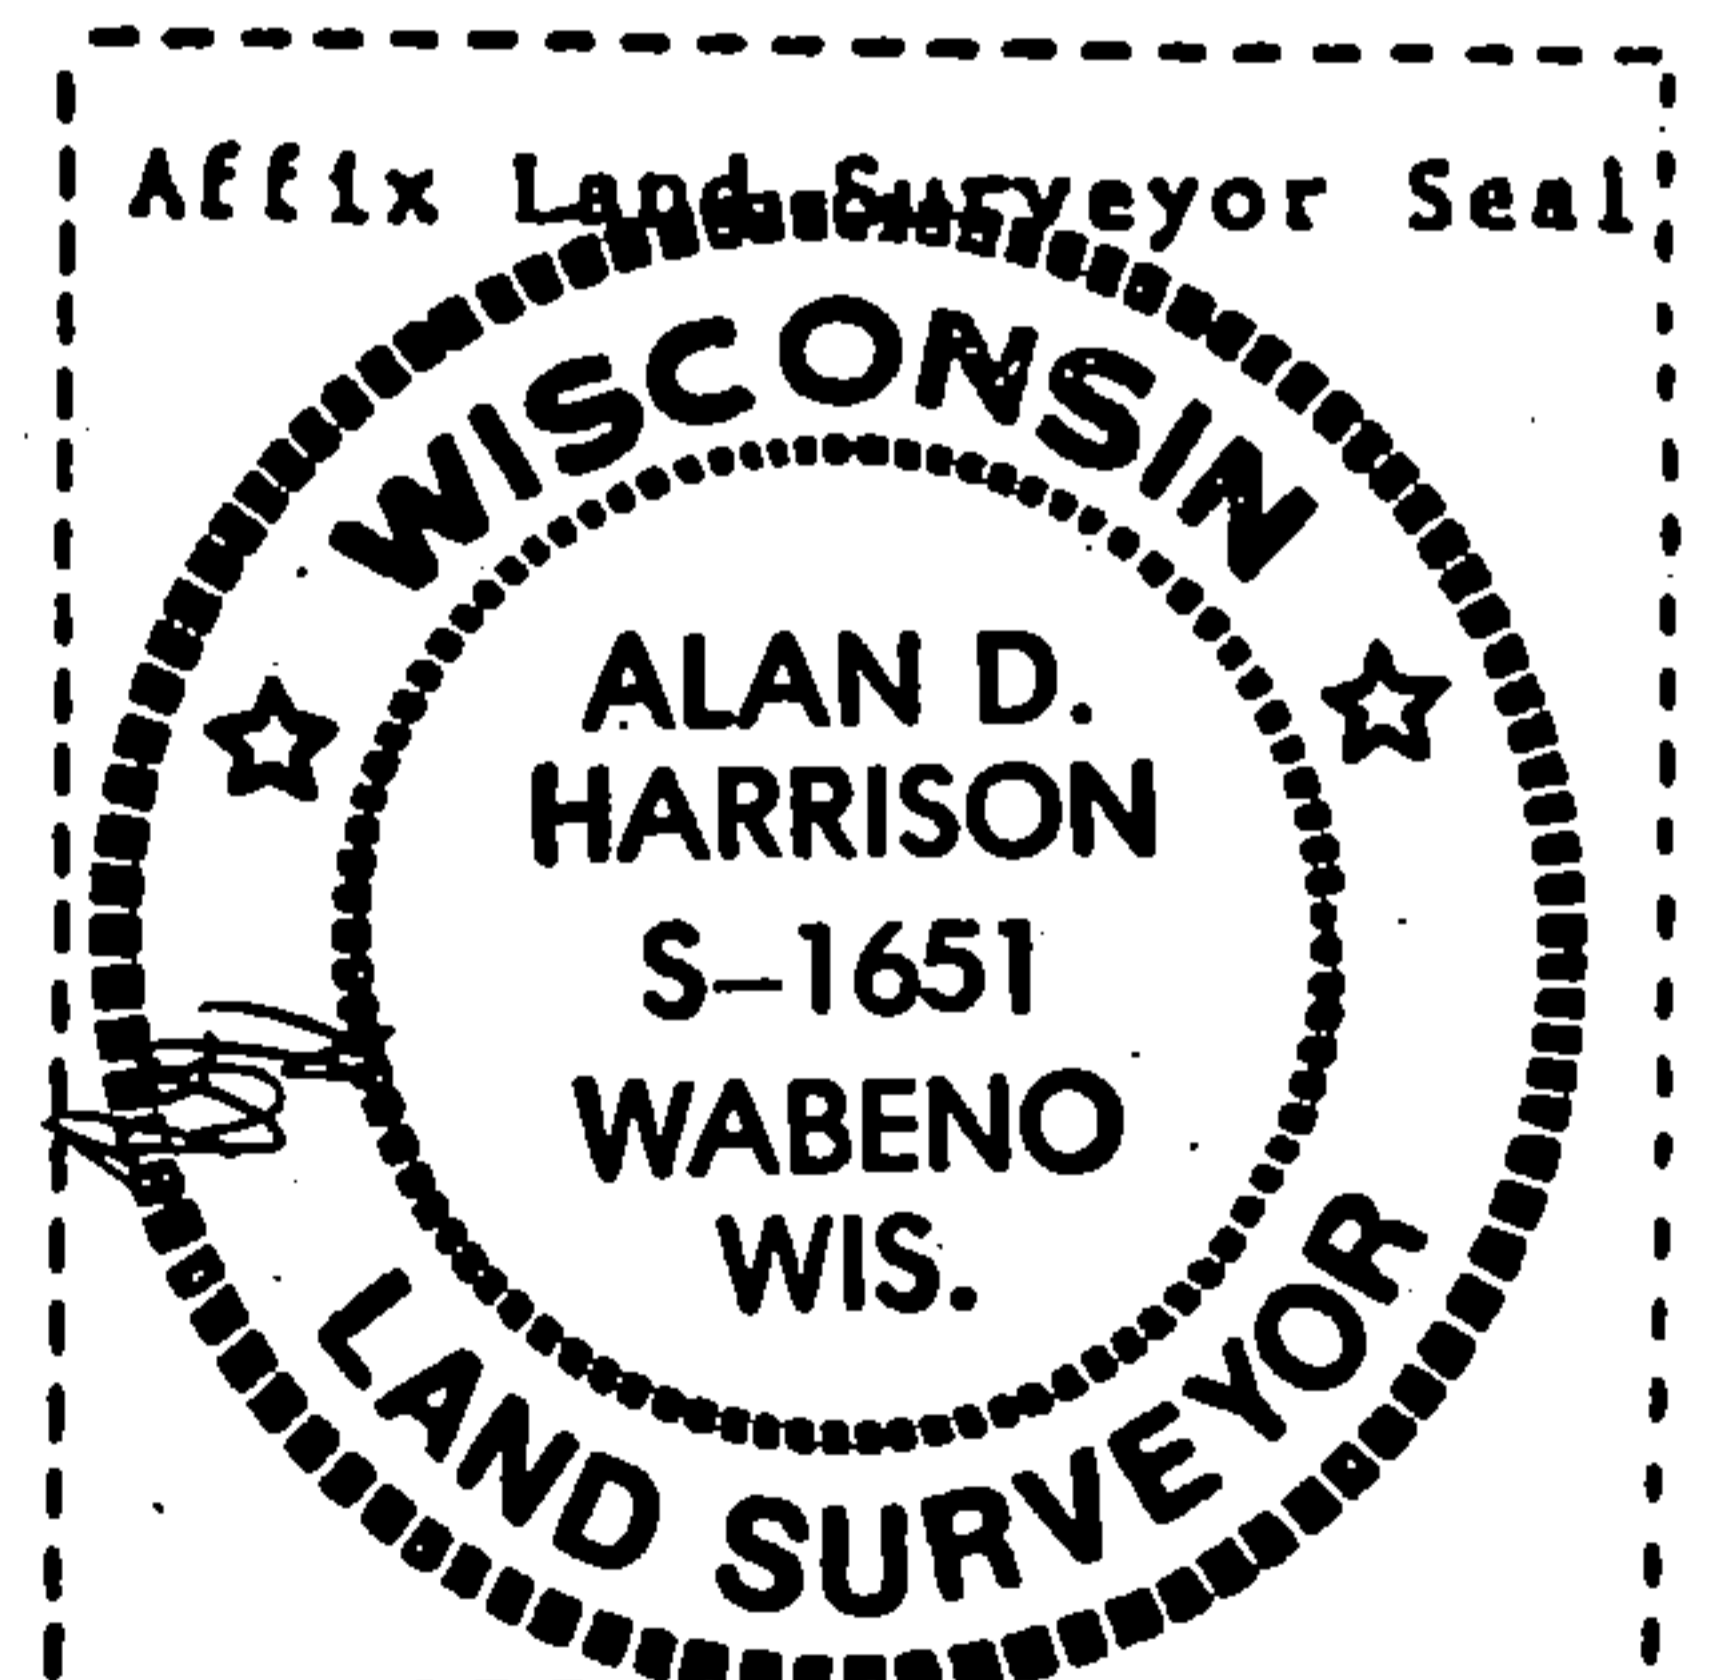

CERTIFICATE READY FOR FILING:

Dale B. Stage
District Ranger