

U. S. PUBLIC LAND SURVEY MONUMENT RECORD

INSTRUCTIONS:

This record shall show the location of the corner and shall include all of the following nine elements (a through i).


- (a) Identify the corner by reference to the U.S. public land survey system.

○ = Corner monument restored.

Quarter Corner to Sections 26 and 27,
T.34N. R.14E., Forest County, Wisconsin

State Plane Coordinates
Wisconsin North Zone
87929.74763-N
2297649.63316-E

Geographic Coordinates
45-24-01.88040-N
088-43-07.05351-W

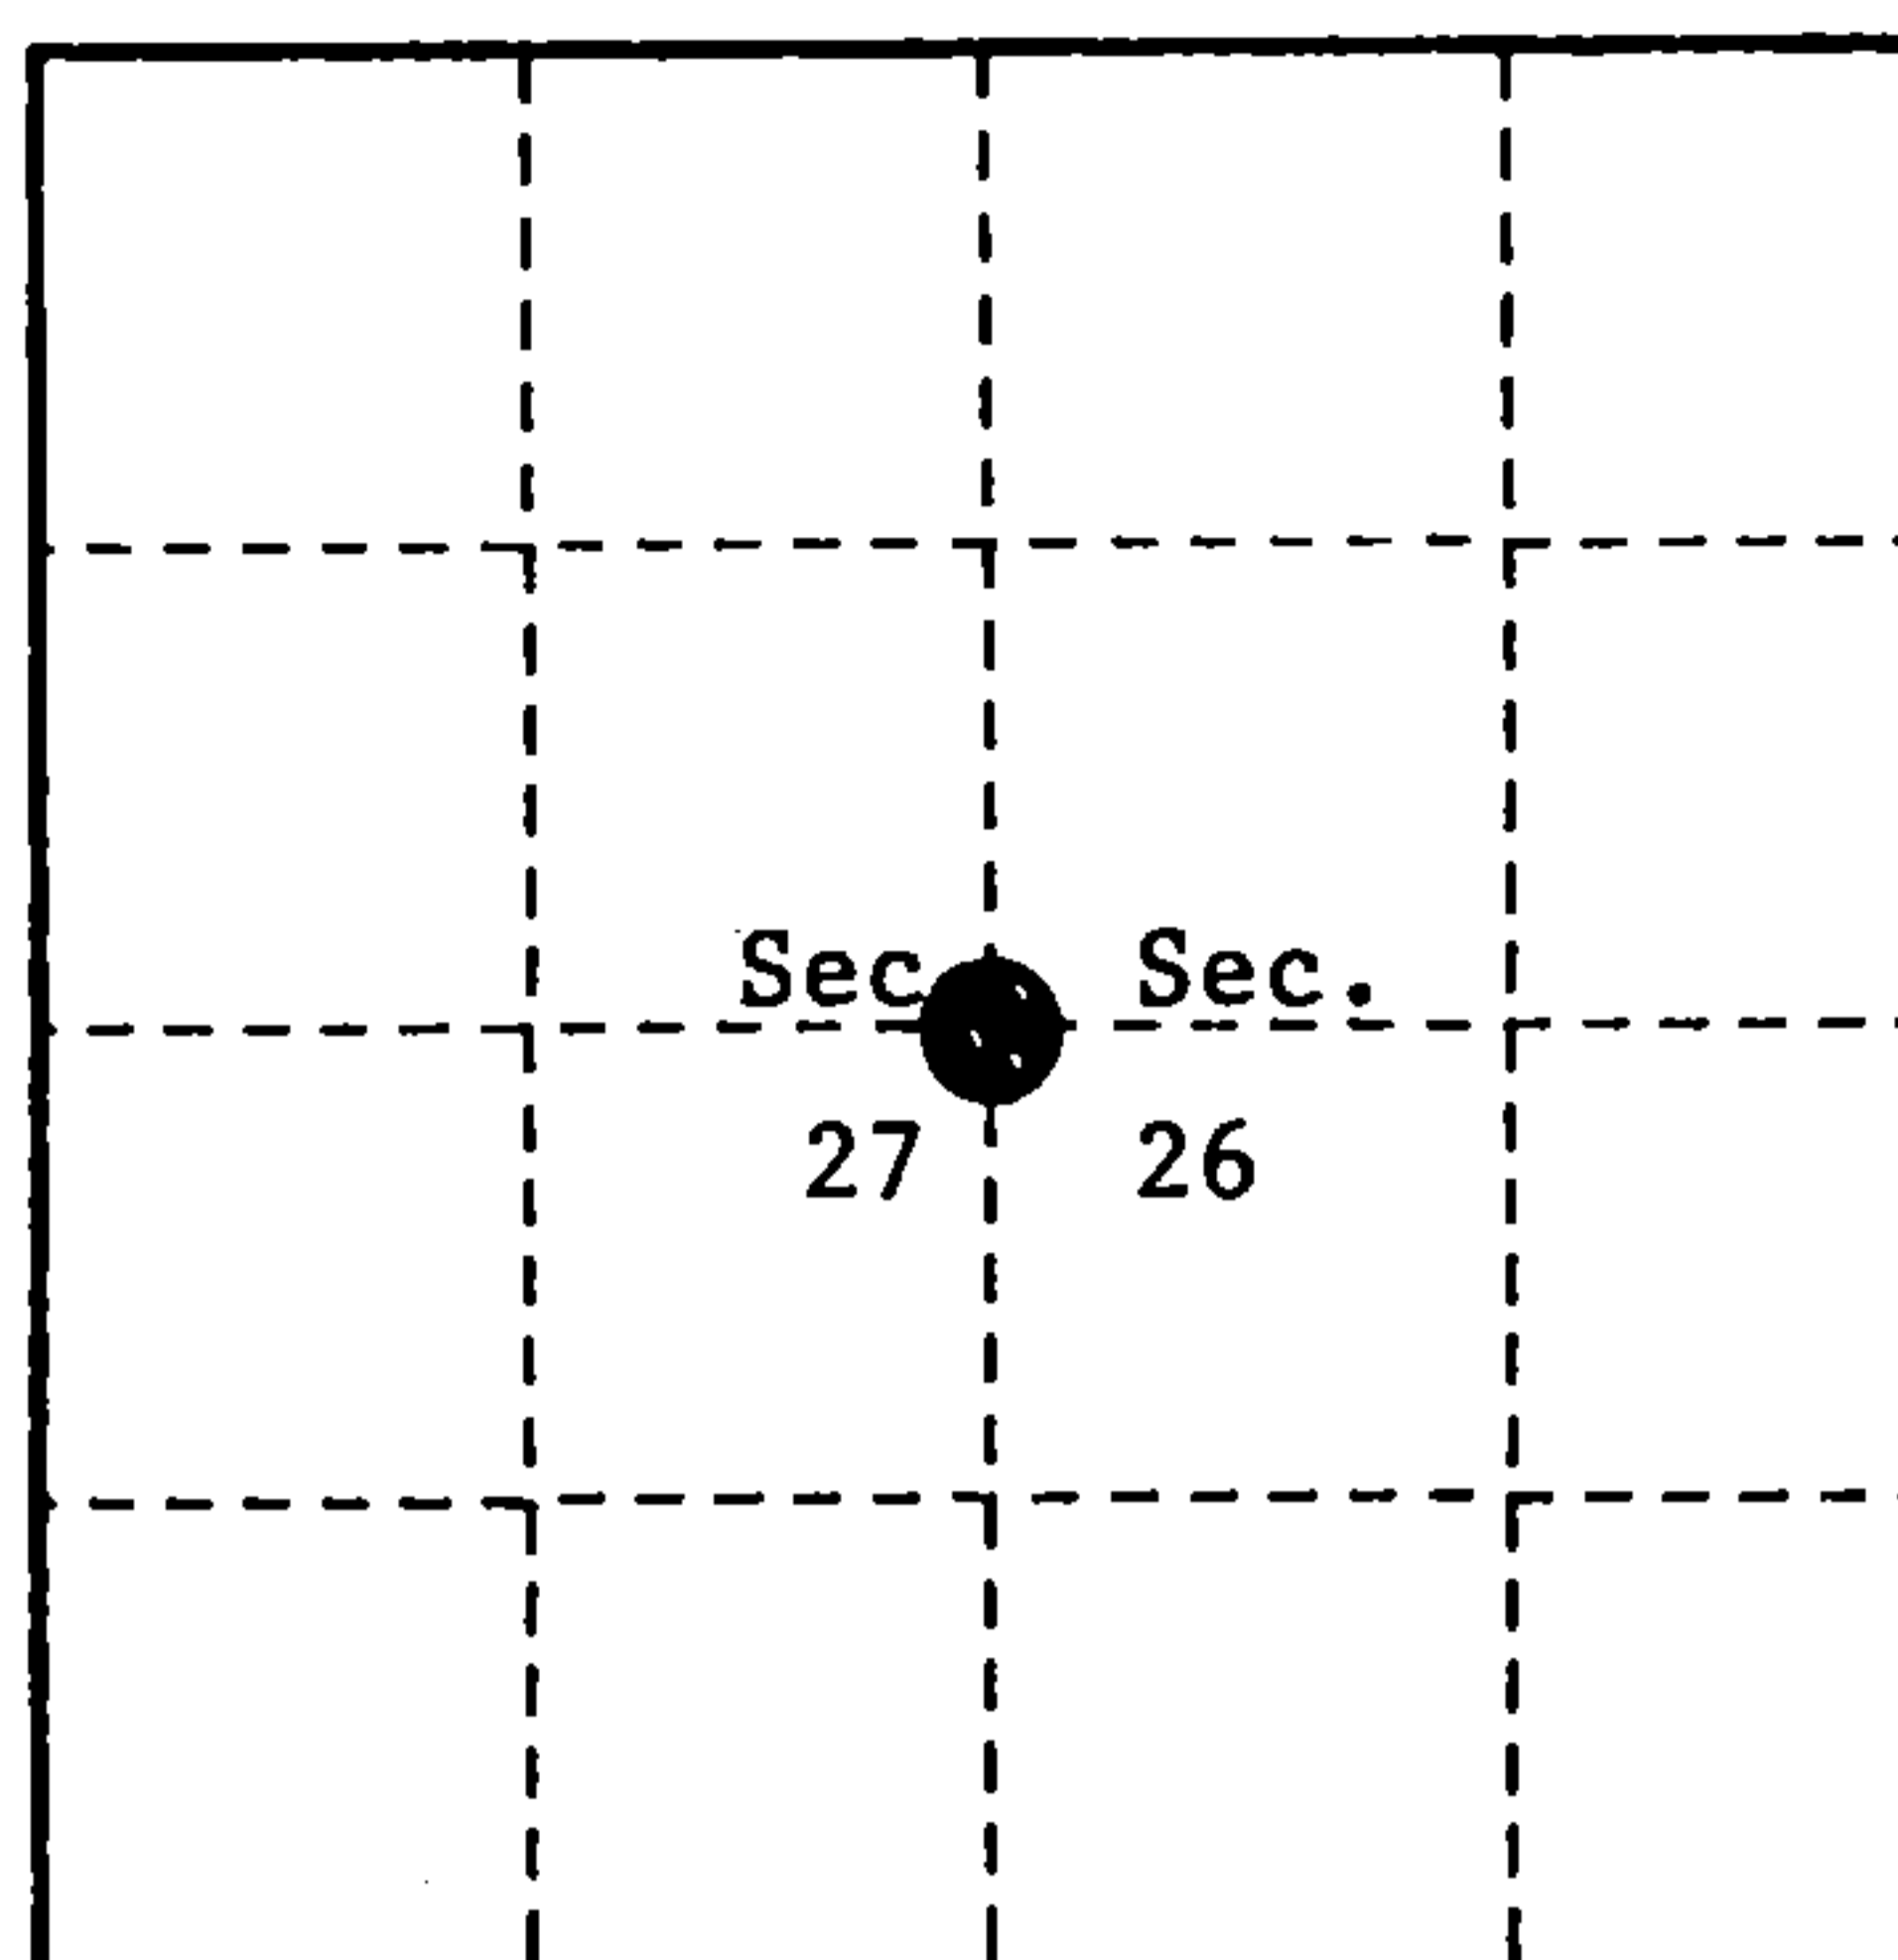

- (b) Describe any record evidence, monument evidence, occupational evidence, testimonial evidence or any other material evidence you considered, and whether the monument was found or placed.

In 1859 James McBride set a wood post and the following bearing trees; Tamarack, 10", N.70°E., 12 links(7.92 feet), Tamarack, 10", N.67°W., 24 links(15.84 feet), South 2.00 chains, stream 6 links wide.

In 1908 J. Melindy (RLS) re-established the corner position and set a 5"x5" cedar post and the following bearing trees; Tamarack, 10", N.37°W., 7.59 feet, Tamarack, 6", N.63½°E., 11.44 feet

In 1909 Nathan Smith (RLS) found Melindy's post from 1908.

In 1922, Nathan Smith (RLS) set a new corner post. Did not recover previous post.


In 1923, Nathan Smith (RLS) measured 40.59 chains from the Section Corner to the North. Then measured 20.30 chains to the South 1/8th corner.

On 12-1-93, Alan Harrison (RLS) restored the corner position at proportionate distance (which is mid-point) and on line between opposing Section Corners. Set 2 Witness Corner Monuments as noted below.

No other corner evidence was recovered.

- (c) In the plan view drawing below, provide reference ties to at least 4 witness monuments, or, if the location is within a municipality, to at least 2 witness monuments. (witness monuments shall be made of concrete, natural stone, iron or other equally durable material.)

- (d) Show a plan view drawing depicting the relevant monuments and reference ties which is sufficient in detail to enable accurate relocation of the corner monument if the corner monument is disturbed. Indicate north.

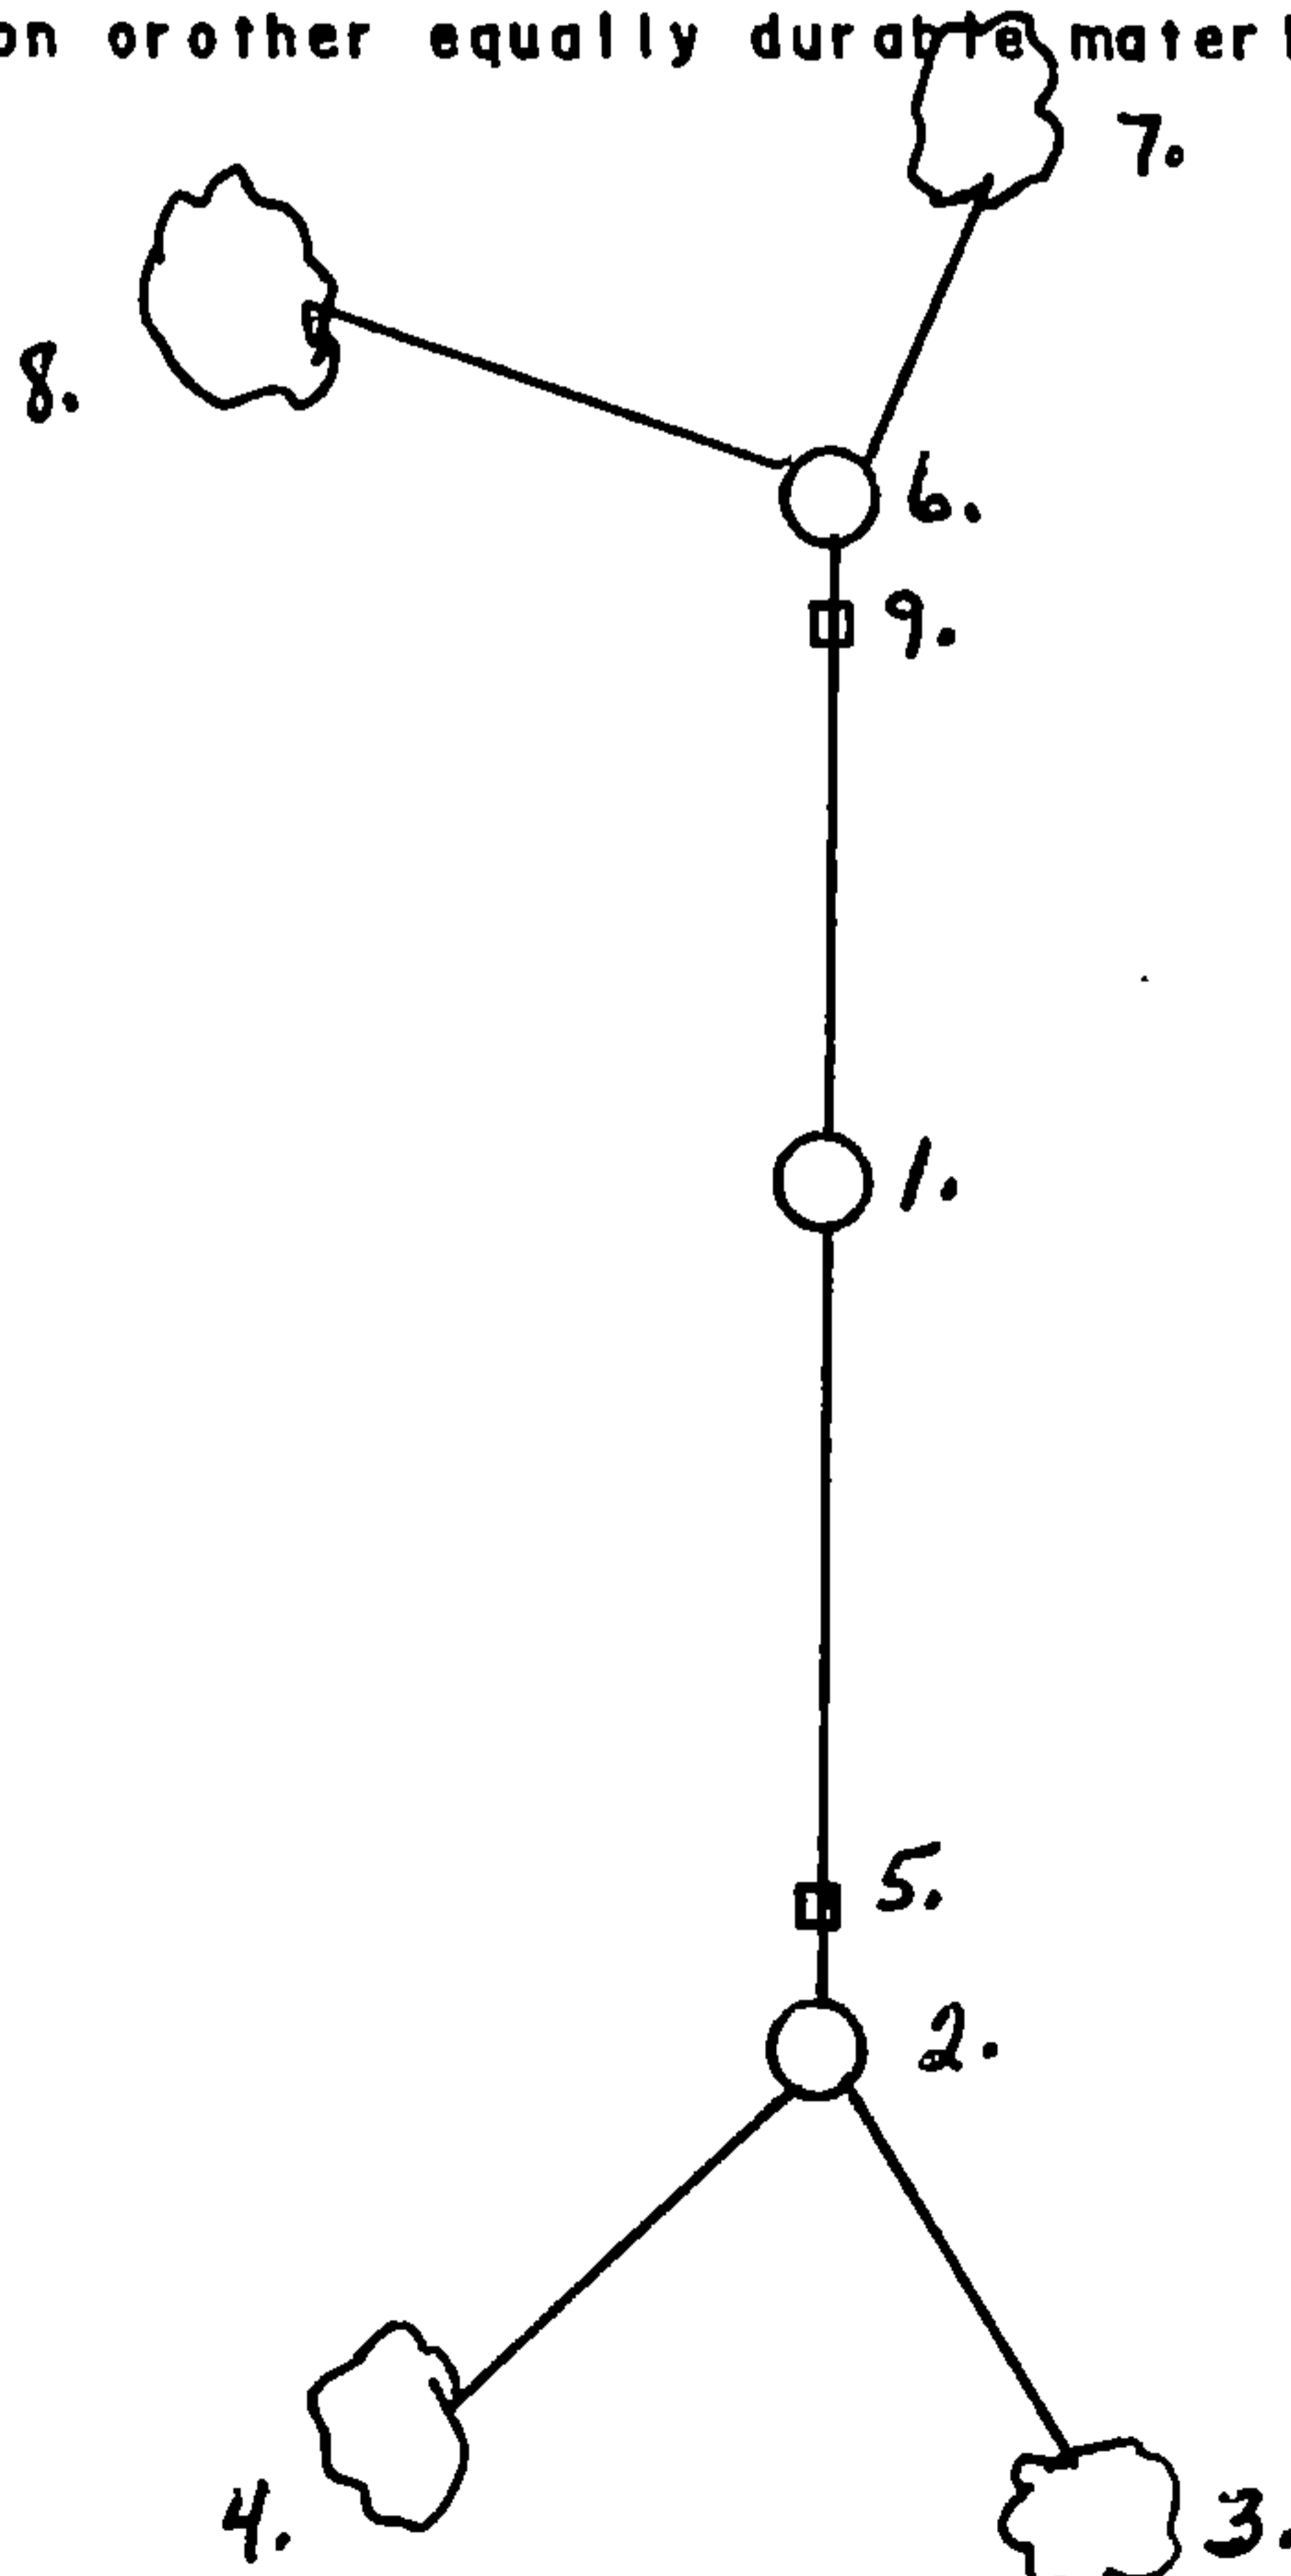

1. True corner position not monumented.
2. 2½" x 36" Aluminum Monument for Witness Corner, S.00°-55'-20"W., 658.81 ft.
3. Spruce, 12", S.30°E., 52.92 ft.
4. Aspen, 7", S.46°W., 37.04 feet
5. Steel Sign Post, North, 0.97 ft.
6. 2½" x 60" Aluminum Monument for Witness Corner, N.00°-55'-20"E., 212.58 ft.
7. Spruce, 6", N.29°E., 78.36 ft.
8. Aspen, 6", N.65°W., 69.14 ft.
9. Steel Sign Post, South, 1.26 ft.

(e) Describe any material discrepancy between the location of the corner as restored or reestablished and the location of that corner as previously restored or reestablished by distance and direction. Show the discrepancy on the plan view drawing under (d), above. Show the distances between the corner as previously restored or reestablished and (1) the corner as restored or reestablished, and (2) to at least 2 of the witness monuments shown on the drawing in (d), above.


None.

(f) Was the corner restored through acceptance of (1) an obliterated evidence location, or, (2) a found perpetuated location?


No

(g & h) Was the corner reestablished through lost corner proportionate methods? If so, show the method, including the directions and distances to other public land survey corners used as evidence or used for proportioning in determining the corner location?

Yes

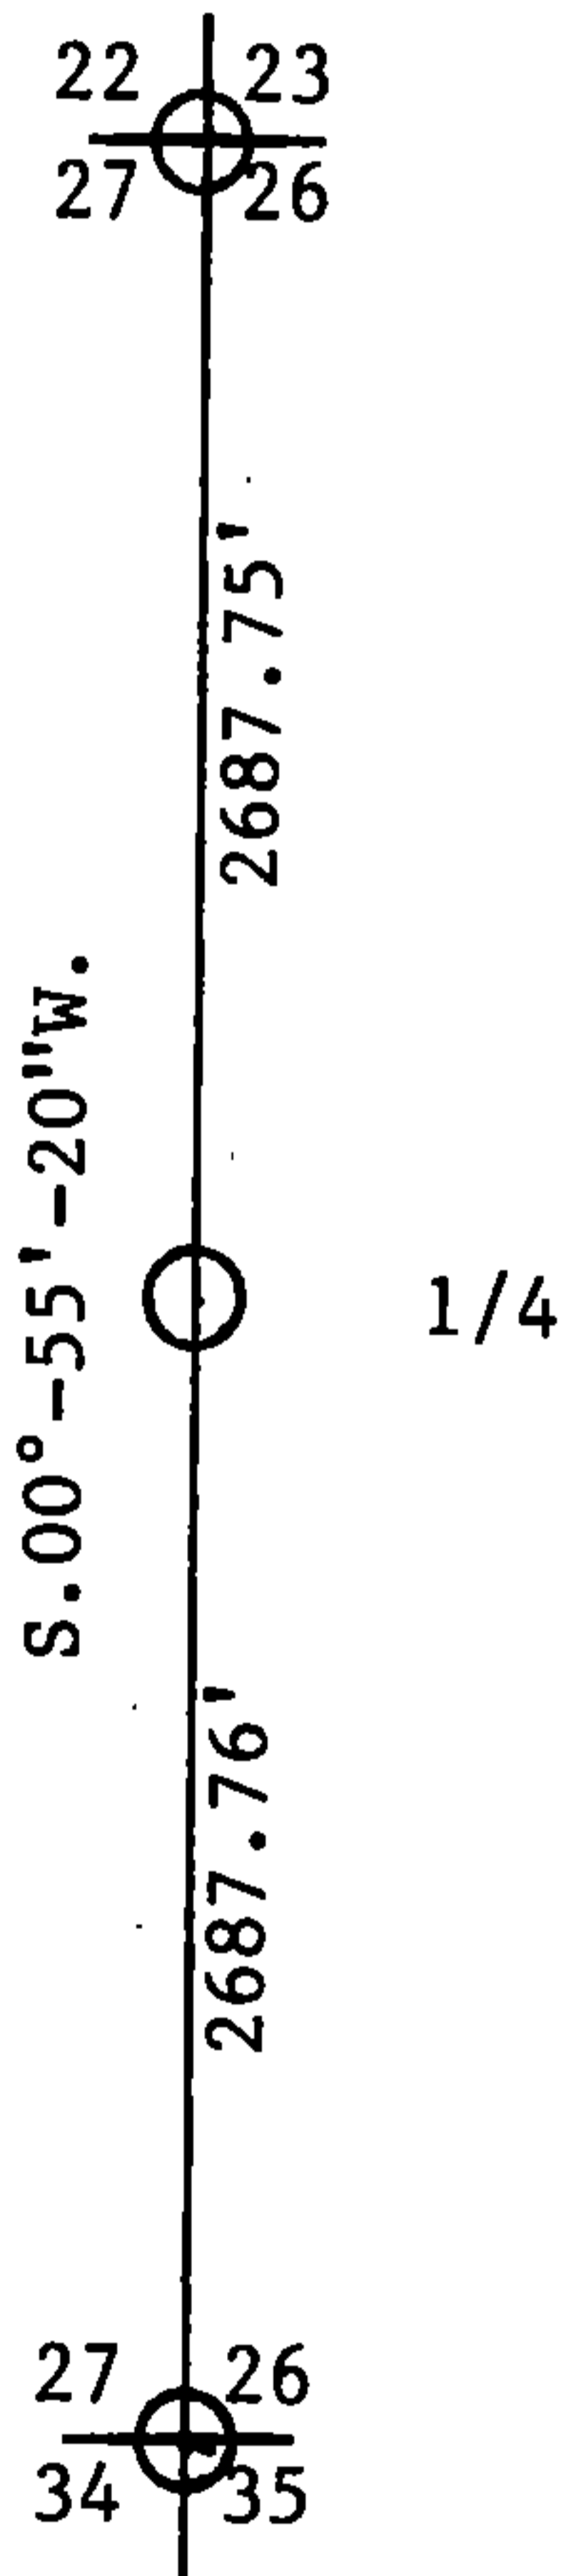

REGISTER'S OFFICE }
 Forest County, Wis. }
 Received for record this 23rd day
 of March A.D., 1994 at
9:00 o'clock A.M. and recorded
 in Vol. Case Restorations
 page 34-14, T-17
Paul Little, Deputy
 Register of Deeds

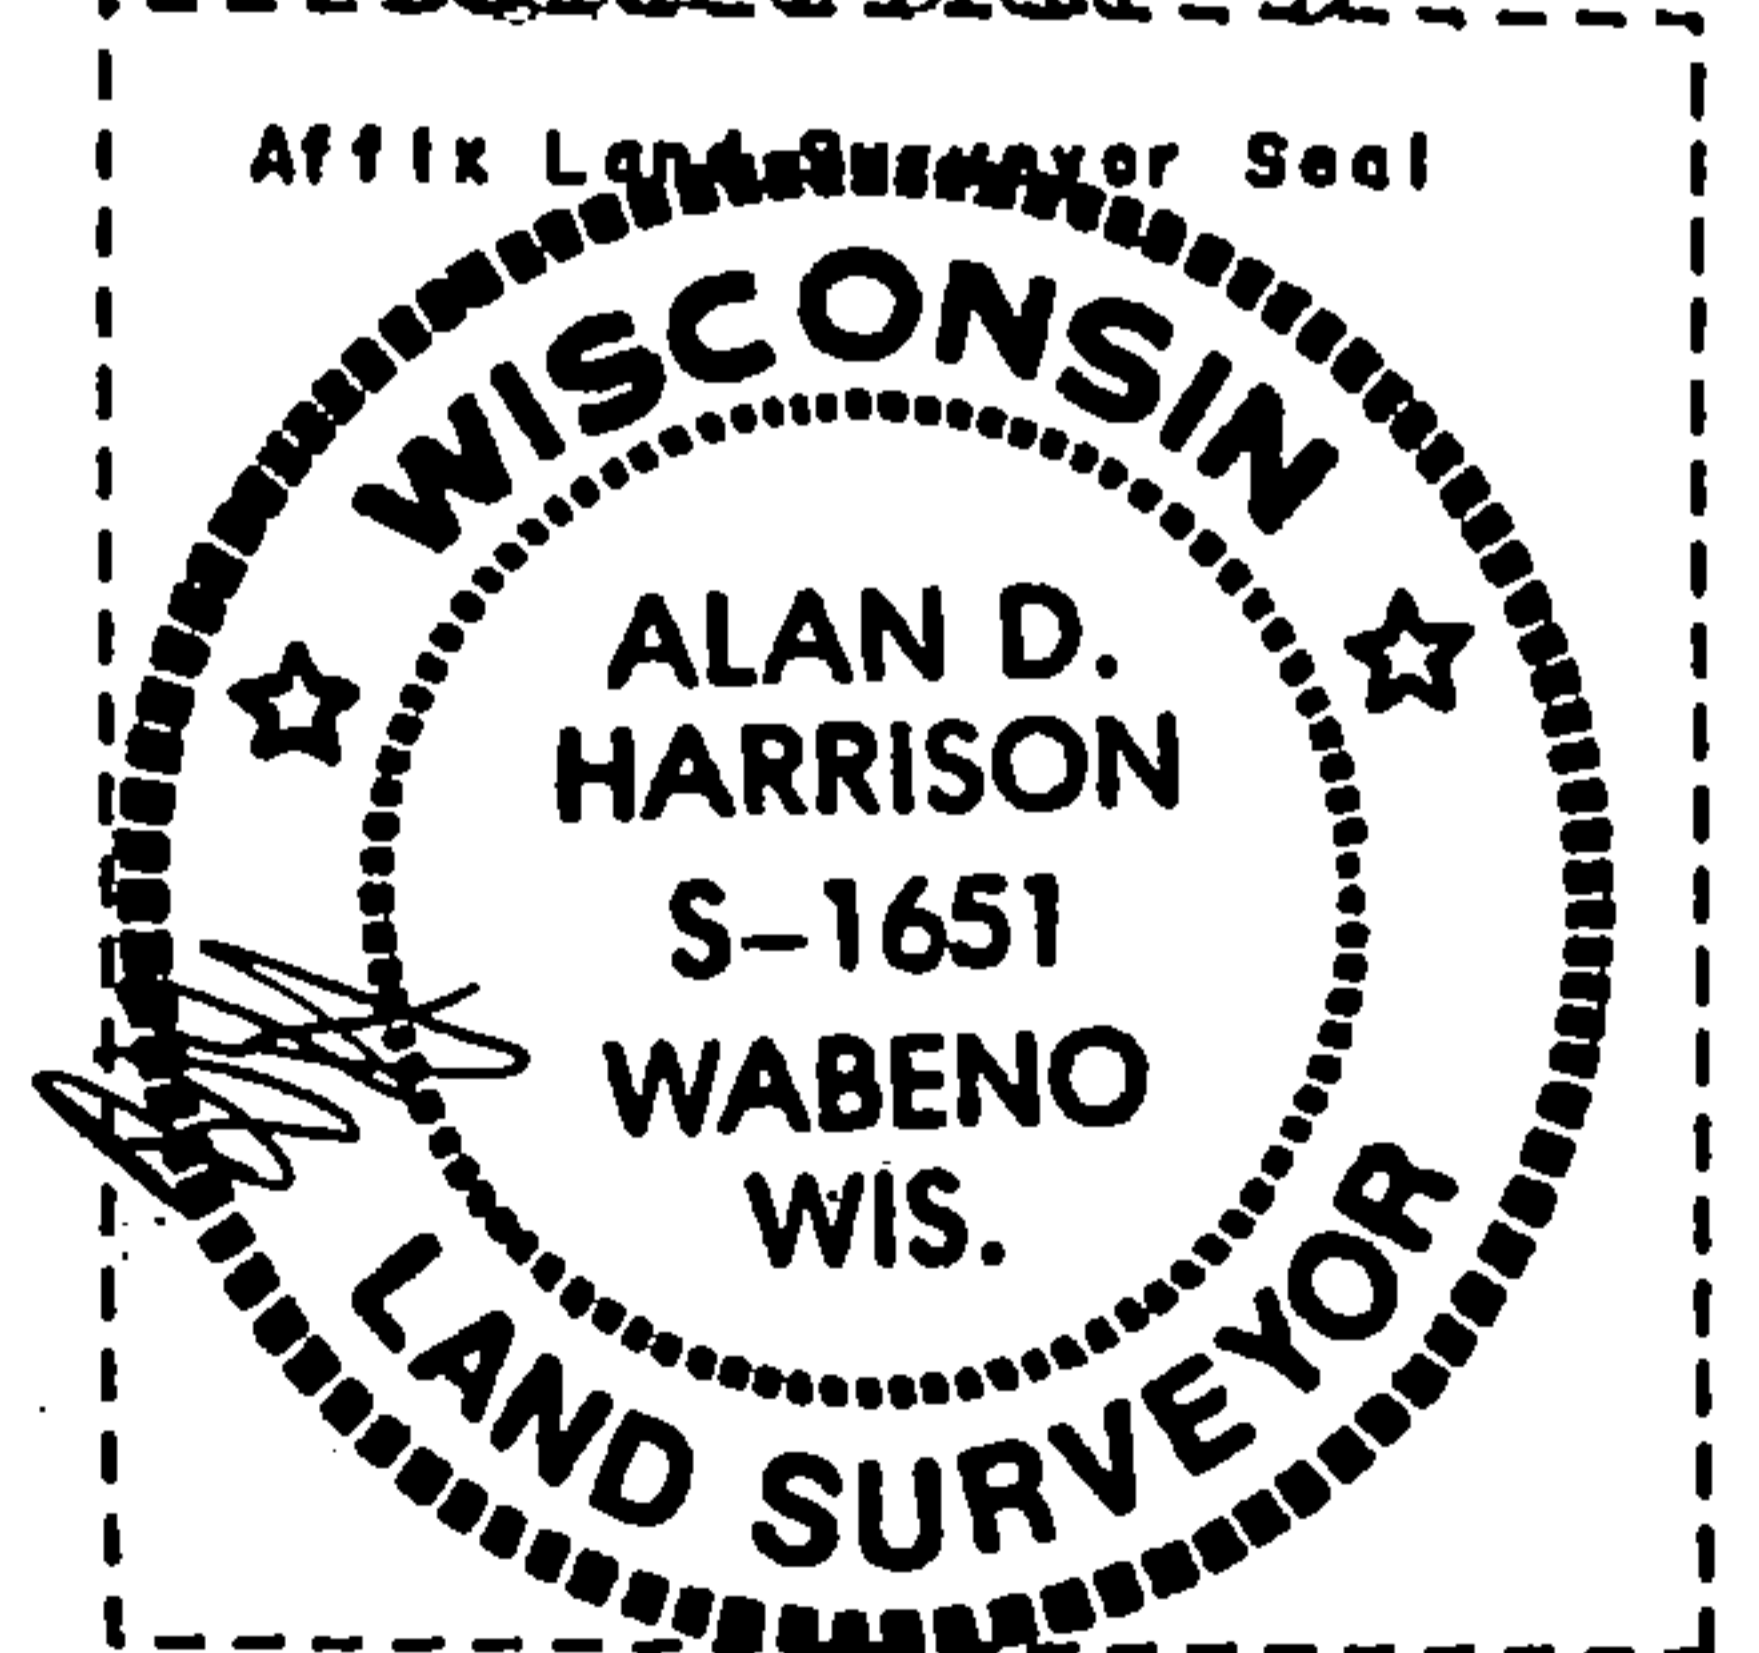

(1) I, Alan D. Harrison

(type or print name) certify that the corner location shown on this record was determined by me or under my direction and control and that this U.S. Public Land Survey Monument Record is correct and complete to the best of my knowledge and belief.

Alan D. Harrison 10/26/94
 Signature Date

CERTIFICATE READY FOR FILING: Sue Vap
 District Ranger