

U. S. PUBLIC LAND SURVEY MONUMENT RECORD

INSTRUCTIONS:


This record shall show the location of the corner and shall include all of the following nine elements (a through i).

- (a) Identify the corner by reference to the U.S. public land survey system.
- - Corner monument restored.

Section Corner to Sections 29, 30, 31 and 32, T.34N., R.14E., Forest County, Wisconsin.

State Plane Coordinates
 Wisconsin North Zone
 84903.60886-N
 2281679.15705-E

Geographic Coordinates
 45-23-34.48975-N
 088-46-51.49039-W

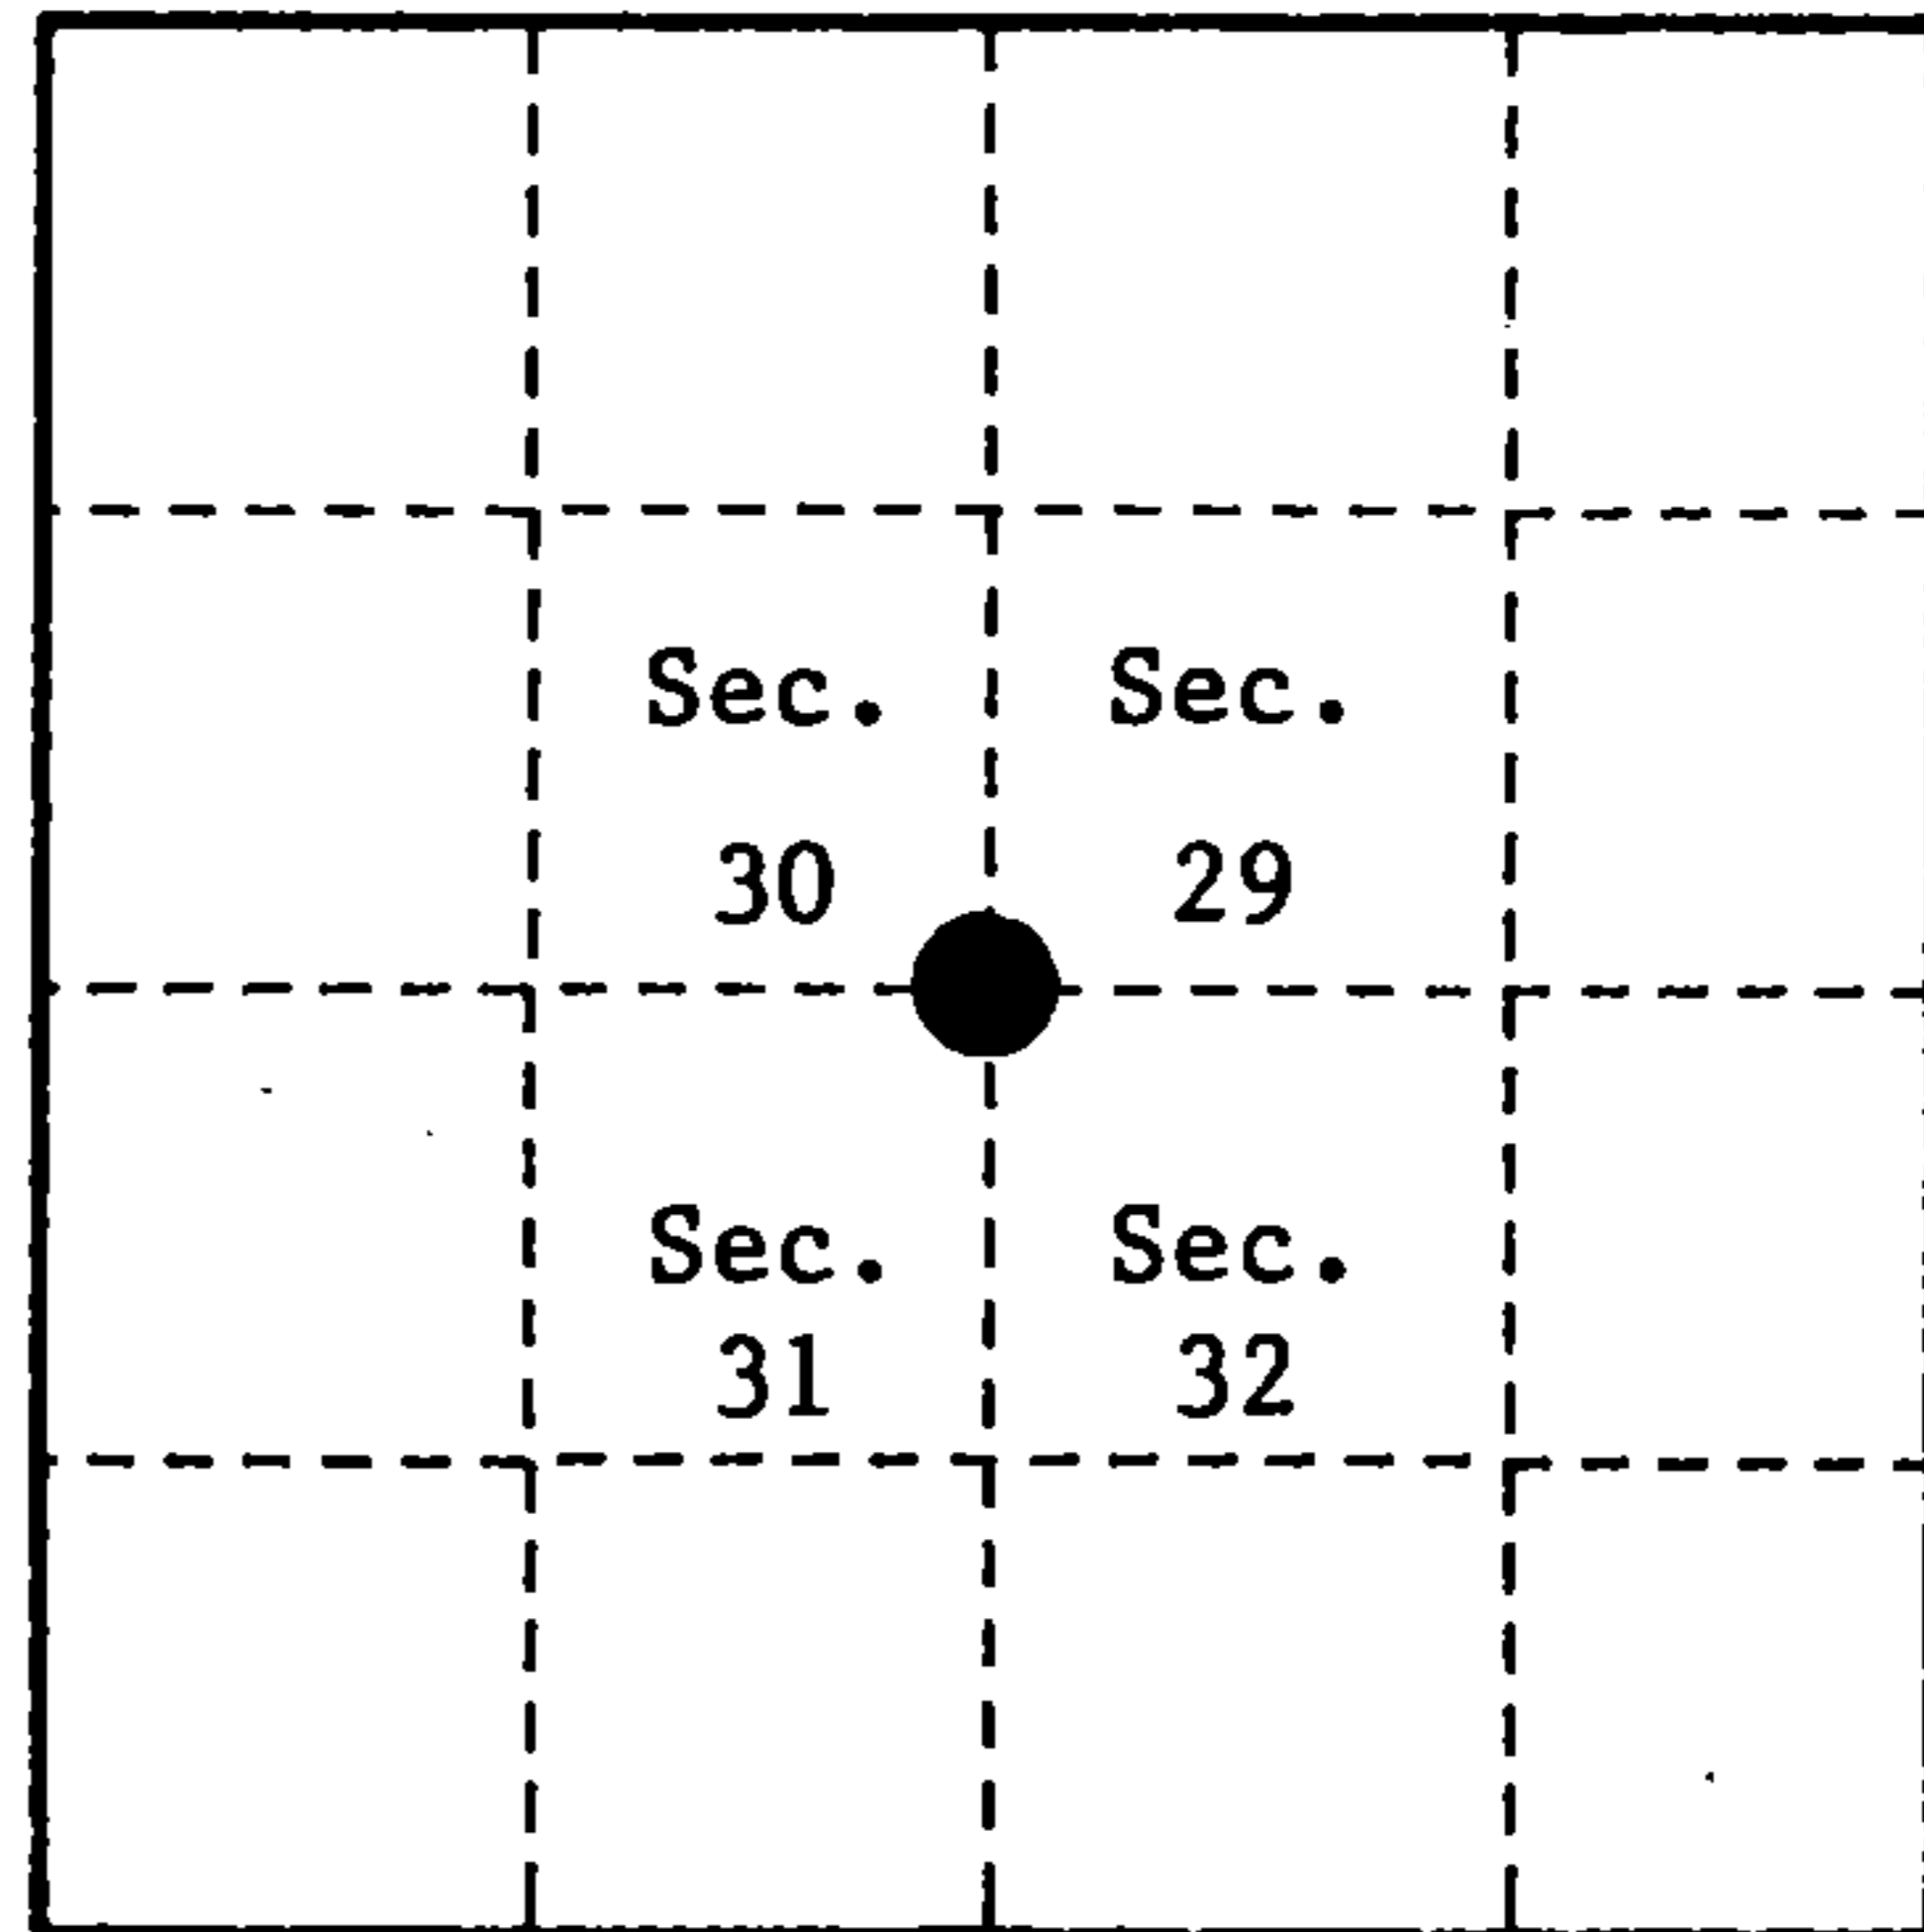

- (b) Describe any record evidence, monument evidence, occupational evidence, testimonial evidence or any other material evidence you considered, and whether the monument was found or placed.

In 1859 James McBride set a wood post and bearing trees; Birch, 15", N.36°N., 21 links (13.86 feet); Birch, 7", N.70°E., 35 links (23.1 feet), Sugar Maple, 10", S.37°E., 47 links (31.02 feet), Birch, 24", S.21°W., 25 links (16.5 feet).

In 1910 Smith found wood post and bearing trees in good condition.

In 1959 Joseph Abernathy found point of wood post and bearing tree stumps; Birch, 15", N.36°W., 21 links (13.86 feet), Sugar Maple, 10", S.37°E., 47 links (31.02 feet): Replaced wood post point with a 2" x 5' galvanized pipe with bronze cap and new bearing trees; Maple, 18", N.69°W., 17.2 feet, chisel cross 1.8' x 1.4' stone, N.7°E., 11.1 feet, chisel cross, 3.8' x 4.0' stone, S.30°E., 23.22 feet.


In 1982 Winat found brass cap set by Abernathy and made a new bearing tree, Maple, 5", S.81°E., 31.36 feet, Steel Sign Post, South, 4.5 feet.

On 1993 Alan Harrison (RLS) found monument in place and bearing trees and chisel cross in stone. Cut down, Maple, 20", N.69°W., 17.25 for G.P.S. observation. Steel Sign Post was found at South, 3.5 feet. Set new bearing trees; Maple, 6", N.66°E., 29.20 feet, Maple, 7", S.67°W., 52.34 feet, Aspen, 10", N.45°W., 41.80 feet.

- (c) In the plan view drawing below, provide reference ties to at least 4 witness monuments, or, if the location is within a municipality, to at least 2 witness monuments. (witness monuments shall be made of concrete, natural stone, iron or other equally durable material.)

- (d) Show a plan view drawing depicting the relevant monuments and reference ties which is sufficient in detail to enable accurate relocation of the corner monument if the corner monument is disturbed. Indicate north.

1. 2" x 5' galvanized pipe with stamped brass cap.
2. Maple, 8", S.81°E., 31.36 feet.
3. Chisel stone, 1.8' x 1.4', N.7°E., 11.1 feet.
4. Chisel stone, 3.8' x 4.0', S.30°E., 23.22 feet.
5. Maple, 6", N.66°E., 29.20 feet.
6. Maple, 7", S.67°W., 52.34 feet.
7. Aspen, 10", N.45°W., 41.80 feet.
8. Steel Sign Post, South, 3.5 feet.

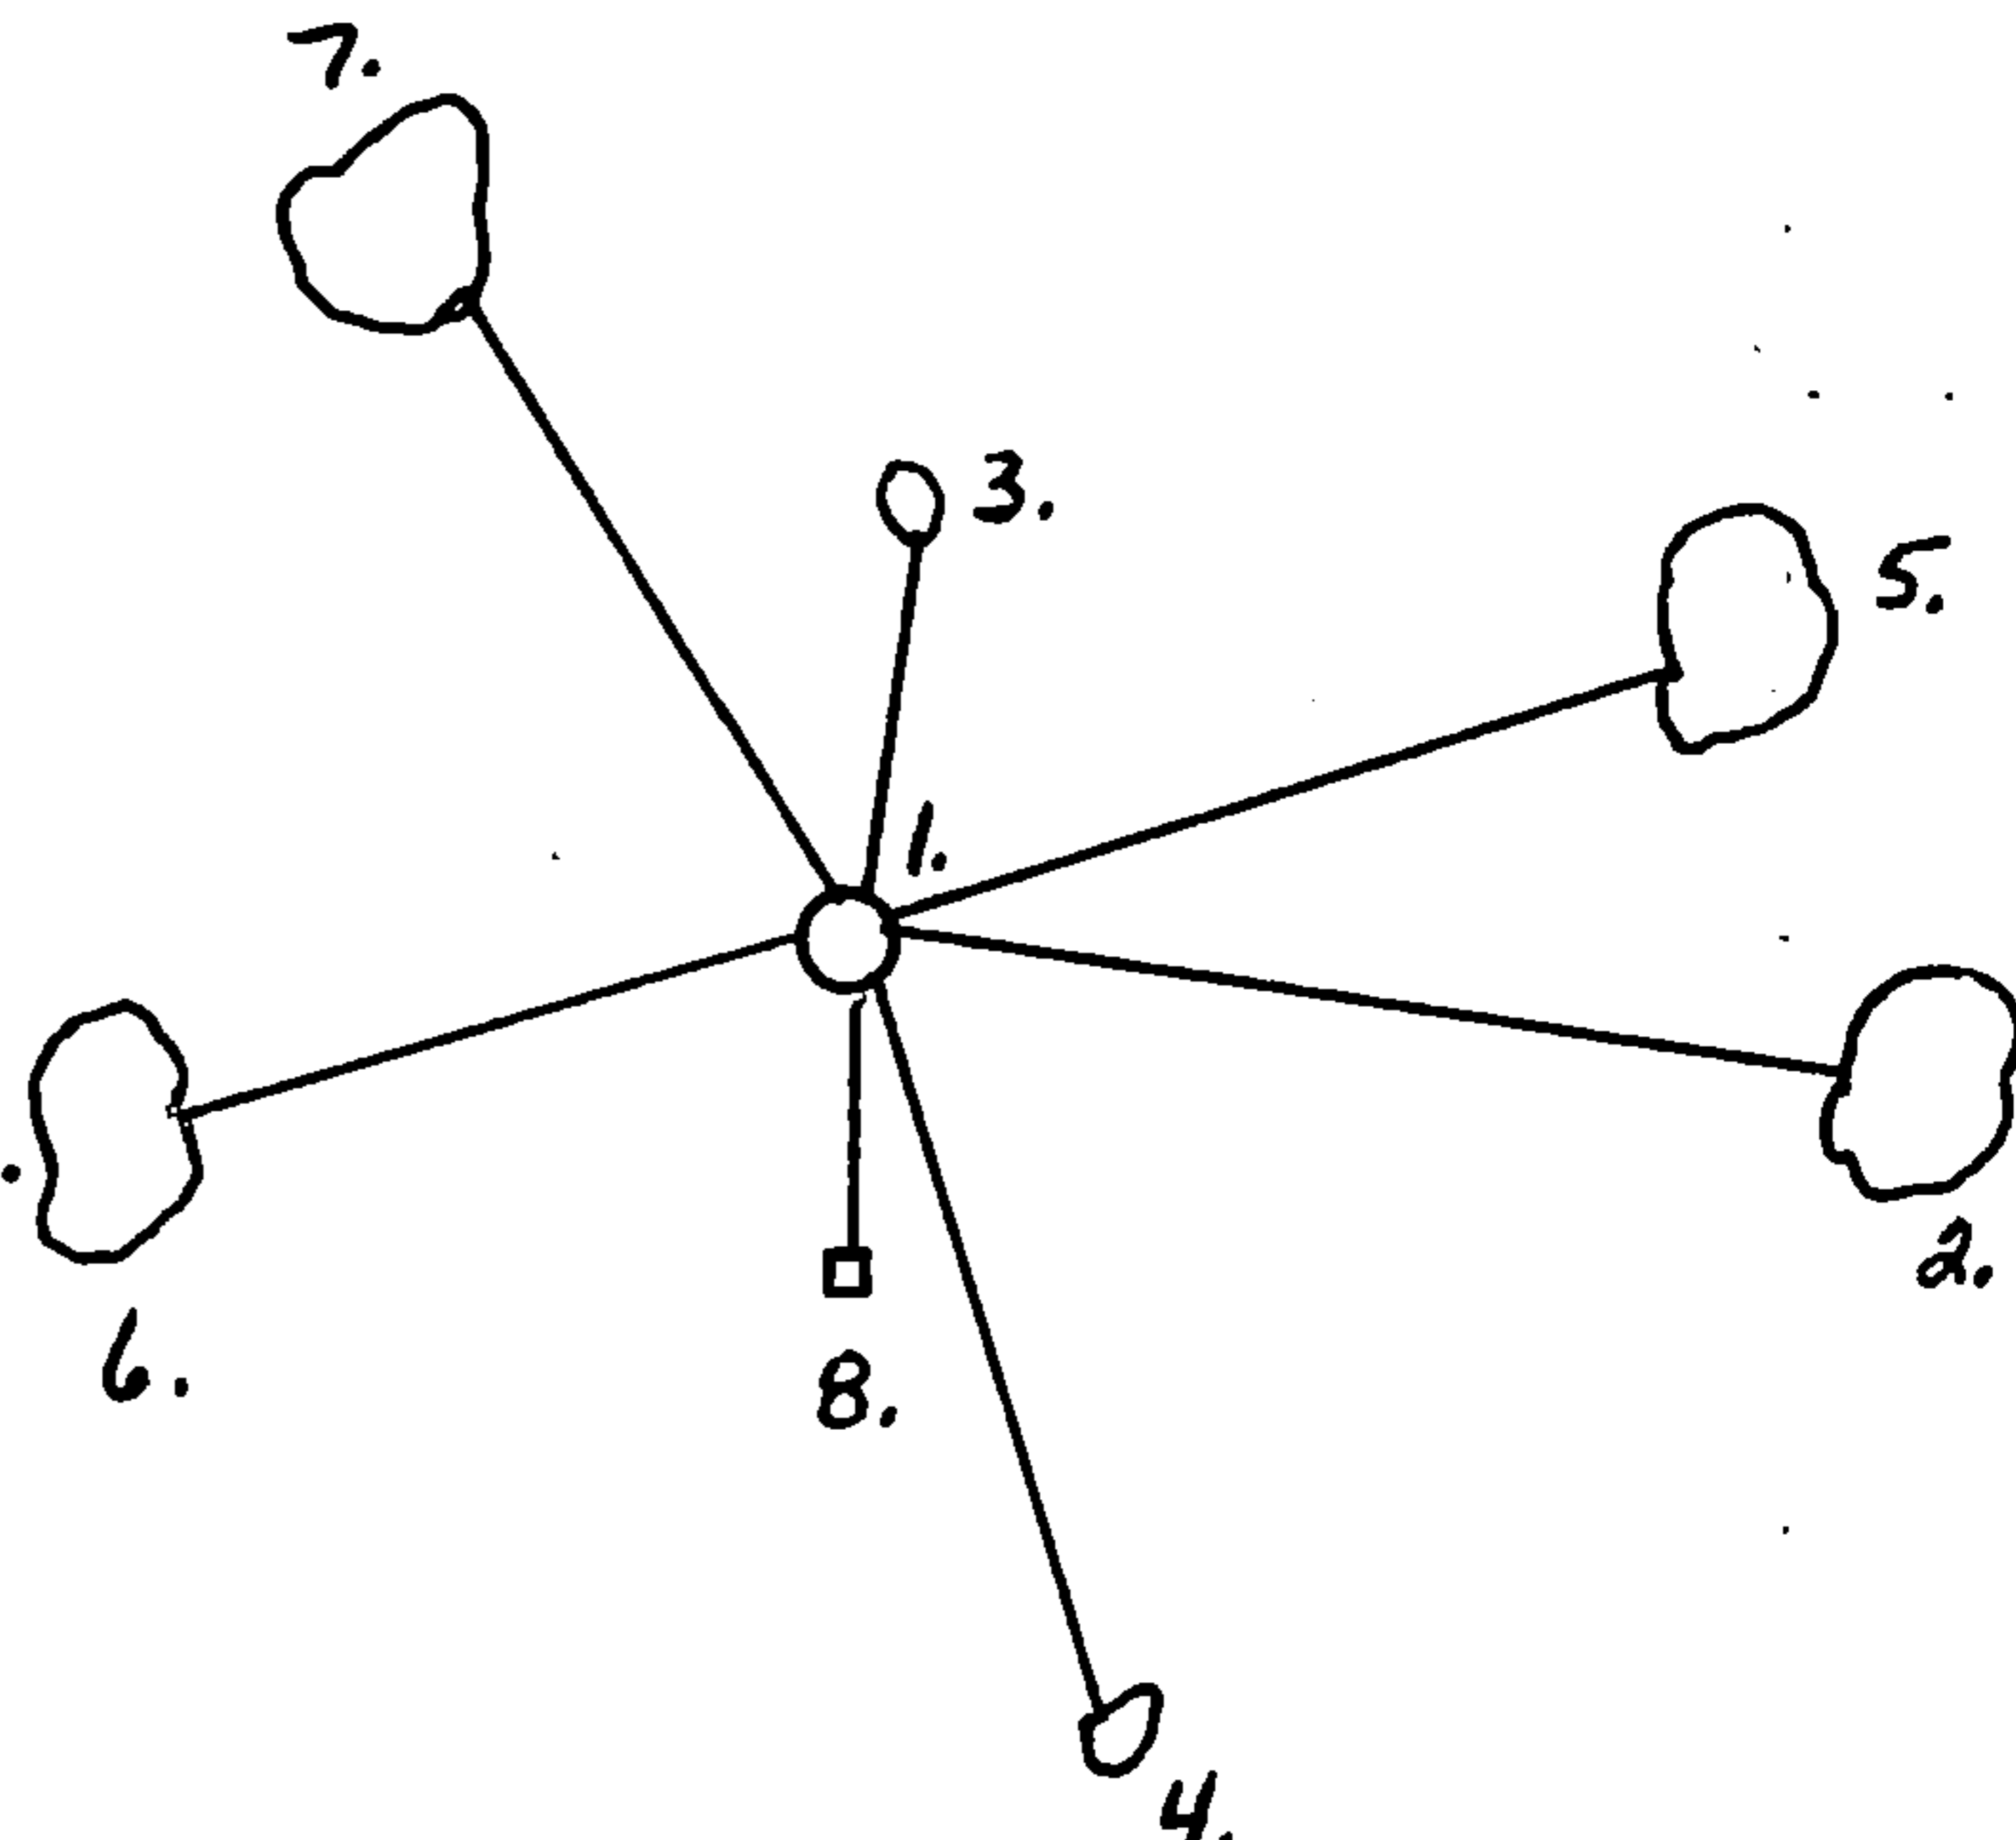

(e) Describe any material discrepancy between the location of the corner as restored or reestablished and the location of that corner as previously restored or reestablished by distance and direction. Show the discrepancy on the plan view drawing under (d), above. Show the distances between the corner as previously restored or reestablished and (1) the corner as restored or reestablished, and (2) to at least 2 of the witness monuments shown on the drawing in (d), above.

None.


(f) Was the corner restored through acceptance of (1) an obliterated evidence location, or, (2) a found perpetuated location?

(2)

(g & h) Was the corner reestablished through lost corner proportionate methods? If so, show the method, including the directions and distances to other public land survey corners used as evidence or used for proportioning in determining the corner location?

No.

REGISTER'S OFFICE
Forest County, Wis.
Received for record this 23rd day
of November A.D., 1994 at
9:00 o'clock A.M. and recorded
in Vol. Corporation
page 34-14, 14-5
Paul Chitt Deputy
Register of Deeds

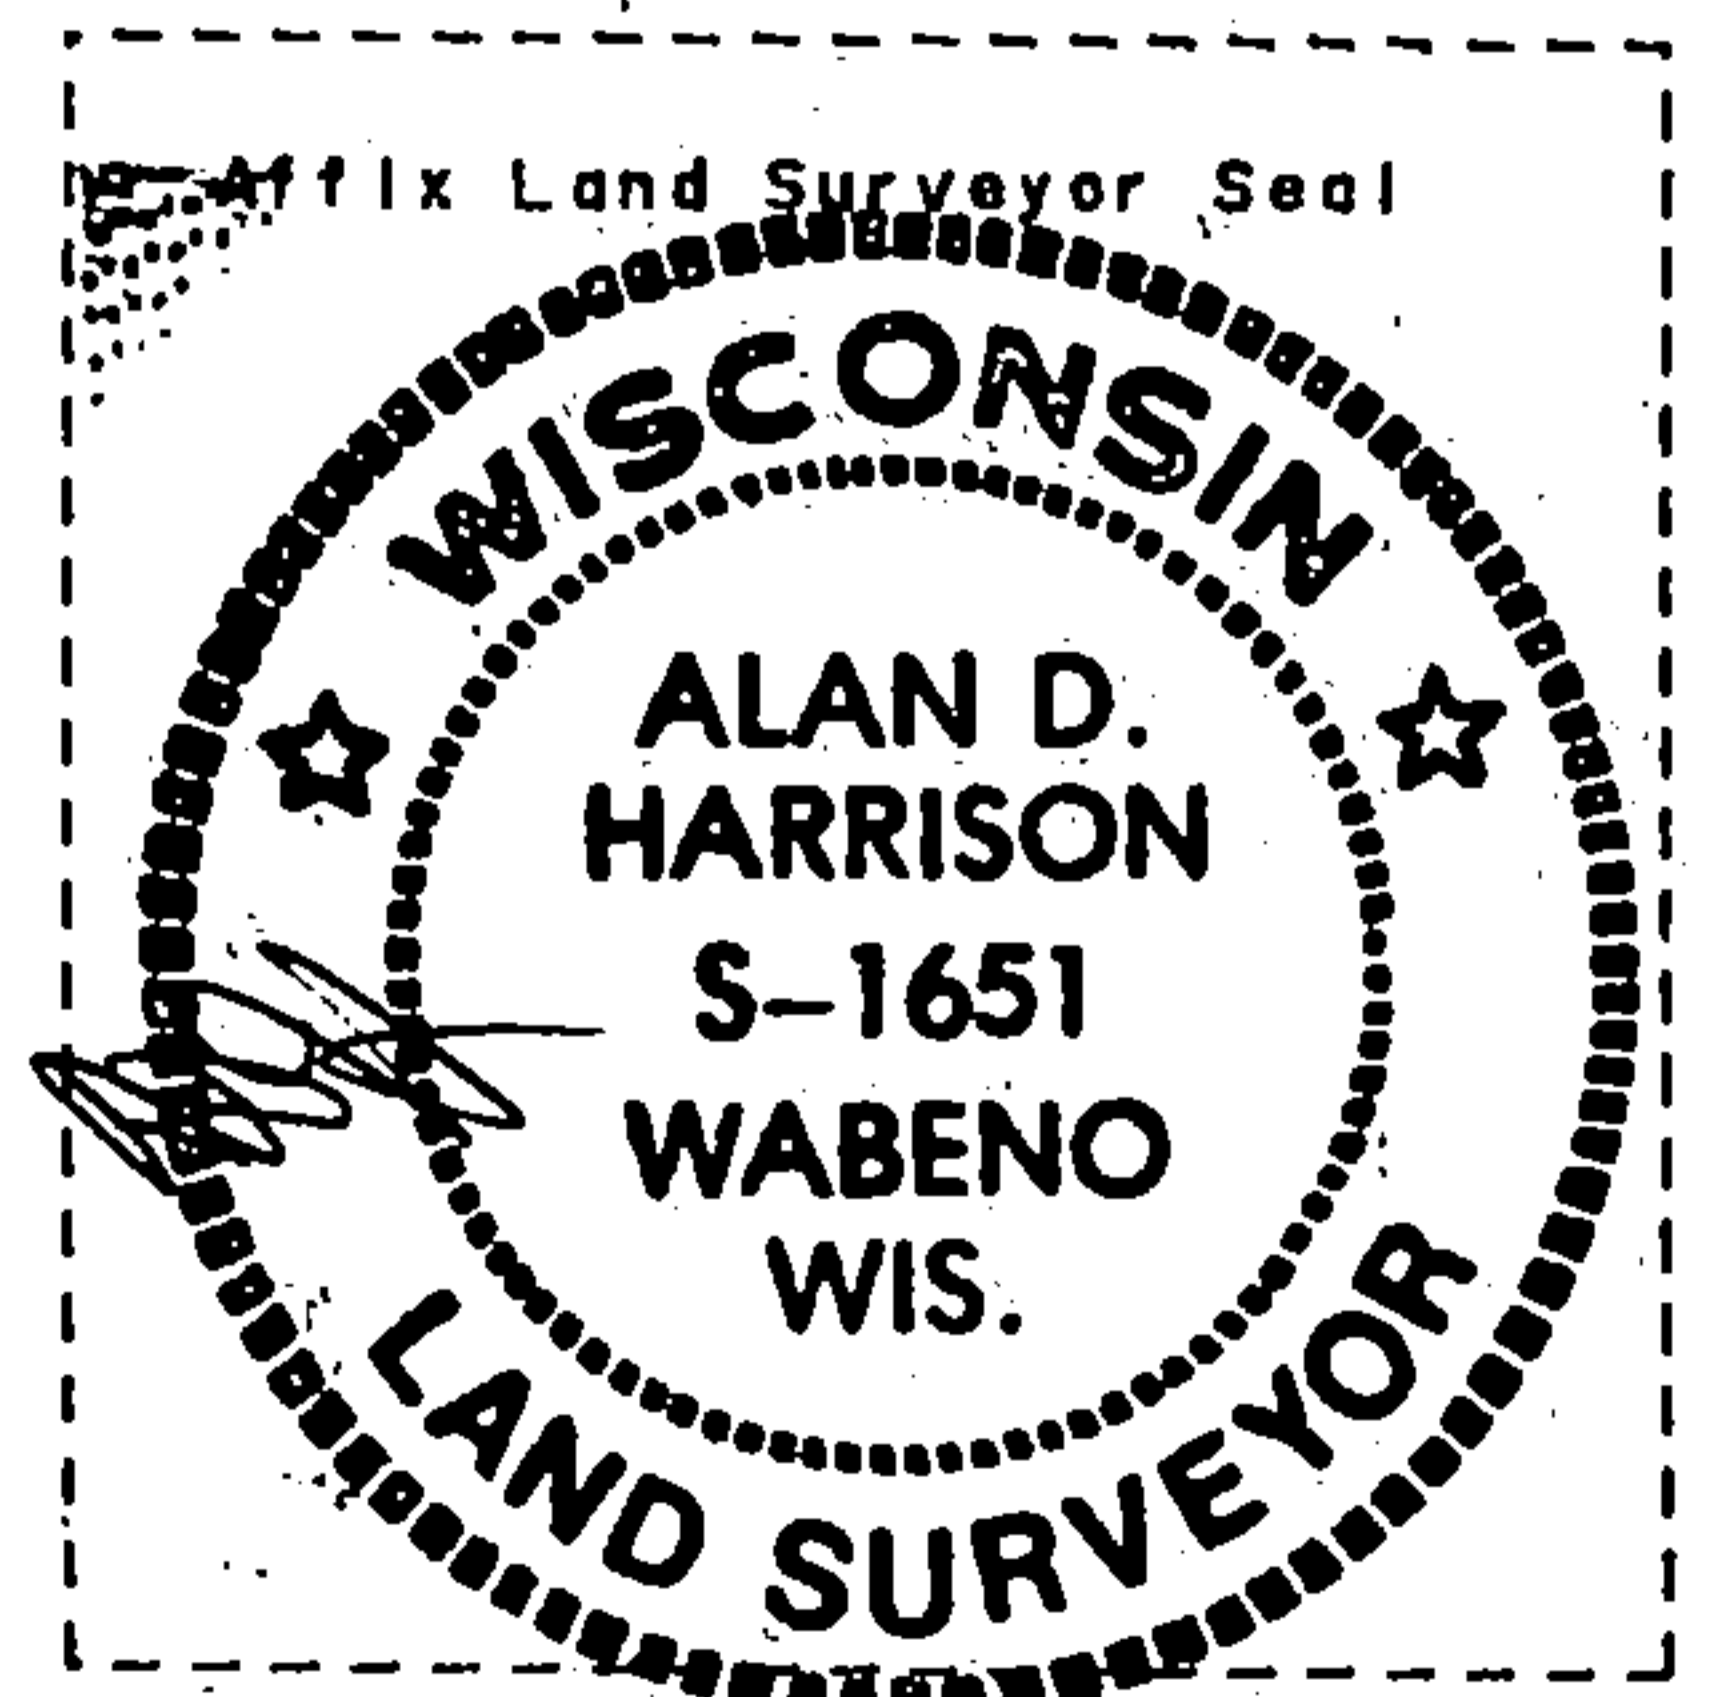

(1) I, Alan D. Harrison
(type or print name), certify that the corner location shown
on this record was determined by me or under my direction and
control and that this U.S. Public Land Survey Monument Record is
correct and complete to the best of my knowledge and belief.

Alan D. Harrison 10/26/94
Signature Date

CERTIFICATE READY FOR FILING:

Sue Vap
District Ranger


U. S. PUBLIC LAND SURVEY MONUMENT RECORD

INSTRUCTIONS: This record shall show the location of the corner and shall include all of the following nine elements (a through i).

(a) Identify the corner by reference to the U.S. public land survey system.

○ = Corner monument restored.

Section corner to Sections 29, 30, 31, and 32, T.34N., R.14E.

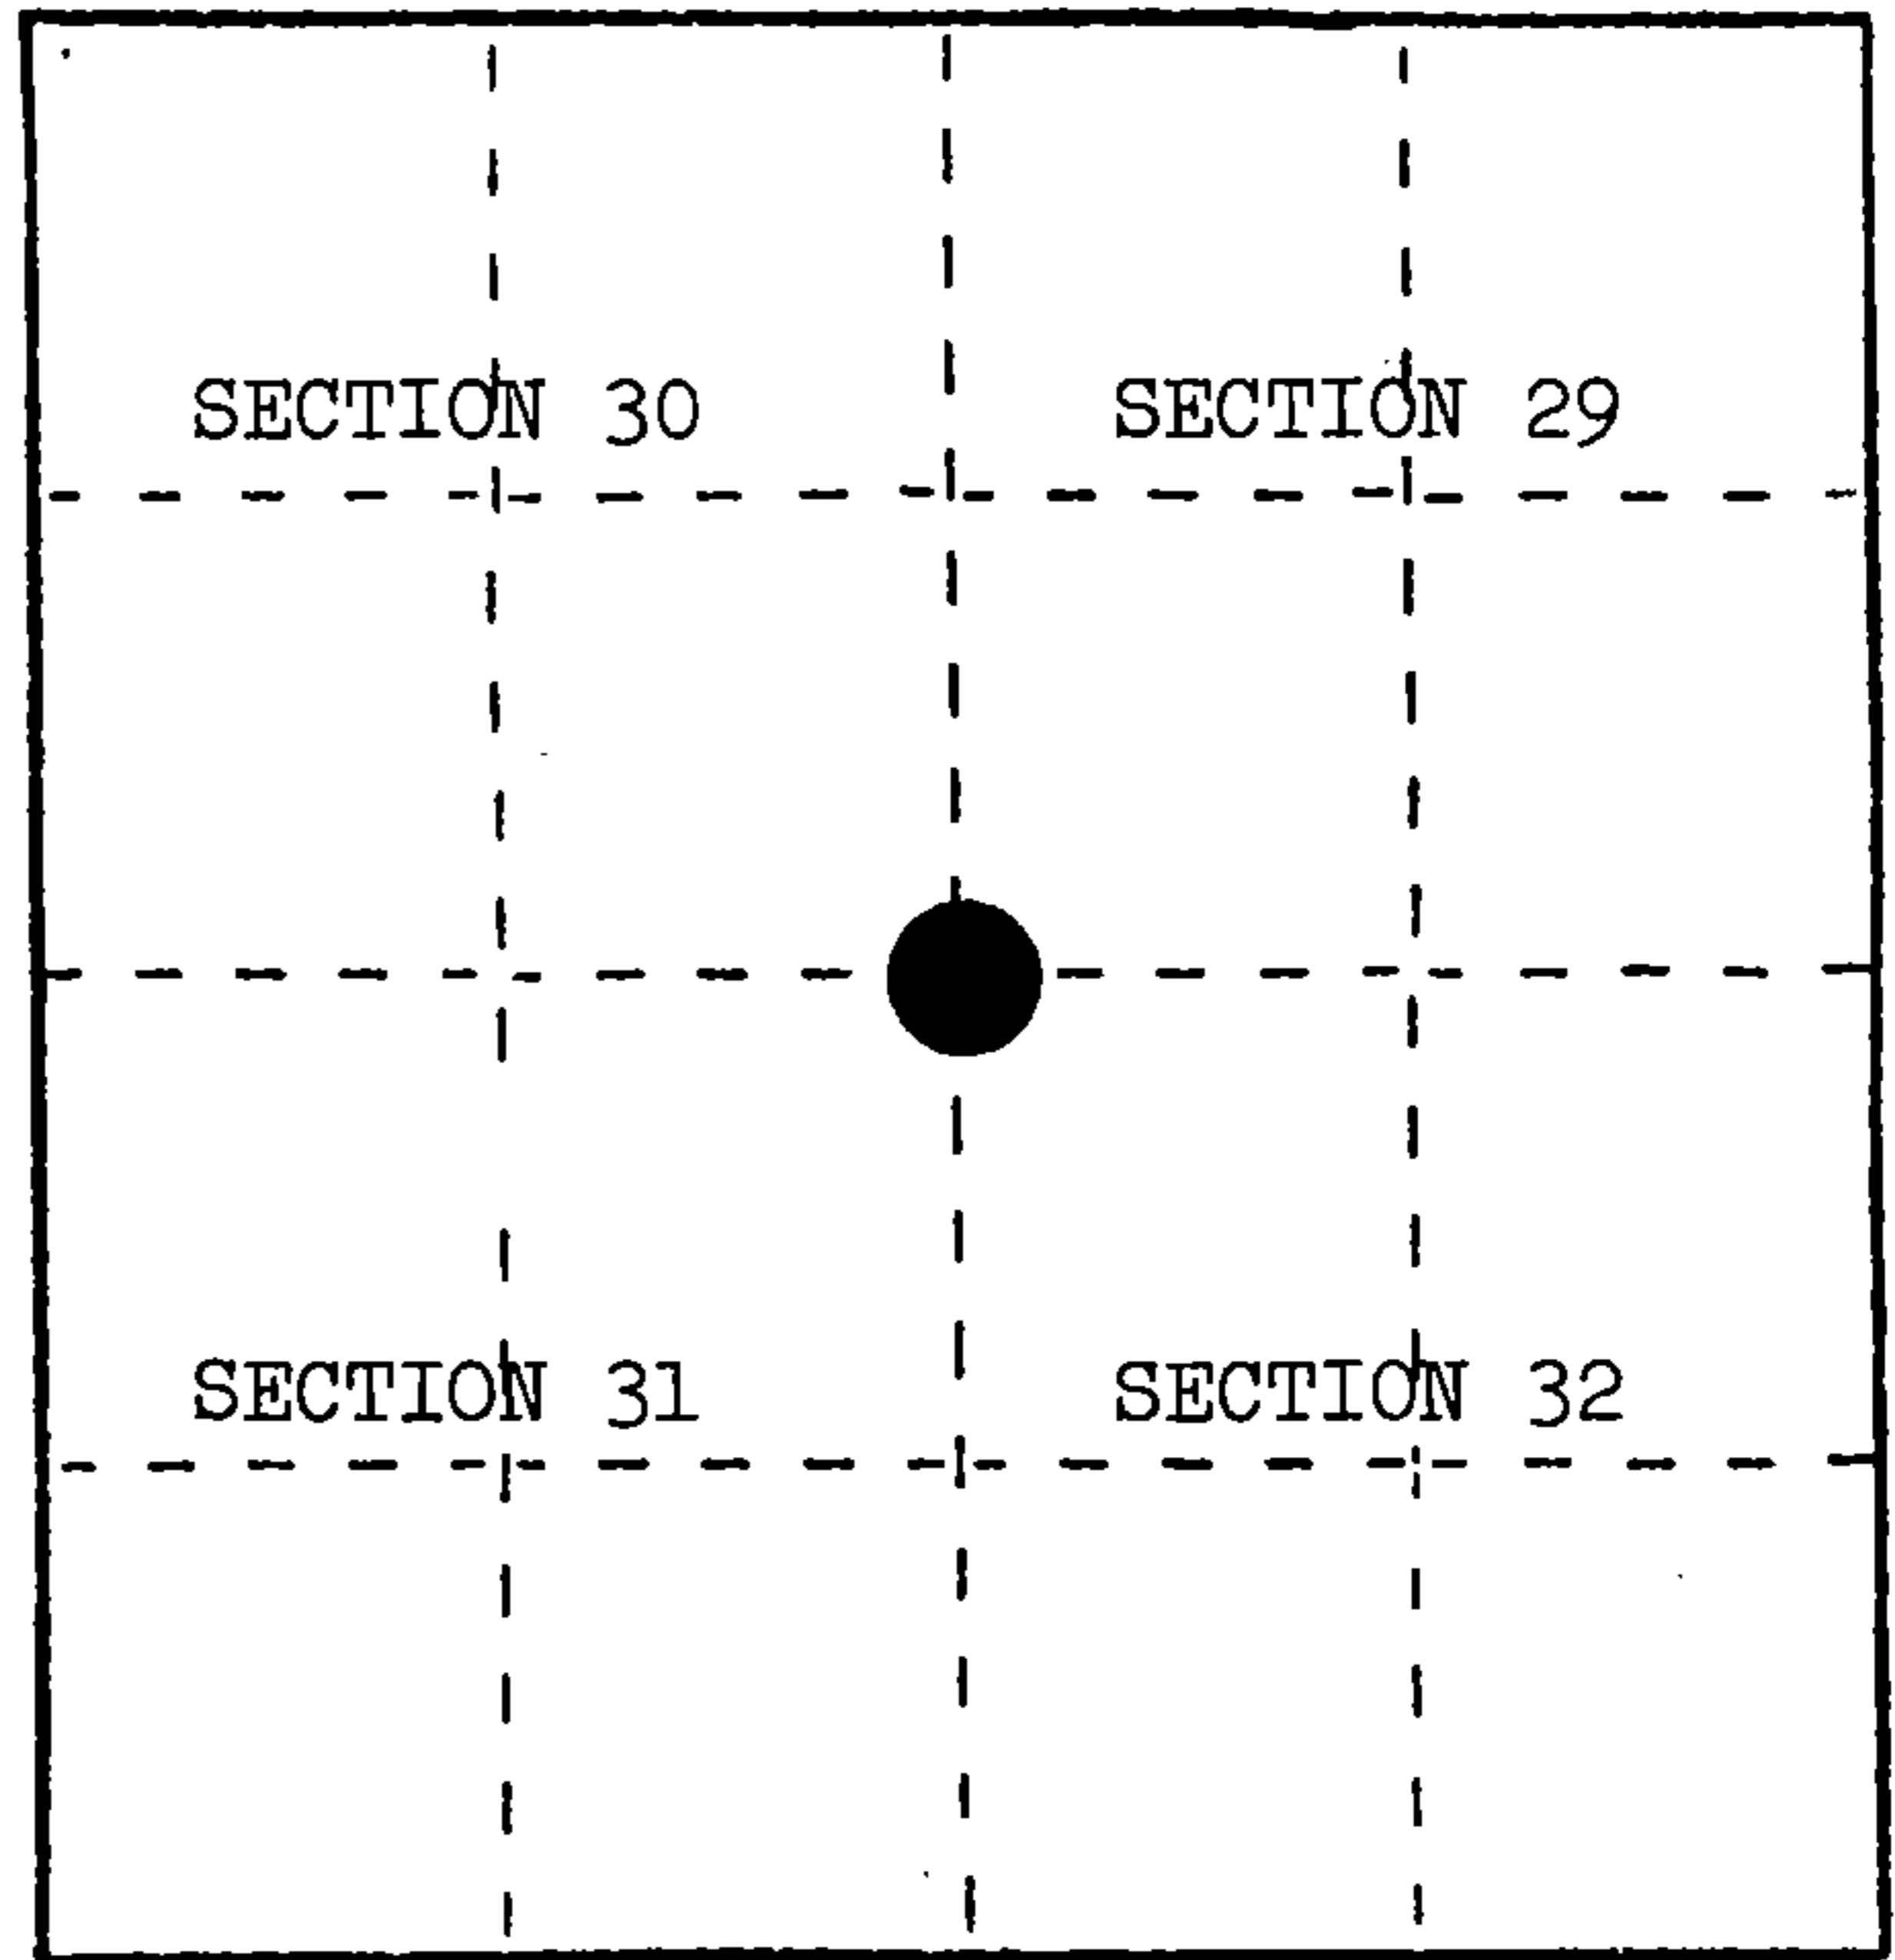


(b) Describe any record evidence, monument evidence, occupational evidence, testimonial evidence or any other material evidence you considered, and whether the monument was found or placed.

Found monument in place, as set by Genisot Engineering in 1959.

(c) In the plan view drawing below, provide reference ties to at least 4 witness monuments, or, if the location is within a municipality, to at least 2 witness monuments. (Witness monuments shall be made of concrete, natural stone, iron or other equally durable material.) Describe witness monuments.

(d) Show a plan view drawing depicting the relevant monuments and reference ties which is sufficient in detail to enable accurate relocation of the corner monument if the corner monument is disturbed. Indicate north.

1. Sugar Maple, 26", N.69°W., 17.29 feet
2. Sugar Maple, 5", S.81°W., 31.36 feet
3. Cross on Boulder (1.8' x 1.4'), N.7°E., 11.12 feet
4. Cross on Boulder (3.8' x 4.0'), S.30°E., 23.22 feet
5. Steel Sign Post, South, 4.50 feet

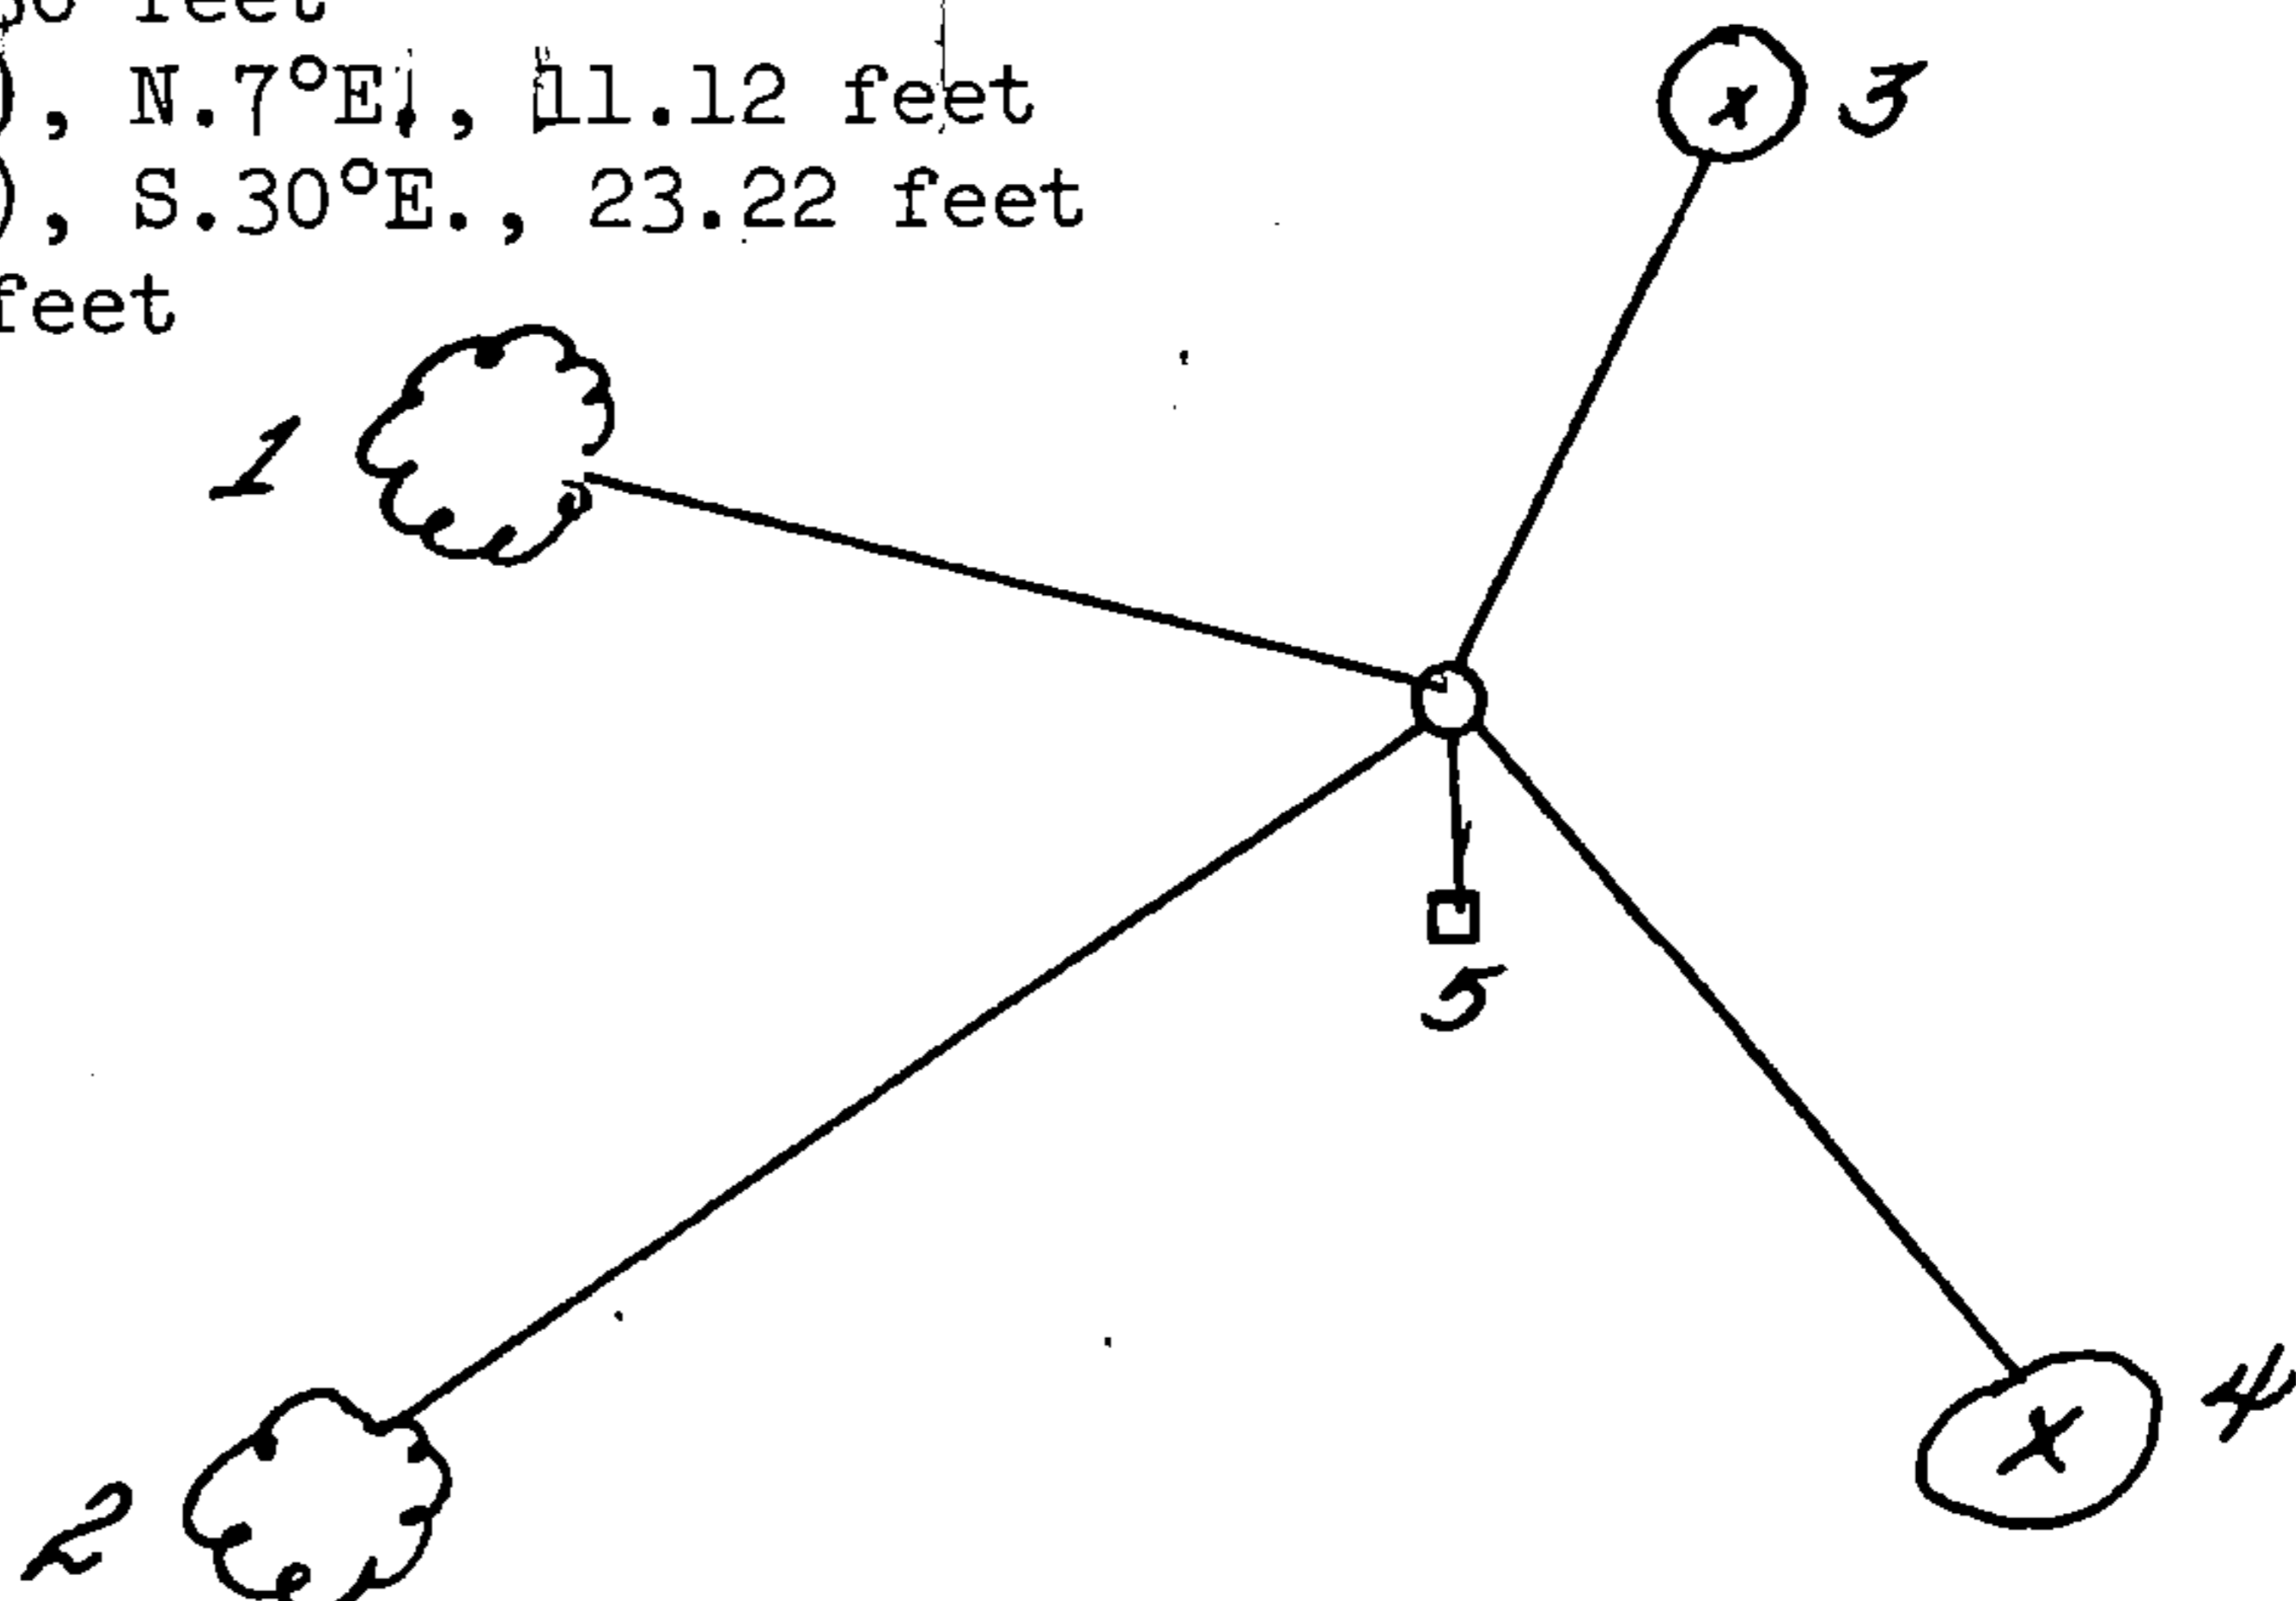

REGISTER'S OFFICE }
Forest County, Wis. }

Received for record this... 16th day
of... January... A. D., 1985 at
... 2:30 o'clock... P... M. and
recorded in Vol. CORNER RESTORATIONS
on page... 15...

Paul Aschenbrenner
REGISTER

(e) Describe any material discrepancy between the location of the corner as restored or reestablished and the location of that corner as previously restored or reestablished by distance and direction. Show the discrepancy on the plan view drawing under (d), above. Show the distances between the corner as previously restored or reestablished and (1) the corner as restored or reestablished, and (2) to at least 2 of the witness monuments shown on the drawing in (d), above.

(f) Was the corner restored through acceptance of (1) an obliterated evidence location, or, (2) a found perpetuated location?

A found perpetuated location.

(g&h) Was the corner reestablished through lost corner proportionate methods? If so, show the method, including the directions and distances to other public land survey corners used as evidence or used for proportioning in determining the corner location?



(i) I, Milo E. Stefan
(type or print name) certify that the corner location shown on this record was determined by me or under my direction and control and that this U.S. Public Land Survey Monument Record is correct and complete to the best of my knowledge and belief.

Milo E. Stefan
Signature

3/21/84
Date