

CERTIFIED LAND CORNER RESTORATION

Index No. 55

State of Wisconsin }
County of Forest } ss.

I, Paul N. Smith, R.L.S., do hereby certify that on the 17 day of September, 1977, I found evidence of the South WEST Section corner of Section 8 Township 34, North, Range 15 East, Fourth Principal Meridian, as described hereon; and that from this evidence I established a new monument and accessories as described hereon to perpetuate the original location of this corner.

Resident witnesses:

.....
.....
.....


History of original corner establishment:
Set by U.S. Dupty Surveyor 1859
Government Bearing Tree,s
Birch 24" N. 64° W. 6 lks
Ironwood 10" N. 41° E. 14 lks
Birch 12" S. 85° E. 45 lks
Birch 36" S. 64° W. 61 lks

Description of corner evidence found:

Found point of wood stake set by N.H. Smith, 1906 ; Repaceing Stake Set 4 year,s, before that Year.
point of original stake dug up by O. N. Smith at same locotion 1908

Description of monument and accessories I established to perpetuate the original location of this corner.

Set Forest County Monument
Wit. corner,s as follow,s
N. 18°50' W. 15.93 ft. 1" iron pipe
S. 14°36'20"W. 25.72 ft. 1" iron
S 89°51'20" E. 10.30 ft. 1" iron

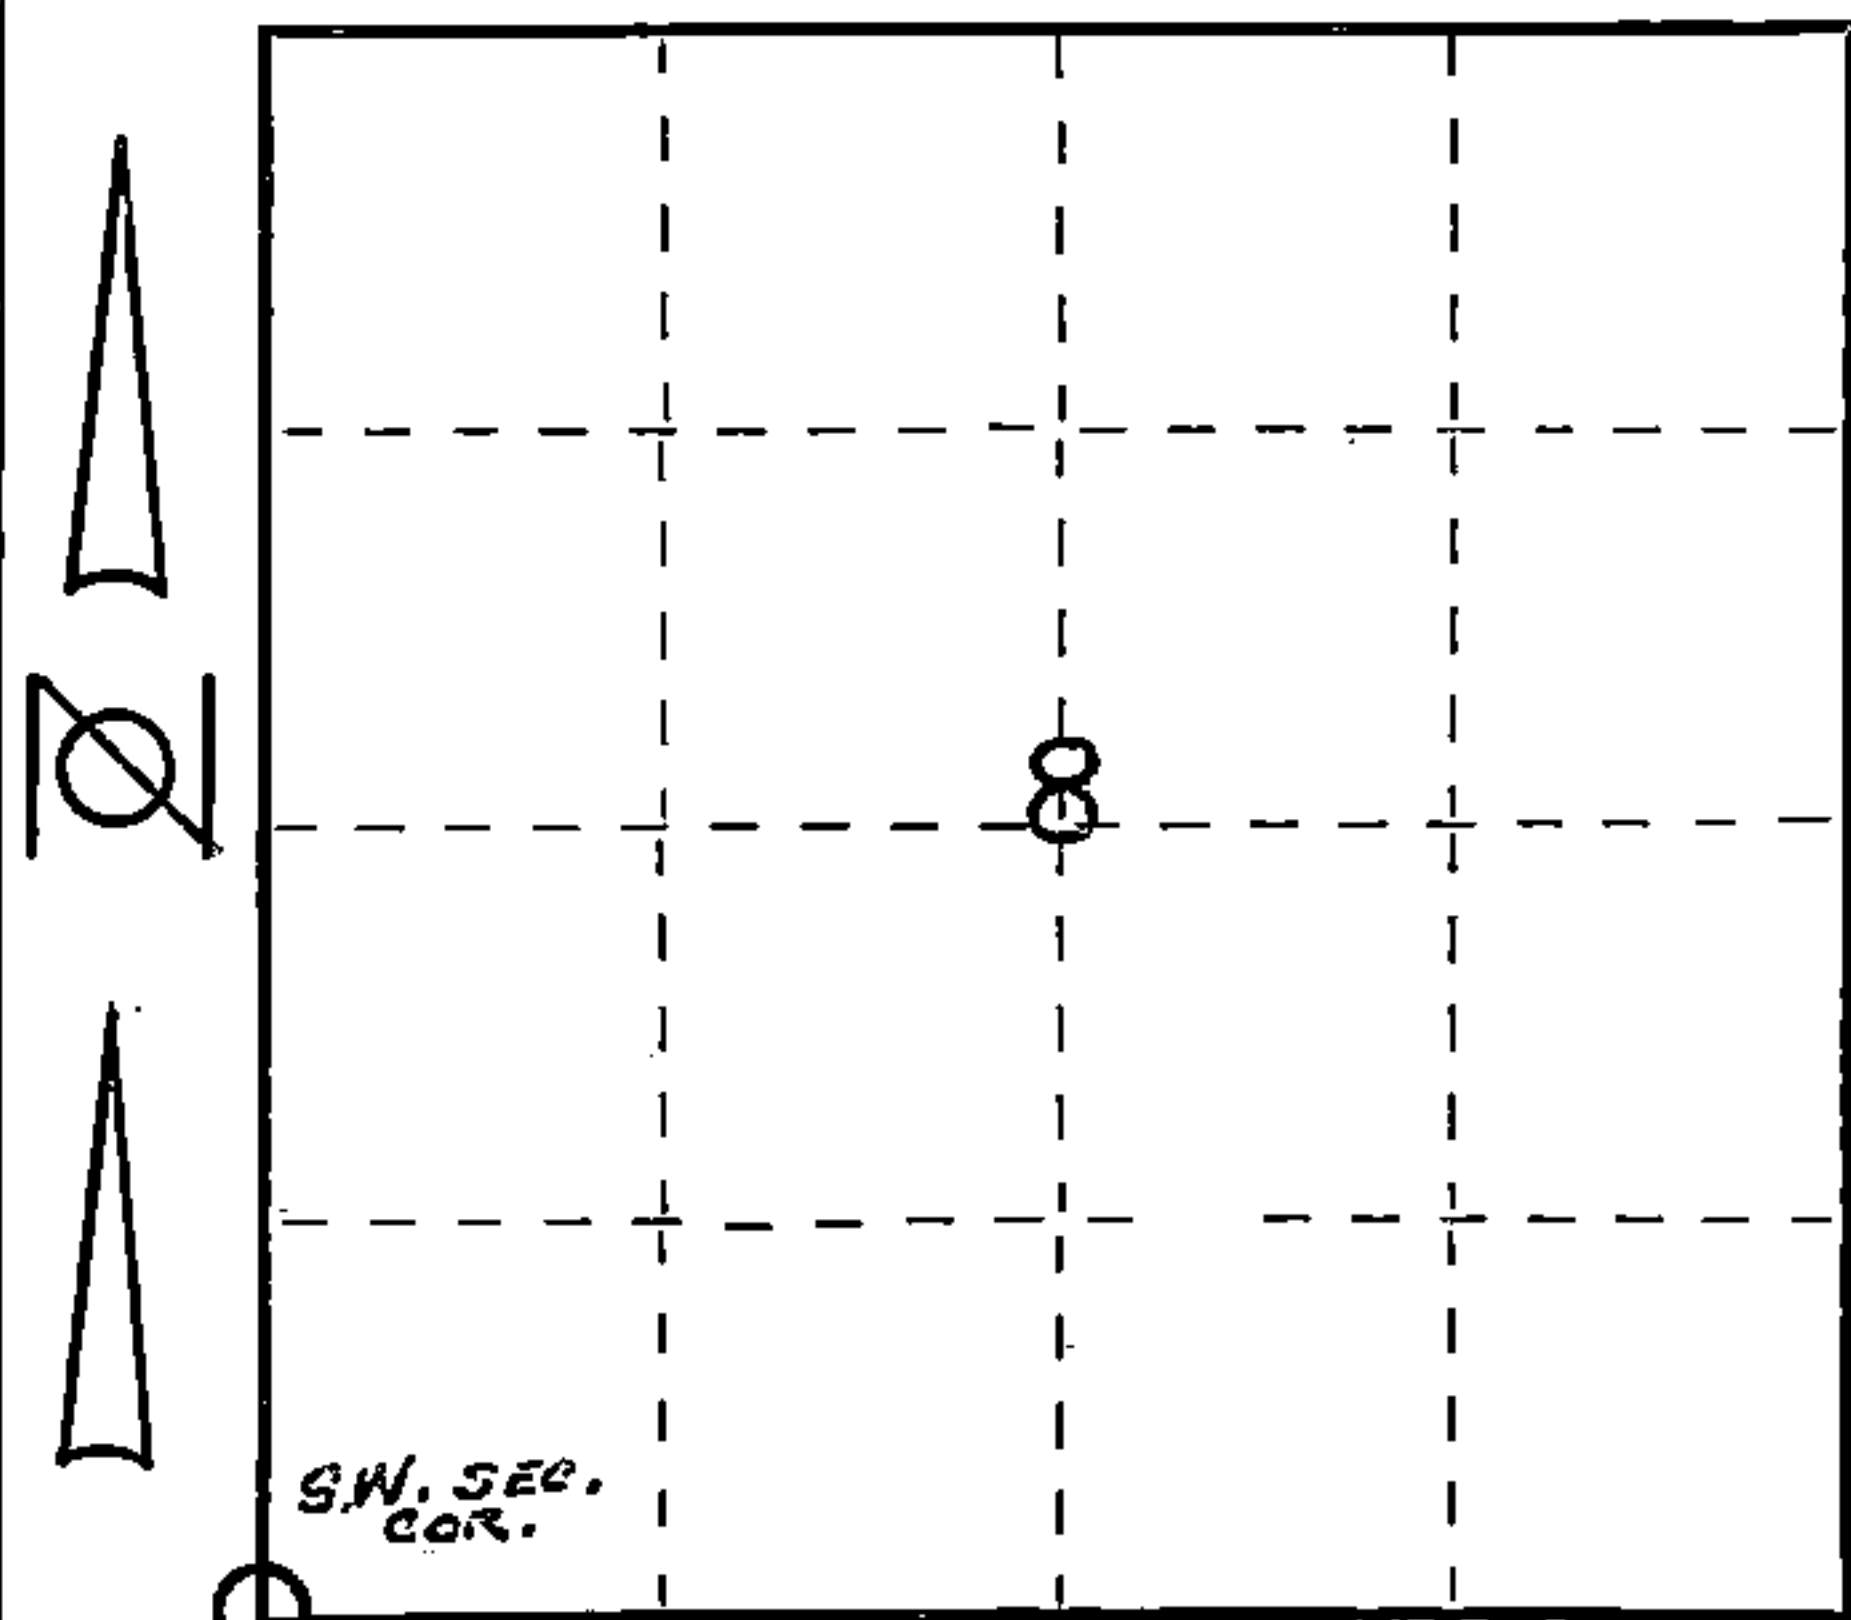

○ = Corner monument restored.



Dated at ATHELSTANE, Wis., this 8 day of NOVEMBER, 1977.

Signature Paul N. Smith Title Land Surveyor Registration No. S-00125
(County Surveyor, Registered Land Surveyor, or other duly authorized official)

Office of Register of Deeds, County of Forest, I hereby certify that the within instrument was filed in this office for record on the 9th day of December, 1977 at 9:45 o'clock A. M.

Eugene Staszny
(Register of Deeds)
By _____ Deputy

DOCUMENT NUMBER - **112924**

43415070000
SEE NEXT


U. S. PUBLIC LAND SURVEY MONUMENT RECORD

INSTRUCTIONS: This record shall show the location of the corner and shall include all of the following nine elements (a through i).

(a) Identify the corner by reference to the U.S. public land survey system.

○ = Corner monument restored.

Section corner to Sections 7, 8, 17, and 18, T.34N., R.15E.

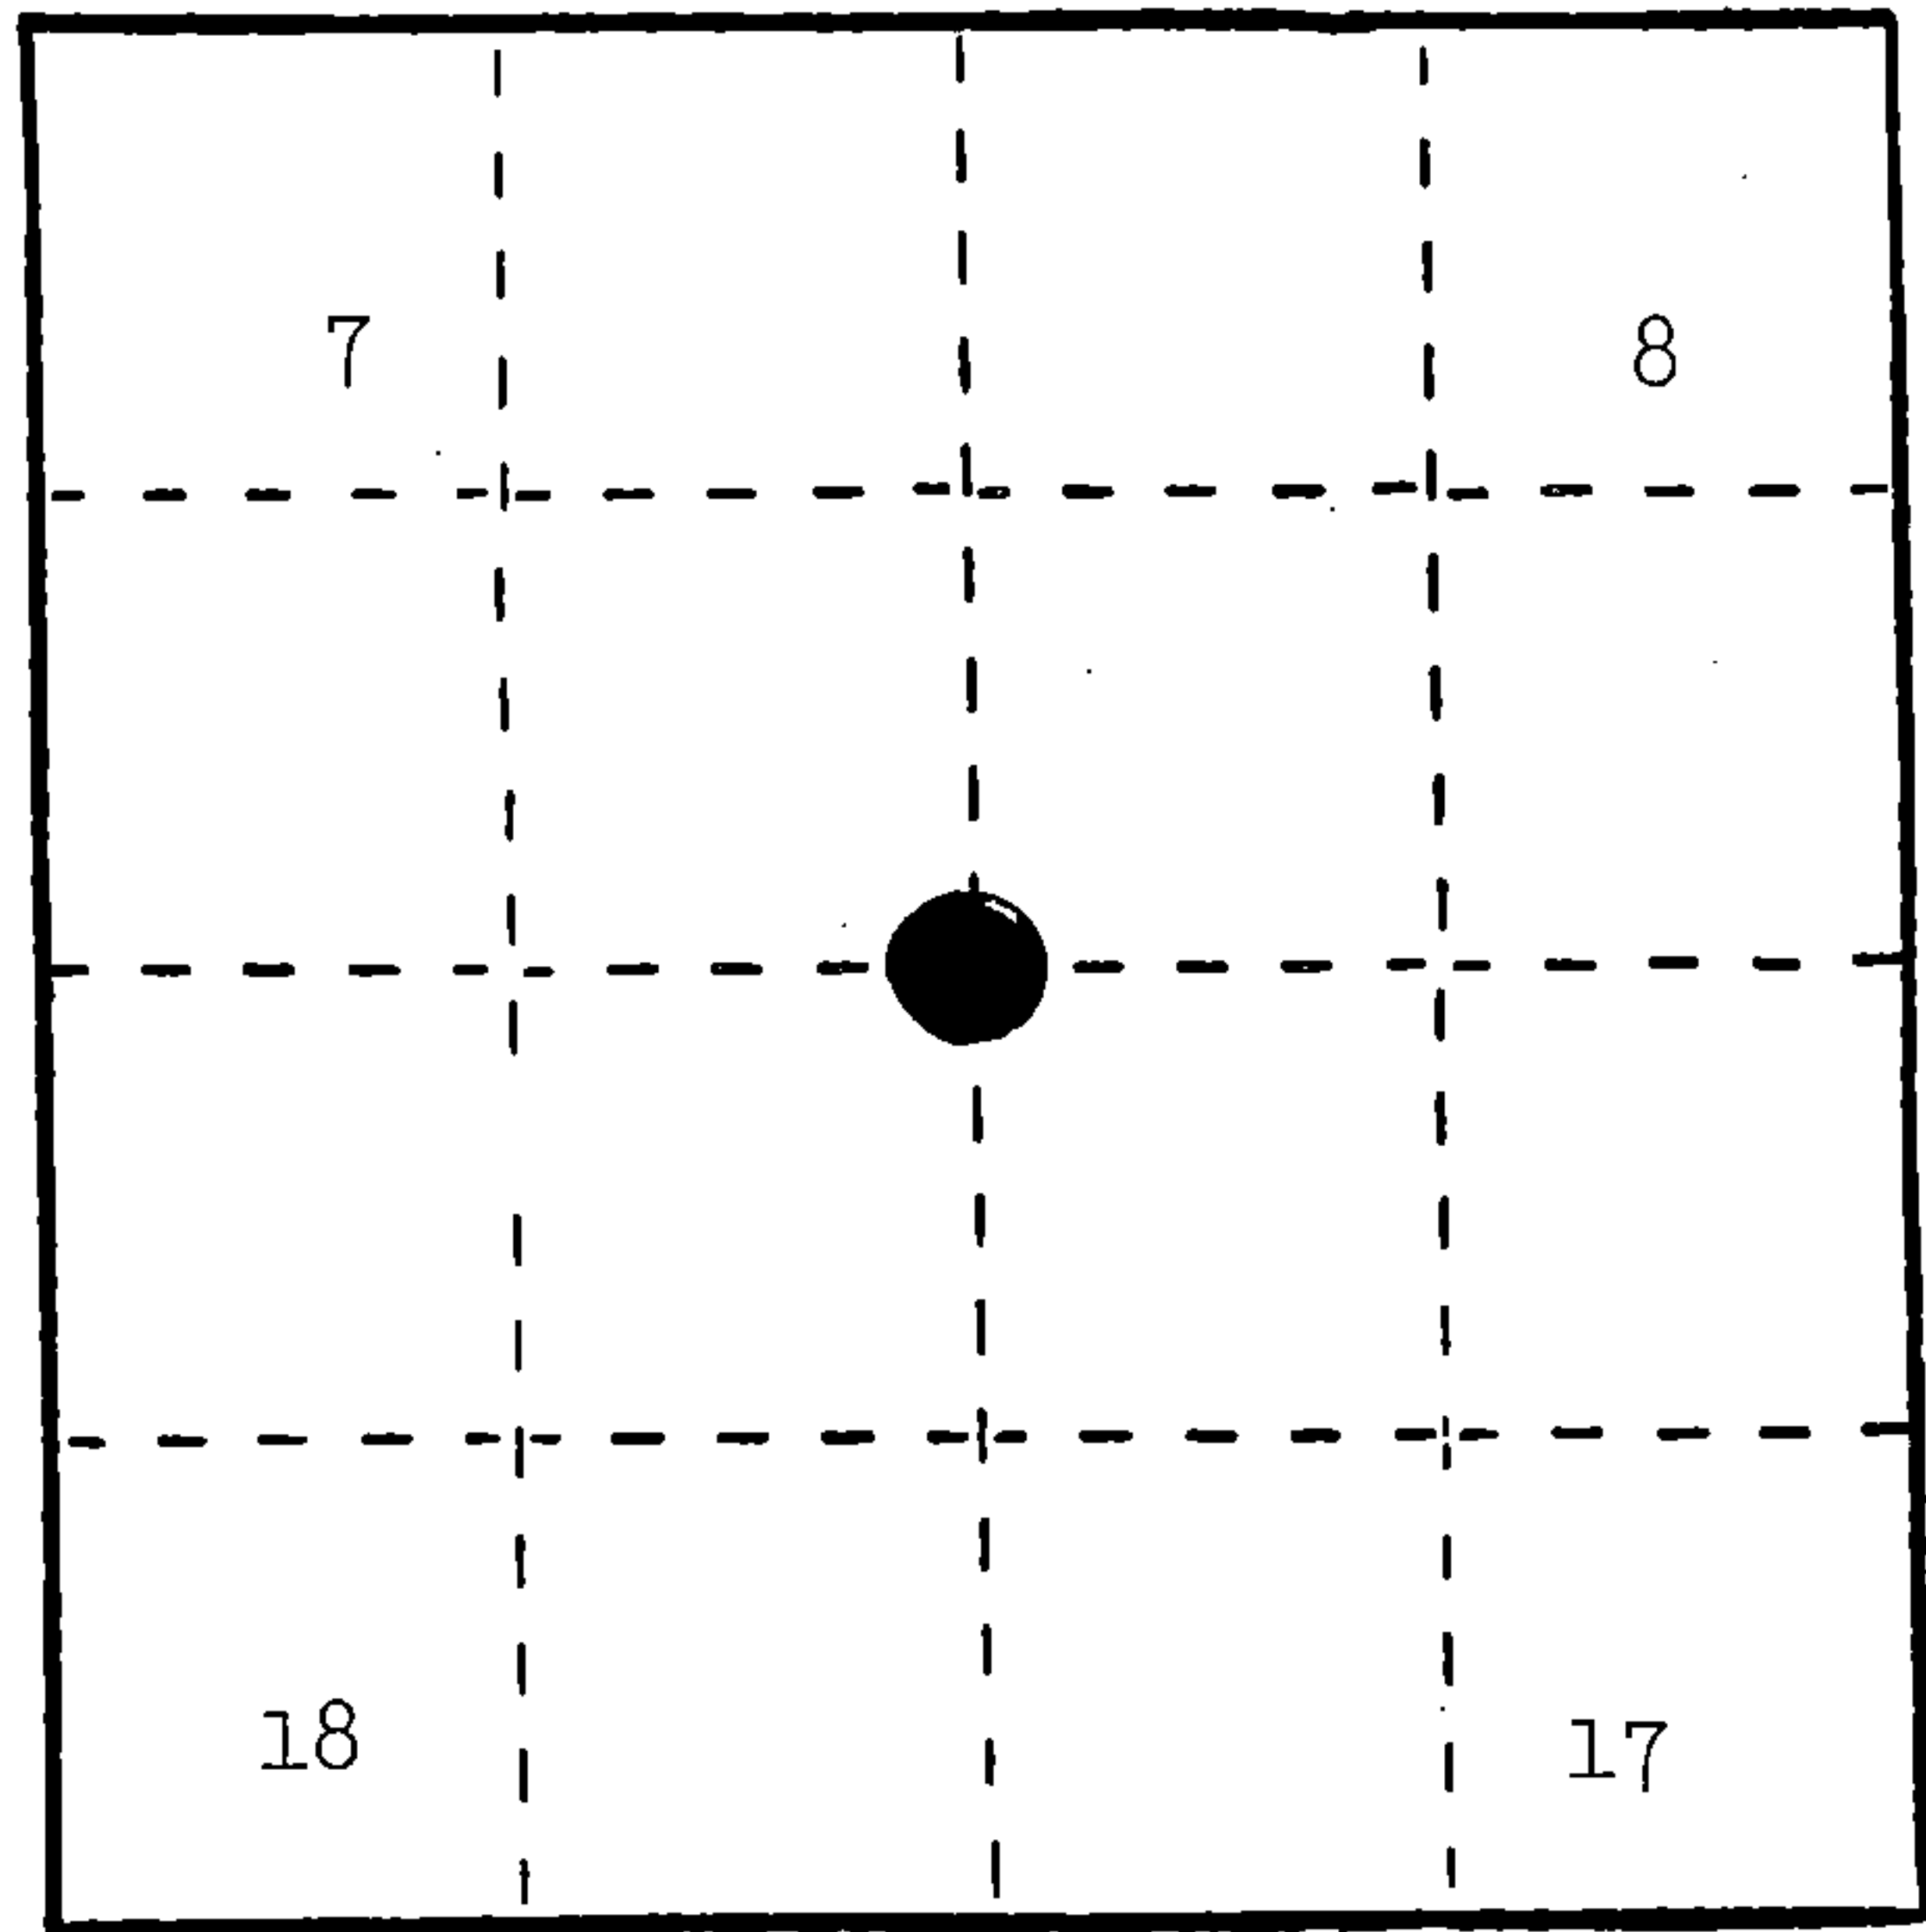

REGISTER'S OFFICE } Forest County, Wis. Received for record this 14th day of March A.D. 1986 at 10:35 o'clock A.M. and recorded in Vol. CORNER RESTORATIONS page J-5 Paul Aschenbrenner Register of Deeds

(b) Describe any record evidence, monument evidence, occupational evidence, testimonial evidence or any other material evidence you considered, and whether the monument was found or placed.

June, 1859, James McBride placed a post at 80.00 chains with the following BTs: Ironwood, 10", N.41°E., 14 links; Birch, 12", S.85°E., 45 links; Birch, 36", S.64°W., 61 links; Birch, 24", N.64°W., 6 links.

In 1906, N. H. Smith found corner. In 1908, O. N. Smith found point of original stake.

May 26, 1967, Resvick and Cochrane found iron pipe with old scribed post.


September 17, 1977, Paul Smith placed a county monument in place of iron pipe with 1" iron pipe, N.18°50'W., 15.93 feet; 1" iron pipe, S.14°36'20"W., 25.72 feet; 1" iron pipe, S.89°51'20"E.

Milo Stefan accepted county monument and placed bearing trees.

(c) In the plan view drawing below, provide reference ties to at least 4 witness monuments, or, if the location is within a municipality, to at least 2 witness monuments. (Witness monuments shall be made of concrete, natural stone, iron or other equally durable material.) Describe witness monuments.

(d) Show a plan view drawing depicting the relevant monuments and reference ties which is sufficient in detail to enable accurate relocation of the corner monument if the corner monument is disturbed. Indicate north.

- 1. Basswood, 10", N.56°E., 32.85 feet
2. Sugar Maple, 8", S.68°E., 38.73 feet
3. Yellow Birch, 10", S.14°W., 26.11 feet
4. Yellow Birch, 8", N.18°W., 16.78 feet
5. Steel Sign Post, East, 1.6 foot
6. County Monument
7. 1" Iron Pipe--Smith (1977)
8. 1" Iron Pipe--Smith (1977)
9. 1" Iron Pipe--Smith (1977)

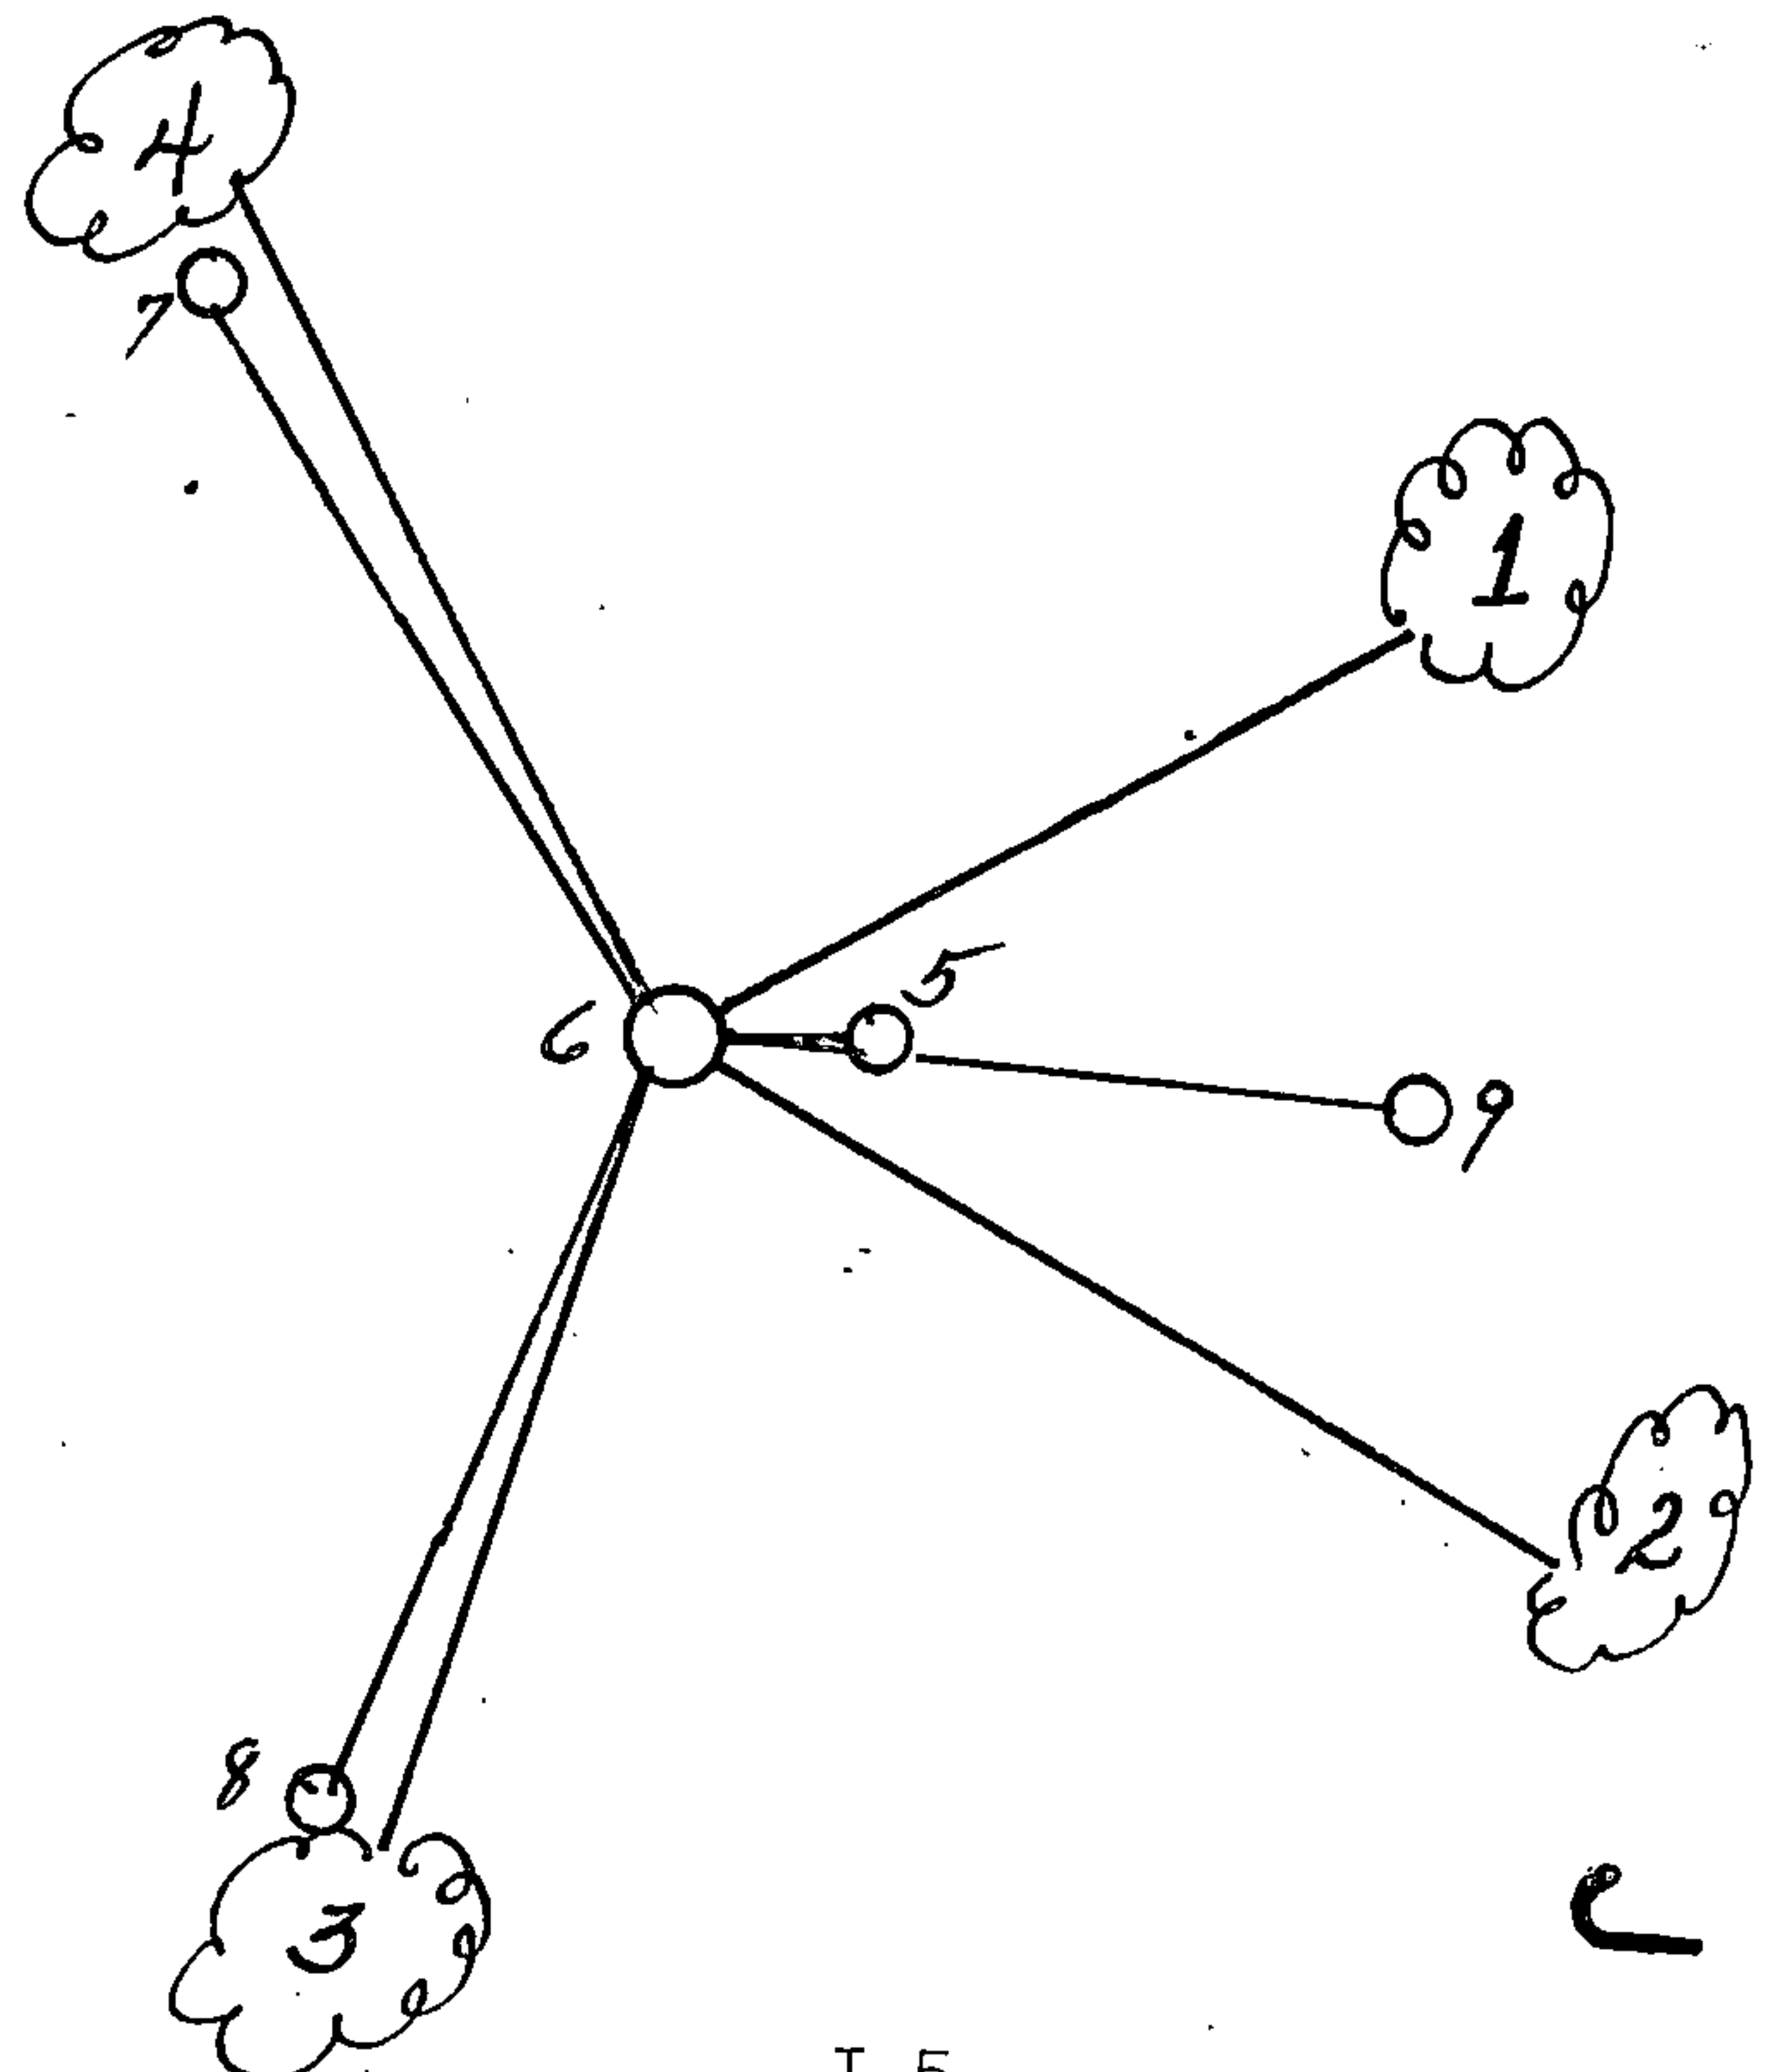

(e) Describe any material discrepancy between the location of the corner as restored or reestablished and the location of that corner as previously restored or reestablished by distance and direction. Show the discrepancy on the plan view drawing under (d), above. Show the distances between the corner as previously restored or reestablished and (1) the corner as restored or reestablished, and (2) to at least 2 of the witness monuments shown on the drawing in (d), above.

(f) Was the corner restored through acceptance of (1) an obliterated evidence location, or, (2) a found perpetuated location?

(2) a found perpetuated location.

(g&h) Was the corner reestablished through lost corner proportionate methods? If so, show the method, including the directions and distances to other public land survey corners used as evidence or used for proportioning in determining the corner location?

Affix Land Surveyor Seal



(i) I, Milo E. Stefan
(Type or print name) certify that the corner location shown on this record was determined by me or under my direction and control and that this U.S. Public Land Survey Monument Record is correct and complete to the best of my knowledge and belief.

Milo E. Stefan
Signature

2/19/86
Date