

U. S. PUBLIC LAND SURVEY MONUMENT RECORD


INSTRUCTIONS: This record shall show the location of the corner and shall include all of the following nine elements (a through i).

- (a) Identify the corner by reference to the U.S. public land survey system.
- = Corner monument restored.

Original Subdivision of Township 34 North, of Range 15 East, by James McBride in 1859.

"North Between Sec's. 11 and 12, at 40.00 chains, set 1/4 Section post."

Hemlock 10 N50E 6
Birch 18 N44W 11

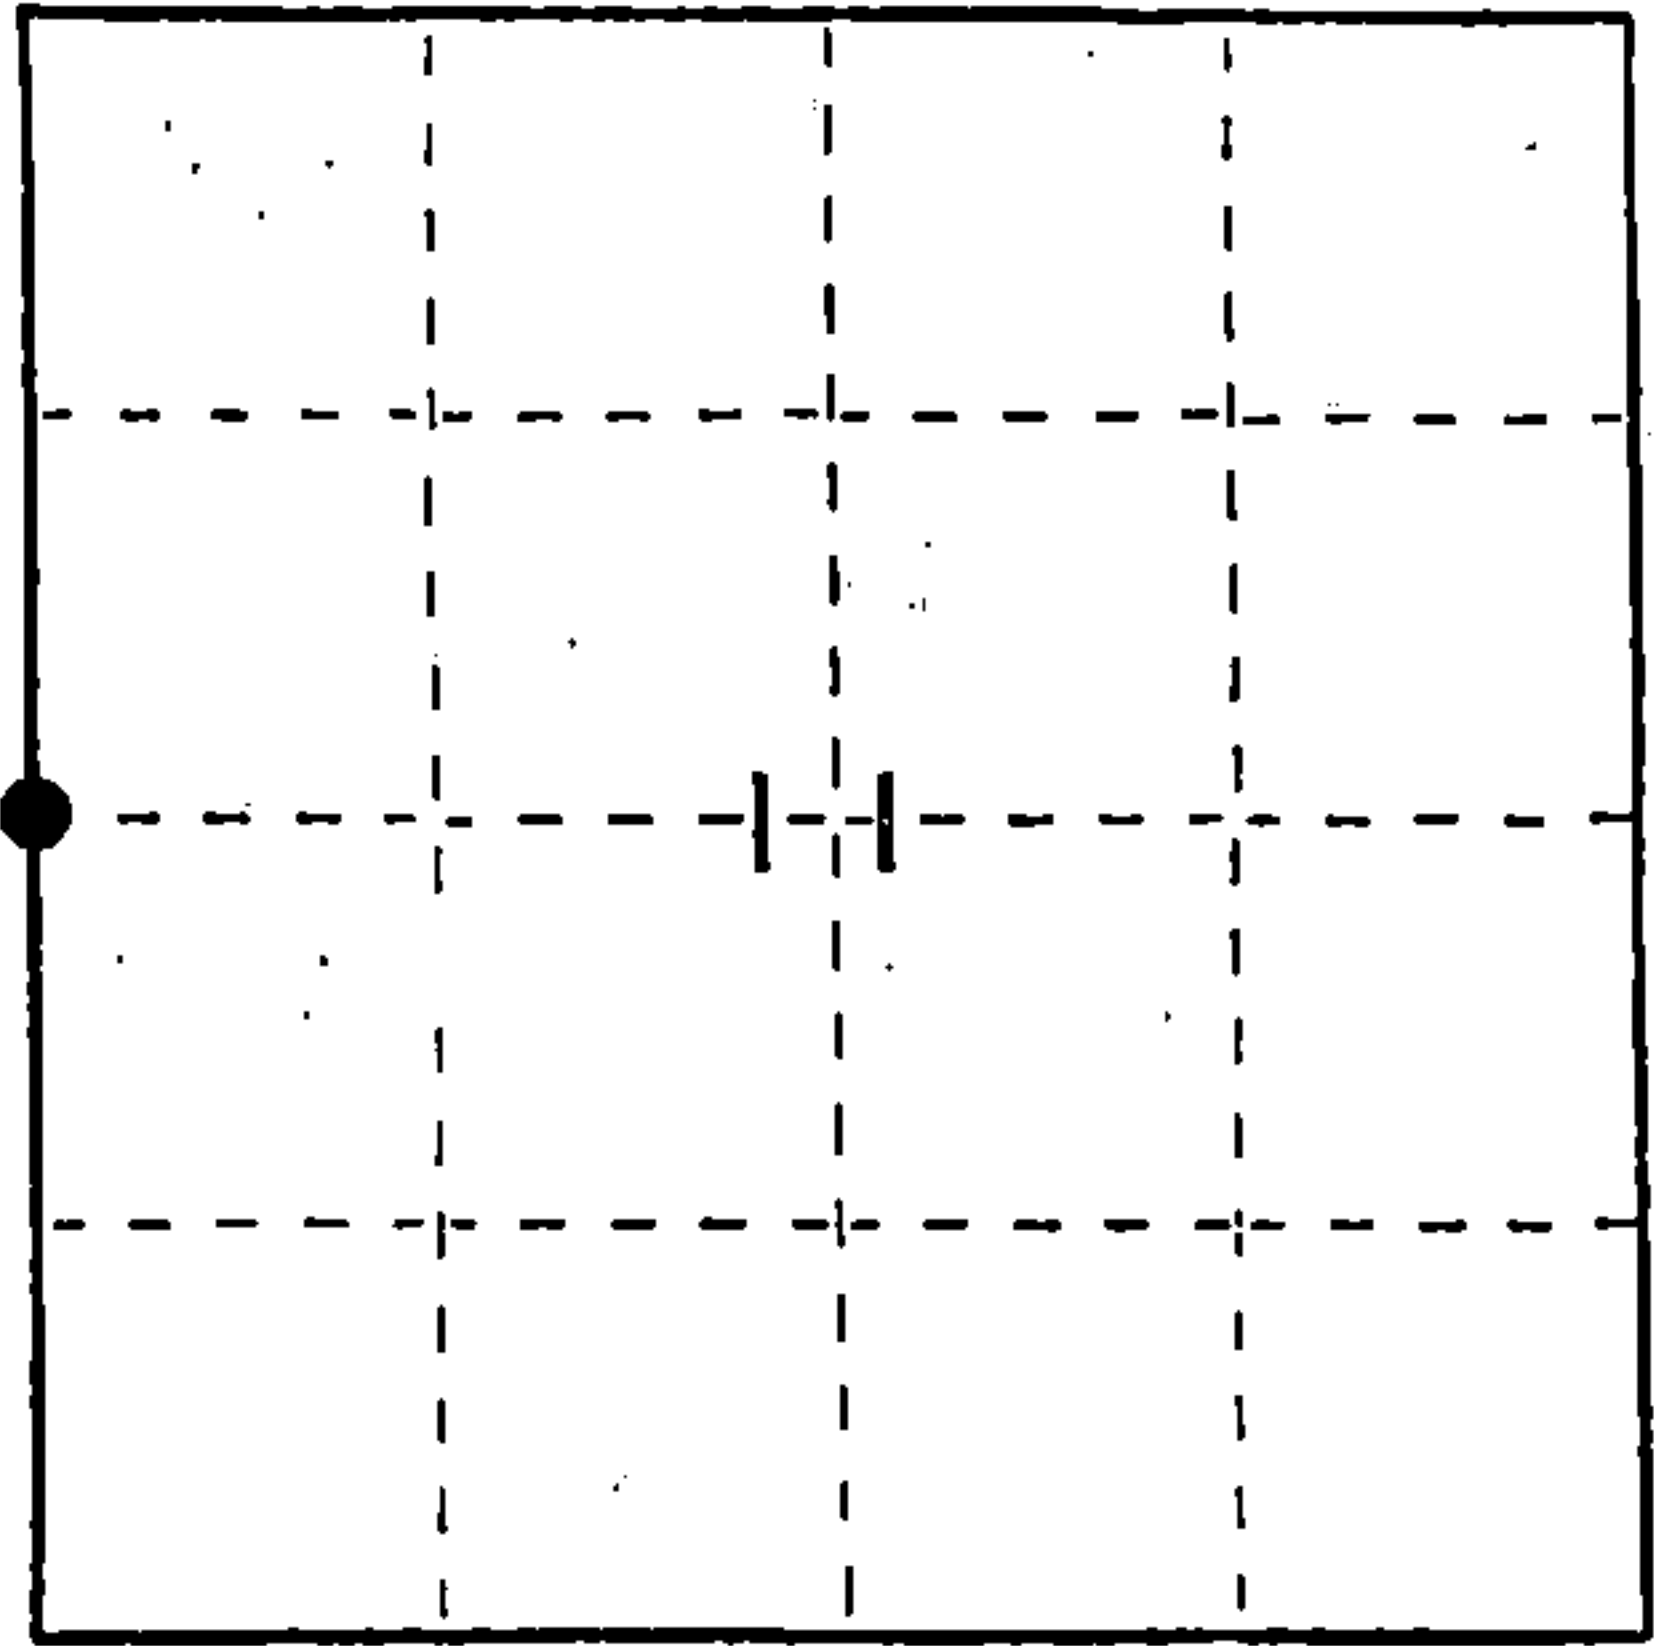

- (b) Describe any record evidence, monument evidence, occupational evidence, testimonial evidence or any other material evidence you considered, and whether the monument was found or placed.

Recovered 3/4" dia. iron rod with flattened top, on east side of 5" squared by 5 foot high wooden post.

This rod has been used in local surveys and is accepted as the best available evidence of the original corner.


Replaced iron rod with 2-1/2" dia. by 36" long aluminum monument with cast aluminum cap. Stamped 1/4 S.
Buried iron rod on east side on new monument.

- (c) In the plan view drawing below, provide reference ties to at least 4 witness monuments, or, if the location is within a municipality, to at least 2 witness monuments. (Witness monuments shall be made of concrete, natural stone, iron or other equally durable material.) Describe witness monuments.

- (d) Show a plan view drawing depicting the relevant monuments and reference ties which is sufficient in detail to enable accurate relocation of the corner monument if the corner monument is disturbed. Indicate north.

REGISTER'S OFFICE
Forest County, Wis.
Received for record this 30th day
of December, A.D., 1987 at
2:00 o'clock P.M. and recorded
in Vol. CORNER RESTORATIONS
page 6-17
Paul Aschenbrenner
Register of Deeds

1. 2-1/2" x 36" ALUMINUM MONUMENT STAMPED TO IDENTIFY THE CORNER.
2. MAPLE, 3" - 5", NORTH, 17.62'
3. MAPLE, 6", S. 81° E., 22.04'
4. MAPLE, 5", S. 6° E., 14.75'
5. YELLOW BIRCH, 12", S. 86° W., 14.86'

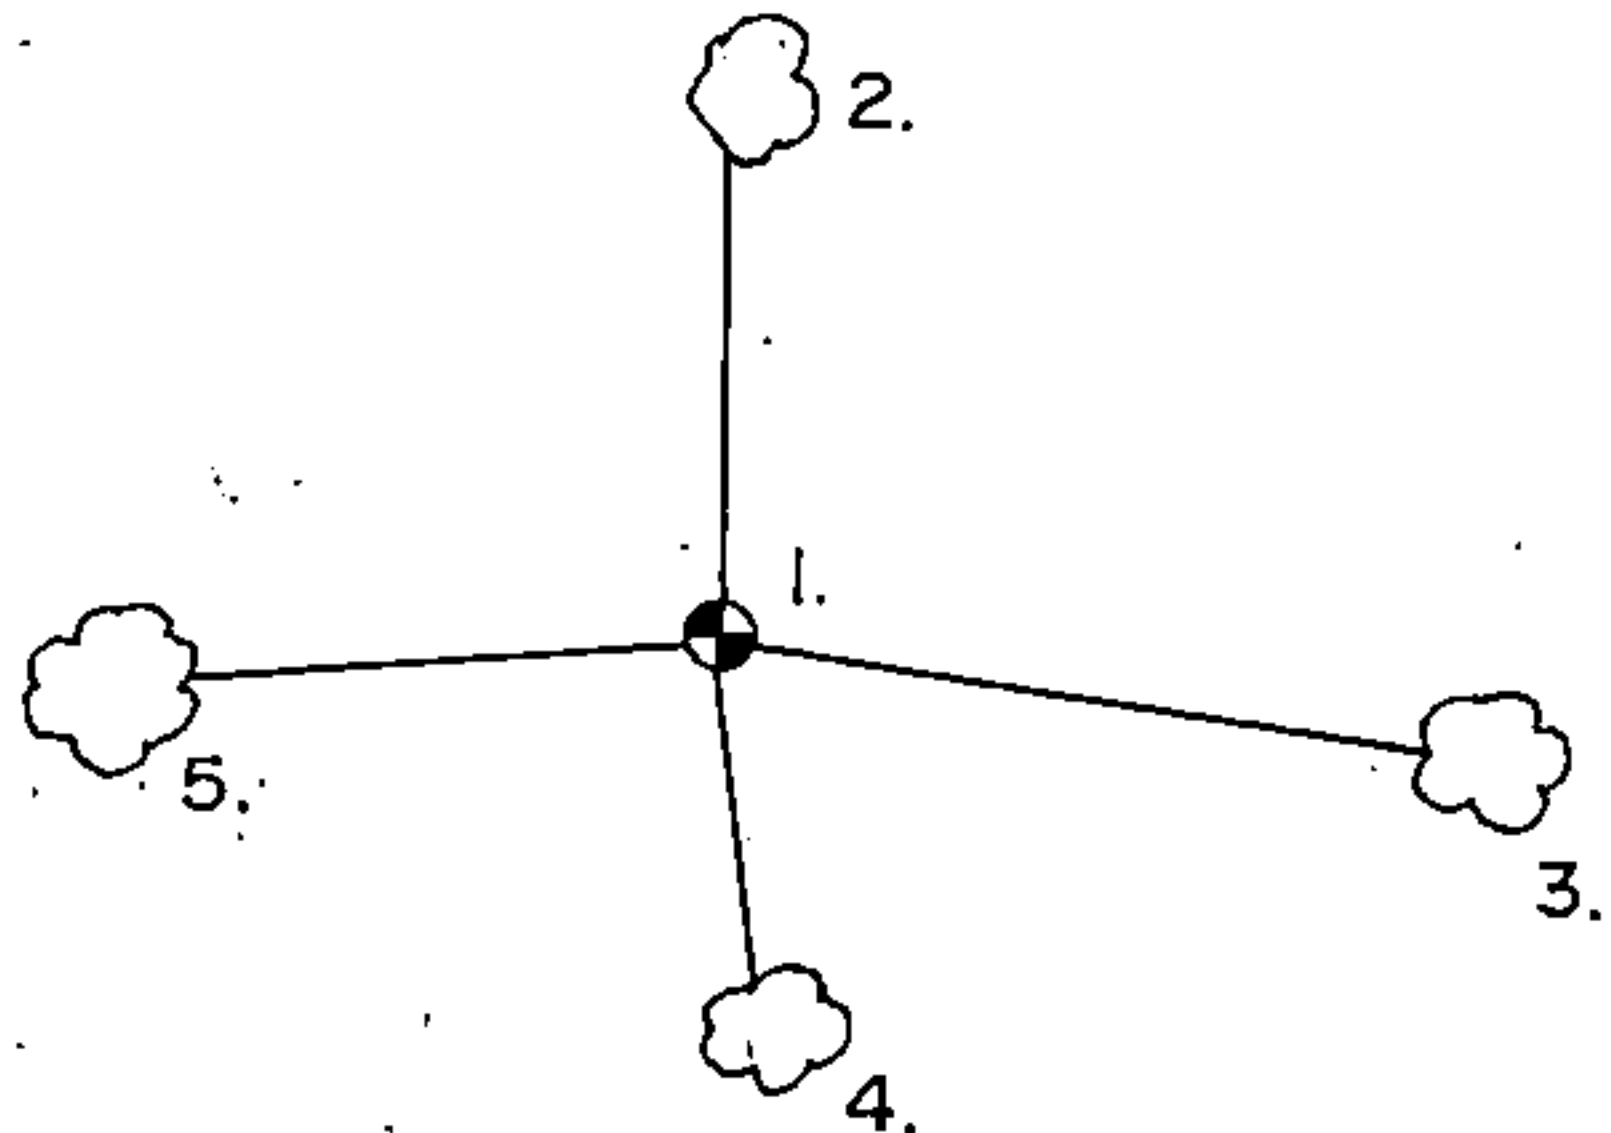

(e) Describe any material discrepancy between the location of the corner as restored or reestablished and the location of that corner as previously restored or reestablished by distance and direction. Show the discrepancy on the plan view drawing under (d), above. Show the distances between the corner as previously restored or reestablished and (1) the corner as restored or reestablished, and (2) to at least 2 of the witness monuments shown on the drawing in (d), above.

(f) Was the corner restored through acceptance of (1) an obliterated evidence location, or, (2) a found perpetuated location?

(g&h) Was the corner reestablished through lost corner proportionate methods? If so, show the method, including the directions and distances to other public land survey corners used as evidence or used for proportioning in determining the corner location?

Affix Land Surveyor Seal



(i) I, R. W. Nordin, Land Surveyor
(type or print name) certify that the corner location shown on this record was determined by me or under my direction and control and that this U.S. Public Land Survey Monument Record is correct and complete to the best of my knowledge and belief.

R. W. Nordin
Signature

10-30-87.
Date