

**U. S. PUBLIC LAND SURVEY MONUMENT RECORD**

**INSTRUCTIONS:** This record shall show the location of the corner and shall include all of the following nine elements (a through i).

(a) Identify the corner by reference to the U.S. public land survey system.

● = Corner monument restored.


Original Subdivision of Township 34 North, of Range 15 East, by James McBride in 1859.

"East Random between Sections 11 and 14.

80.20 intersect section line 25 links North of post.

West corrected.

40.10 Set quarter section post.  
Elm 12 N10E 36  
Hemlock 30 S34E 26

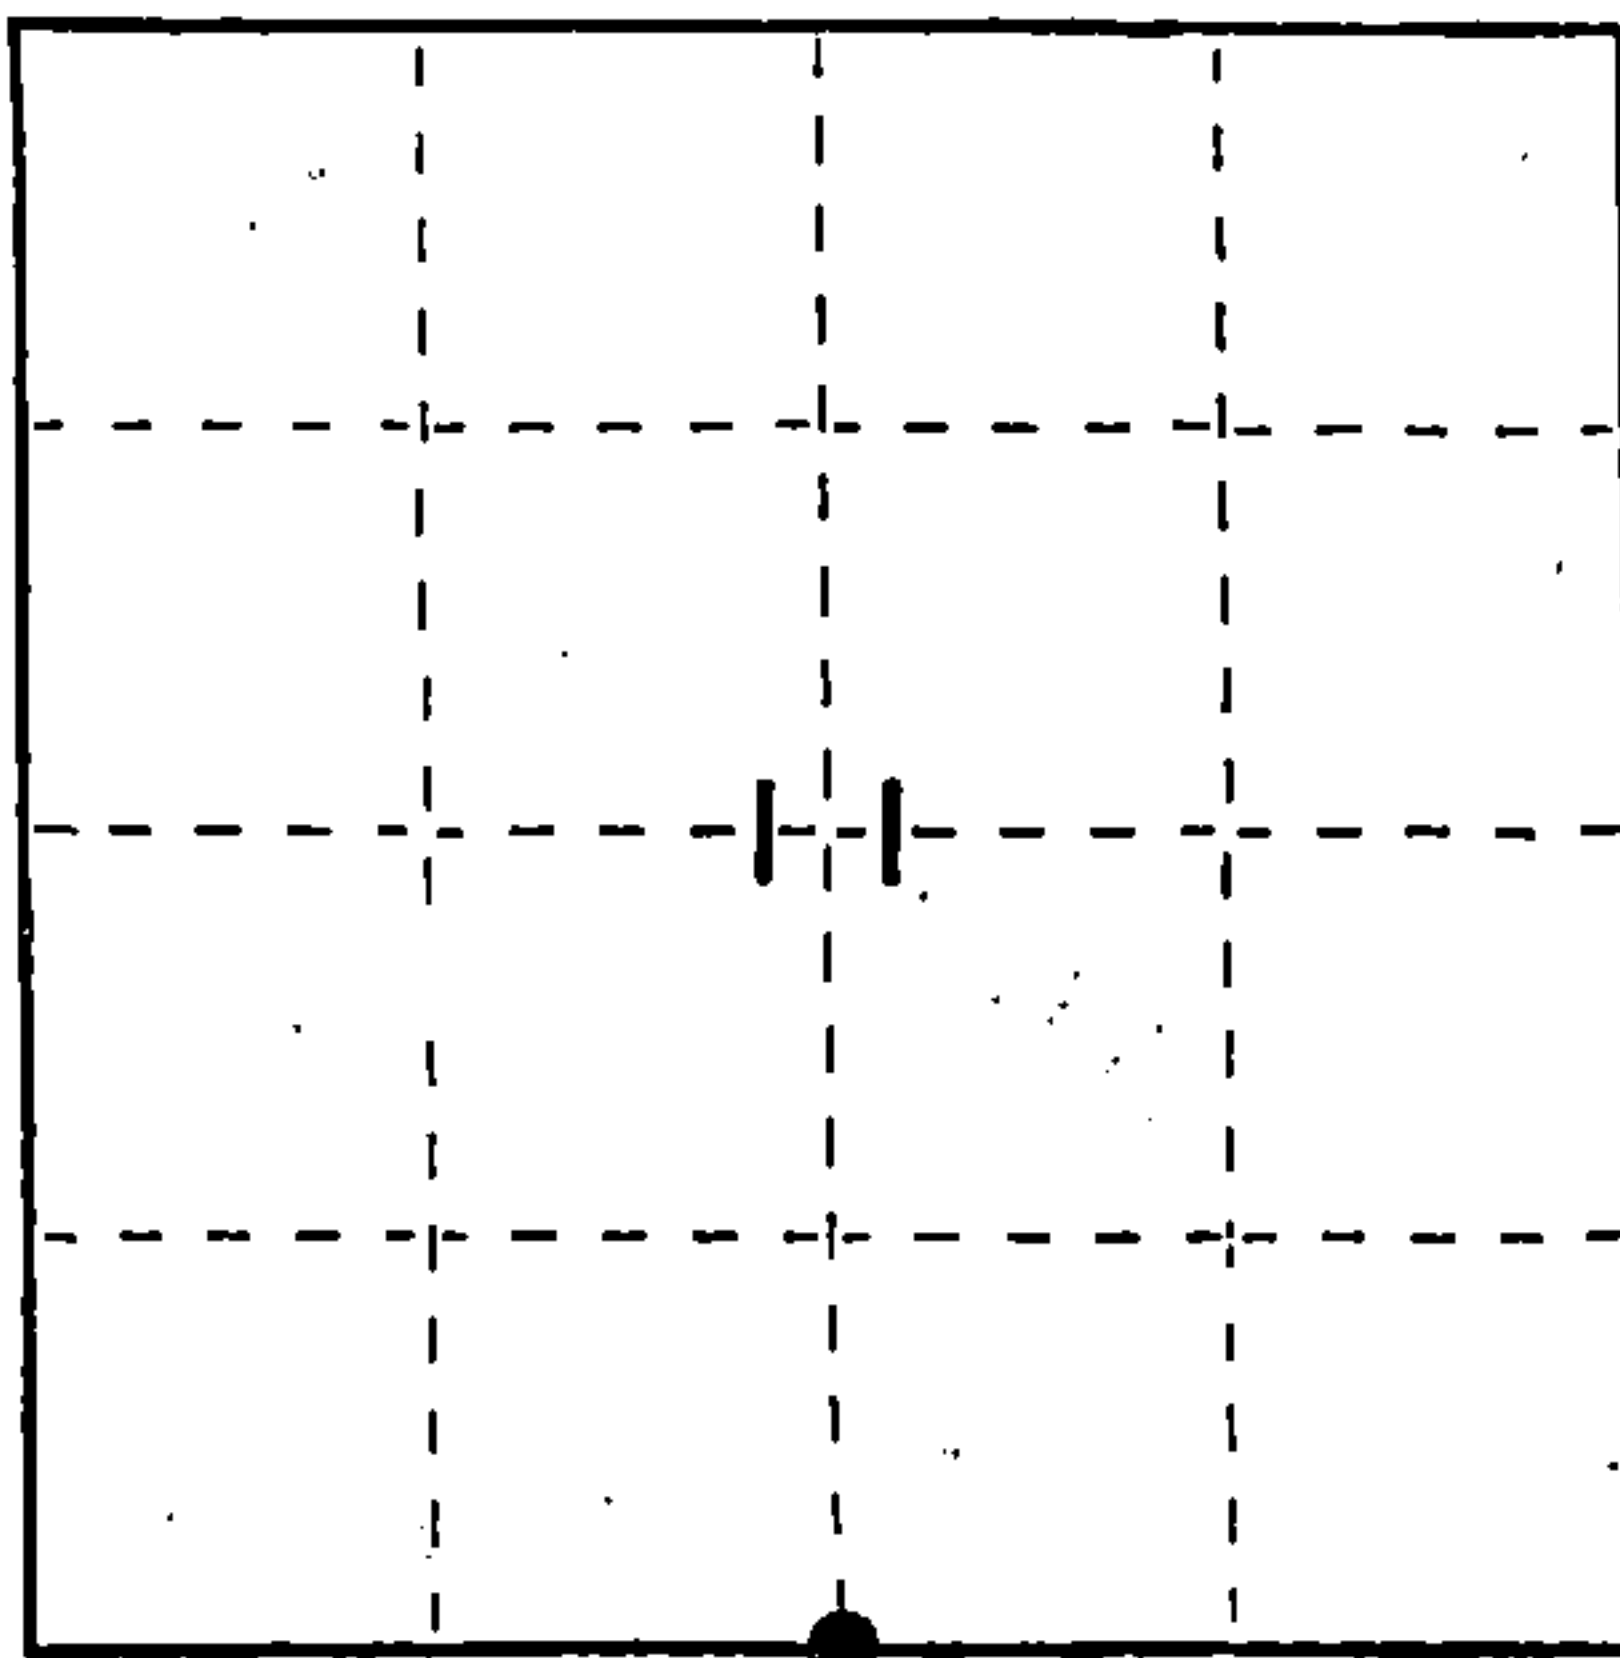

(b) Describe any record evidence, monument evidence, occupational evidence, testimonial evidence or any other material evidence you considered, and whether the monument was found or placed.

After searching the area completely and finding no evidence of the original corner nor its accessories, set corner equidistant and on line between the southeast and southwest corners of the section.


Set 2-1/2" dia. by 36" long aluminum monument with cast aluminum cap for corner. Stamped 1/4 S.

(c) In the plan view drawing below, provide reference ties to at least 4 witness monuments, or, if the location is within a municipality, to at least 2 witness monuments. (Witness monuments shall be made of concrete, natural stone, iron or other equally durable material.) Describe witness monuments.

(d) Show a plan view drawing depicting the relevant monuments and reference ties which is sufficient in detail to enable accurate relocation of the corner monument if the corner monument is disturbed. Indicate north.

REGISTER'S OFFICE  
Forest County, Wis.  
Received for record this 30<sup>th</sup> day  
of December A.D., 1987 at  
2:00 o'clock P.M. and recorded  
in Vol. CORNER RESTORATIONS  
page J-19  
*Paul Acheathanner*  
Register of Deeds

1. 2-1/2"x 36" ALUMINUM MONUMENT STAMPED TO IDENTIFY THE CORNER.
2. MAPLE, 6", N. 57°E., 28.88'
3. MAPLE, 9", S. 34°E., 19.68'
4. MAPLE, 8", S. 37°W., 14.17'
5. MAPLE, 6", N. 36°W., 44.62'

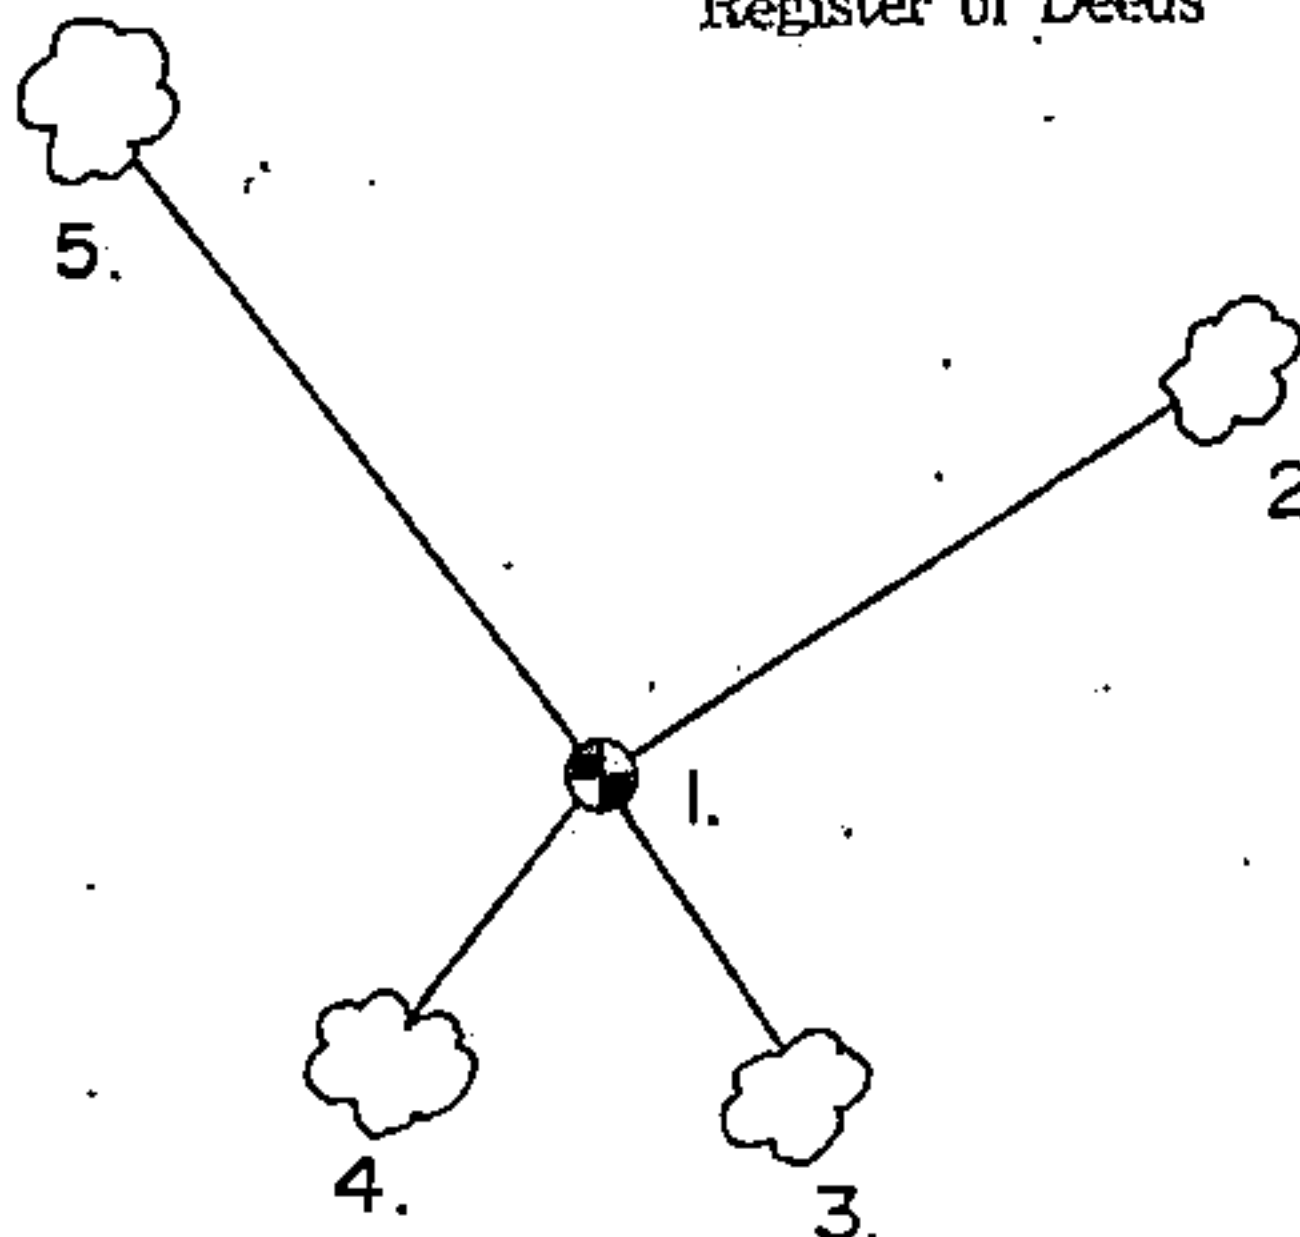

(e) Describe any material discrepancy between the location of the corner as restored or reestablished and the location of that corner as previously restored or reestablished by distance and direction. Show the discrepancy on the plan view drawing under (d), above. Show the distances between the corner as previously restored or reestablished and (1) the corner as restored or reestablished, and (2) to at least 2 of the witness monuments shown on the drawing in (d), above.


(f) Was the corner restored through acceptance of (1) an obliterated evidence location, or, (2) a found perpetuated location?

(g&h) Was the corner reestablished through lost corner proportionate methods? If so, show the method, including the directions and distances to other public land survey corners used as evidence or used for proportioning in determining the corner location?

Yes.

Direct proportion between southeast and southwest Section corners.

Southeast corner bears S.  $87^{\circ}-30'-33''$  E. 2619.47 feet.  
Southwest corner bears N.  $87^{\circ}-30'-33''$  W. 2619.47 feet.

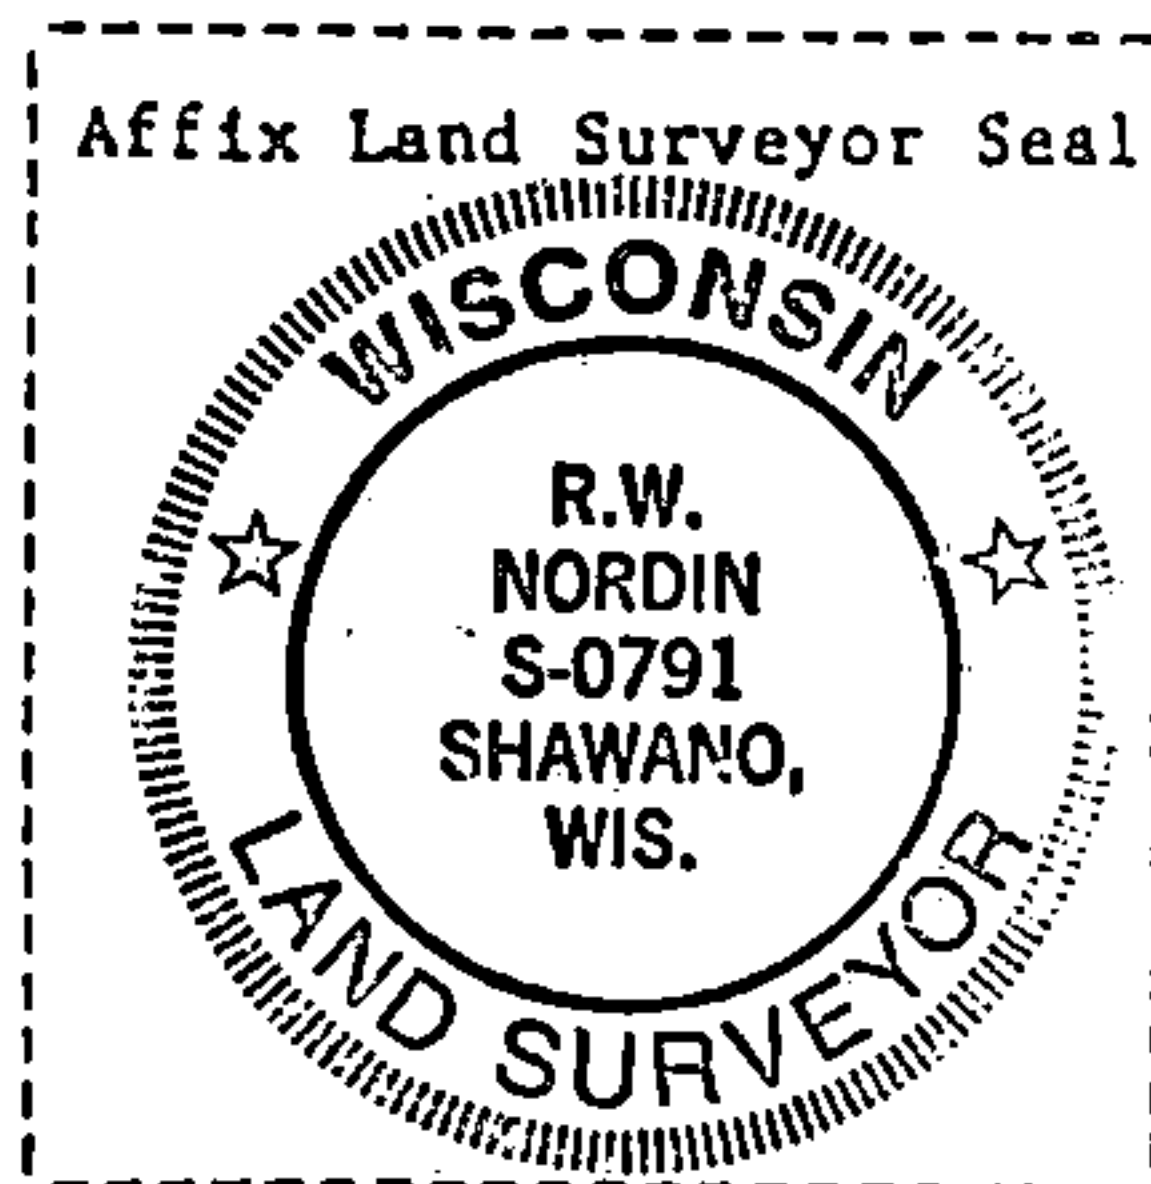

(1) I, R. W. Nordin, Surveyor  
(type or print name) certify that the corner location shown on this record was determined by me or under my direction and control and that this U.S. Public Land Survey Monument Record is correct and complete to the best of my knowledge and belief.

R. W. Nordin  
Signature

10-29-87.  
Date