


U. S. PUBLIC LAND SURVEY MONUMENT RECORD

INSTRUCTIONS: This record shall show the location of the corner and shall include all of the following nine elements (a through i).

- (a) Identify the corner by reference to the U.S. public land survey system.
- = Corner monument restored.

Quarter corner to Sections 11 and 12, T.34N., R.15E.

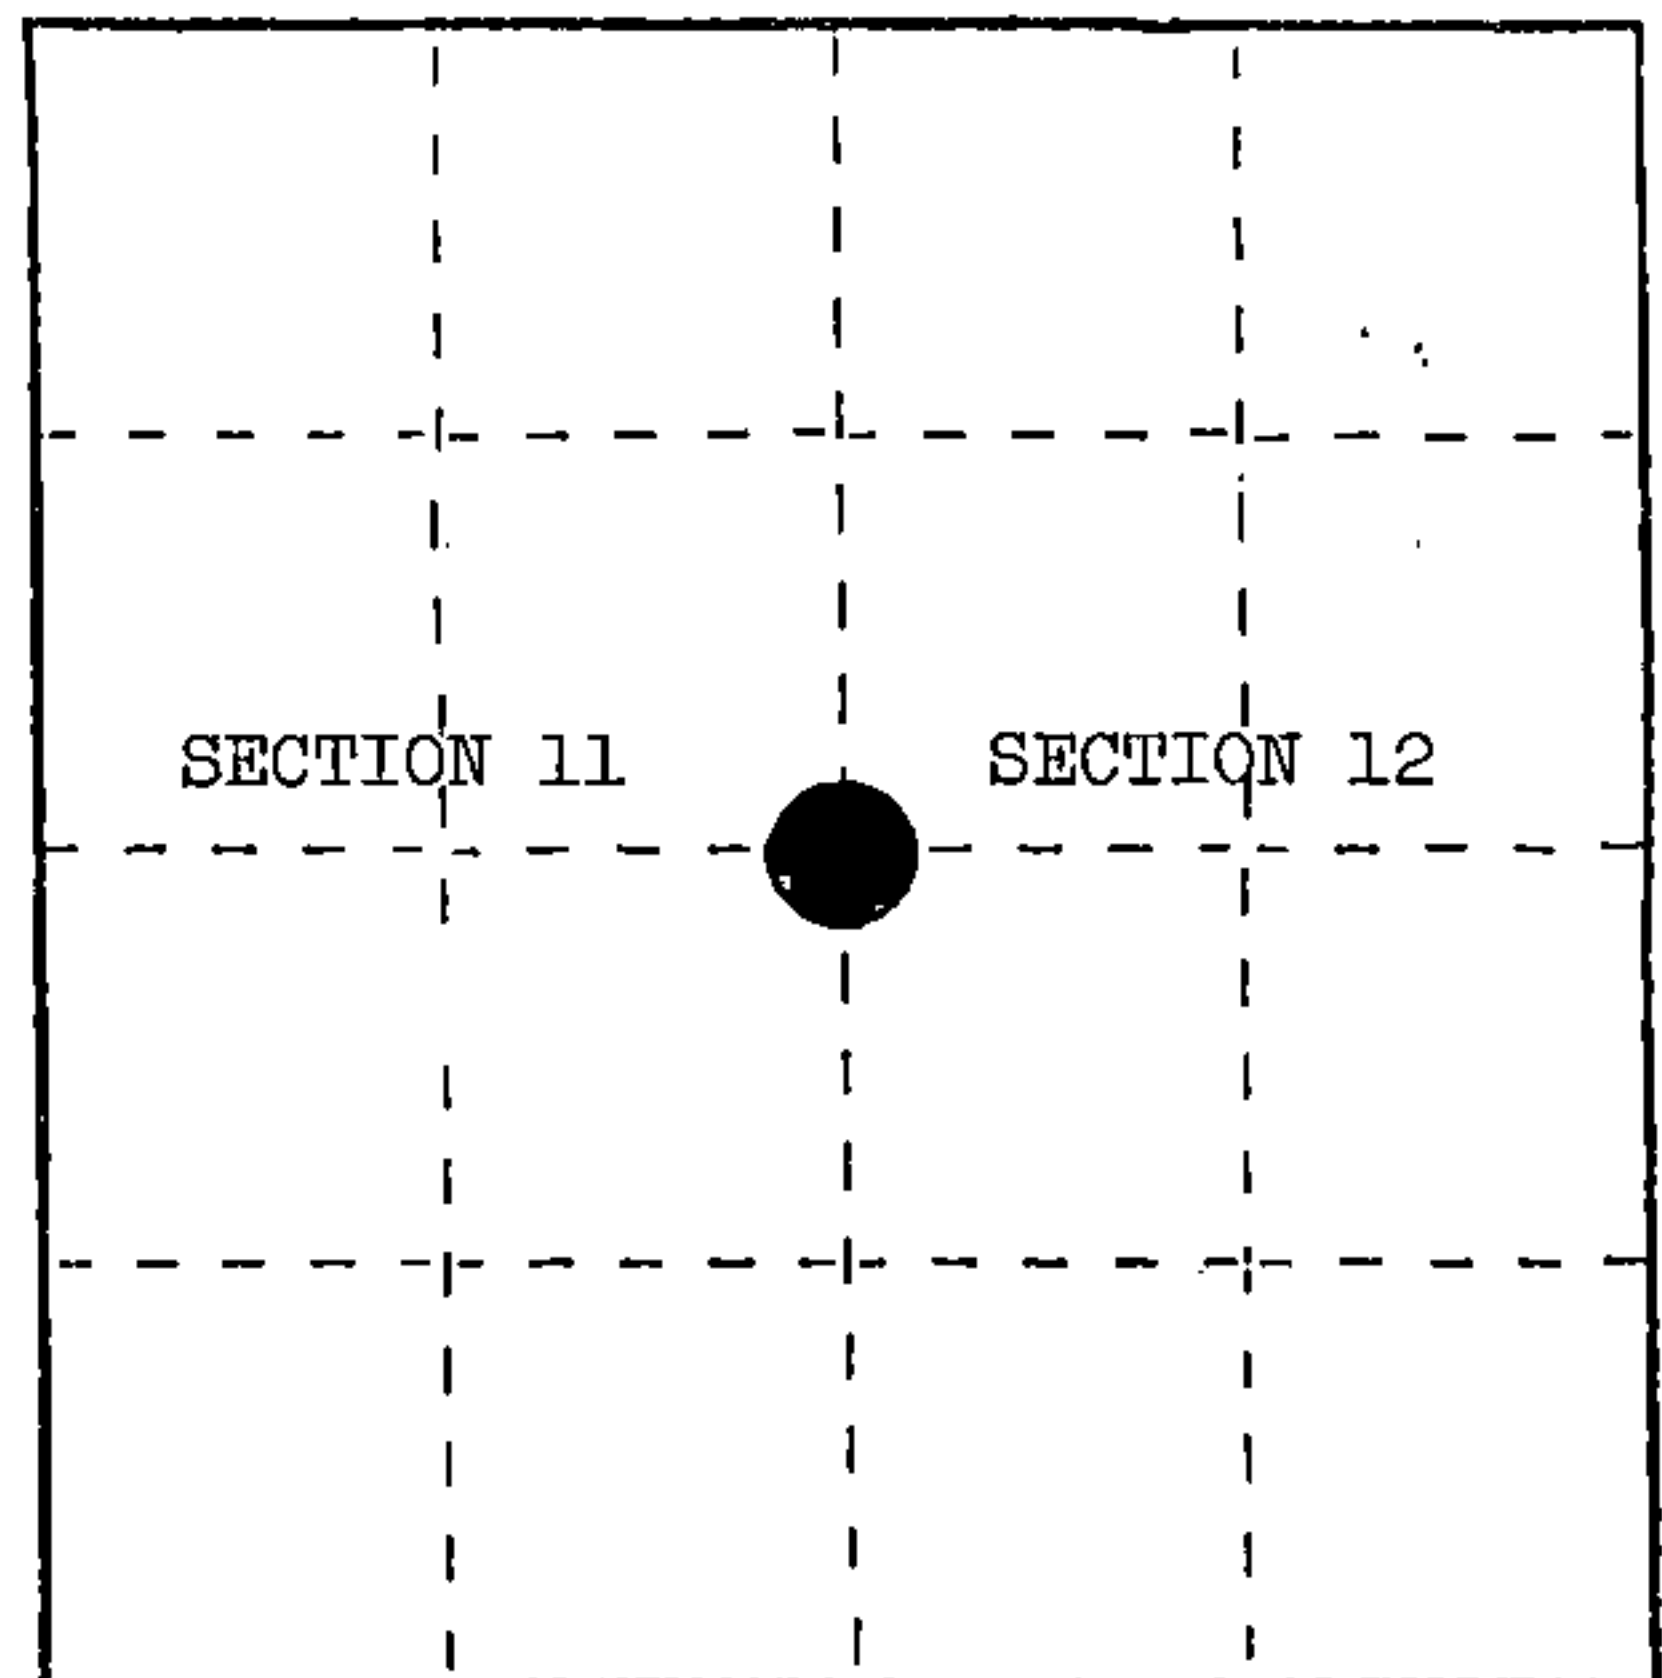


(b) Describe any record evidence, monument evidence, occupational evidence, testimonial evidence or any other material evidence you considered, and whether the monument was found or placed. June-1859, James McBride set $\frac{1}{4}$ section post with the following BTs: Hemlock, 10", N.50°E., 6 links; Birch, 18", N.44°W., 11 links. November 8, 1922, N. H. Smith - stake in mound of stone and made new 14" Hemlock BT, $783\frac{1}{2}$ °E., $44\frac{1}{4}$ links. April 23, 1935, 874 by Robert Kolbe. He found hardwood post but no BTs. Placed location poster on west side of 10" Hemlock, 24 links. May 13, 1969, Resvick chained 40 chains from section corner to Sections 11, 12, 13, and 14, and found location poster on 17" Hemlock. Bulldozer has pushed pile from trail on site top at plantation post seen in rubble. Hemlock could be BT with large blowdown for Birch. October 27, 1983, Milo Stefan found location tag on slab of fallen Hemlock - east instead of west. Found plantation post. June 11, 1984, Milo Stefan - distance from $C\frac{1}{4}$ places corner east of Kolbe's tag. Using Kolbe's data east 24 links, located a small pile of stone, from which the remains of a 16"-18" Hemlock, S.83 $\frac{1}{2}$ °E., $44\frac{1}{4}$ links was found. Placed a 2" x 36" aluminum monument at called distance from Hemlock off 874, West, 24 links.

(c) In the plan view drawing below, provide reference ties to at least 4 witness monuments, or, if the location is within a municipality, to at least 2 witness monuments. (Witness monuments shall be made of concrete, natural stone, iron or other equally durable material.) Describe witness monuments.

(d) Show a plan view drawing depicting the relevant monuments and reference ties which is sufficient in detail to enable accurate relocation of the corner monument if the corner monument is disturbed. Indicate north.

1. Sugar, 6", N.70°E., 31.31'
2. Sugar, 6", S.69°W., 17.00'
3. Sugar, 7", N.14°W., 26.95'
4. Steel Sign Post, South, 2.55'
5. 2" x 36" aluminum monument stamped to identify the corner.

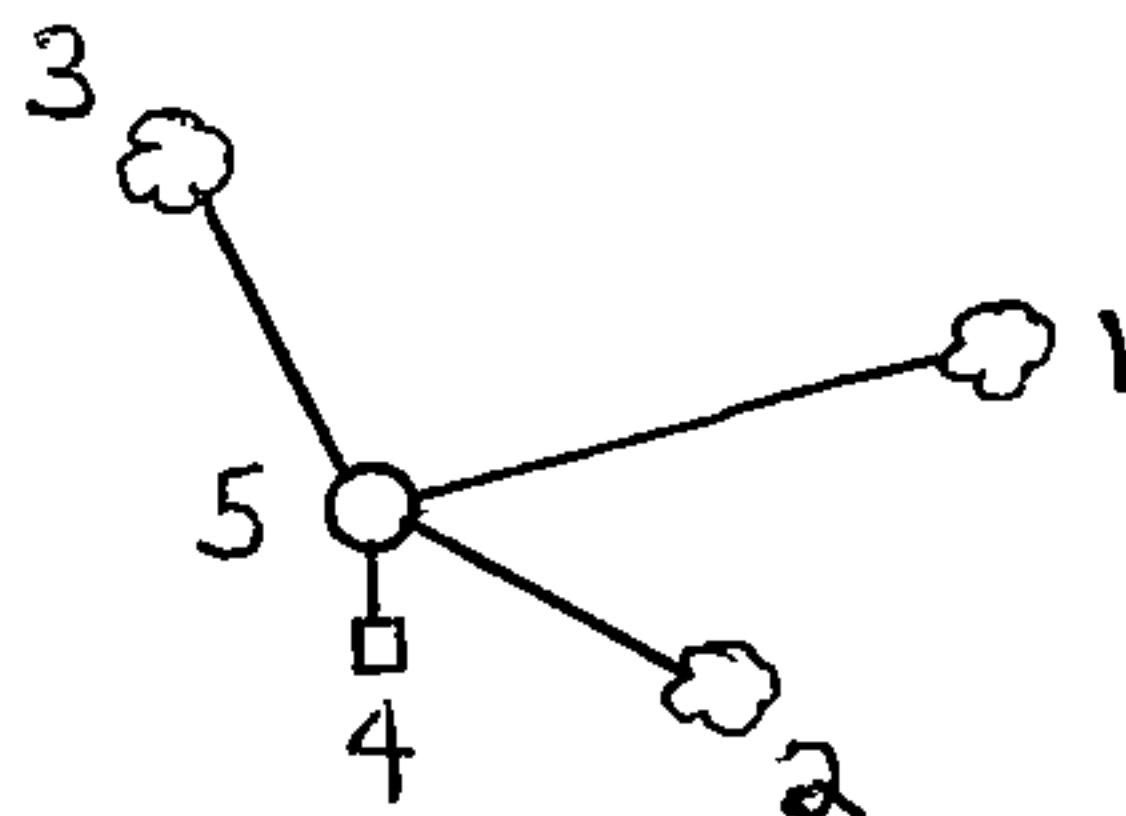

REGISTER'S OFFICE }
 Forest County, Wis. }
 Received for record this... 11th day
 of... January... A.D., 1985 at
 ... 1:00... o'clock... P... M. and
 recorded in Vol. **CORNER RESTORATIONS**
 on page **G-21**
Paul Aschenbrenner
 REGISTER

Describe any material discrepancy between the location of the corner as restored or reestablished and the location of that corner as previously restored or reestablished by distance and direction. Show the discrepancy on the plan view drawing under (d), above. Show the distances between the corner as previously restored or reestablished and (1) the corner as restored or reestablished, and (2) to at least 2 of the witness monuments shown on the drawing in (d), above.

(f) Was the corner restored through acceptance of (1) an obliterated evidence location, or, (2) a found perpetuated location?

(2) a found perpetuated location.

(g&h) Was the corner reestablished through lost corner proportionate methods? If so, show the method, including the directions and distances to other public land survey corners used as evidence or used for proportioning in determining the corner location?

No.

Affix Land Surveyor Seal



(i) I, Milo E. Stefan
(type or print name) certify that the corner location shown on this record was determined by me or under my direction and control and that this U.S. Public Land Survey Monument Record is correct and complete to the best of my knowledge and belief.

Milo E. Stefan
Signature

12/20/84
Date