

CERTIFIED LAND CORNER RESTORATION

State of Wisconsin }  
County of Forest } ss.

I Jean F. Resvick, do hereby certify that on the 27th day of October, 1965, I found evidence of the Northeast corner of Section 22 Township 34 North, Range 15 East, Fourth Principal Meridian, as described hereon; and that from this evidence I established a new monument and accessories as described hereon to perpetuate the original location of this corner:

Description of original monument and accessories and subsequent restorations:

Surveyed in 1859 by James McBride  
80.00 ch. North between sections 22 and 23  
Set wood post from which the following bear  
Sugar 14", N50°W, 51 lks.  
Hemlock 14", N 58 E, 47 lks.  
Sugar 10", S 58°E, 55 lks.  
Sugar 12", S 56°W, 66 lks.


Robert Kolbe of the Connor Lumber Company reports replacing scribed post with iron pipe in 1963.

Description of corner evidence found:


- 1. Iron axle in mound of rock with scribed 4x4 lying along side of axle.  
Sugar stump, N 50°W, 33.7 ft.  
Hemlock stump, N 58°E, 31.0 ft.  
Sugar stump, S 58°E, 36.3 ft.  
Sugar stump, S 56°W, 43.6 ft.  
Hemlock 17 in. diam., scribed, bears East, 4.3 ft. or 6.52 lks.  
Elm 7 in. diam., scribed, bears S 81°W, 16.8 ft. or 25.45 lks.

Description of monument and accessories I established to perpetuate the original location of this corner:

Replaced axle with 2 inch inside diameter, galvanized iron pipe, 5 ft. long, filled with concrete, flanged at bottom, with brass cap marked:

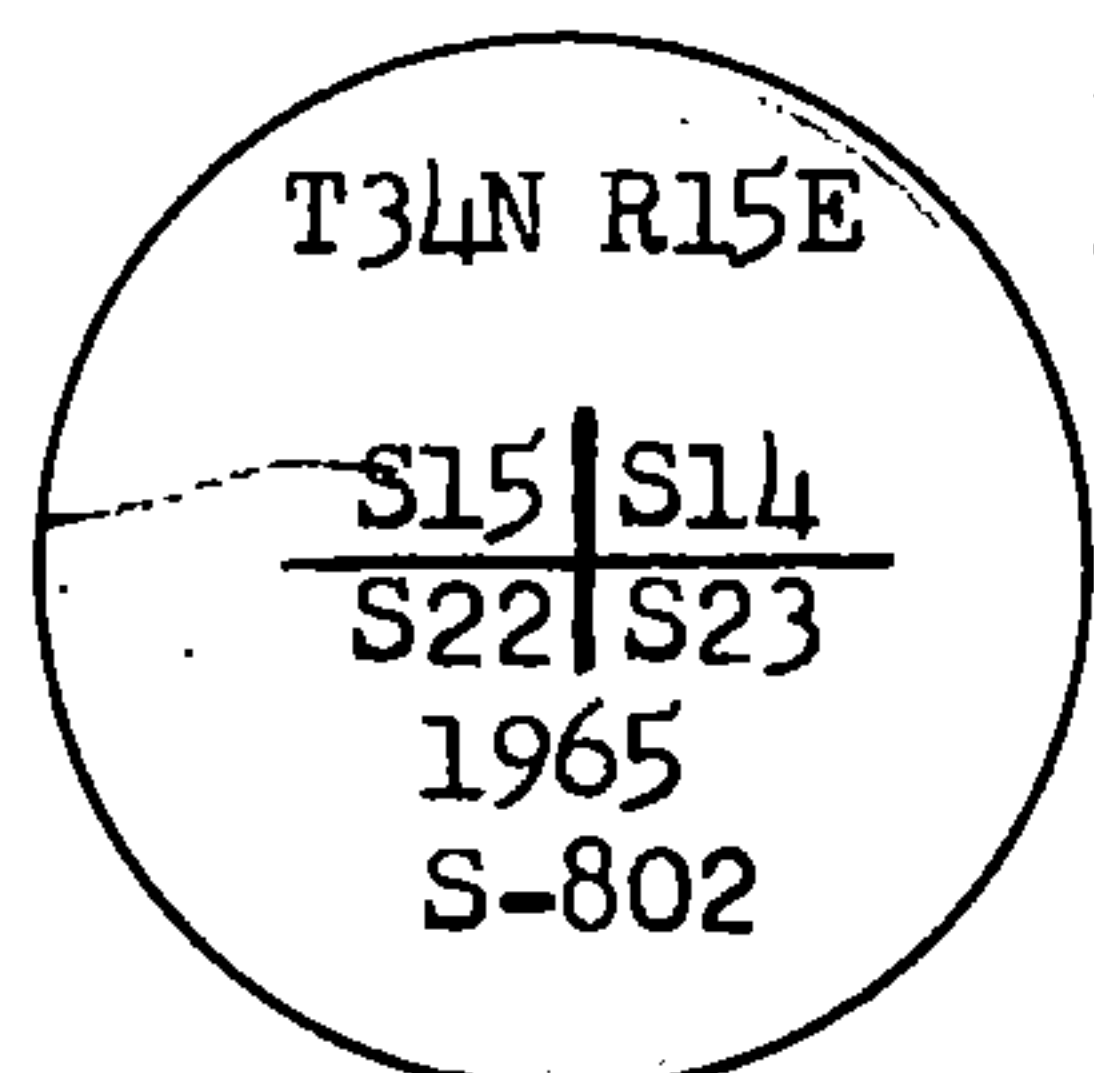

from which the following new blazed and scribed bearing trees bear:  
Elm 4 ins. diameter, bears S 14°E, 13.08 ft. or 19.82 lks.  
Elm 4 ins. diameter, bears N 43°W, 20.02 ft. or 30.33 lks.  
Place axle found on south side of monument.

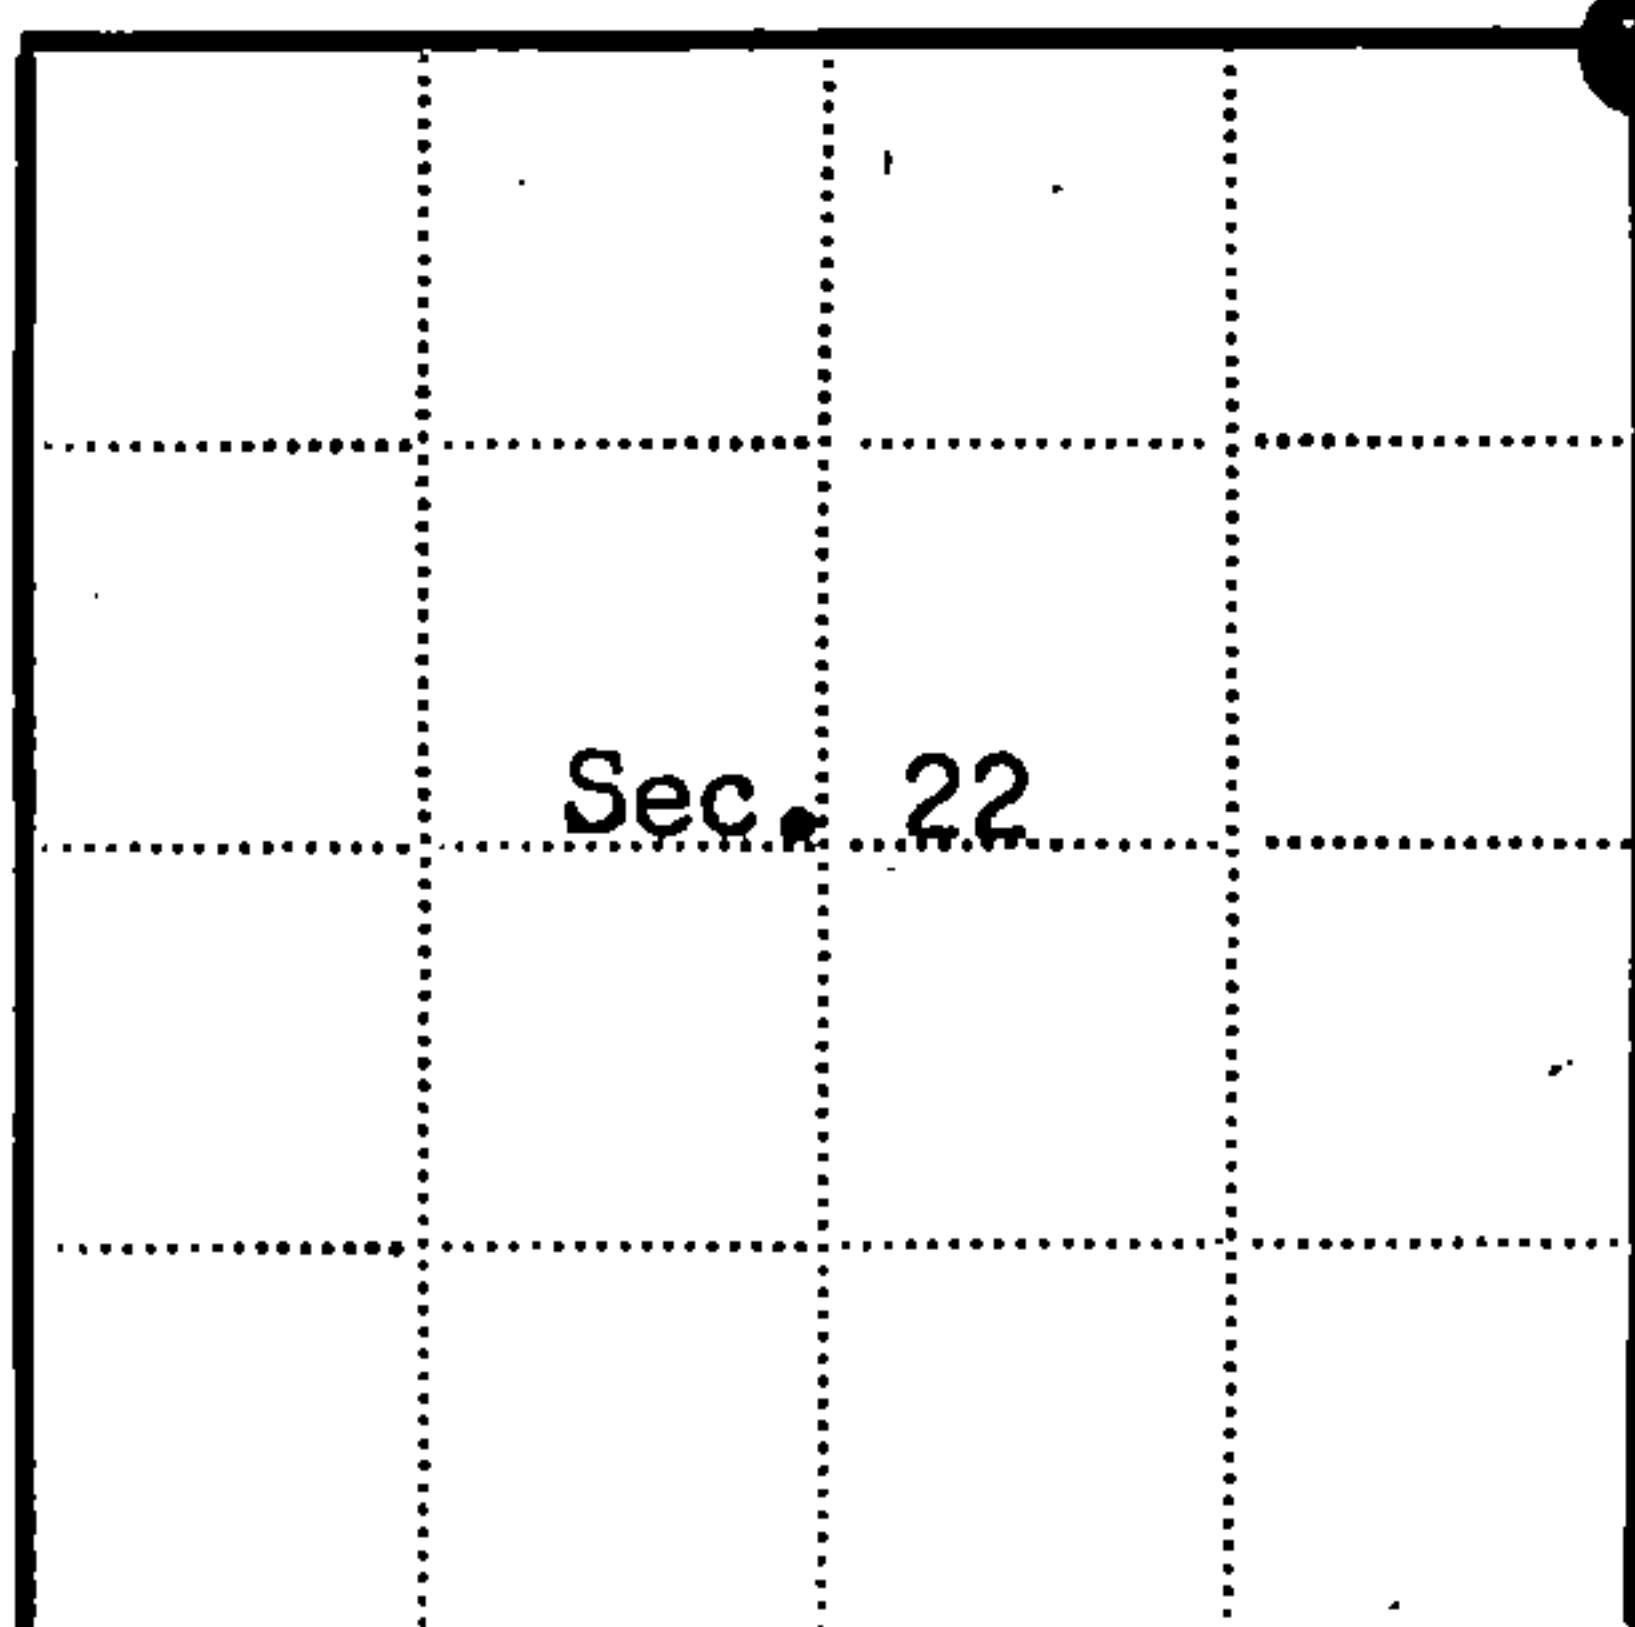

● = Corner monument restored  
□ =

Resident witnesses.....

Dated at Rhinelander Wisconsin, this 7th day of Jan. 1966.

Signature Jean F. Resvick Title Cadastral Surveyor  
(County Surveyor, Registered Land Surveyor, or other duly authorized official)

Surveyors Registration No S-802 91350

Office of Register of Deeds County of Forest  
I hereby certify that the within instrument was filed in this office for record on the 13 day of April 1966, and was filed in Book No. Page No. of County Records.

Signature Anna Peterson Title Register of Deeds

Township 34 North, Range 15 East, Section 22, Index No. N-17, Page No.

43415150000

N17