

CERTIFIED LAND CORNER RESTORATION

State of Wisconsin }  
County of Forest } ss.

I Jean F. Resvick, do hereby certify that on the 22 day of June, 1977, I found evidence of the Southwest Section corner of Section 36 Township 34 North Range 15 East, Fourth Principal Meridian, as described hereon; and that from this evidence I established a new monument and accessories as described hereon to perpetuate the original location of this corner:

Description of original monument and accessories and subsequent restorations:



- Surveyed in 1857 by Artemas Curtis
- 80.00 chains west between Sections 1 and 36, set post
- Cedar 16, N25W, 17 lks.
- Tamarack, 14, N52E, 3 lks.
- Cedar 10, S30E, 36 lks.
- Cedar 12, S48W, 33 lks.

Description of corner evidence found:

- 6x6x4 ft. squared cedar post
- Tamarack stump, with fallen burnt snag, visible scribing N52E, 3 lks.
- Cedar 10, snag 4 ft. high burnt face but scribing visible, N15W, 17 lks.
- Note: Diameter and bearing apparently in error, 6 inch when scribed.
- No evidence of south bearing trees found.

Description of monument and accessories I established to perpetuate the location of this corner:

- Set 2 inch inside diameter galvanized iron pipe, 6 feet long, the top 3 feet filled with concrete, with brass cap stamped, T34N, R15E, S35, S36, S2, S1, T33N, 1977 - S-802
- Blazed and scribed the following new bearing trees
- W. spruce 10, N30E, 20.61 ft.
- W. Spruce 7, S84E, 27.31 ft.
- W. spruce 5, S25W, 26.18 ft.
- B. spruce 9, N58W, 28.67 ft.
- Set steel sign post 6 inches southeast of monument

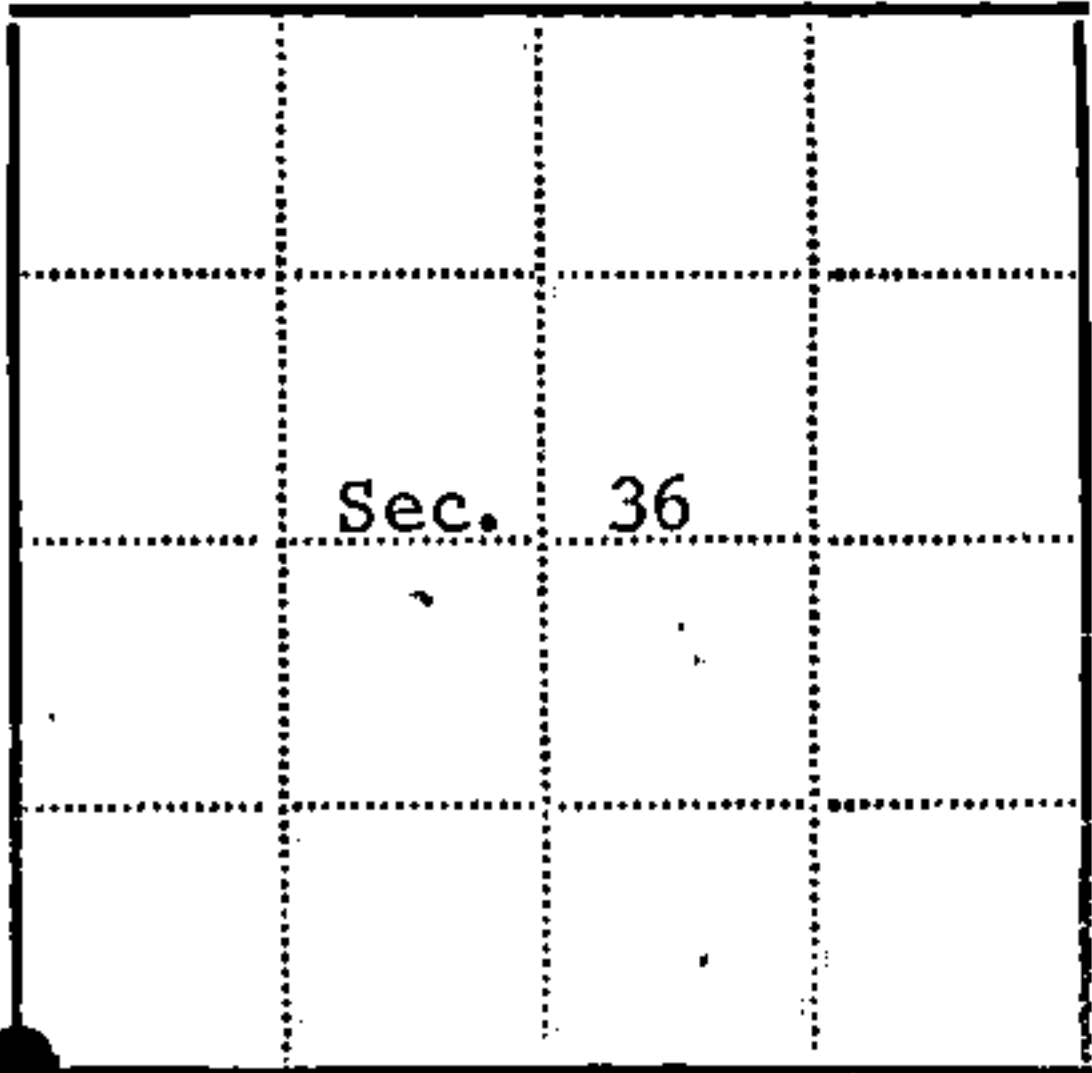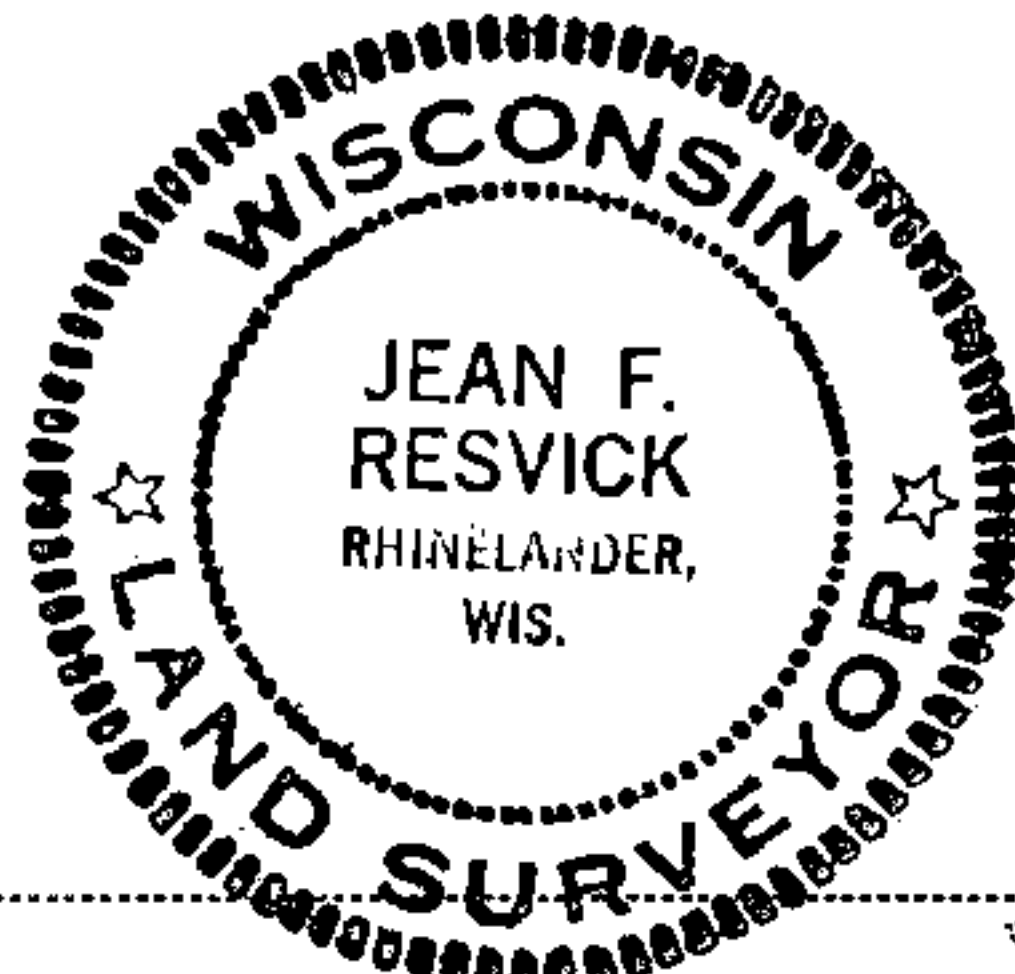

● - Corner monument restored  
 □ -

Resident witnesses.....

Dated at Rhinelander Wisconsin, this 20 day of July 1977.

Signature *Jean F. Resvick* Title Land Surveyor  
 (County Surveyor, Registered Land Surveyor, or other duly authorized official)

Surveyors Registration No. S-802 DOCUMENT NUMBER 113285

Office of Register of Deeds County of Forest

I hereby certify that the within instrument was filed in this office for record on the 13th day of February 1978, and was filed in Book No. Page No. of County Records.

Signature *Eugene Staszynski* Title Register of Deeds

Township 34 North Range 15 East Section 36 Index No. Z-21 Page No.