


U. S. PUBLIC LAND SURVEY MONUMENT RECORD

INSTRUCTIONS : This record shall show the location of the corner and shall include all of the following nine elements (a through i).

(a) Identify the corner by reference to the U.S. public land survey system.

○ = Corner monument restored.

Quarter corner between Sections 4 and 5, T.34N., R.16E.

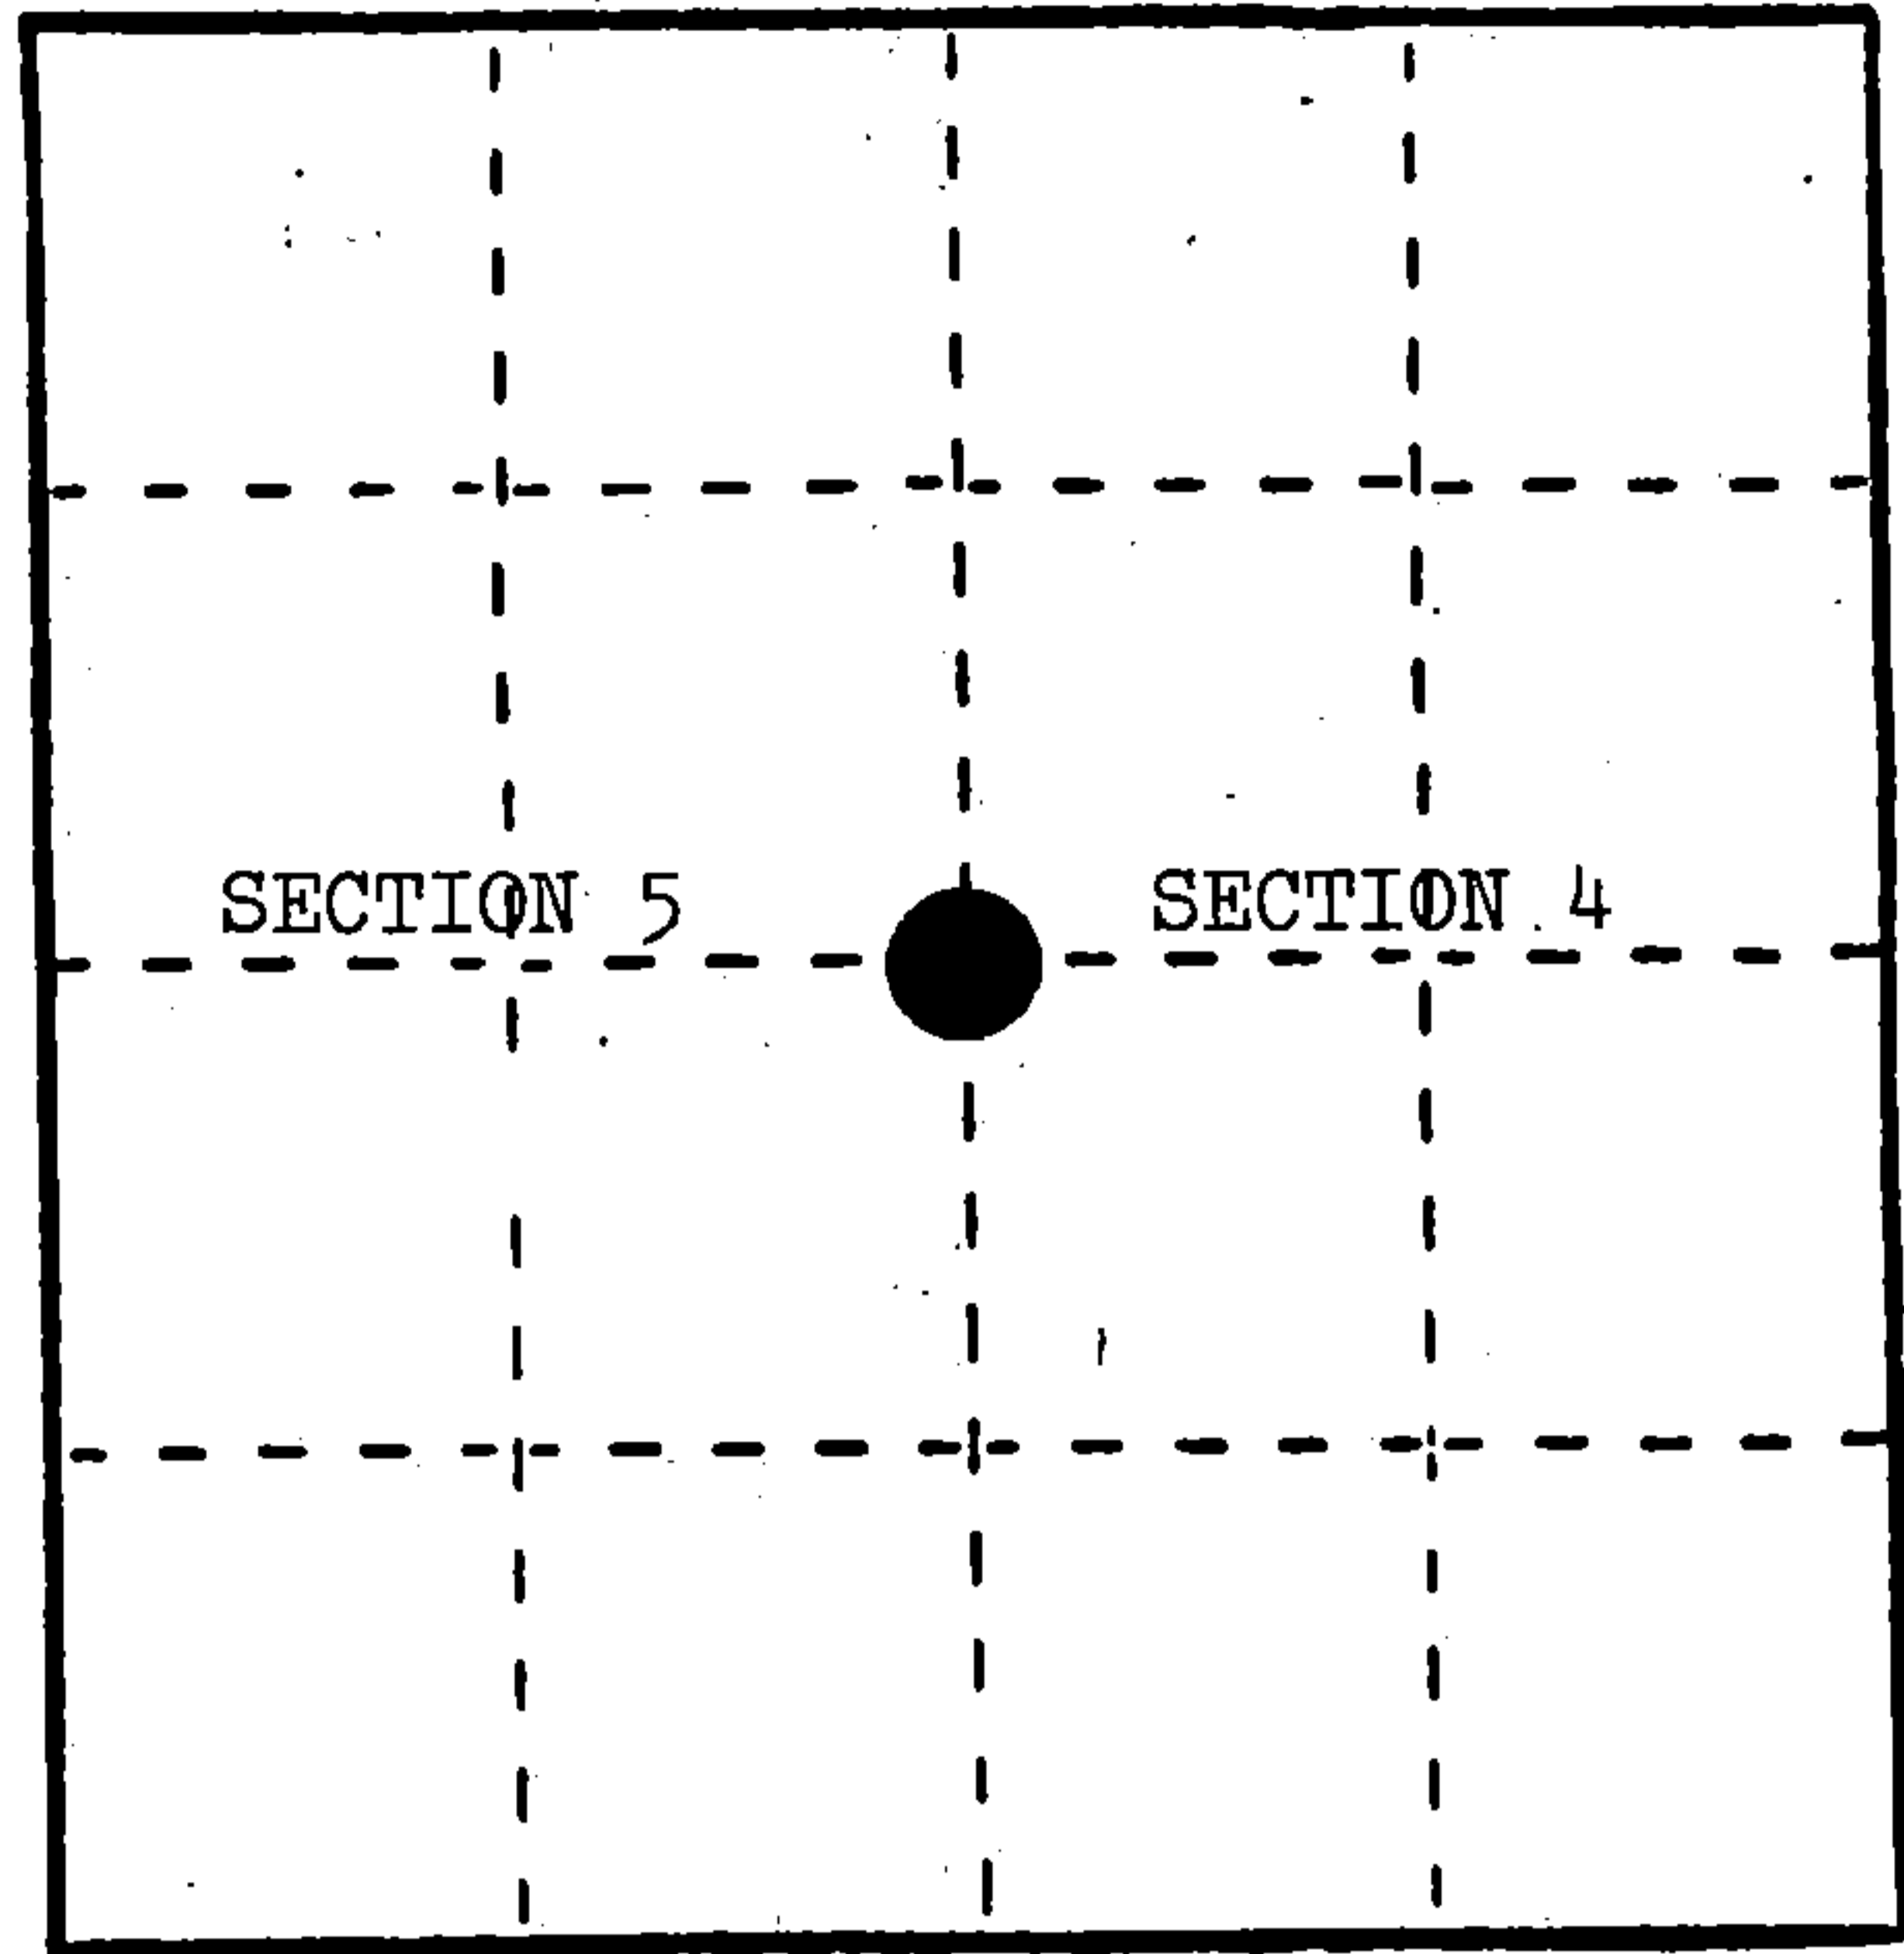

(b) Describe any record evidence, monument evidence, occupational evidence, testimonial evidence or any other material evidence you considered, and whether the monument was found or placed.


In 1858, James McBride set post with the following BTs: Basswood, 11", West, 8 links; Sugar, 13", N.49°E., 11 links.

May 2, 1984, Alan Harrison found remains of Cedar post. Pulled from post hole and found Basswood clump, West, 5.28'; Stump hole of Sugar, N.49°E., 7.5'. Set corner from post hole and stumps.

(c) In the plan view drawing below, provide reference ties to at least 4 witness monuments, or, if the location is within a municipality, to at least 2 witness monuments. (Witness monuments shall be made of concrete, natural stone, iron or other equally durable material.) Describe witness monuments.

(d) Show a plan view drawing depicting the relevant monuments and reference ties which is sufficient in detail to enable accurate relocation of the corner monument if the corner monument is disturbed. Indicate north.

1. 2" x 36" aluminum monument stamped to identify the corner.
2. Steel Sign Post, Northwest, 1.35'
3. Iron Pipe, 1", N.35°E., 3.48'
4. Iron Pipe, 1", S.61°E., 4.26'
5. Iron Pipe, 1/2", S.30°W., 3.24'

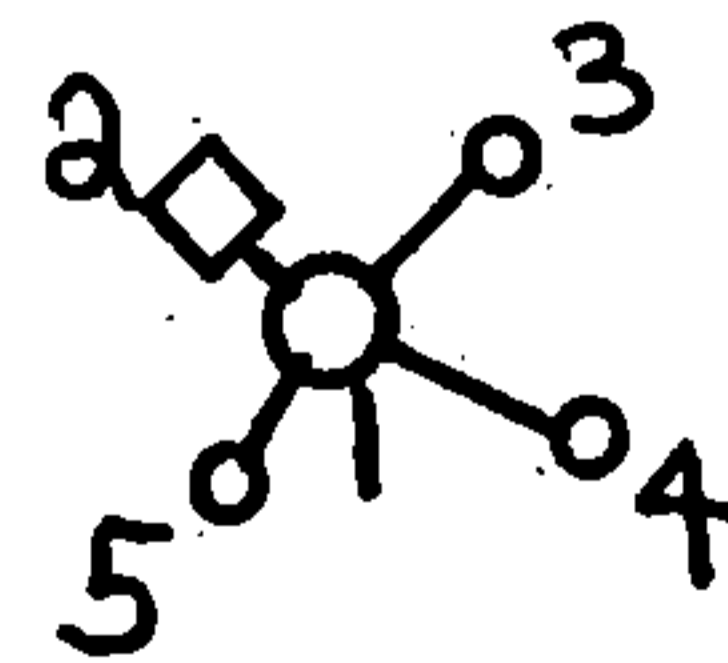

REGISTER'S OFFICE }
 Forest County, Wis. }
 Received for record this... 23rd day
 of January A. D., 1985 at
 ... 2:00 o'clock... P..... M. and
 recorded in Vol. CORNER RESTORATIONS
 on page C-9
Paul Hechenbrenner
 REGISTER

