

CERTIFIED LAND CORNER RESTORATION

State of Wisconsin }
County of Forest } ss.

I Jean F. Resvick, do hereby certify that on the 2nd day of May, 1975, I found evidence of the East Quarter corner of Section 13 Township 34 North, Range 16 East, Fourth Principal Meridian, as described hereon; and that from this evidence I established a new monument and accessories as described hereon to perpetuate the original location of this corner:

Description of original monument and accessories and subsequent restorations:

Surveyed by T. Sprague in November 1839
Surveyed in 1935 by F.P. Gould and B.F. Hammes
Set a 4" iron post for the quarter corner between Sections 13 and 18, with a brass cap stamped: Marinette Co. - Survey, T34N, R16E, T34N, R17E, 1/4, 13, 18



Description of corner evidence found:

Monument as described above and in place.

Description of monument and accessories I established to perpetuate the location of this corner:

Blazed and scribed the following new bearing trees:

Basswood, 4", N44°W, 22.12 feet
Maple, 12", S62°W, 34.14 feet
Set a steel sign post SE of the monument, 0.50 feet

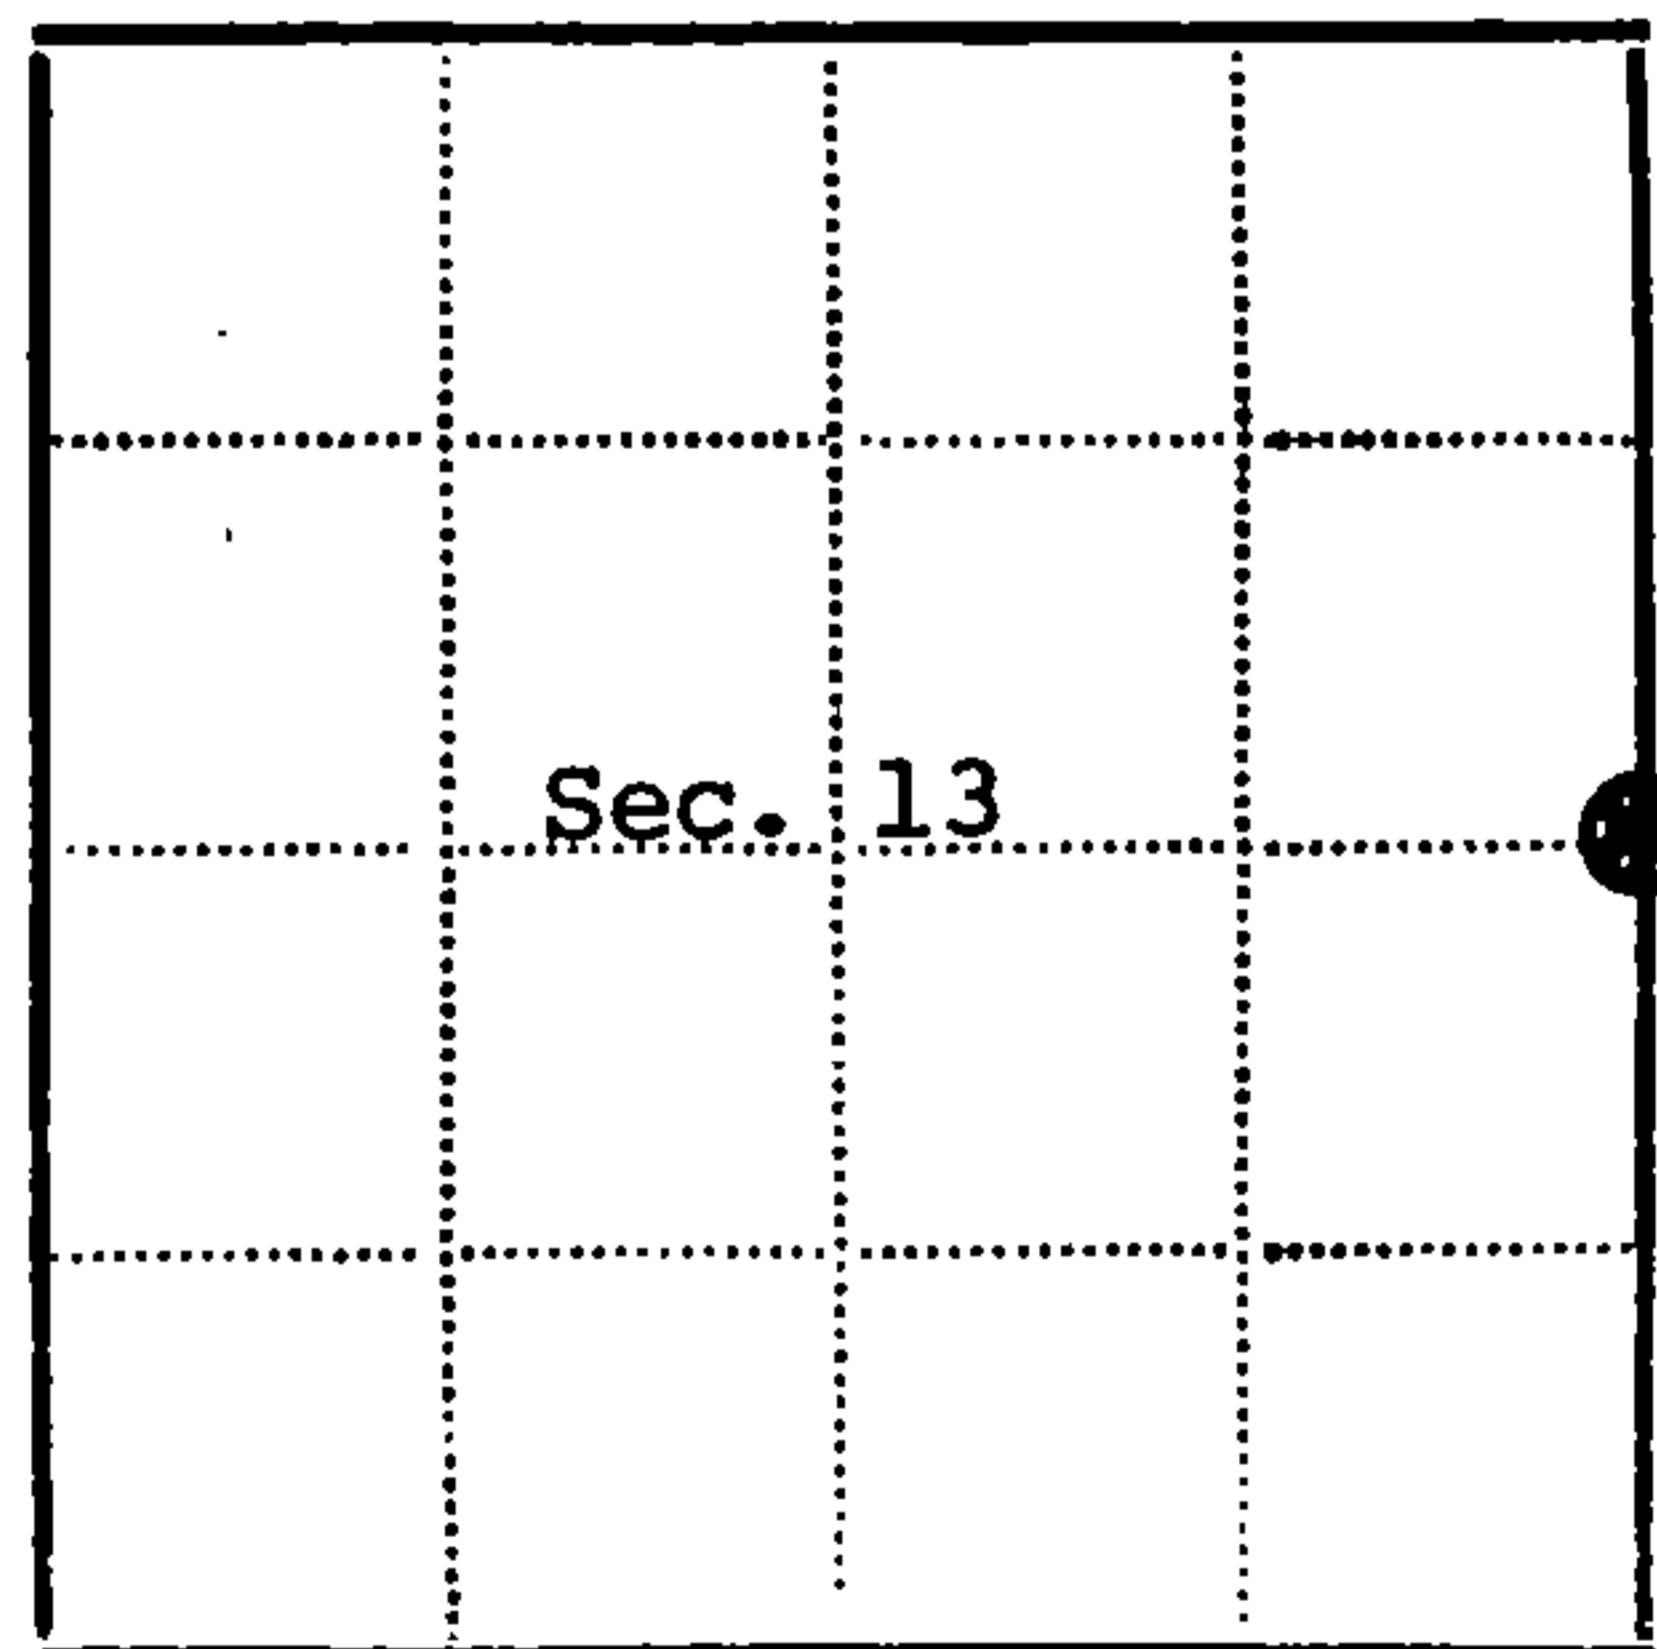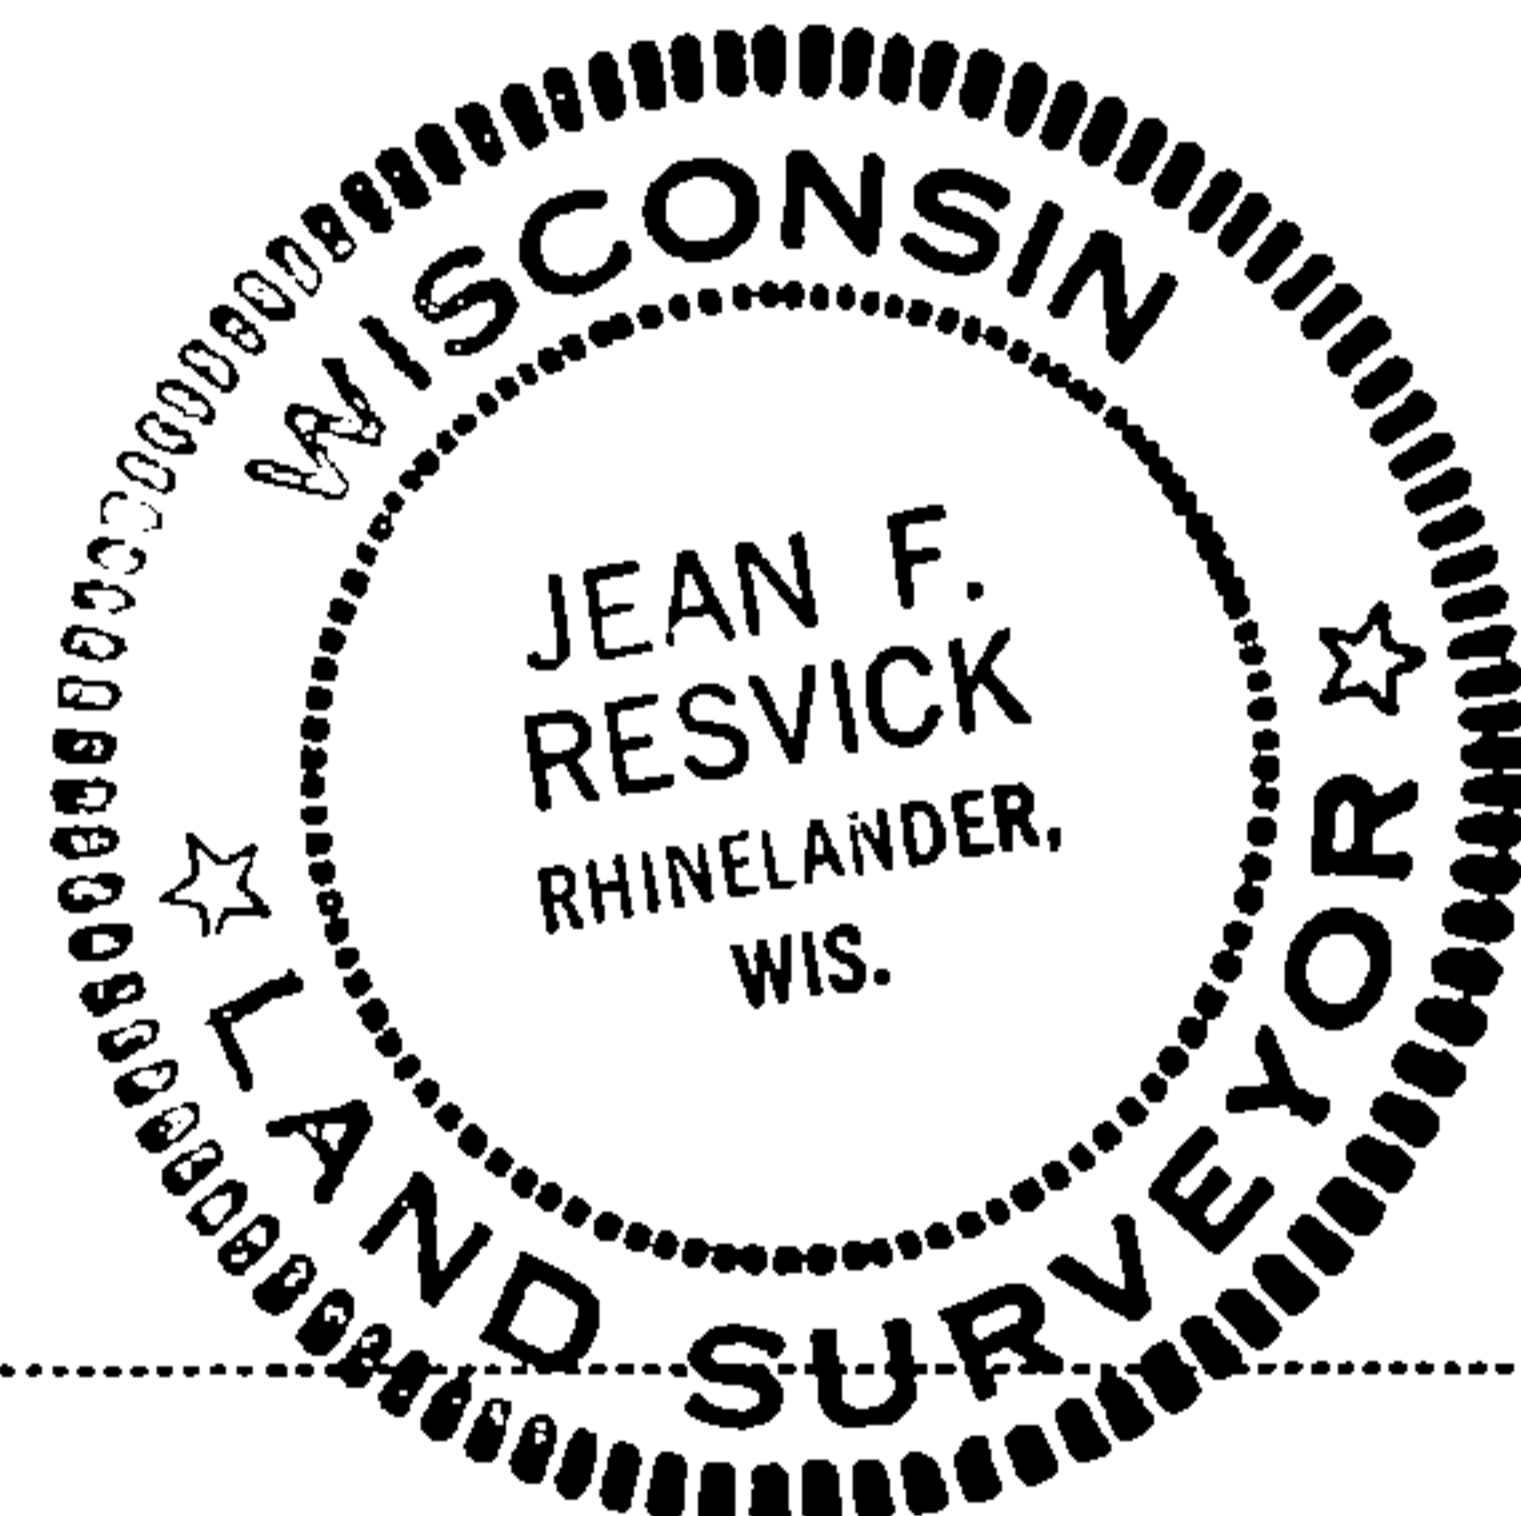

● - Corner monument restored
□ -

Resident witnesses.....

Dated at Rhinelander Wisconsin, this 15 day of June 1976.

Signature *Jean F. Resvick* Title Land Surveyor
(County Surveyor, Registered Land Surveyor, or other duly authorized official)

Surveyors Registration No. S-802 DOCUMENT NUMBER 109579

Office of Register of Deeds County of Forest

I hereby certify that the within instrument was filed in this office for record on the 2nd day of July 1976, and was filed in Book No. Page No. of County Records.

Signature *Eugene Staszny* Title Register of Deeds

Township 34 North, Range 16 East, Section 13, Index No. L-25, Page No.


U. S. PUBLIC LAND SURVEY MONUMENT RECORD

INSTRUCTIONS:

This record shall show the location of the corner and shall include all of the following nine elements (a through i).

- (a) Identify the corner by reference to the U.S. public land survey system.
● = Corner monument restored.

Quarter Corner to Sections 13 and 18,
T.34N., R.16 and 17E., Forest and
Marinette County, Wisconsin.

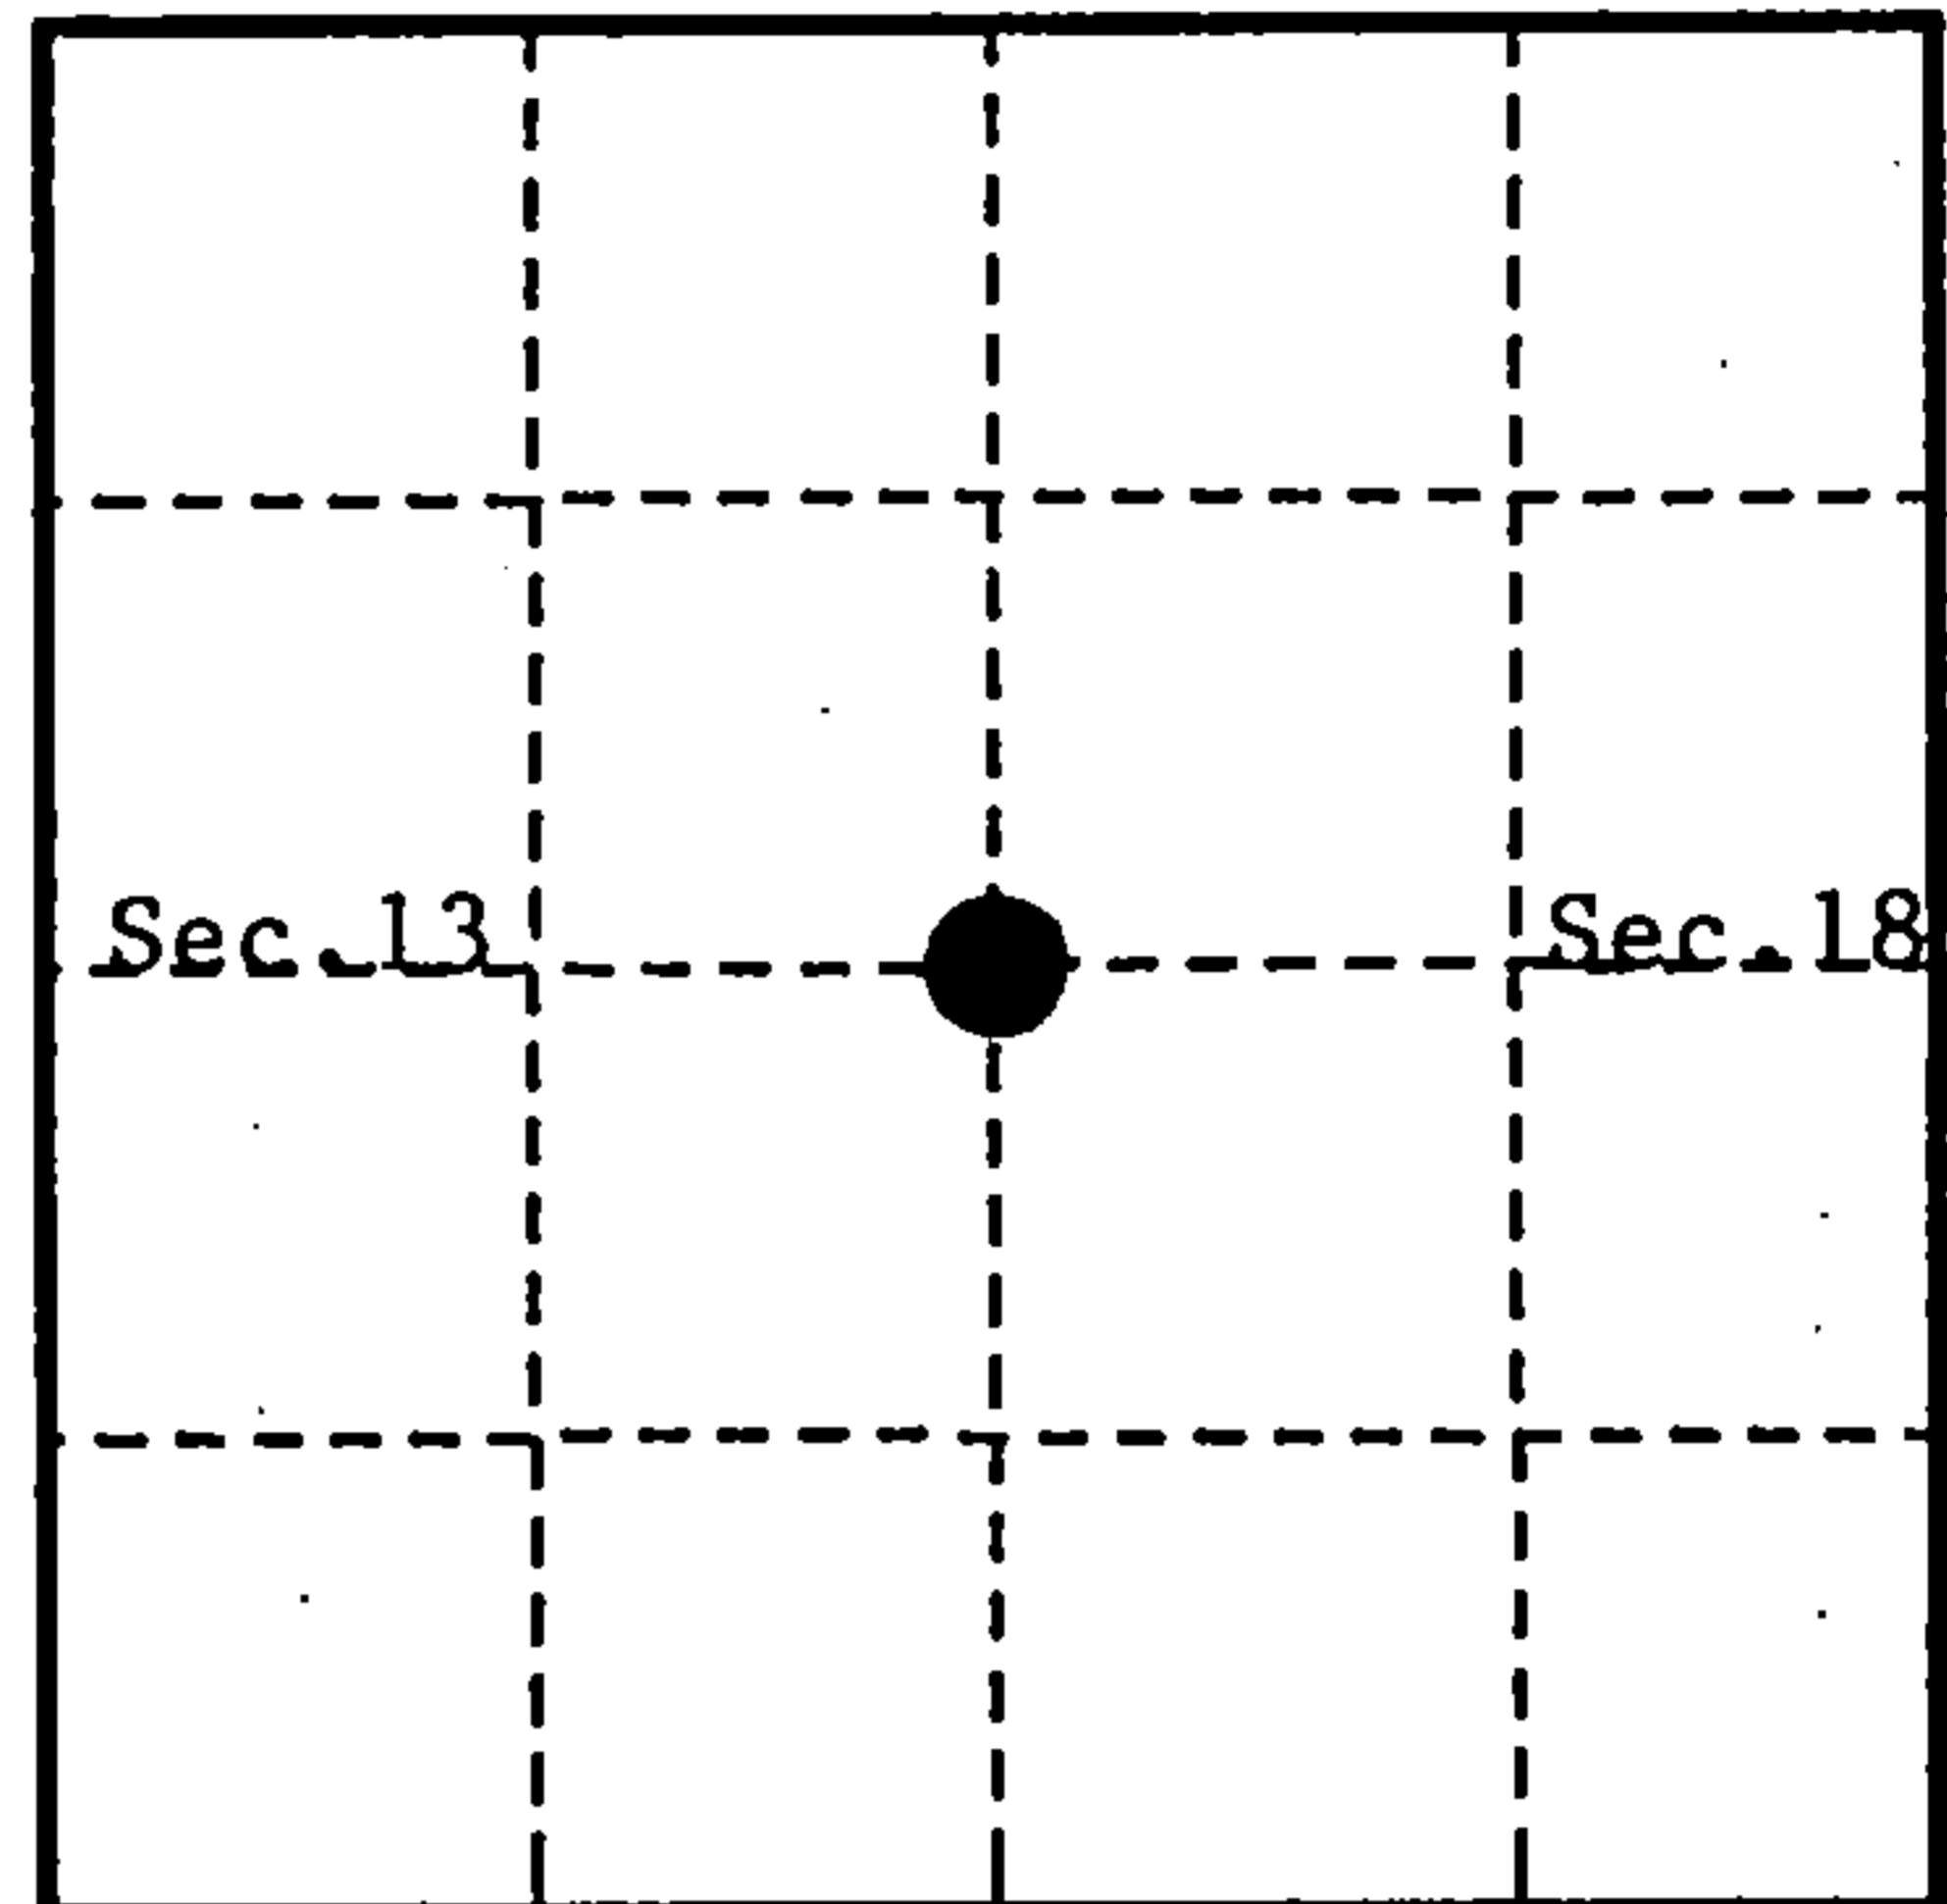

- (b) Describe any record evidence, monument evidence, occupational evidence, testimonial evidence or any other material evidence you considered, and whether the monument was found or placed.

In 1839, Tom Sprague set a wood post with the following B.T.'s: Sugar, 10", S.39W., 15 links (9.90 feet); Hemlock, 13", N.44W., 15 links (9.90 feet).

In 1933, Robert Colbe (C.C.C.) found Elm stake.

In 1935, F.P. Gould, Deputy Surveyor, Marinette County, set 4" pipe with a stamped brass cap to identify the corner.


In 1976, William Cochrane (R.L.S.) found monument in place. Set the following B.T.'s: Basswood, 4", N.44W., 22.12 feet; Maple, 12", S.62W., 34.14 feet; Steel Sign Post, Southeast, 0.50 feet.

In 1990, Alan Harrison (R.L.S.) found monument in place and added new B.T.

- (c) In the plan view drawing below, provide reference ties to at least 4 witness monuments, or, if the location is within a municipality, to at least 2 witness monuments. (witness monuments shall be made of concrete, natural stone, iron or other equally durable material.)

- (d) Show a plan view drawing depicting the relevant monuments and reference ties which is sufficient in detail to enable accurate relocation of the corner monument if the corner monument is disturbed. Indicate north.

1. Marinette County Monument with stamped brass cap to identify the corner.
2. Hemlock, 24", N.80E., 47.94 feet (new).
3. Basswood, 4", N.44W., 22.12 feet.
4. Maple, 12", S.62W., 34.14 feet.
5. Steel Sign Post, Southeast, 0.50 feet.

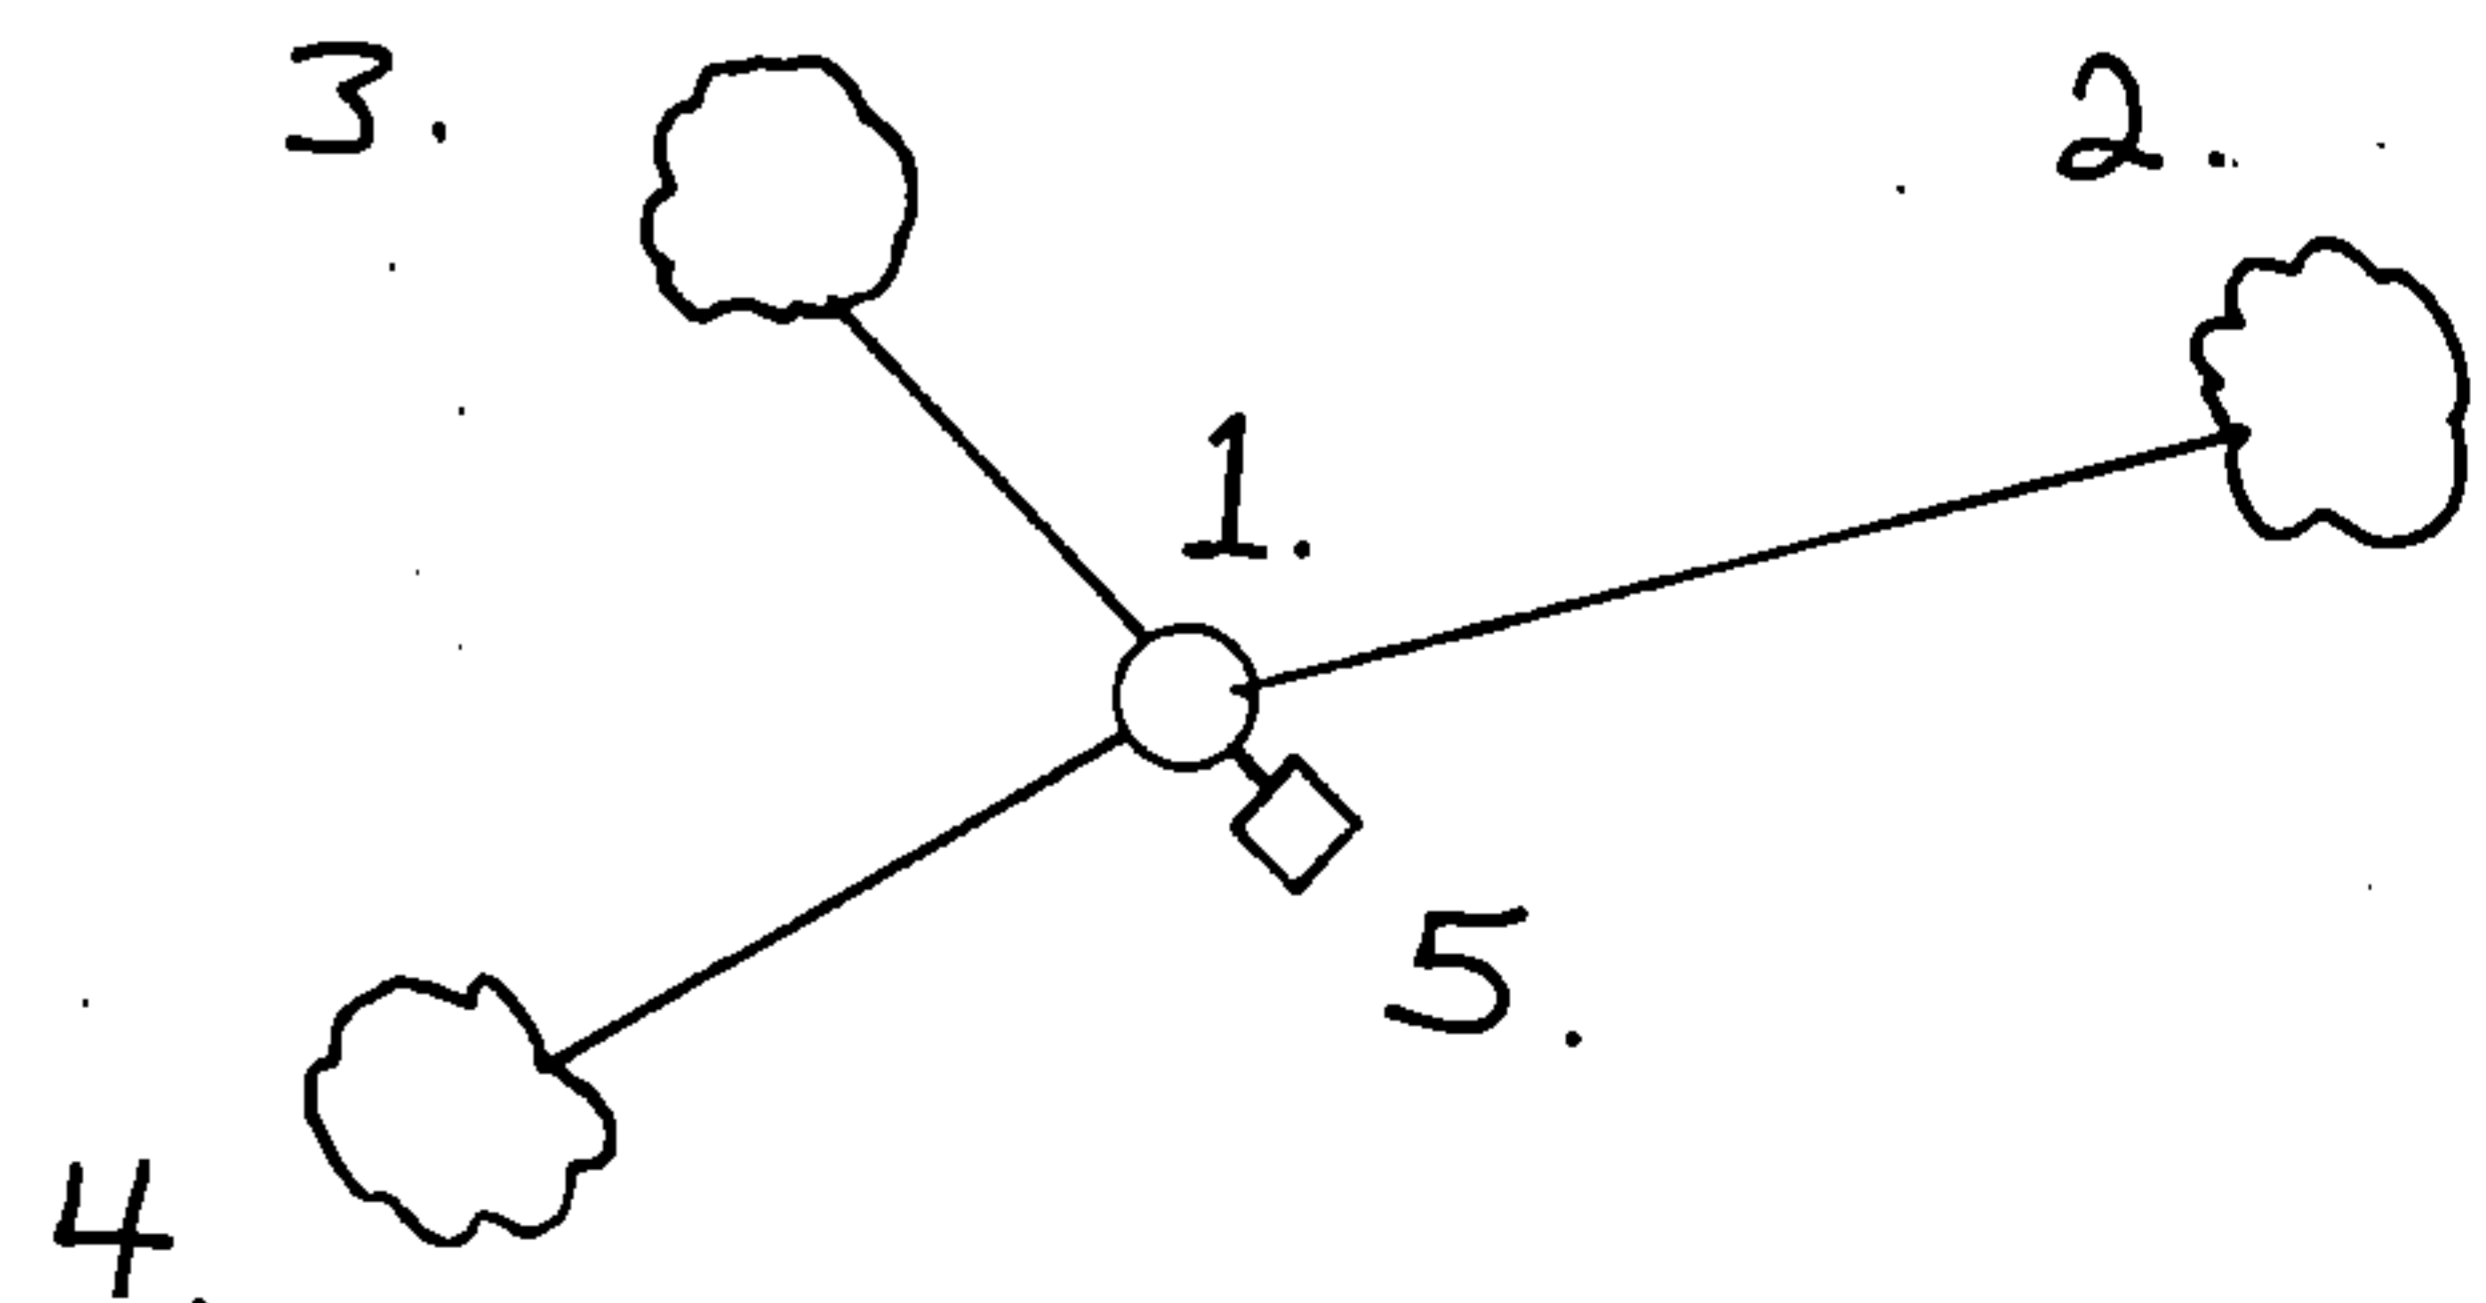

REGISTER'S OFFICE
Forest County, Wis.

Received for record this 19th day
of SEPTEMBER A.D., 19 90 at
3:15 o'clock P.M. and recorded
in Vol. CORNER RESTORATIONS
page L-25

Paul H. Schreiber
Register of Deeds

(e) Describe any material discrepancy between the location of the corner as restored or reestablished and the location of that corner as previously restored or reestablished by distance and direction. Show the discrepancy on the plan view drawing under (d), above. Show the distances between the corner as previously restored or reestablished and (1) the corner as restored or reestablished, and (2) to at least 2 of the witness monuments shown on the drawing in (d), above.

None.


(f) Was the corner restored through acceptance of (1) an obliterated evidence location, or, (2) a found perpetuated location?

(2) a found perpetuated location

(g & h) Was the corner reestablished through lost corner proportionate methods? If so, show the method, including the directions and distances to other public land survey corners used as evidence or used for proportioning in determining the corner location?

No.

(1) I, Alan D. Harrison
(type or print name) certify that the corner location shown on this record was determined by me or under my direction and control and that this U.S. Public Land Survey Monument Record is correct and complete to the best of my knowledge and belief.

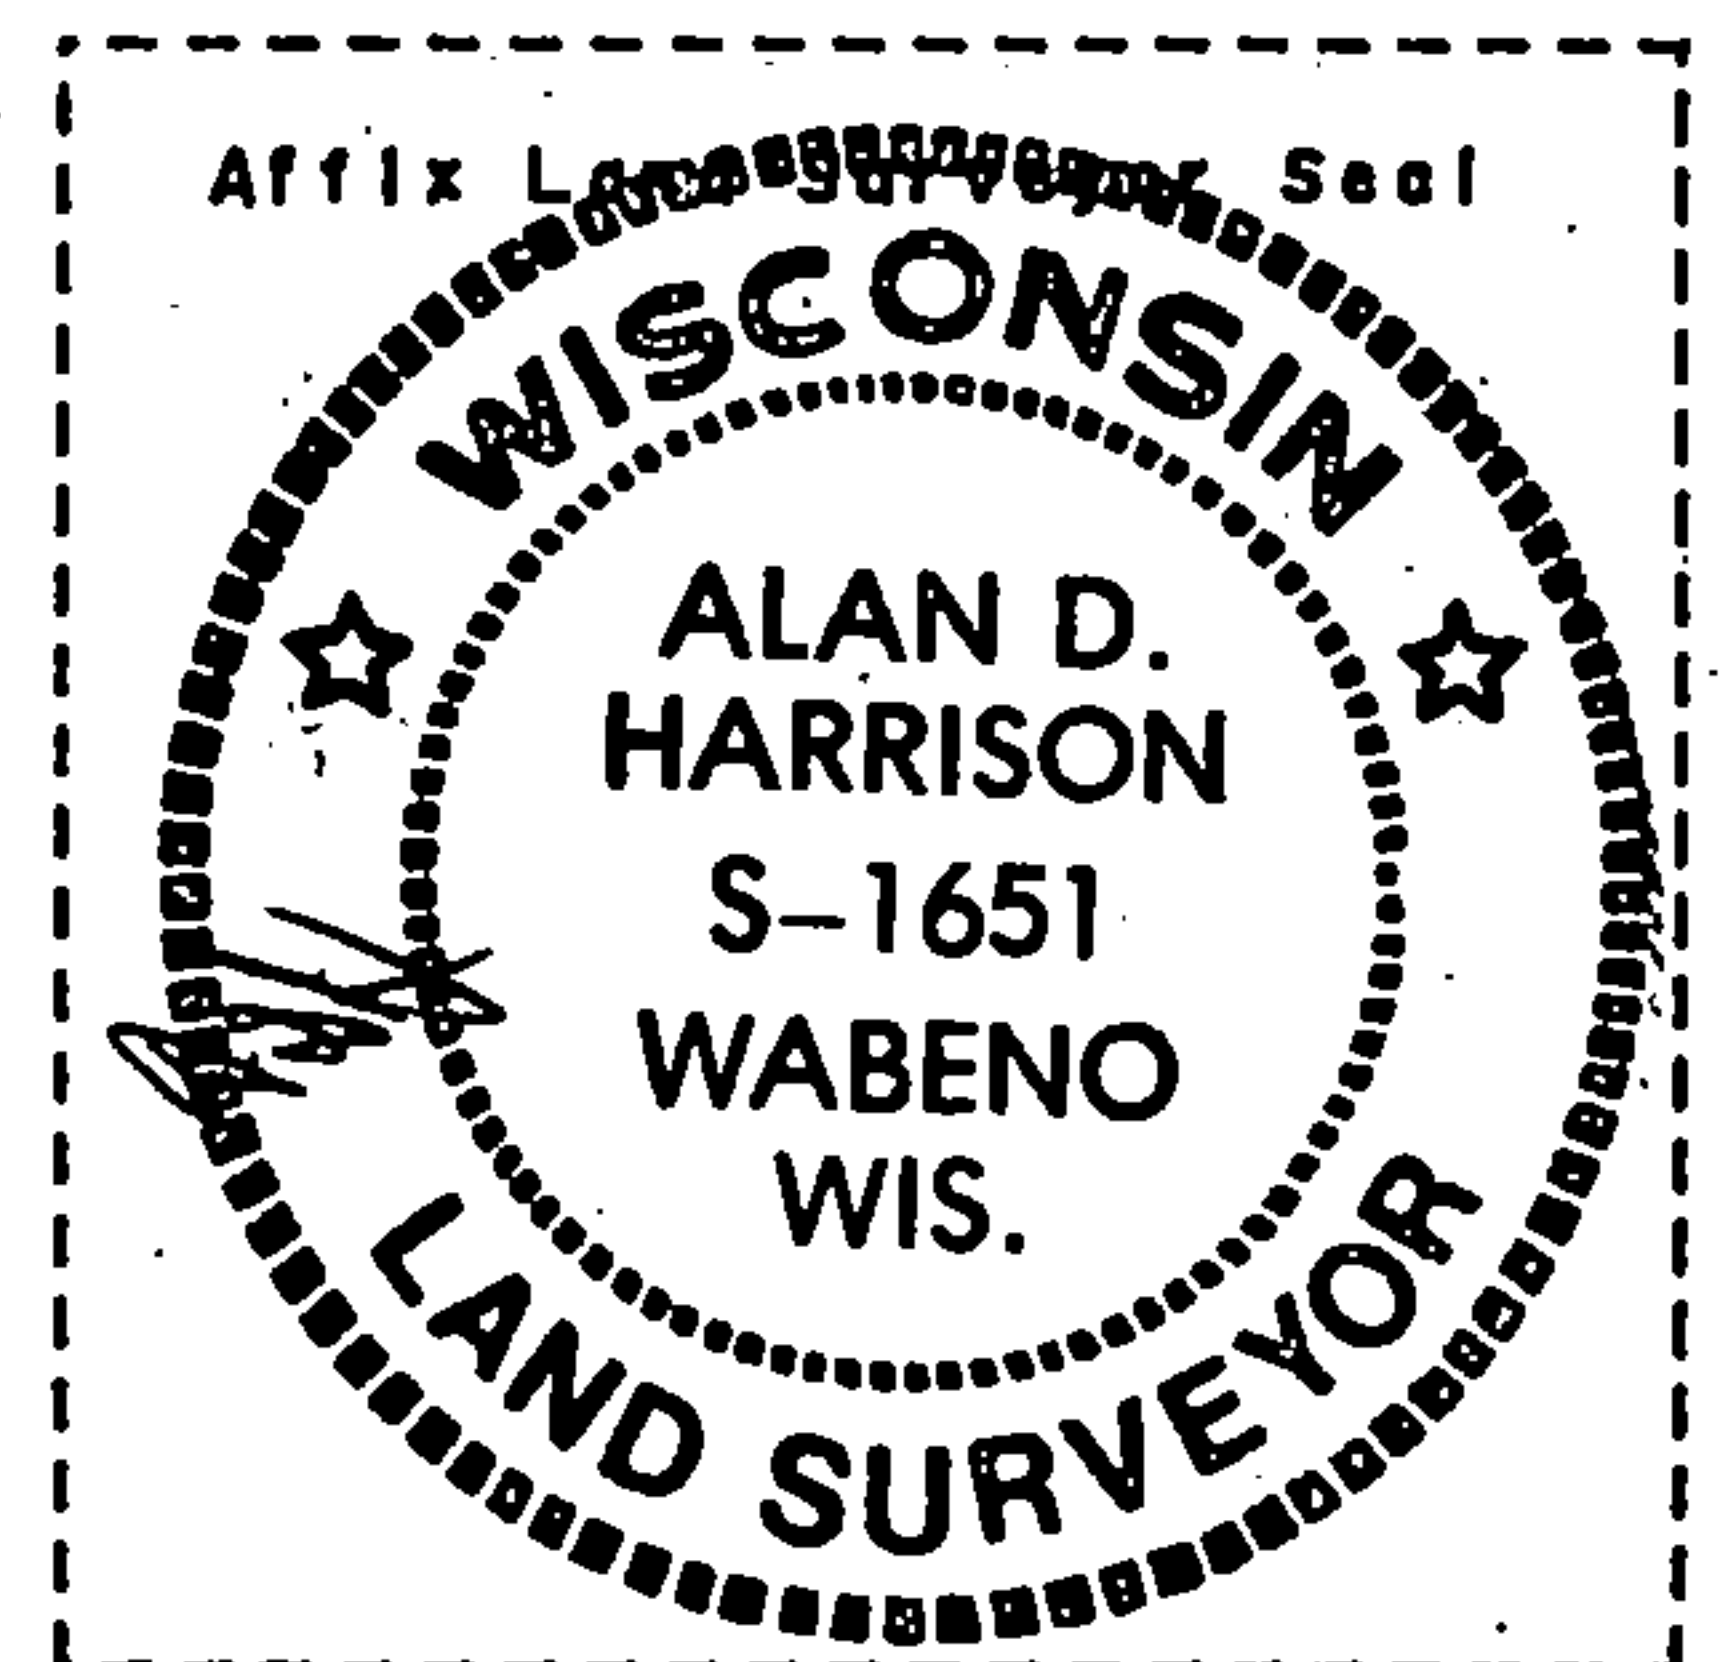

Alan D. Harrison 8/1/90
Signature Date

CERTIFICATE READY FOR FILING:

Dale S. Stage
District Ranger