


CERTIFIED LAND CORNER RESTORATION

Index No. **E 1**


State of Wisconsin }
County of Forest } ss.

I Philip T. Hansen, do hereby certify that on the 15th day of May, 1975, I found evidence of the Section Corner corner of S1, S6, S7, S12 Township 35 North, Range 11 and 12 East Fourth Principal Meridian, as described hereon; and that from this evidence I established a new monument and accessories as described hereon to perpetuate the original location of this corner.

Resident witnesses:

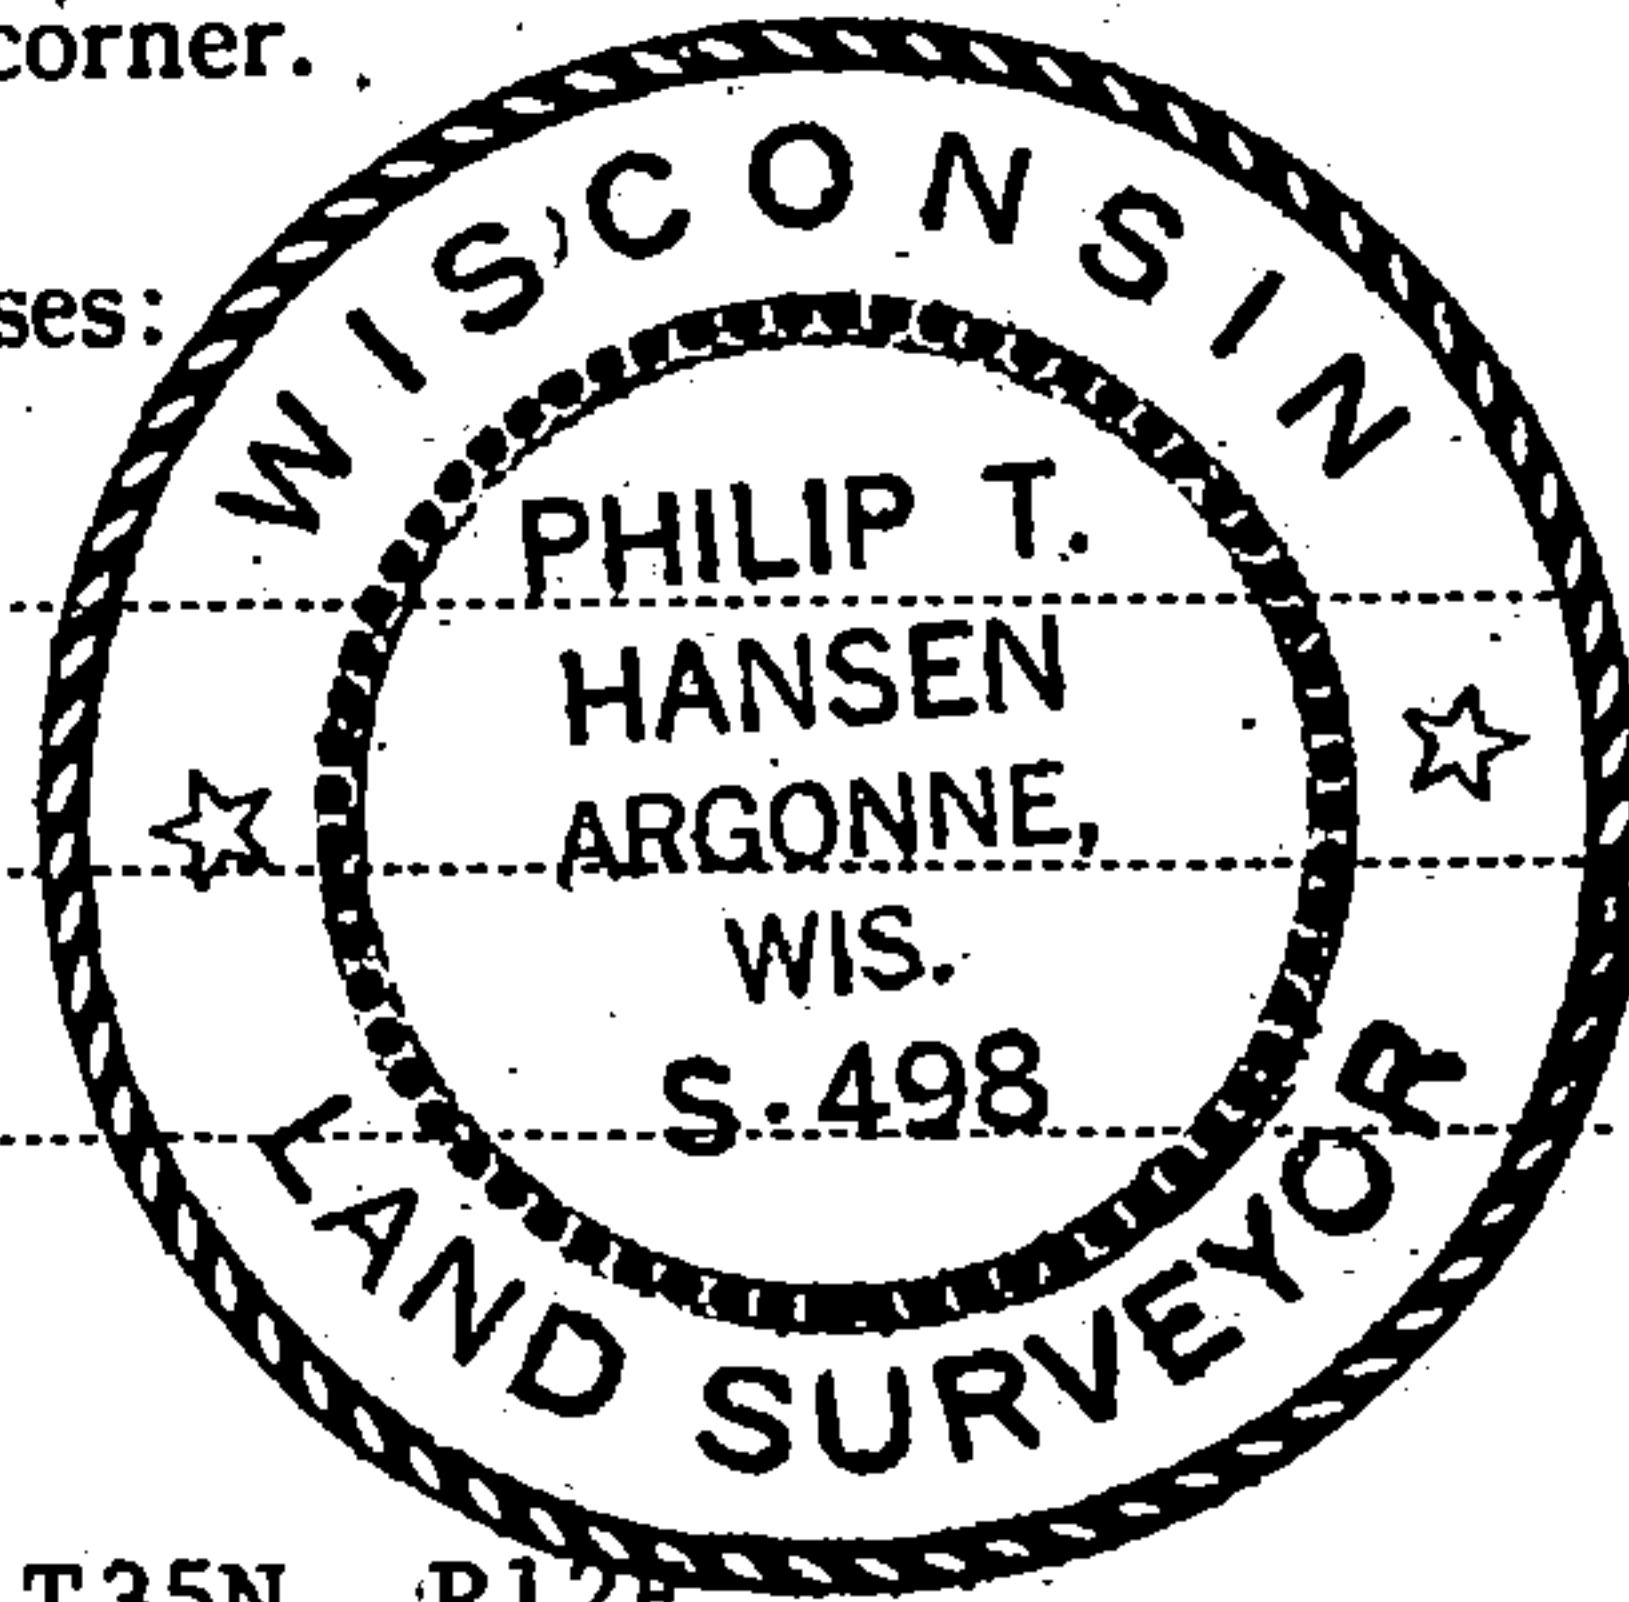

T35N, R12E

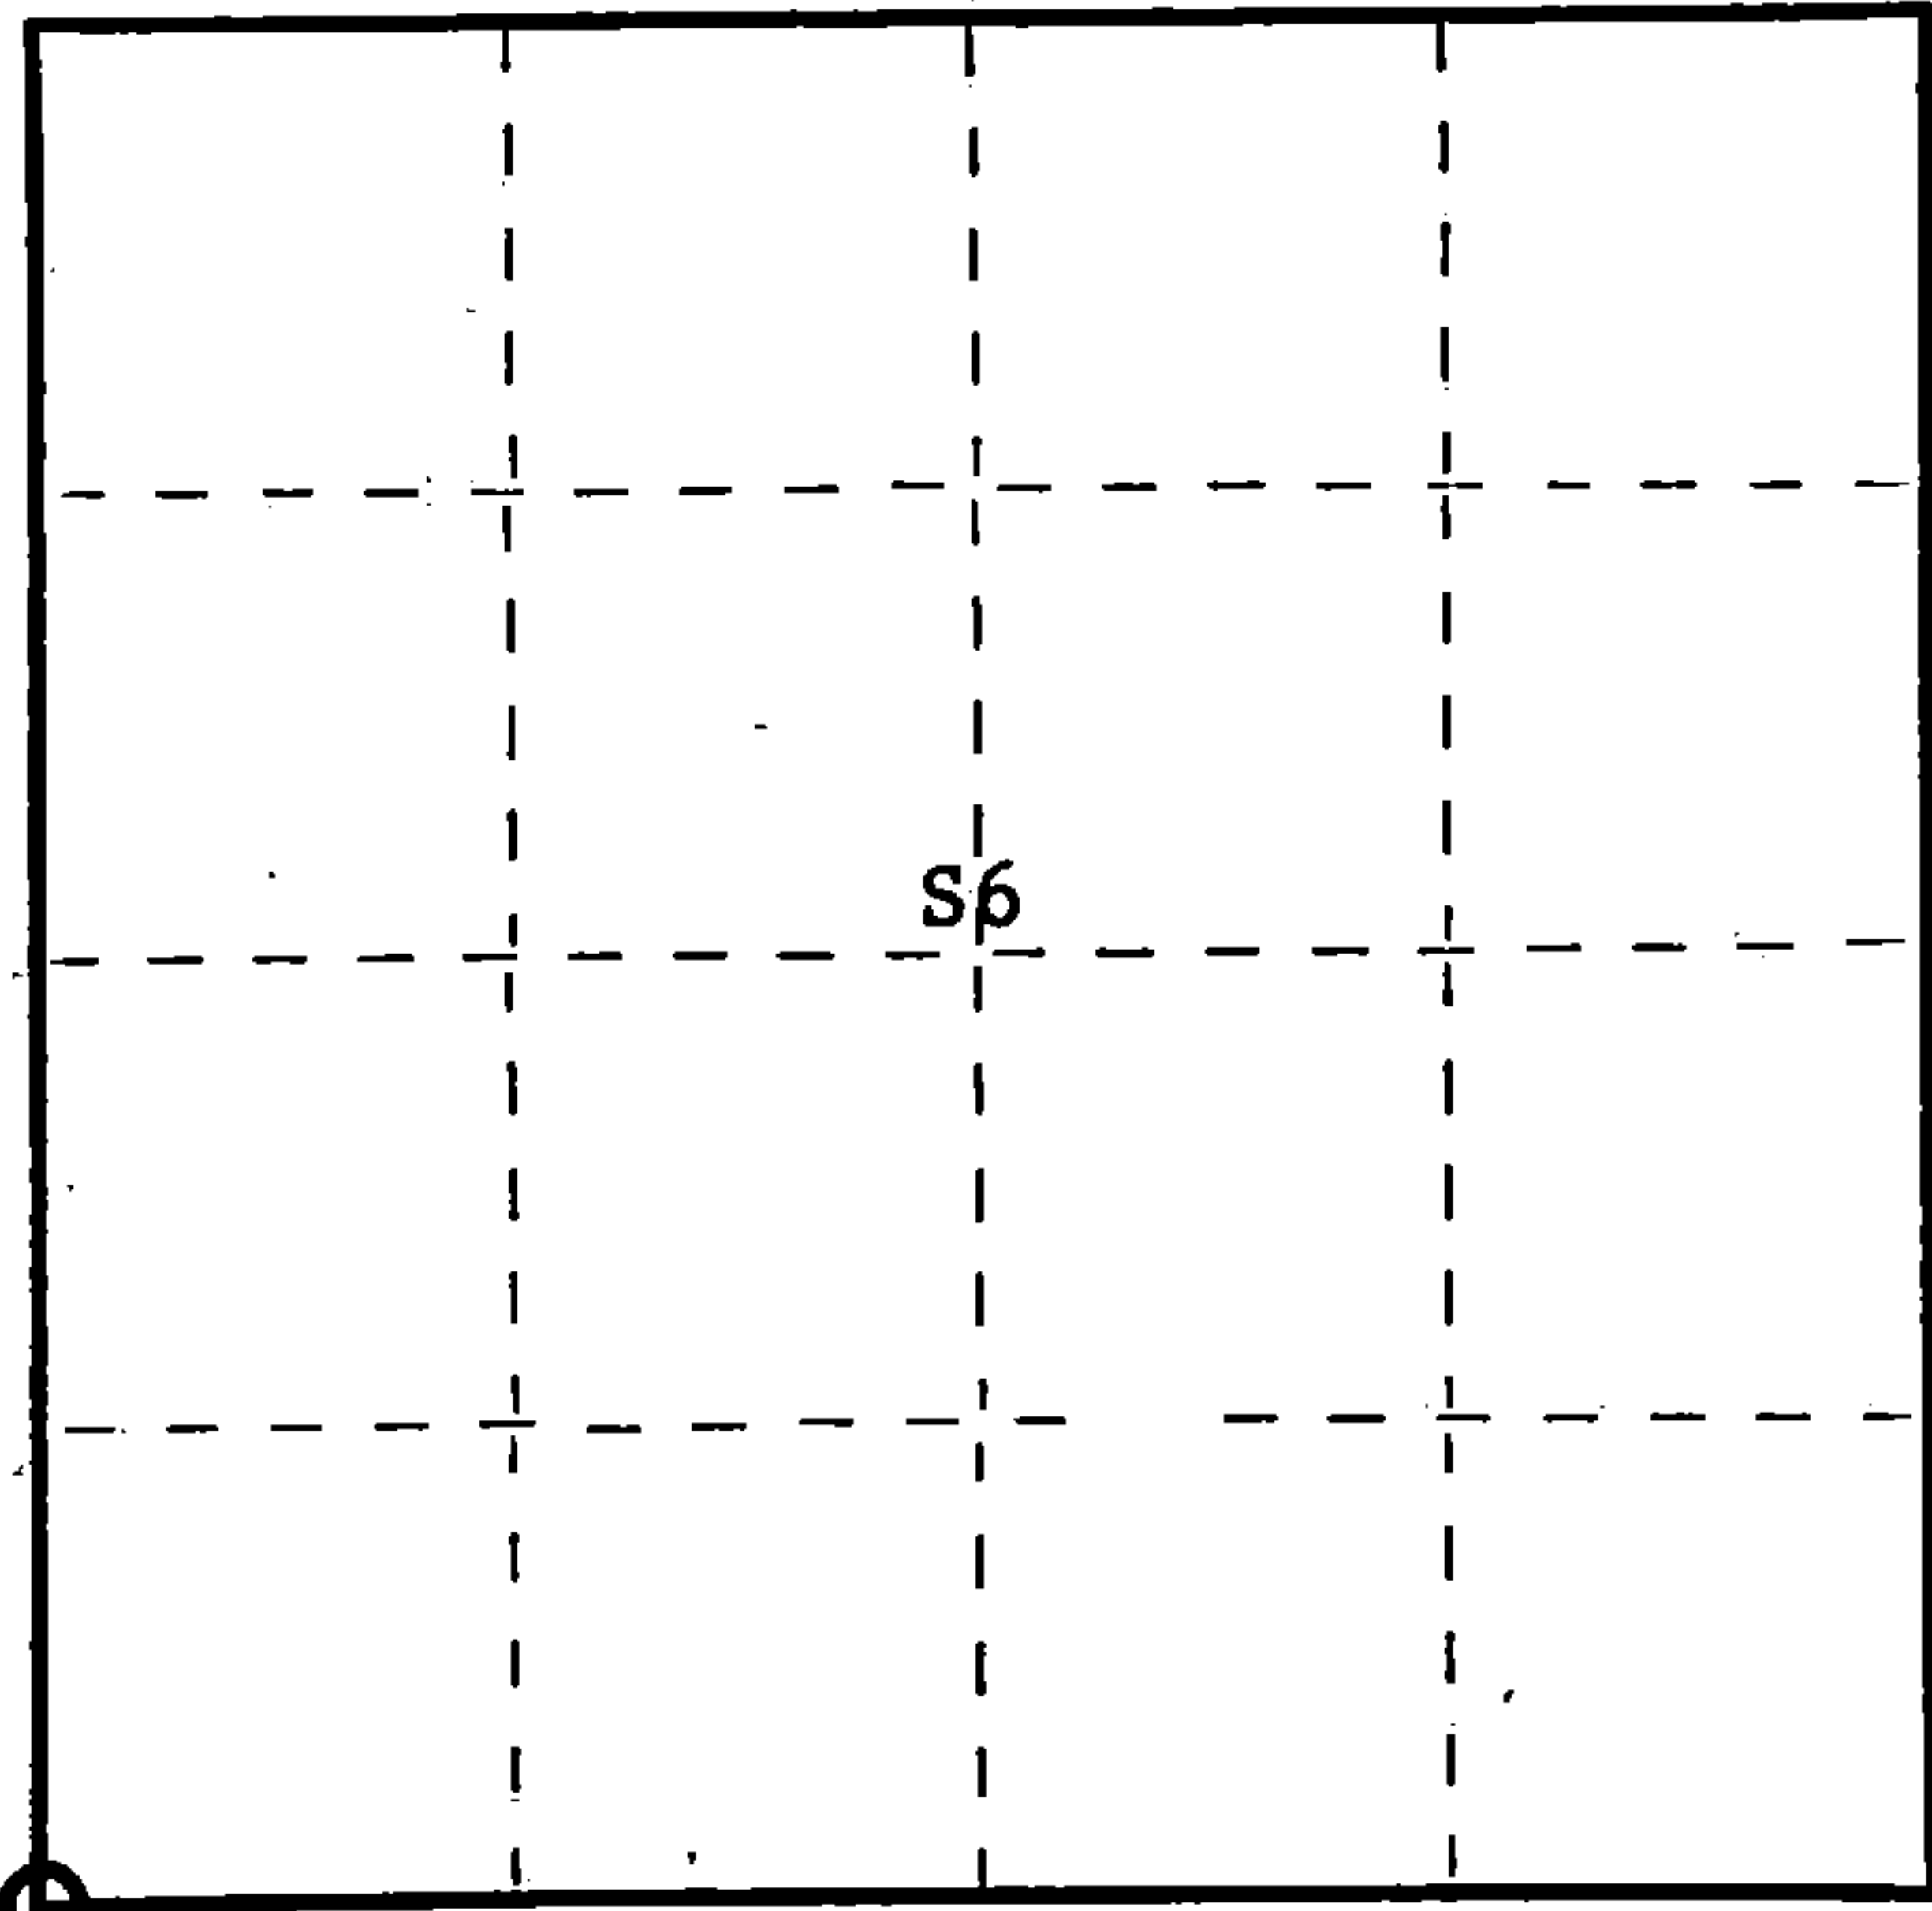

○ = Corner monument restored.

History of original corner establishment:

Original corner established by Hiram A. Fellows, Gov. Deputy Surveyor, in 1859 from which birch 10" bears S60°W 14 links, sugar 6" bears N37°W 12 links, birch 10" bears N25°E 12 links.

Corner restored by H.C. Lawrence, Registered Land Surveyor, in 1957 during his retracement survey. Set iron pin, buried in road at intersection of N-S and E-W highways.

Description of corner evidence found:

Recovered iron pin, buried in road at intersection of N-S and E-W highways.

No. BT's found.

Description of monument and accessories I established to perpetuate the original location of this corner.

Set 2 1/2" iron pipe with brass cap stamped as W.C.

The witness corner bears North, 35 links.

NBT - Line pole N10°E 34.5 links #3511 - 1R1
Sign post (Pitts) S40°E 57 links
Bearings and distance taken to true corner.

S498
T35N
R11E 1/6 R12E
12/7
CPI-1975
W.C. 35 links

DOCUMENT NUMBER **107641**

Dated at Rhinelander, Wis., this 3rd day of June, 1975

Signature *Philip T. Hansen* Title Registered Land Surveyor Registration No. S-498
(County Surveyor, Registered Land Surveyor, or other duly authorized official)

Office of Register of Deeds, County of Forest, I hereby certify that the within instrument was filed in this office for record on the 20th day of August, 1975 at 4:00 o'clock P. M.

Eugene Staszny
(Register of Deeds)
By _____ Deputy

FORM 985 H. C. MILLER CO., MILWAUKEE

43511010000