

CERTIFIED LAND CORNER RESTORATION

Index No. X-1

State of Wisconsin }  
County of Forest } ss.


I Philip T. Hansen, do hereby certify that on the 29th day of November, 1976, I found evidence of the Quarter corner of Section 31 - 36 Township 35, North, Range 11 & 12 East, Fourth Principal Meridian, as described hereon; and that from this evidence I established a new monument and accessories as described hereon to perpetuate the original location of this corner.

Resident witnesses:

Glen Barker

Jim Claflin

Herb Wagoner

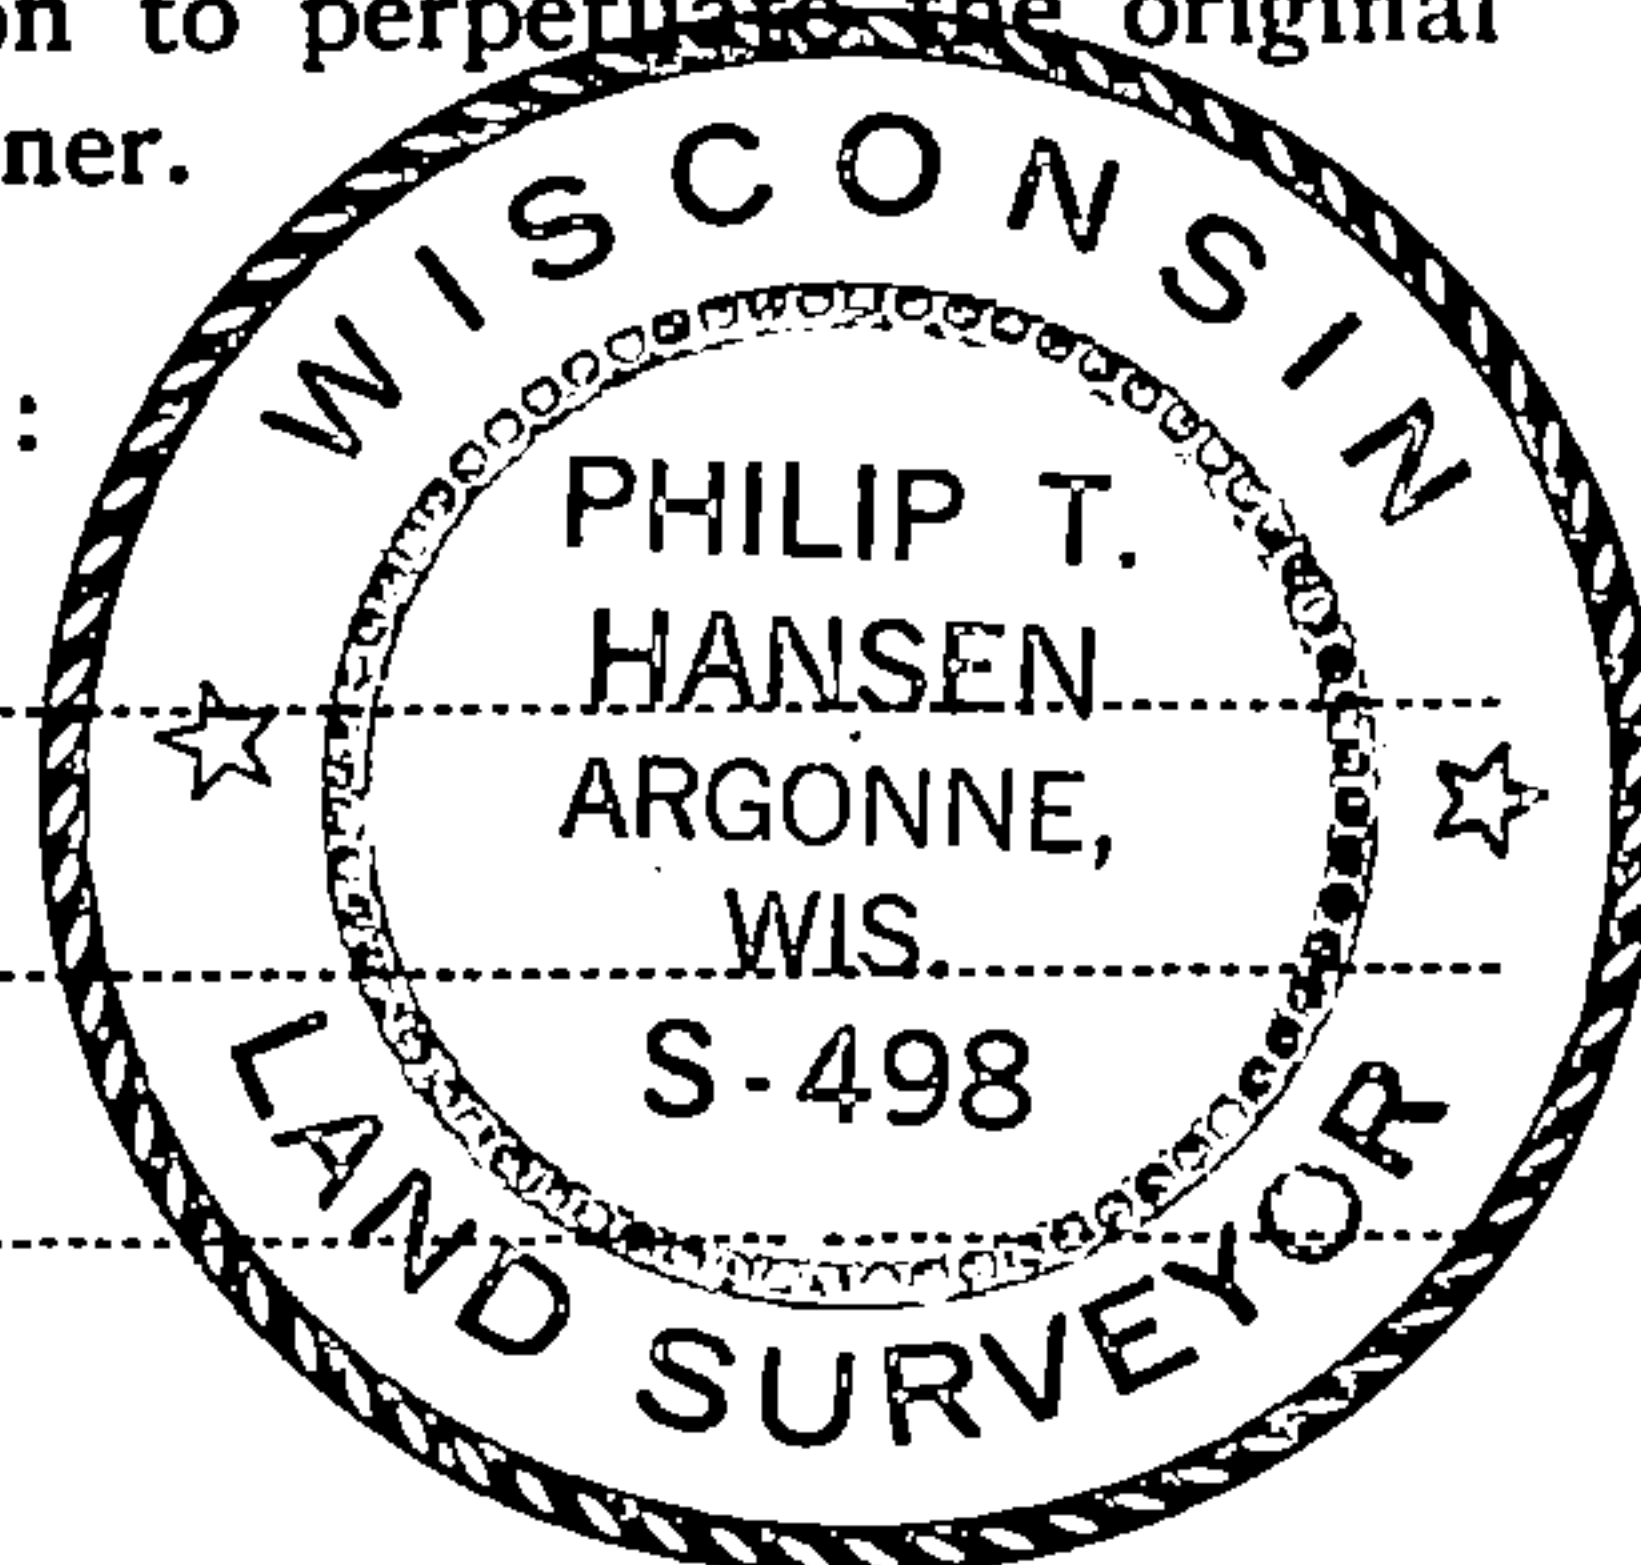

History of original corner establishment:

Original Corner established by Alfred Millard, Gov. Deputy Surveyor, in 1857 from which White Birch 8" bears N 51° E 19 links and White Birch 10" bears N 8° W 27 links.

Corner restored by H.C. Lawrence, Registered Land Surveyor, in 1959. Ran a random line S 3° 00' E a distance of 80.14 chains to close out 47 links east of township corner. Set a 5" cedar post at 40.07 chains, 23 1/2 links west, old cedar BT S 69° E 31 links, old White Birch BT S 69° W 27 1/2 links. Marked NBTs Cedar 12" N 73° W 29 1/2 links, Cedar 15" N 33° E 33 links.

Description of corner evidence found:


Recovered 5" cedar post, squared and scribed 1/4S S31, 1/4S R12E S36 R12E. Post was in fair condition. There is an old cedar post which bears west 9.5 links from Lawrence's. Recovered OBT - Cedar 10" S 69° E 31 links, scribing rotted out. White Birch 8" S 69° W 27.5 links, now a 14' stub. Cedar 12" N 73° W 29.5 links, scribed 1/4S NBT. Cedar 15" (16") N 33° E 33 links, scribed 1/4S 31, NBT.

Description of monument and accessories I established to perpetuate the original location of this corner.

Replaced cedar post with 2 1/2" Berntsen A-1 Federal Monument, aluminum with magnet installed in cap and base. Cap stamped: Monument projects 12" above ground. NBT - Cedar 6" S 15° W 24 links, scribed 1/4 BT.

R T35N R  
11 S36 | S31 12  
E | E  
S498-1976

FORM 985 M. C. MILLER CO., MILWAUKEE

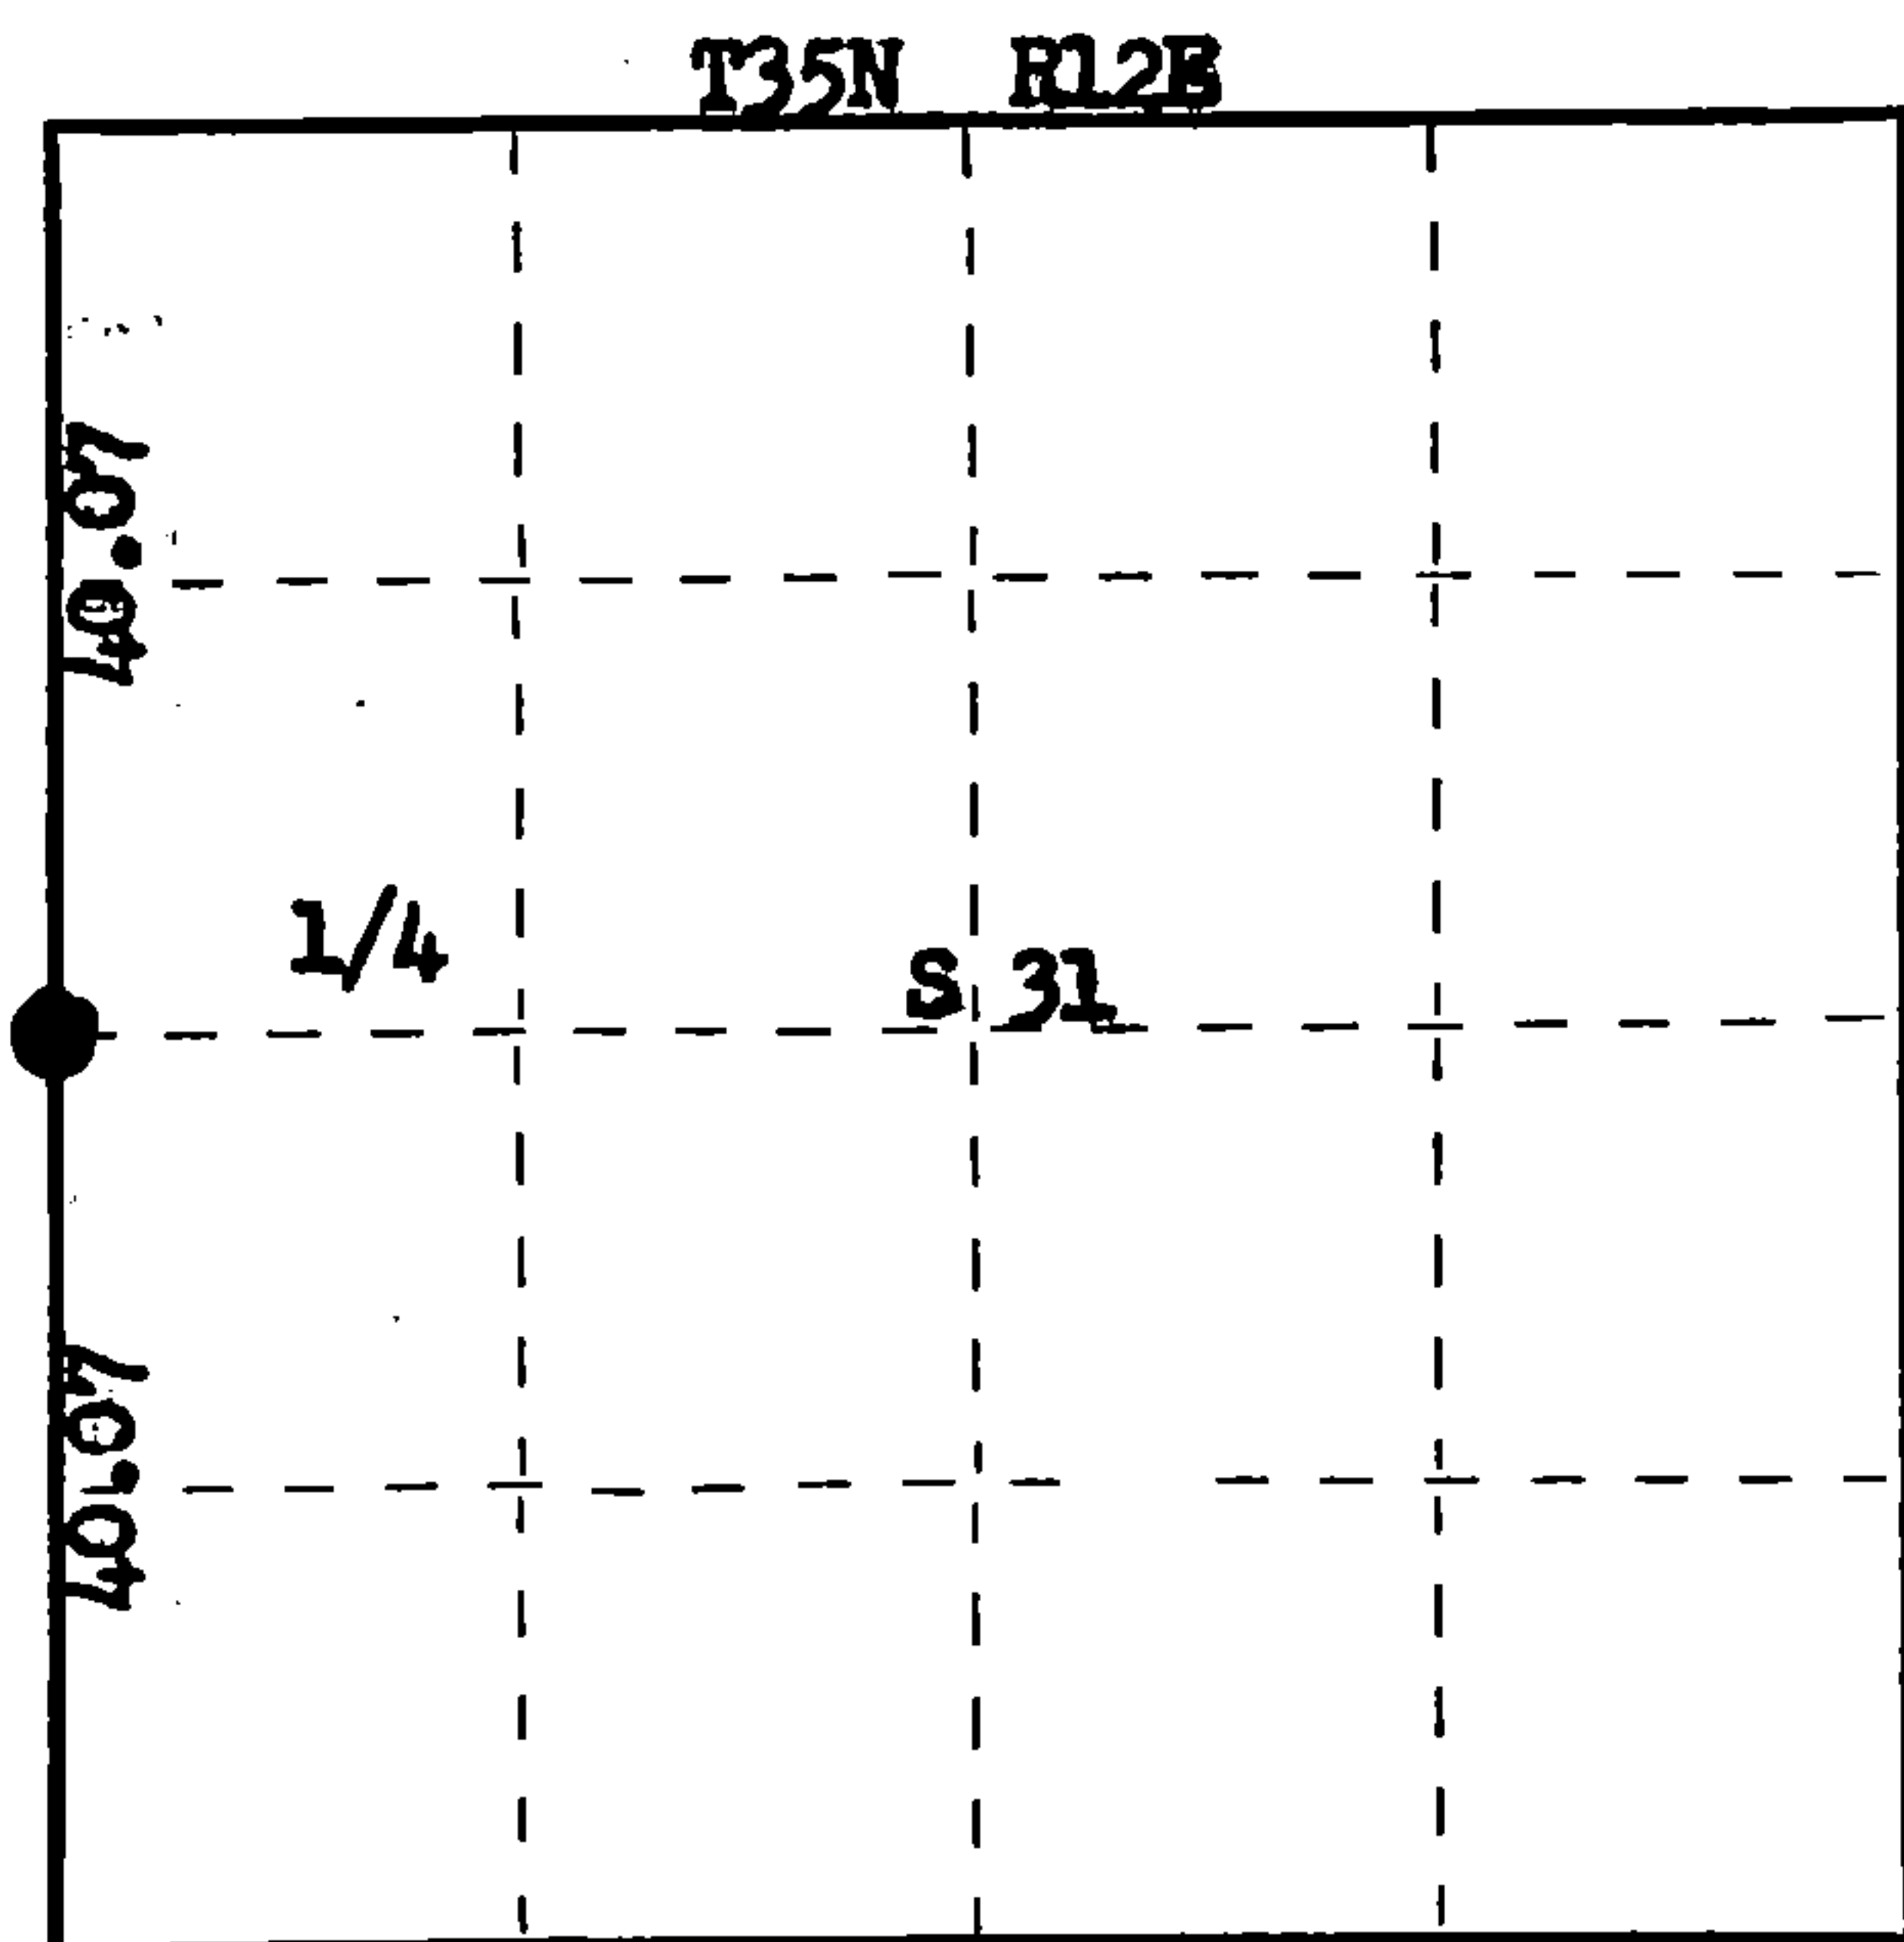

○ = Corner monument restored.

Dated at Rhineland, Wis., this 13th day of December, 19 76

Signature Philip T. Hansen Title Registered Land Surveyor Registration No. S-498  
(County Surveyor, Registered Land Surveyor, or other duly authorized official)

Office of Register of Deeds, County of Forest, I hereby certify that the within instrument was filed in this office for record on the 21st day of January, 19 77 at 4:00 o'clock P. M.

Eugene Stutzman  
(Register of Deeds)  
By \_\_\_\_\_ Deputy

DOCUMENT NUMBER **110879**

43511302000