

CERTIFIED LAND CORNER RESTORATION

Index No. E-23


State of Wisconsin }
County of Forest } ss.

I Philip T. Hansen, do hereby certify that on the 14th day of May, 1979, I ~~found~~ ^{established} ~~corner of~~ ^{corner of} the Quarter ~~Sections 1 and 12~~ ^{Sections 1 and 12} Township 35, North, Range 12 East, Fourth Principal Meridian, as described hereon; and that from this evidence I established a new monument and accessories as described hereon to perpetuate the original location of this corner.


Resident witnesses:

Glen Barker

Jim Claflin

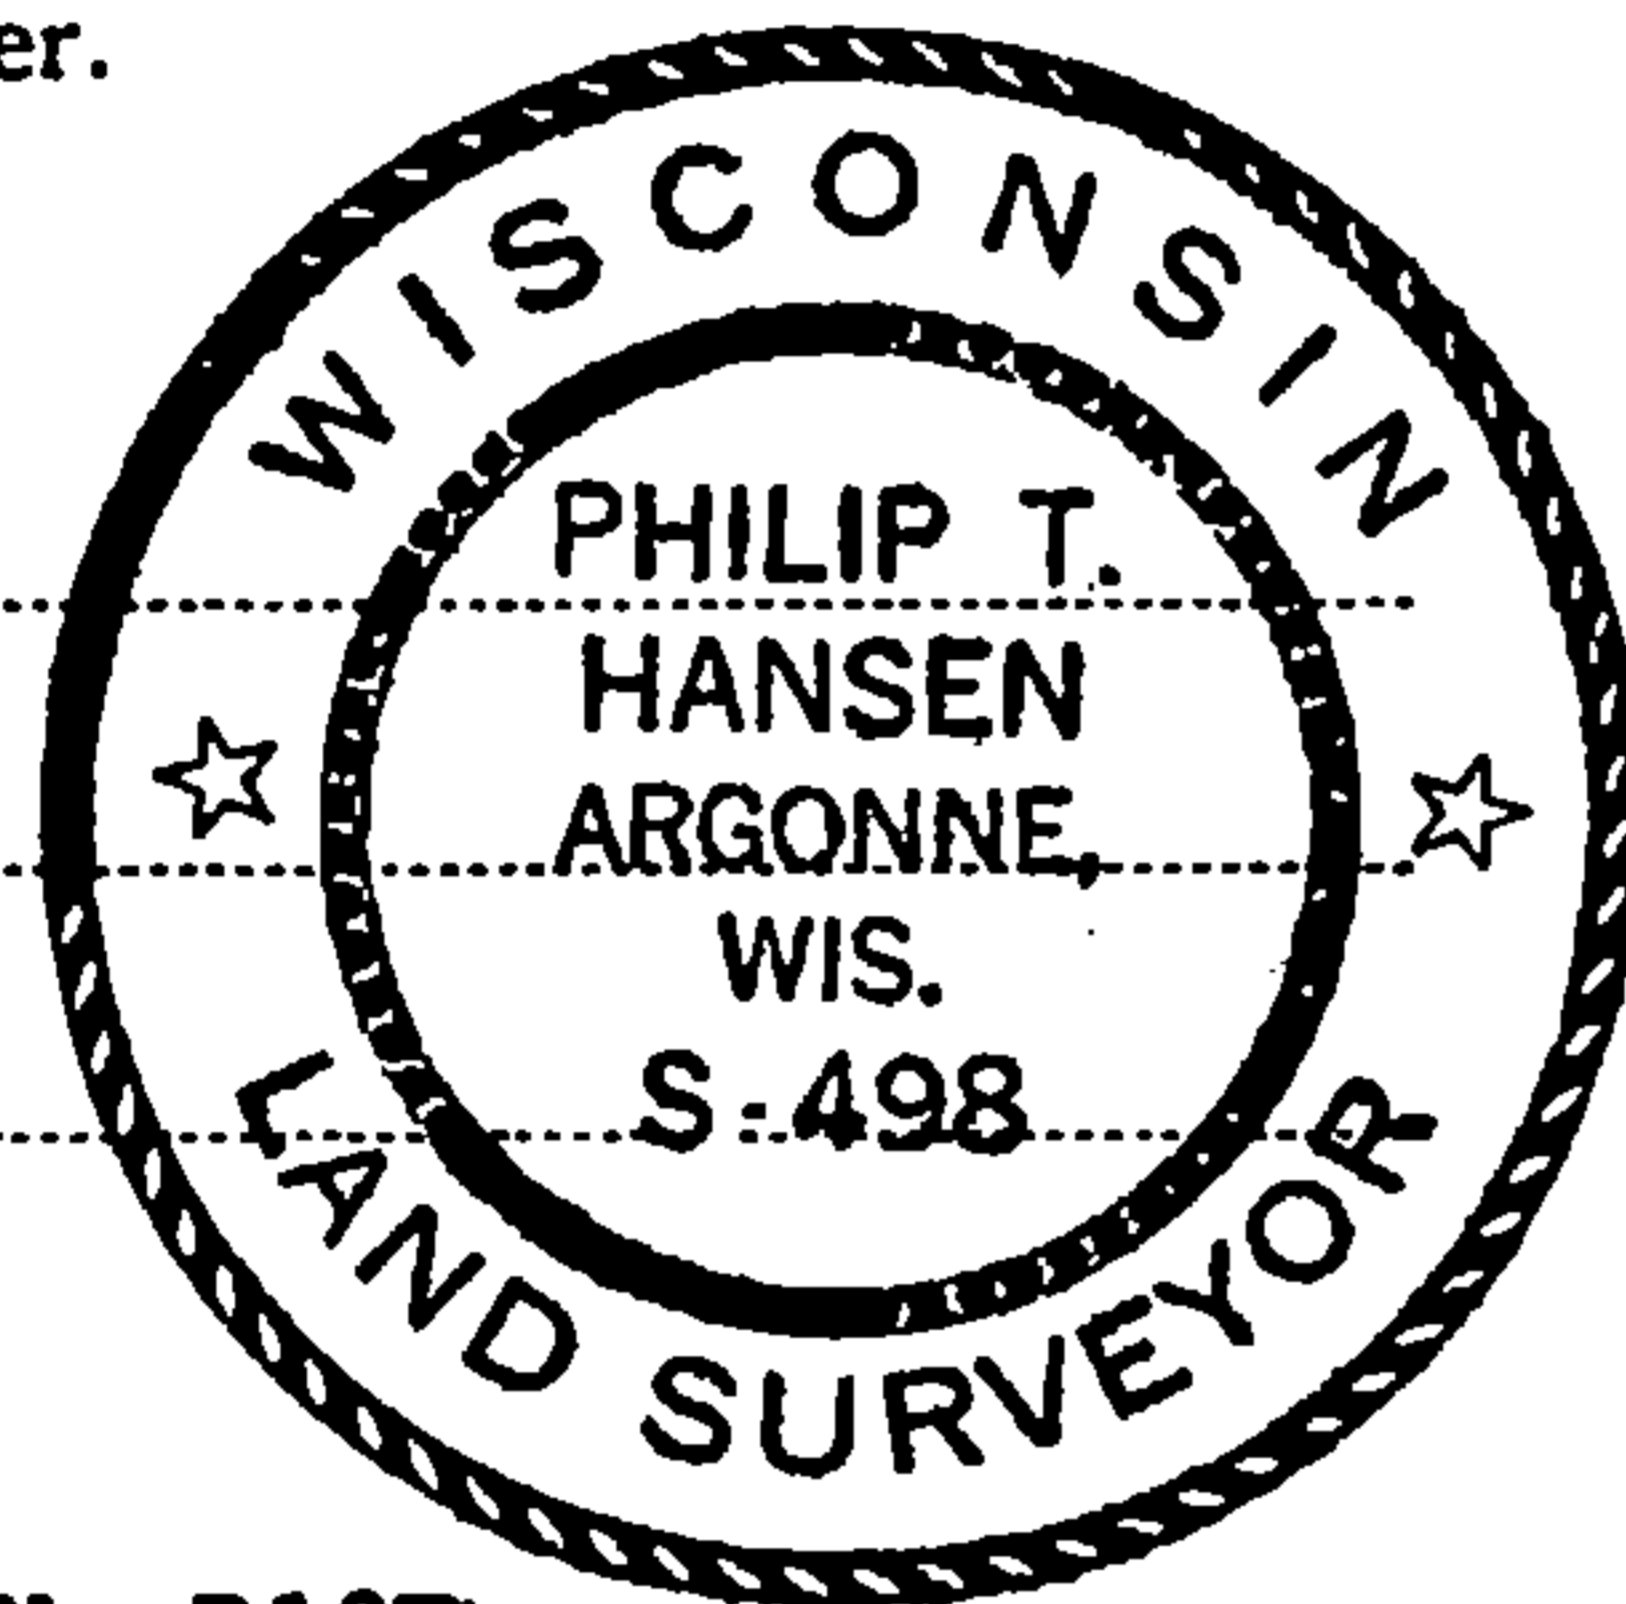

FORM 985

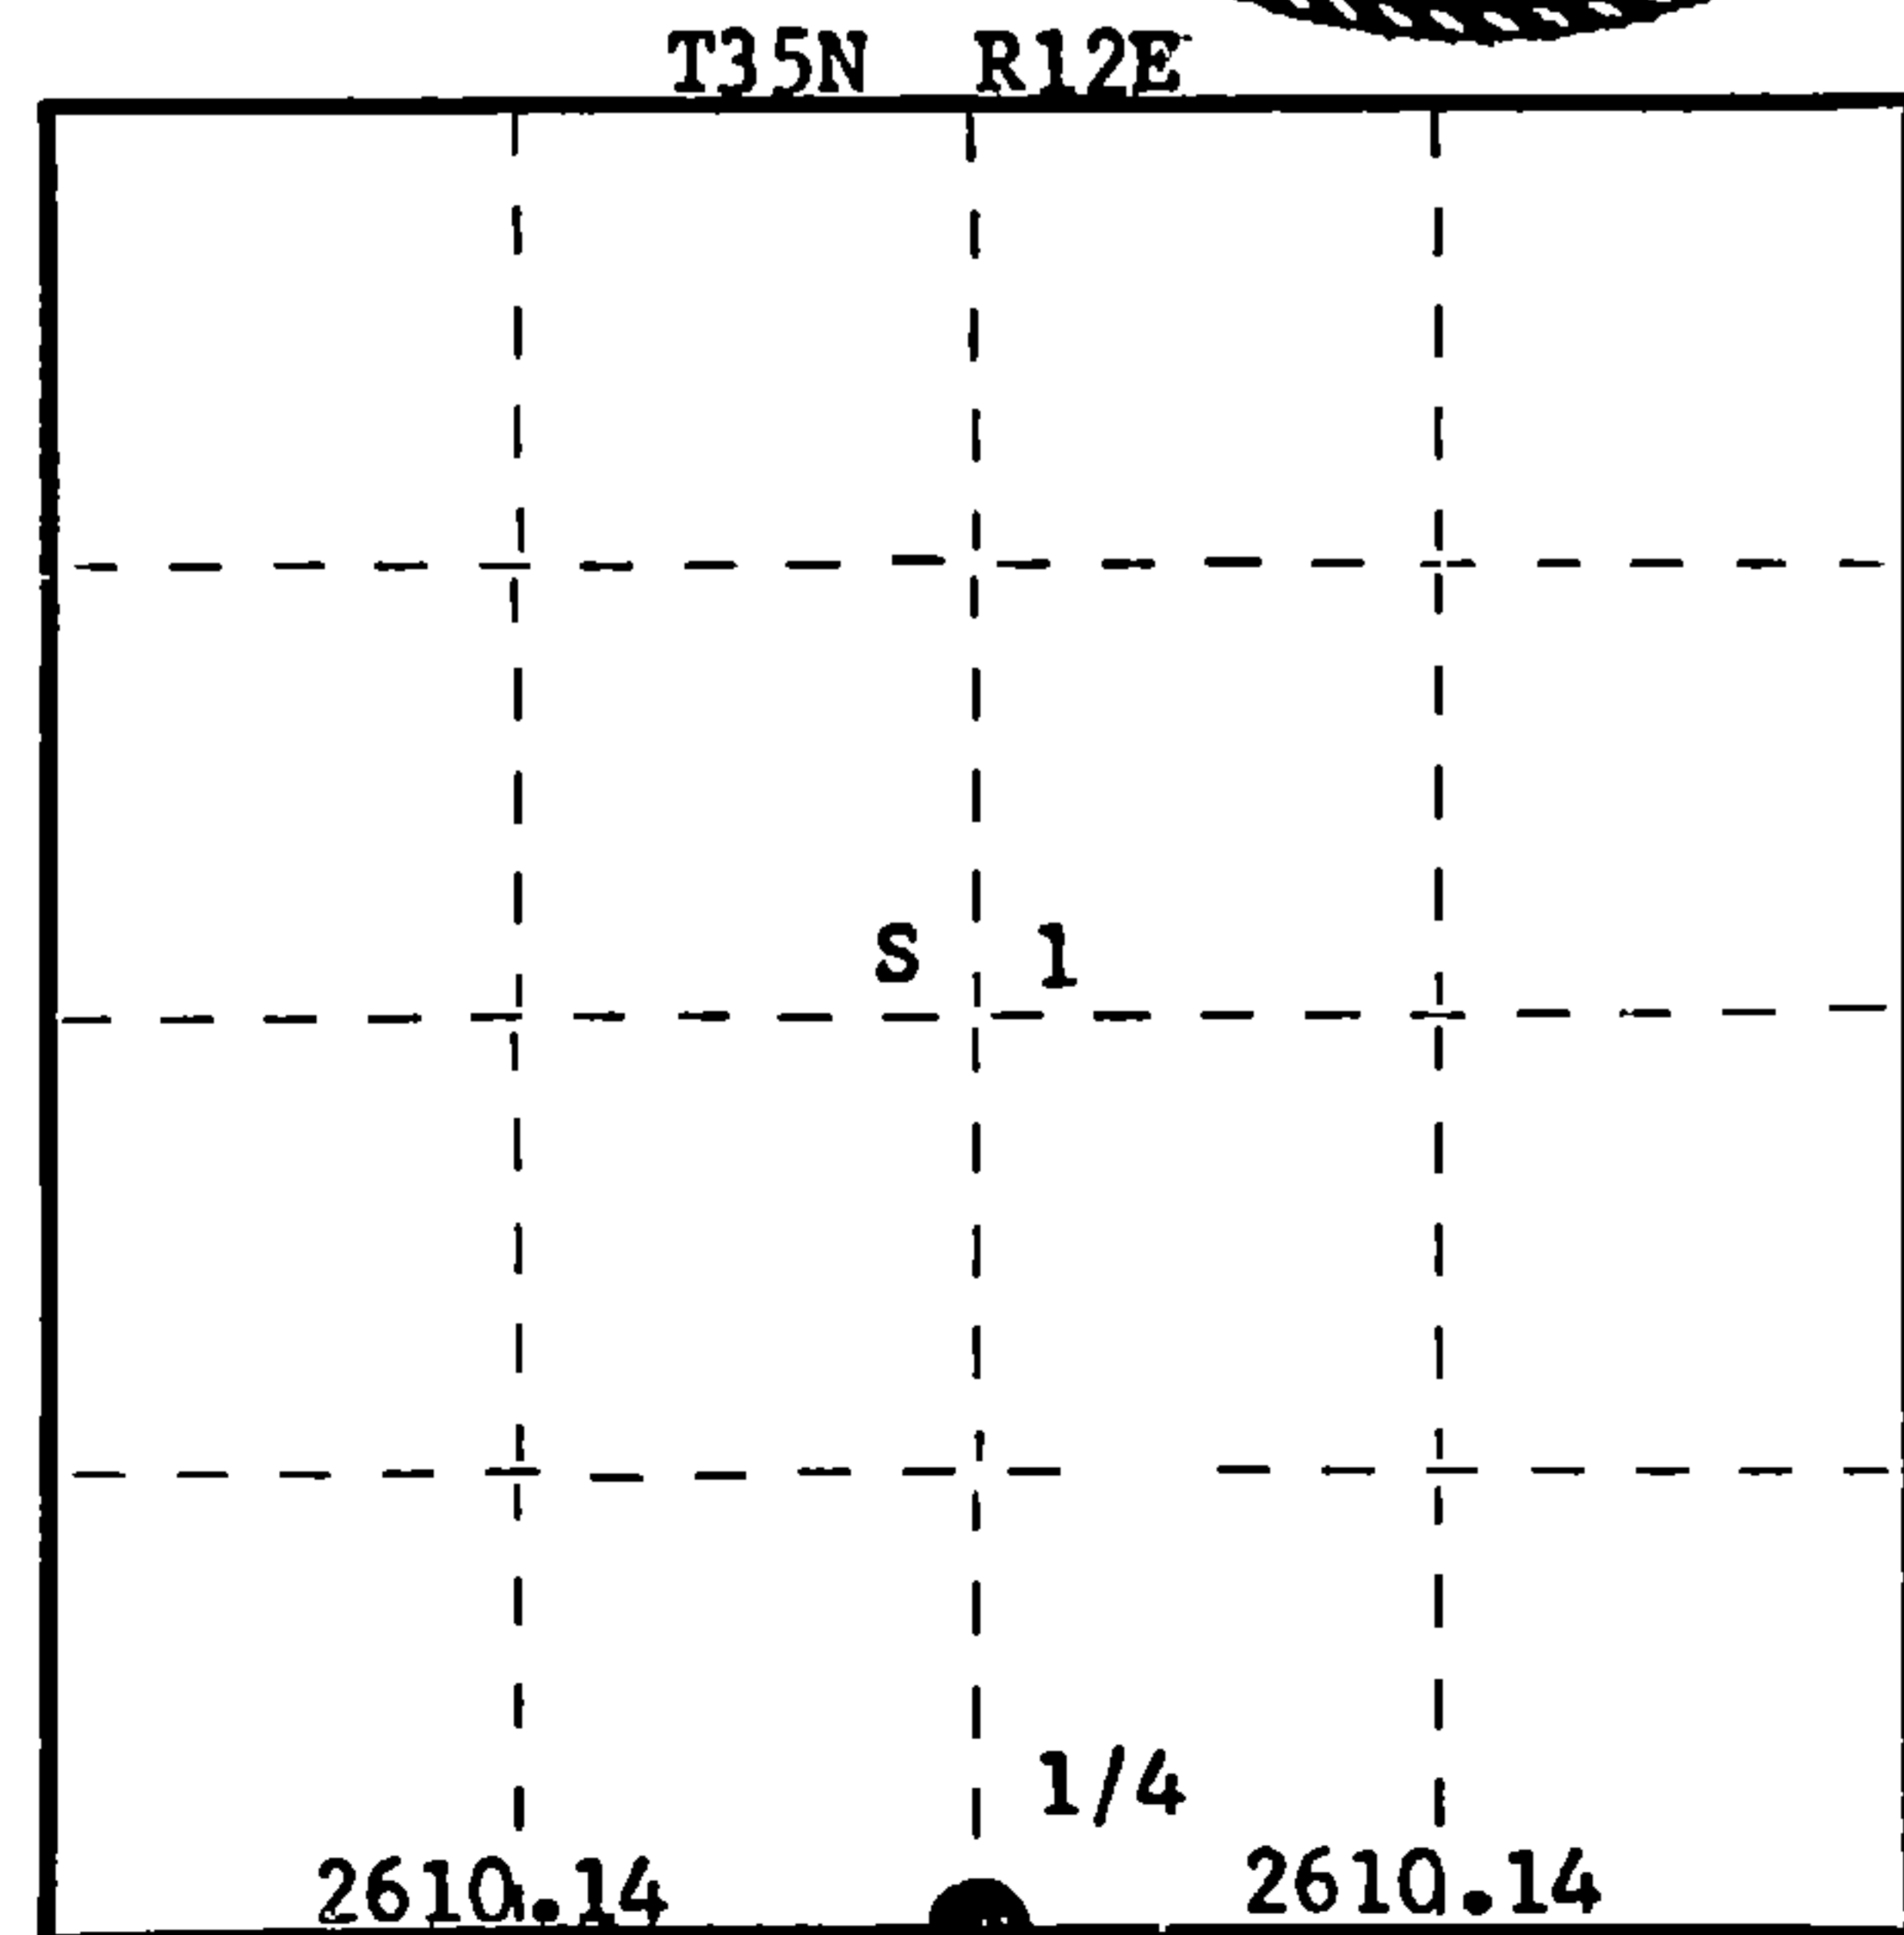

○ = Corner monument restored.

History of original corner establishment:

Original corner established by Wm. E. Dougherty, Deputy Surveyor, in 1859, from which tamarack 8" bears N 13° E 13 links and tamarack 8" bears S 33° W 11 links.

No records of any subsequent survey.

Description of corner evidence found:

No evidence of any corner recovered except an 18" tamarack BT. No records on this BT. Corner established by traverse and computation. Ran a traverse from section corner 1, 2, 11 and 12 to section corner 1, 12, 35 and 2 and 6, 7, 35, 13. Computed bearing S 88° 16' 06" E, 5220.28 feet.

Set 1/4 corner at 2610.14 feet intermediate.

Description of monument and accessories I established to perpetuate the original location of this corner.

Drove a surveyor's spike in south lane at Lemke Road for true corner.

Set a 2-1/2" iron pipe with brass cap, 45 feet north for witness corner.

Monument projects 12" above ground - cap stamped:

Old BT, tamarack 12" S26° E 24.56 feet

NBT's - Tamarack 5" N33° W 54.59' scribed 1/4 BT.

Tamarack 8" S58° W 45.63' scribed 1/4 BT.

T35N R12E
1/4 S + 1/12 W.C.
S 45 ft.
S498 - 1979

43512010020

Dated at Rhineland, Wis., this 29th day of May, 1979.

Signature Philip T. Hansen Title Registered Land Surveyor Registration No. S-498
(County Surveyor, Registered Land Surveyor, or other duly authorized official)

Office of Register of Deeds, County of Forest, I hereby certify that the within instrument was filed in this office for record on the 13th day of November, 1979 at 8:30 o'clock A. M.

Eugene Staszynski
(Register of Deeds)

By _____ Deputy

DOCUMENT NO. **117075**