

CERTIFIED LAND CORNER RESTORATION

Index No. **E-19**

State of Wisconsin }  
County of Forest } ss.

History of original corner establishment: Original corner established by J.L. Nowlin, Deputy Surveyor, in 1860, from which Sugar 12" N15°W 8 lks, Lind 15" S36°E 12".

I Philip T. Hansen, do hereby certify that on the 10th day of May, 1976, I found evidence of the Quarter corner of 2 and 11 Township 35, North, Range 12 East, Fourth Principal Meridian, as described hereon; and that from this evidence I established a new monument and accessories as described hereon to perpetuate the original location of this corner.

Description of corner evidence found: Recovered a very old 3" squared cedar post, scribed 1/4 S, projecting 18" above ground, origin unknown. Also recovered a 1 1/2" iron pipe 30" long beside it. Adjoining land owners have accepted this as corner many years.


Unable to locate any visible evidence of bearing trees.

Resident witnesses:

Glen Barker

Jim Claflin

Herb Wagoner

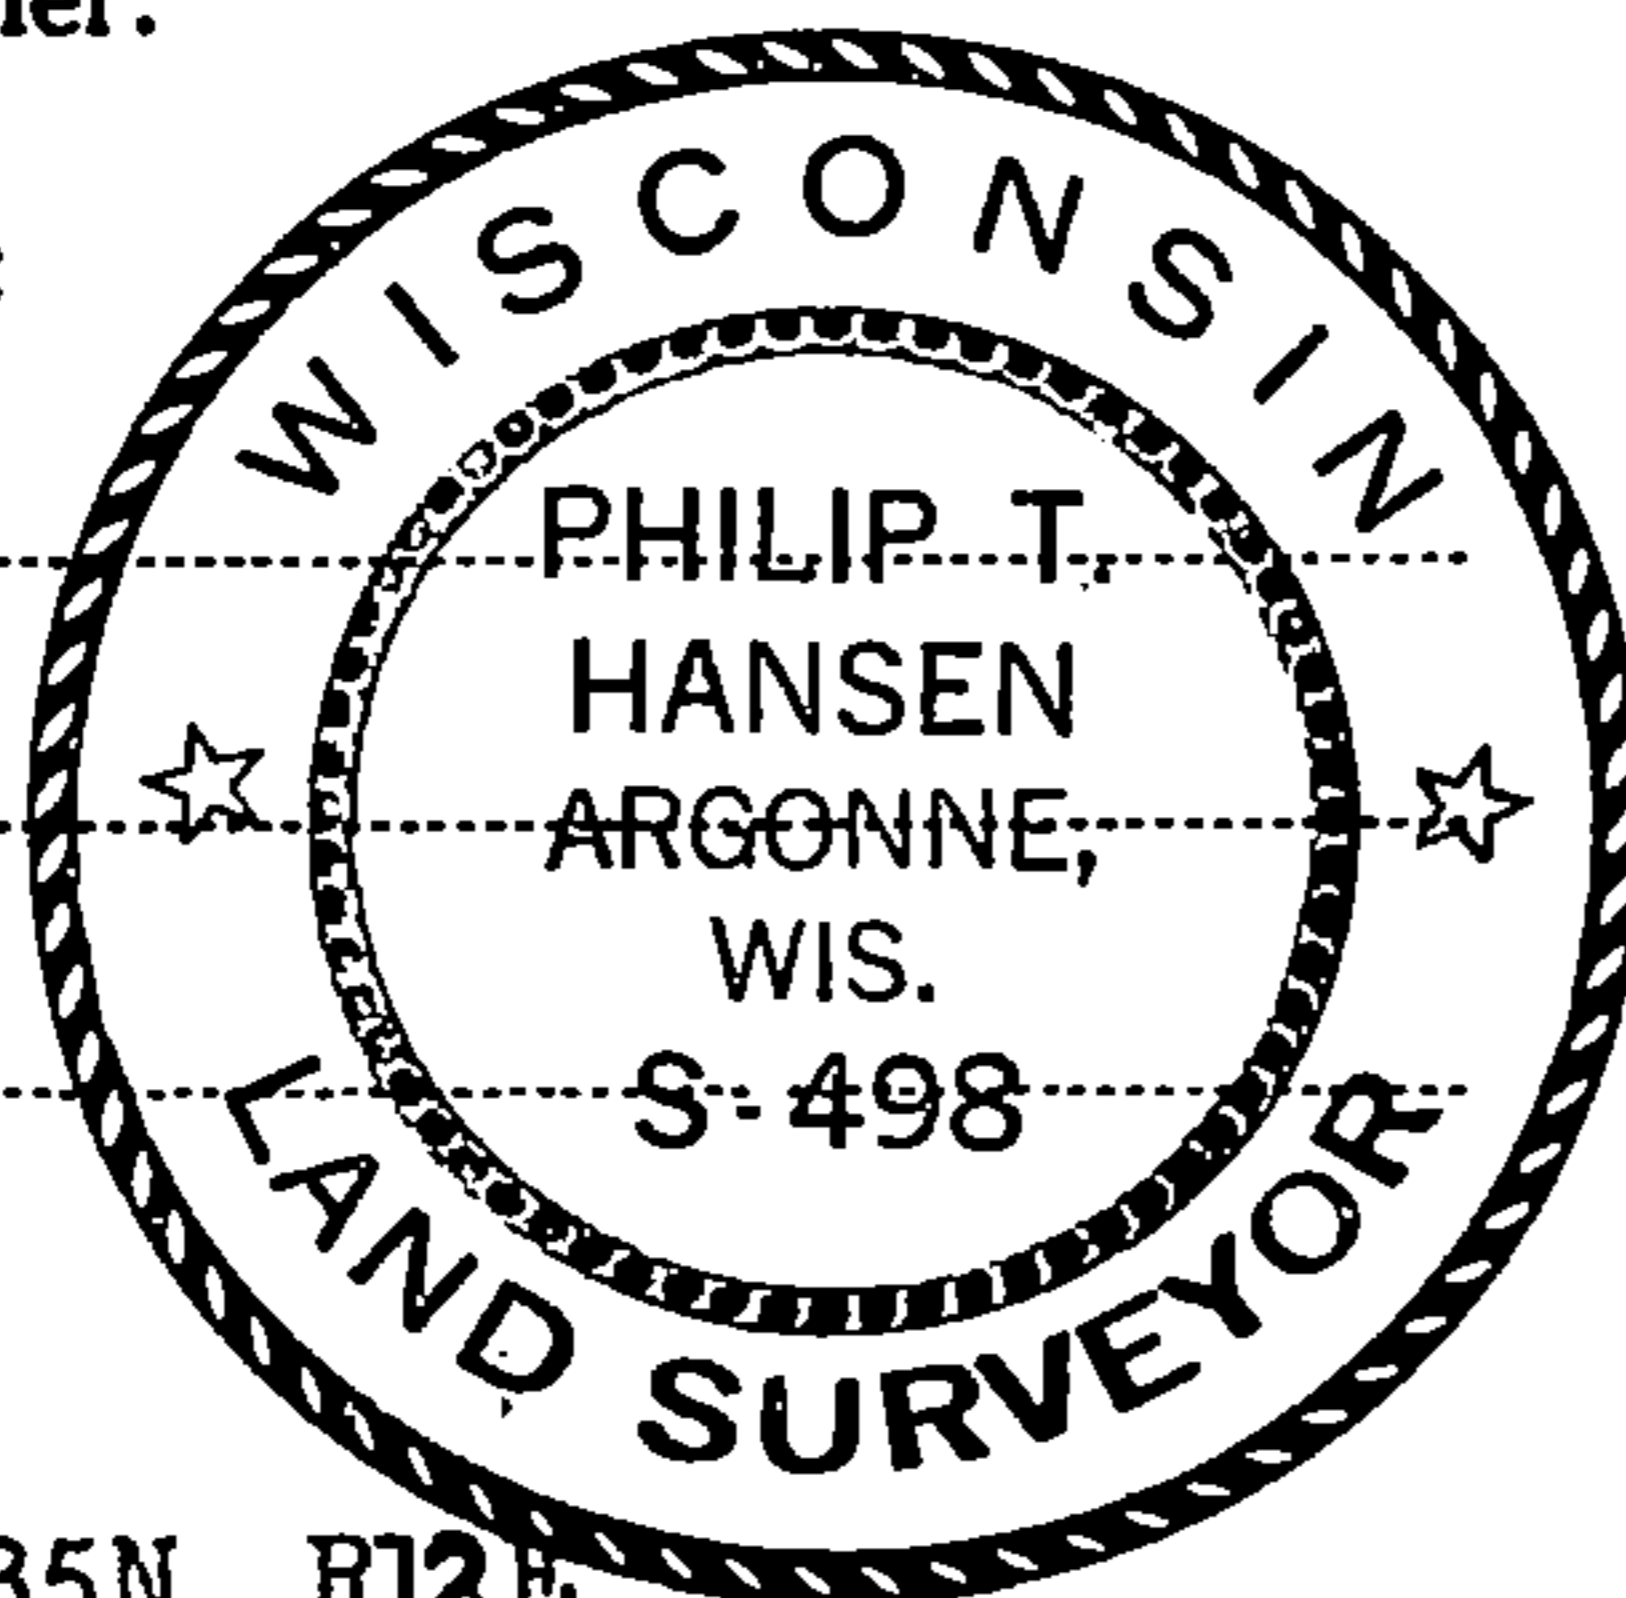

Description of monument and accessories I established to perpetuate the original location of this corner.

Replaced old post with 2 1/2" Berntsen A-1 Federal Monument, cap stamped.

Pipe projects 18" above ground.

Built rock cairn around base.

NBTs - Sugar 6" S39°E 37 lks, scribed 1/4 BT.


Sugar 10" N14°W 24.6 lks, scribed 1/4 BT.

Sugar 12" S67°W 60 lks, scribed 1/4 BT.

Pipe and BTs painted blue.

T35N R12E  
1/4 S 2  
S 11  
S498-1976

FORM 985

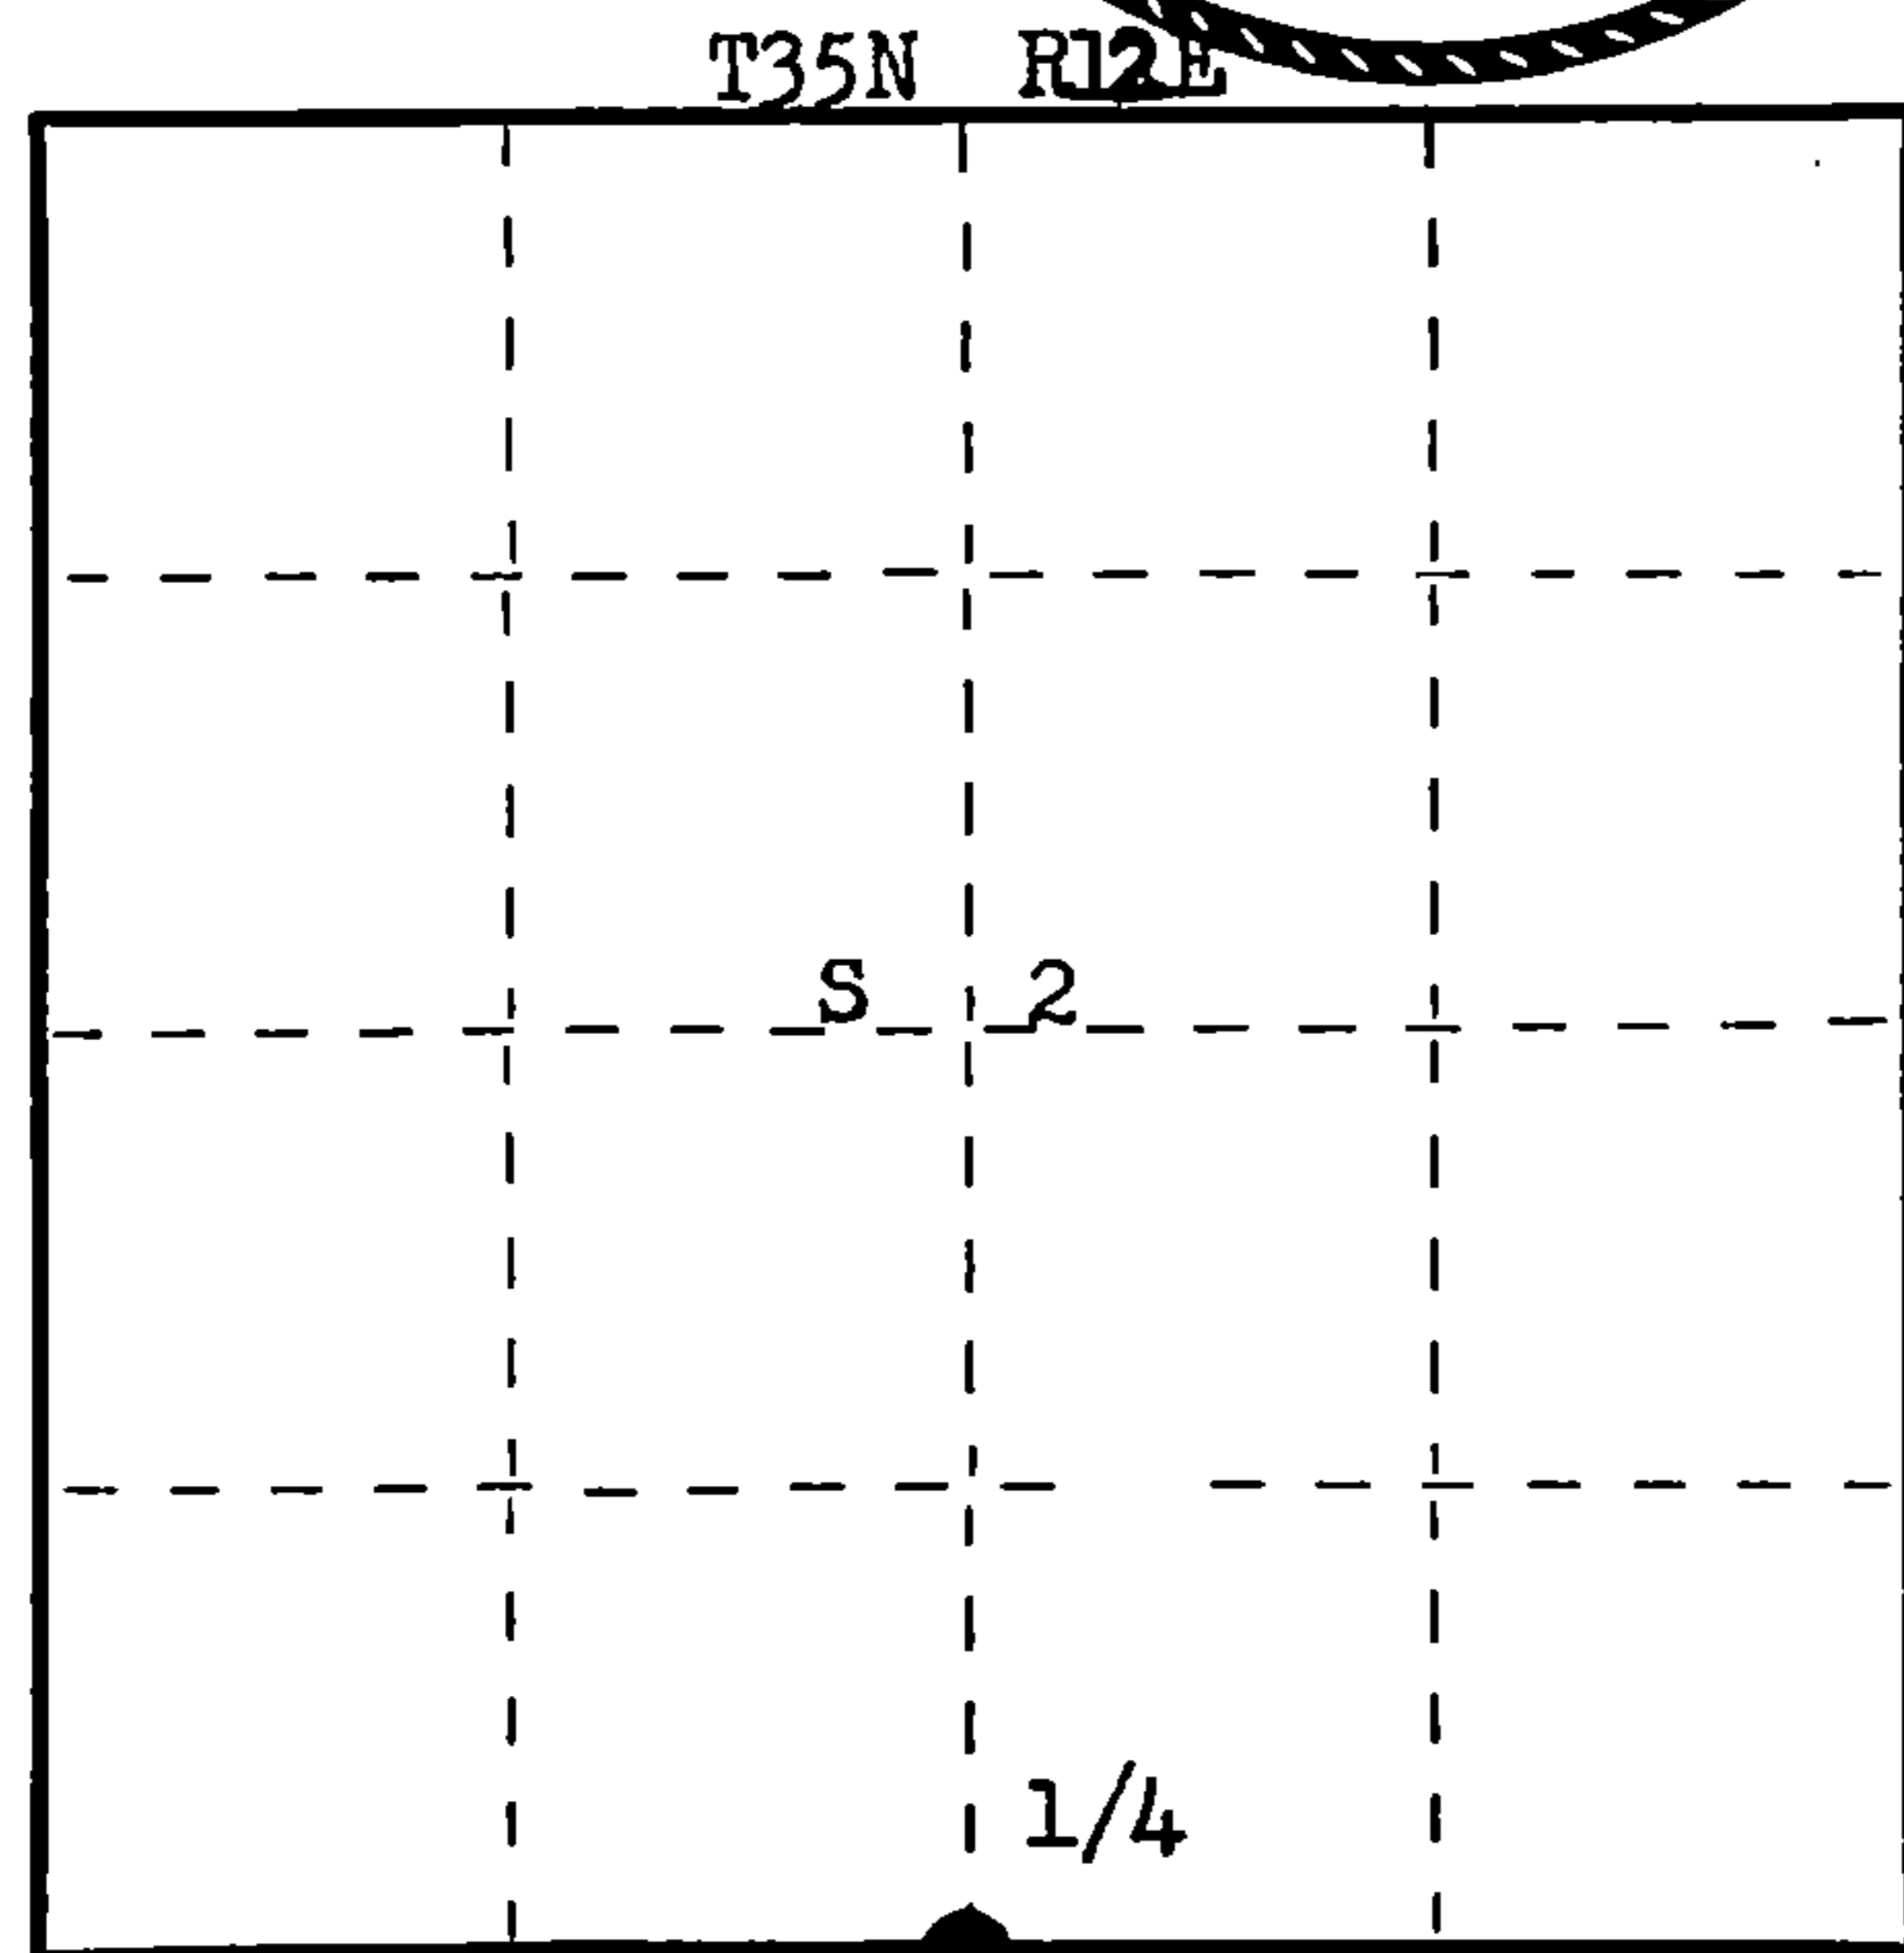

○ = Corner monument restored.

Dated at Rhineland, Wis., this 24th day of May, 1976

Signature Philip T. Hansen Title Registered Land Surveyor Registration No. S-498  
(County Surveyor, Registered Land Surveyor, or other duly authorized official)

Office of Register of Deeds, County of Forest, I hereby certify that the within instrument was filed in this office for record on the 9th day of June, 1976 at 3:30 o'clock P. M.

Eugene S. Stegny  
(Register of Deeds)  
By..... Deputy

DOCUMENT NUMBER **109397**

43512020020