

CERTIFIED LAND CORNER RESTORATION

Index No. D-21


State of Wisconsin }  
County of Forest } ss.

I Philip T. Hansen, do hereby certify that on the 14th day of May, 1979, I ~~found~~ <sup>established</sup> ~~recovered~~ the S. 1/16 corner of Section 1 and 2 Township 35, North, Range 12 East, Fourth Principal Meridian, as described hereon; and that from this evidence I established a new monument and accessories as described hereon to perpetuate the original location of this corner.

Resident witnesses:


Glen Barker

Jim Claflin

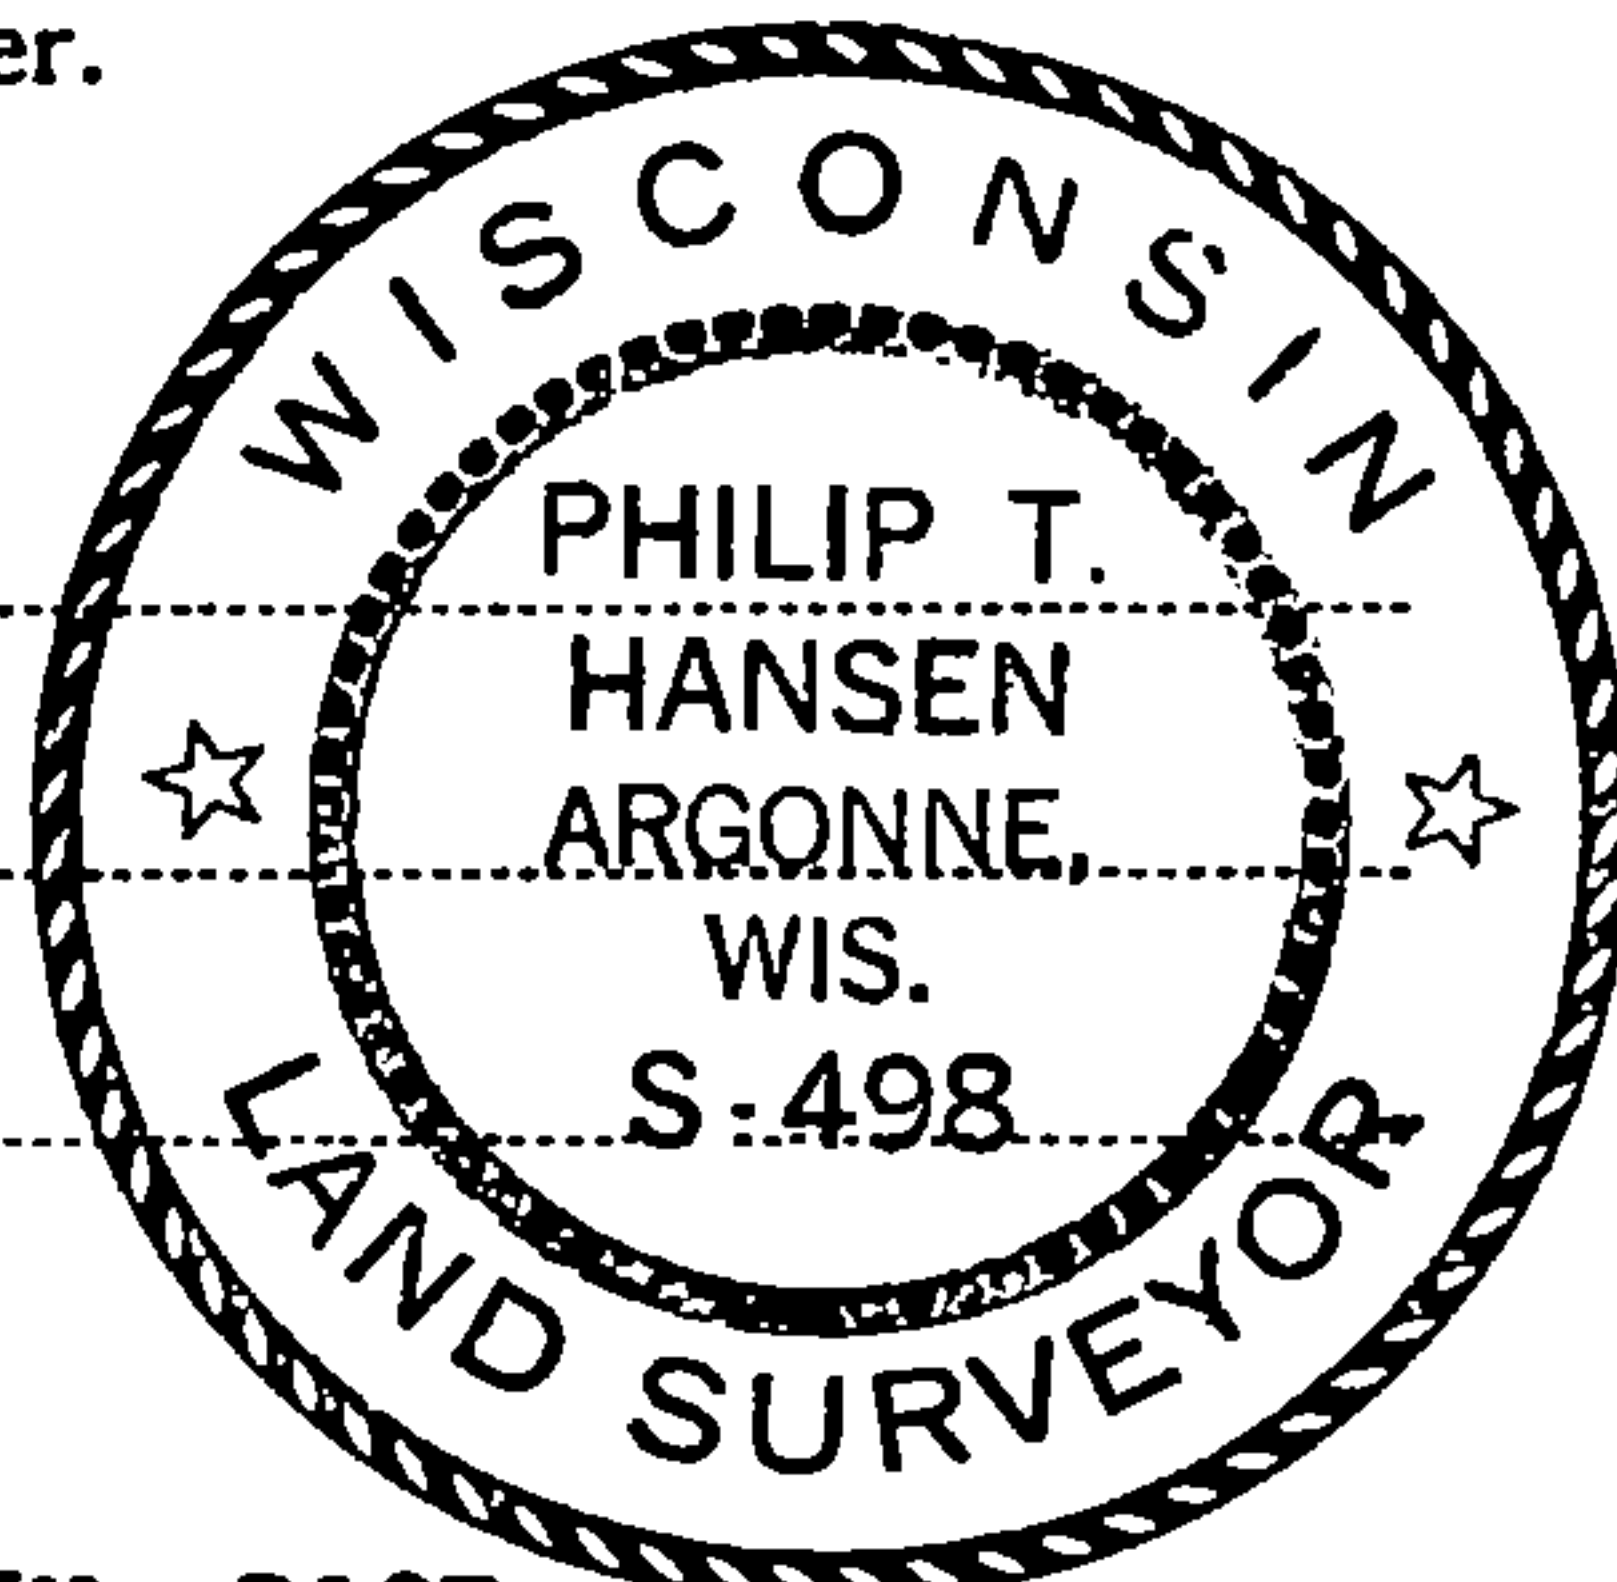

FORM 985  
Wisconsin Planning Board  
Madison, Wisconsin

T35N R12E

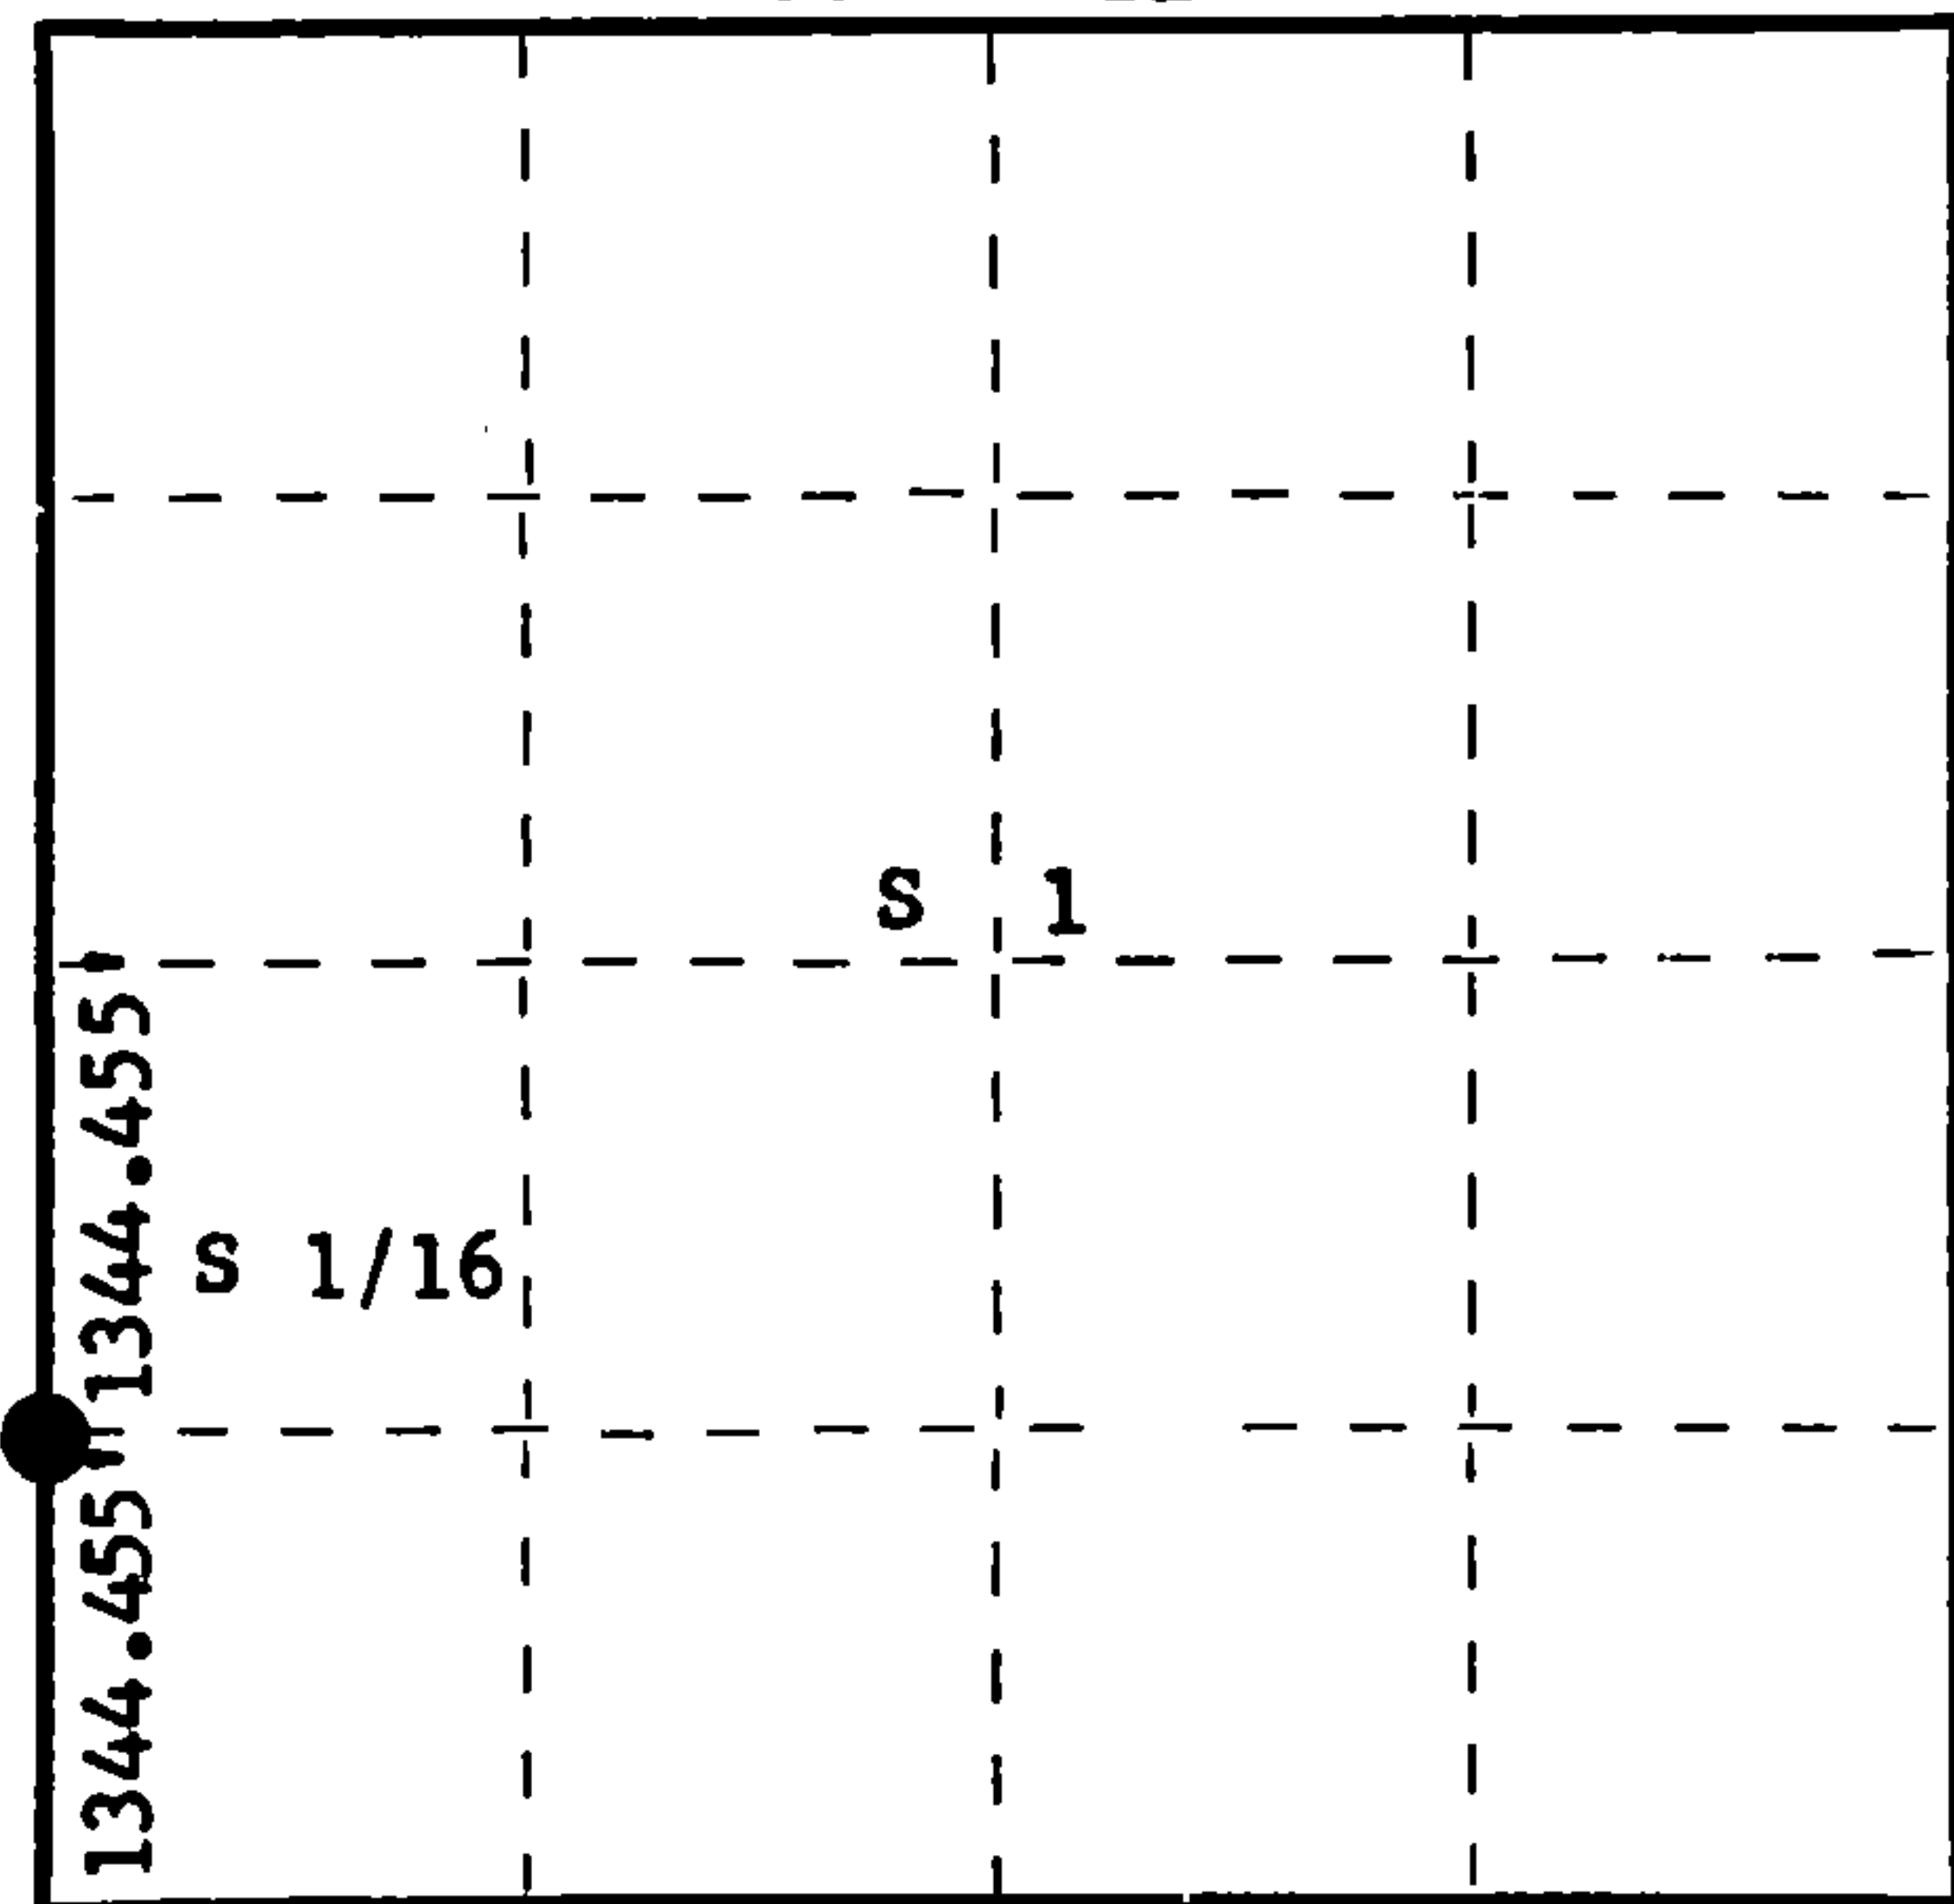

○ = Corner monument restored.

History of original corner establishment:

No records of any previous survey.

Description of corner evidence found:

No evidence of any corner recovered.

Corner established by traverse and computations. Ran traverse from section corner 1, 2, 11 and 12 to quarter corner between section 1 and 2. Computed distance is 2688.91 feet at bearing S 1° 14' 31' E.

Set S 1/16 corner at 1344.455 feet intermediate.

Description of monument and accessories I established to perpetuate the original location of this corner.

Set a 1-1/2" iron pipe with 2" brass cap, projecting 24", cap stamped:

Marked NBT's -

Sugar 9" S10°W 20.09', scribed 1/16 BT.

Sugar 5" S54°E, 24.21', scribed 1/16 BT.

Corner sets at the intersection of an old fence running east and south.

S498  
T35N R12E  
S 1/16 2+1  
1979

Dated at Rhinelander, Wis., this 21st day of May, 1979.

Signature Philip T. Hansen Title Registered Land Surveyor Registration No. S-498  
(County Surveyor, Registered Land Surveyor, or other duly authorized official)

Office of Register of Deeds, County of Forest, I hereby certify that the within instrument was filed in this office for record on the 13th day of November, 1979 at 8:30 o'clock A. M.

Eugene Stegemyer  
(Register of Deeds)

By \_\_\_\_\_ Deputy

DOCUMENT NO. **117073**

43512021000