

CERTIFIED LAND CORNER RESTORATION

Index No. D-20

State of Wisconsin }  
County of Forest } ss.


I Philip T. Hansen, do hereby certify that on the 18th day of October, 19 79, I ~~found~~ established ~~existence of the~~ SE 1/16 corner of Section 2 Township 35, North, Range 12 East, Fourth Principal Meridian, as described hereon; and that from this evidence I established a new monument and accessories as described hereon to perpetuate the original location of this corner.

Resident witnesses:


Glen Barker

Jim Claflin

Herb Wagoner

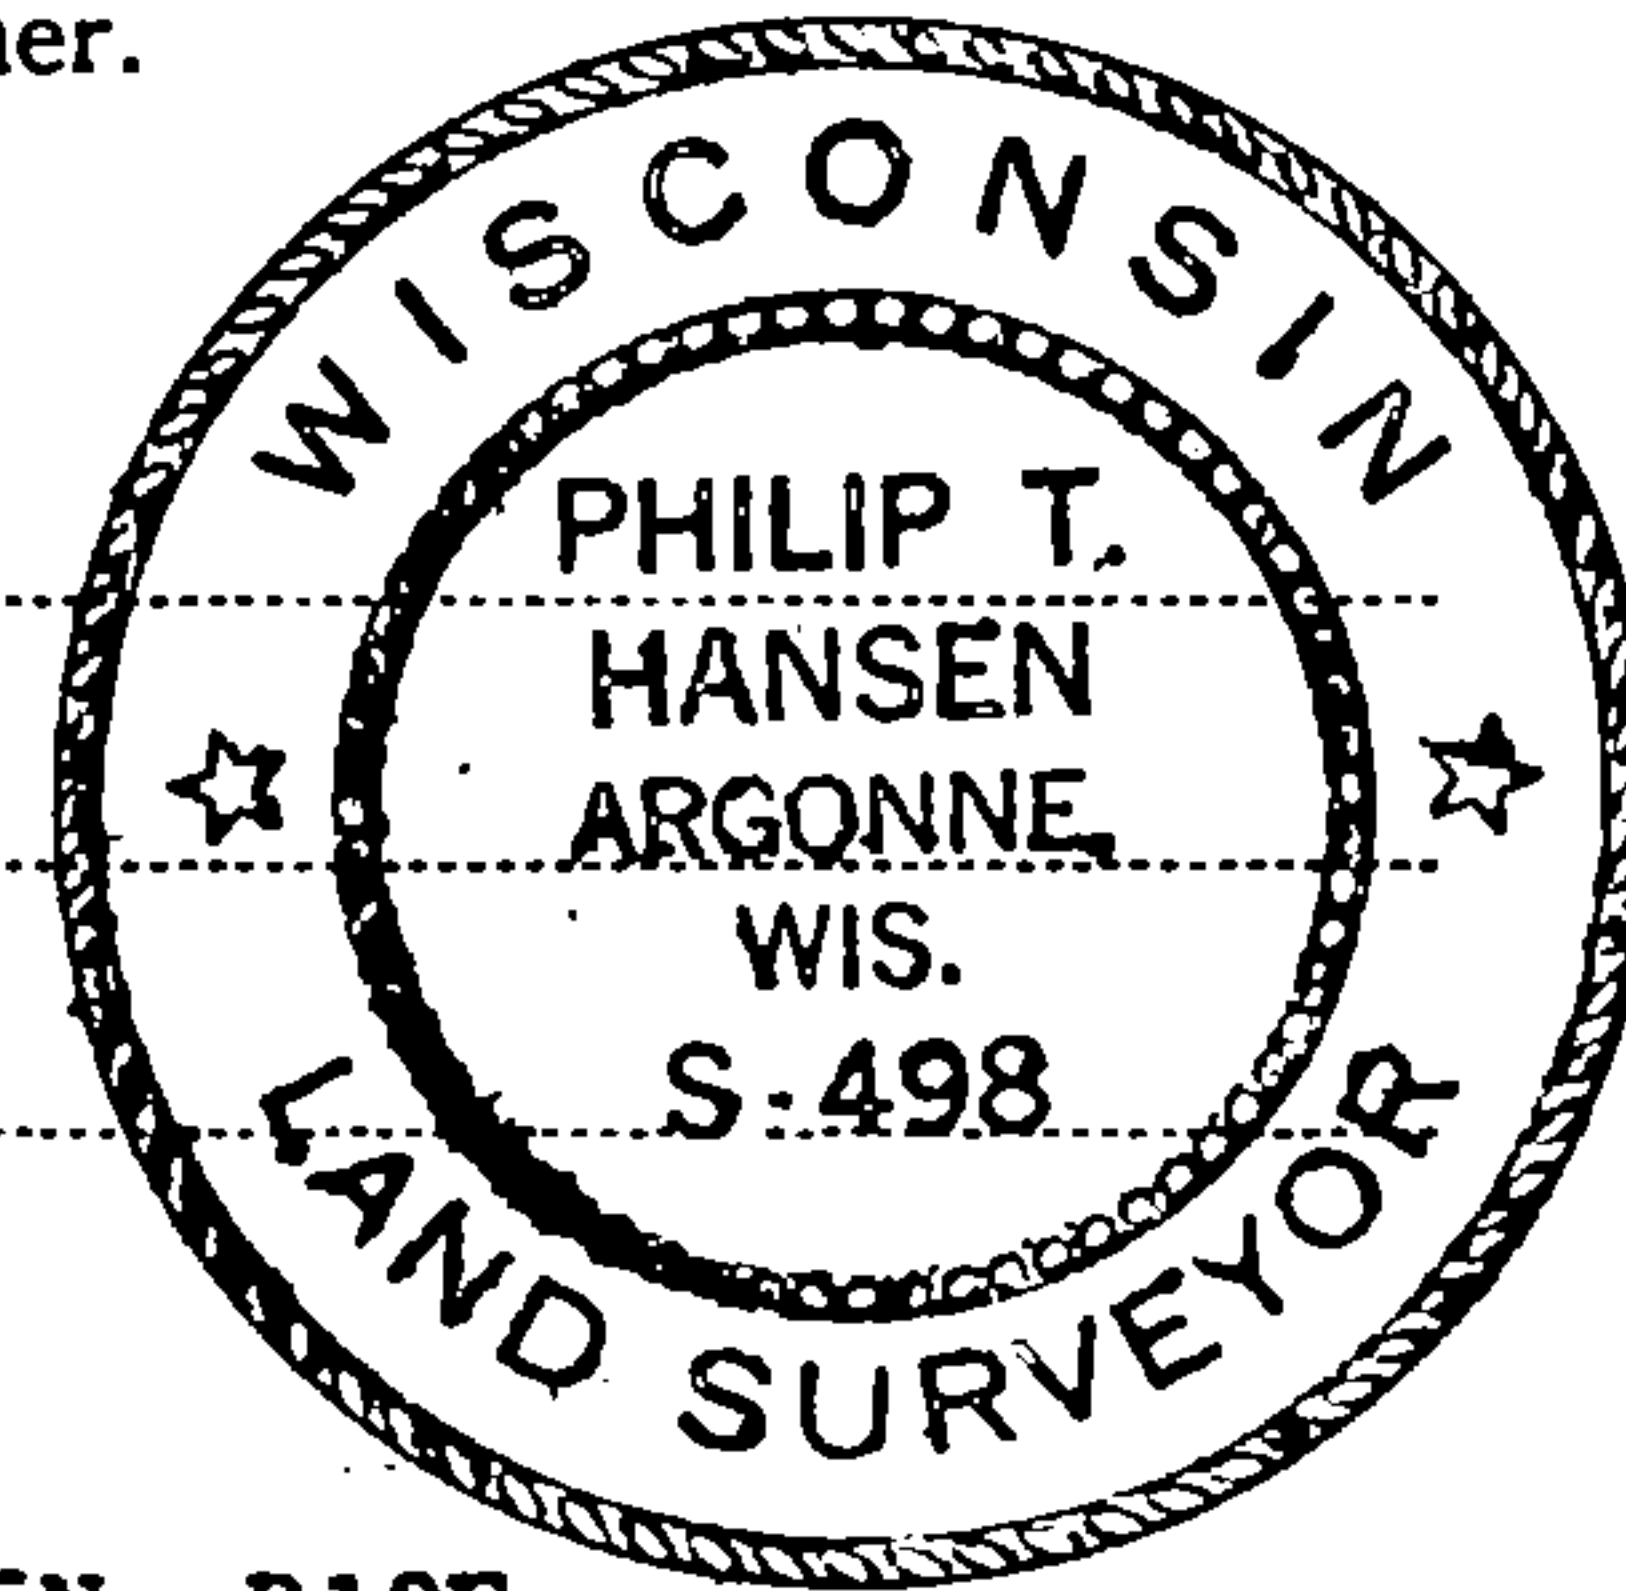

T35N R12E

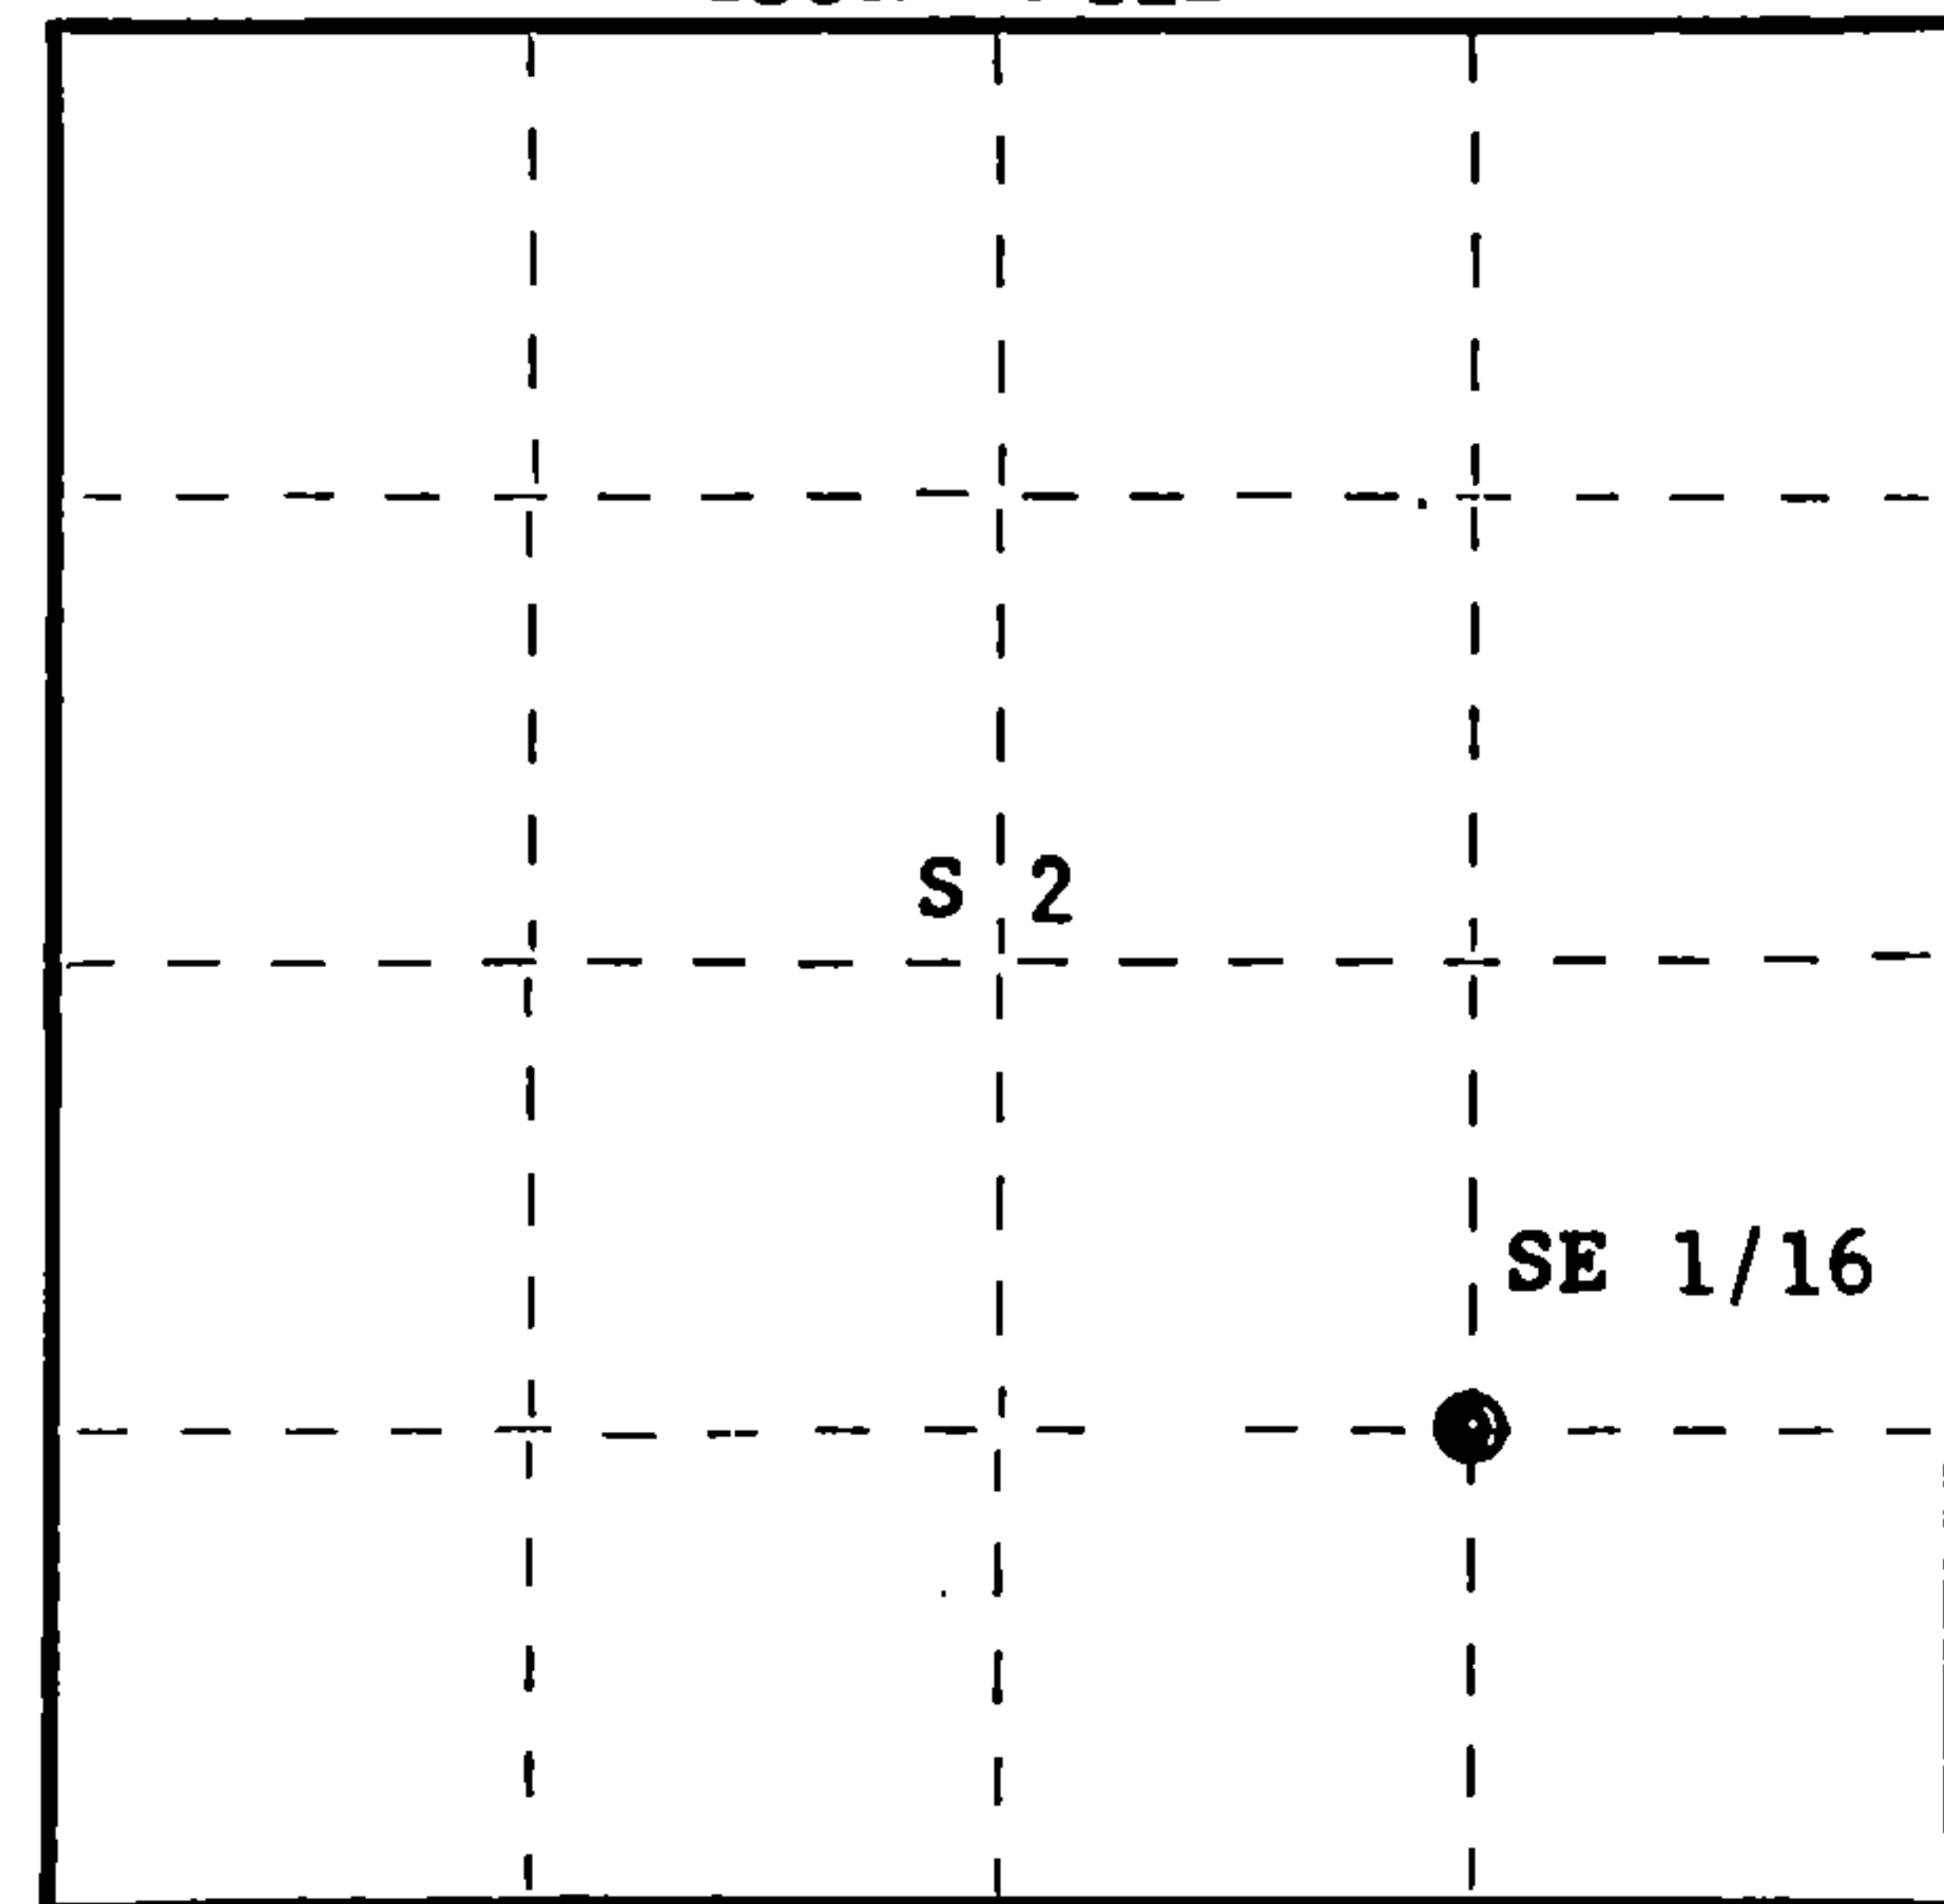

○ = Corner monument restored.

History of original corner establishment:

No records of any previous surveys.

Description of corner evidence found:

No evidence of any corner recovered.

Corner established by traverse and computation. Computed bearing and distance from E 1/16 between sections 2 and 11 and the EC 1/16 section 2 is N 1° 38' 24" W 2642.11 feet. Computed location of SE 1/16 is S 1° 38' 24" E, 1321.05 feet of EC 1/16.

Description of monument and accessories I established to perpetuate the original location of this corner.

Set a 1-1/2" iron pipe with 2" brass cap projecting 18" - stamped:

Marked NBT's -

Sugar 6" S42°E 26.35 feet, scribed 1/16 BT.

Sugar 7" S62°W 14.90 feet, scribed 1/16 BT.

S498  
T35N R12E  
SE 1/16 S+2  
CPI-1979

Dated at Rhineland, Wis., this 19th day of May, 19 80

Signature Philip T. Hansen Title Registered Land Surveyor Registration No. S-498  
(County Surveyor, Registered Land Surveyor, or other duly authorized official)

Office of Register of Deeds, County of Forest, I hereby certify that the within instrument was filed in this office for record on the 2nd day of June, 19 80 at 8:30 o'clock A. M.

Eugene Stutzman  
(Register of Deeds)

By \_\_\_\_\_ Deputy

DOCUMENT NO. **118006**

FORM 985 M. C. MILLER CO., MILWAUKEE

43512021010