

CERTIFIED LAND CORNER RESTORATION

Index No. E-6

State of Wisconsin }
County of Forest } ss.


I Philip T. Hansen, do hereby certify that on the 25th day of May, 19 77, I found established evidence of the W 1/16 corner of Section 5 & 8 Township 35, North, Range 12 East, Fourth Principal Meridian, as described hereon; and that from this evidence I established a new monument and accessories as described hereon to perpetuate the original location of this corner.

Resident witnesses:


Glen Barker

Jim Claflin

Herb Wagoner

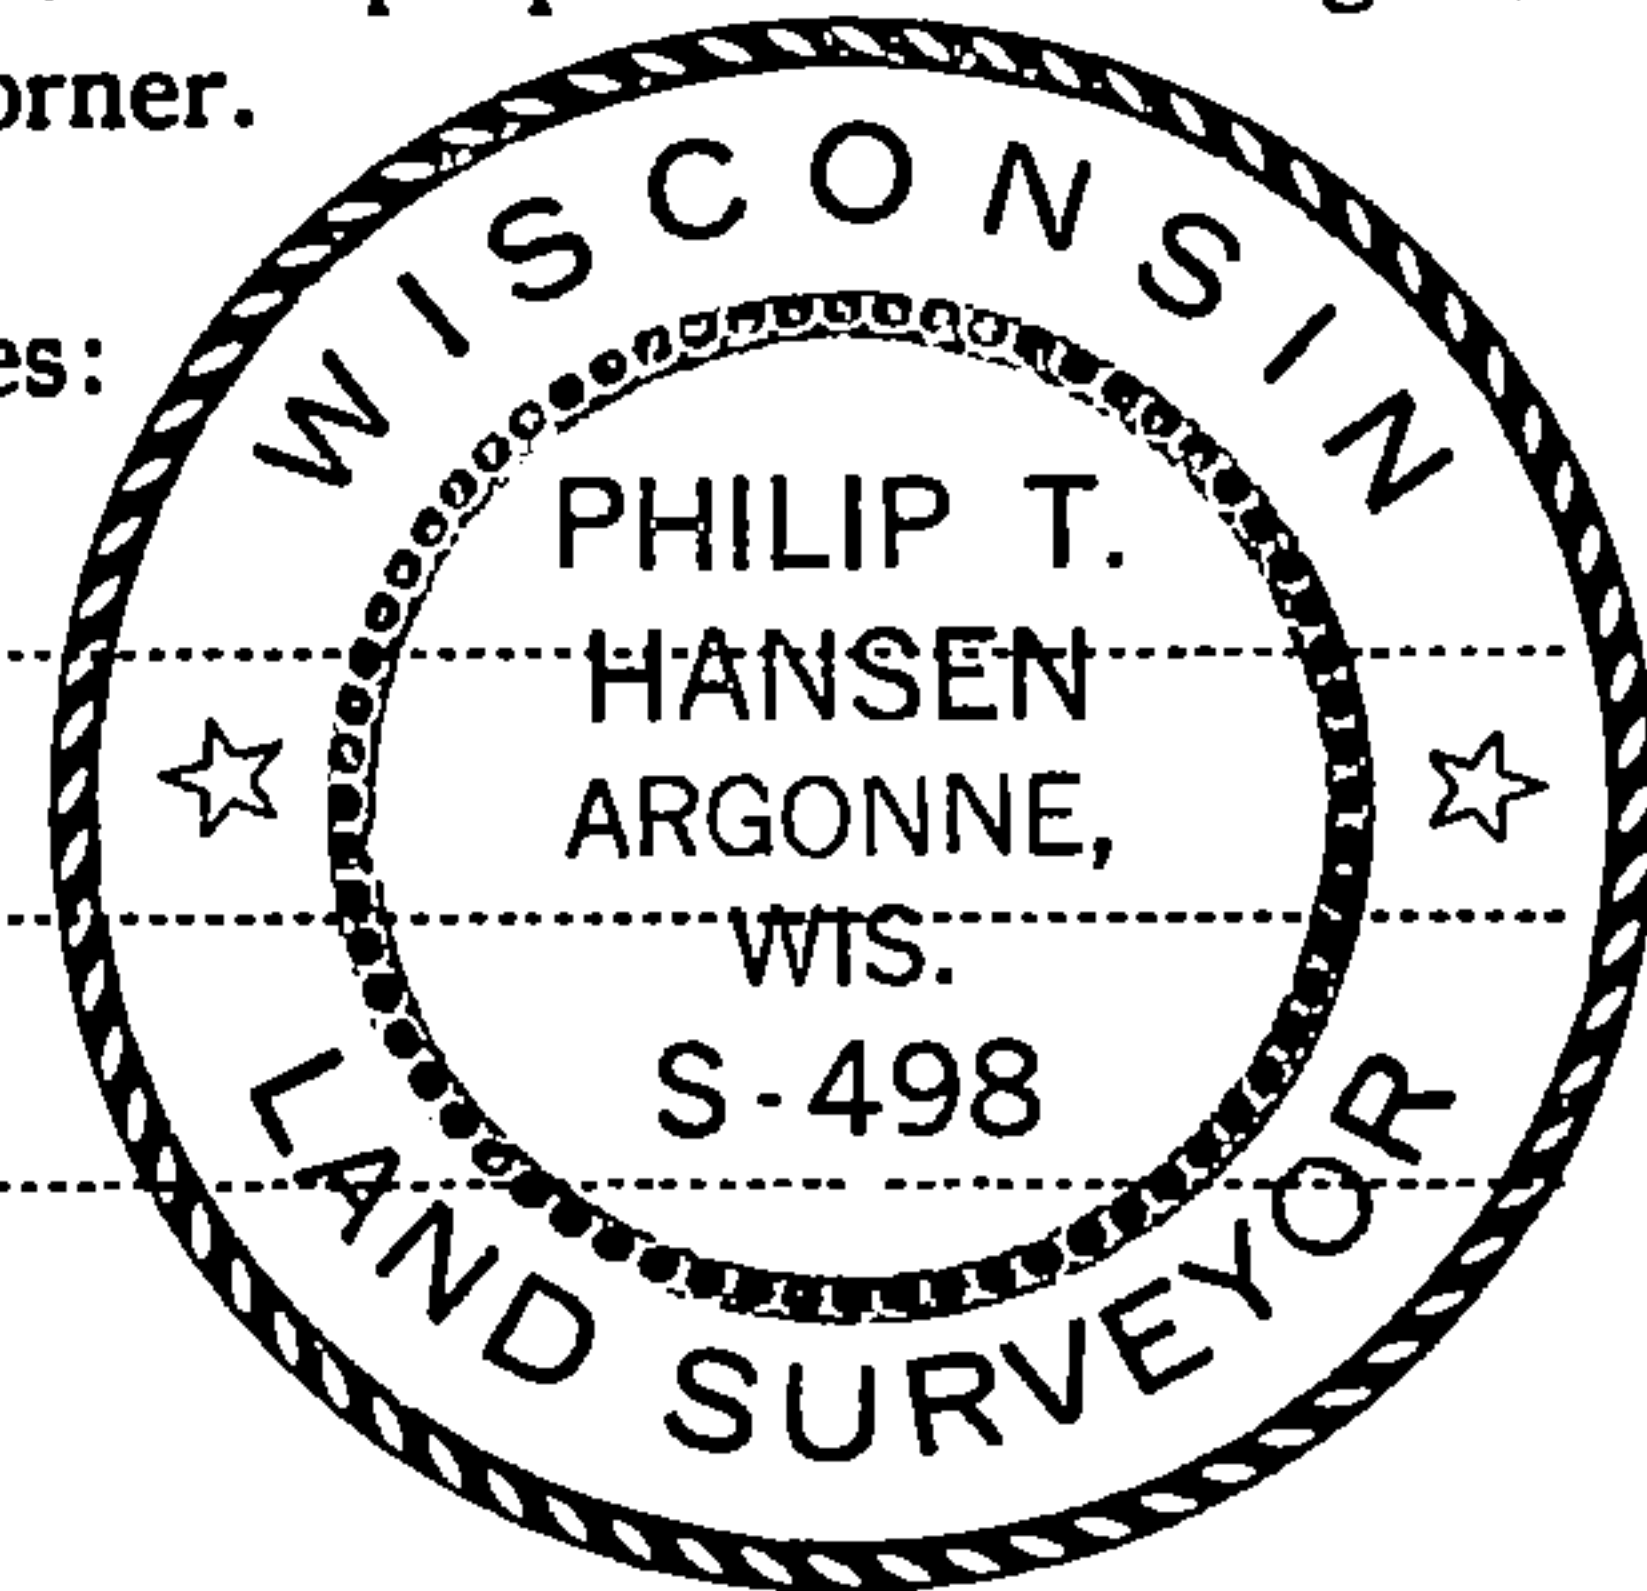

T35N R12E

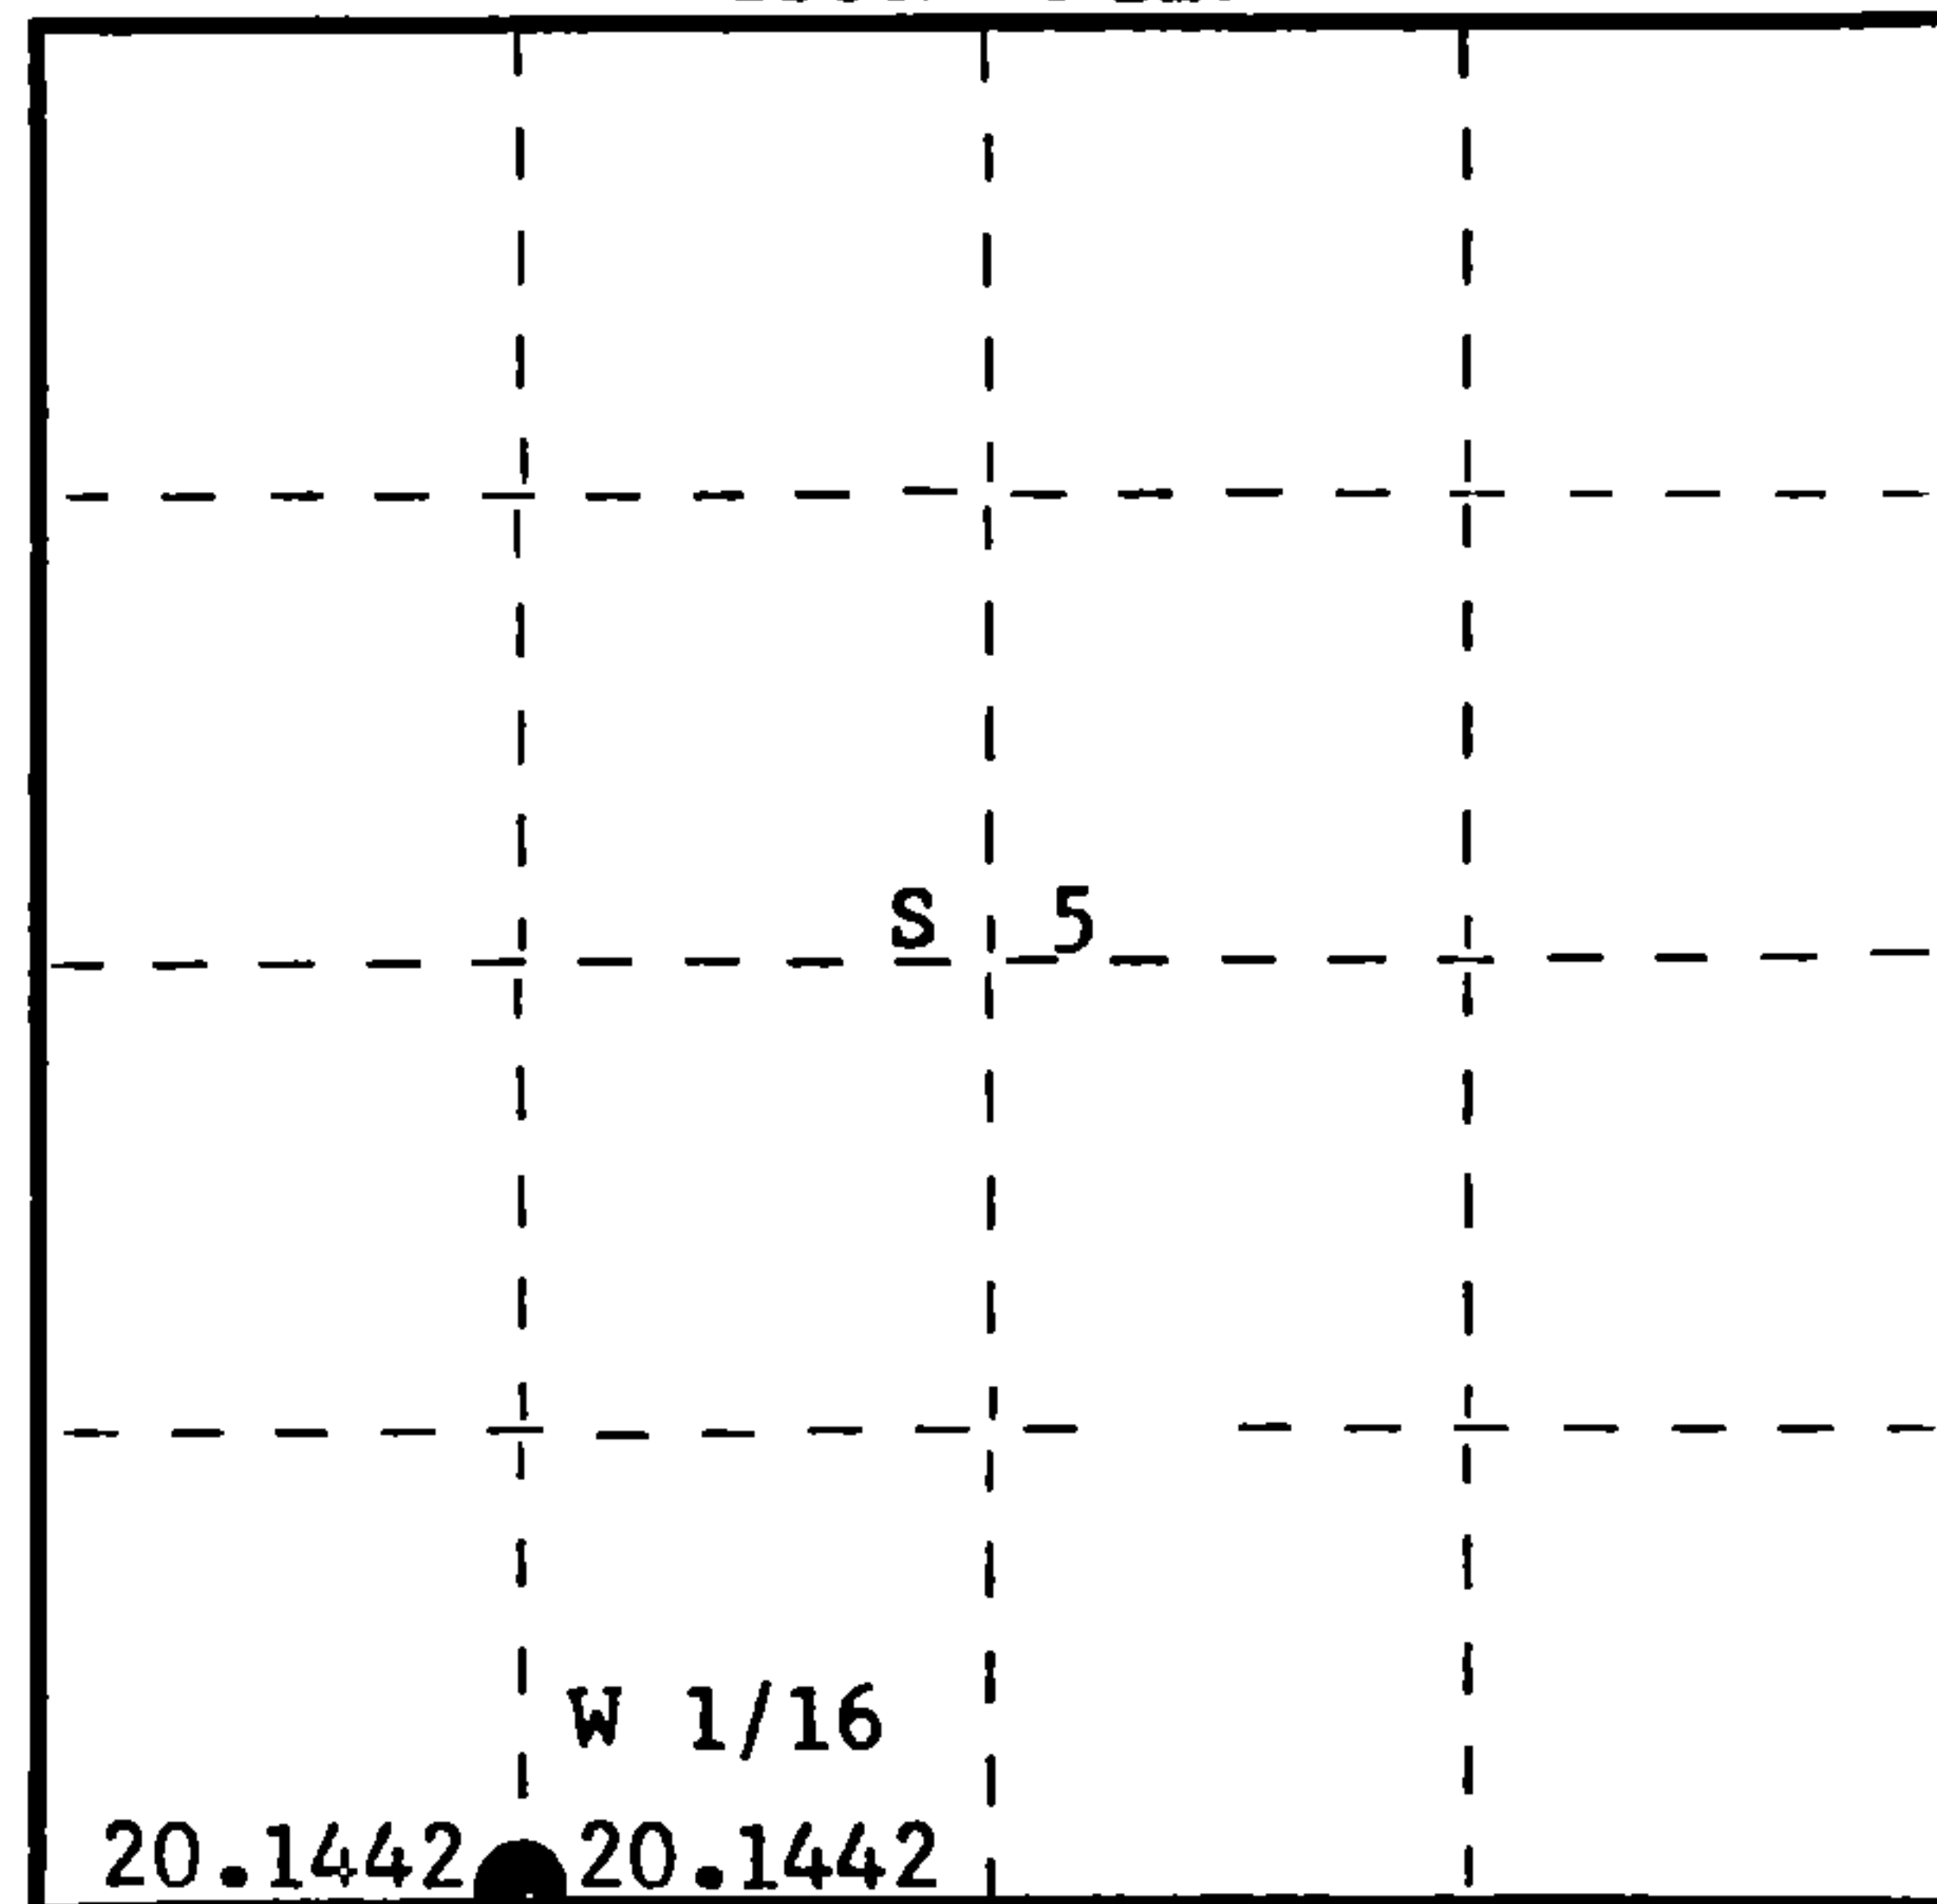

○ = Corner monument restored.

History of original corner establishment:
No records on file on any surveys of this corner.

Description of corner evidence found:
No evidence of any corner or reference marks.
Corner established by proportion. Ran traverse from previously established Section Corner 4, 5, 8, 9 to Section Corner 5, 6, 7 & 8, distance 5318.086'. Set 1/4 corner at 40.2885 Chs equidistant and set W 1/16 at 20.1442 chains equidistant.

Description of monument and accessories I established to perpetuate the original location of this corner.
Set 1 1/2" iron pipe with 2" brass cap, stamped:
Monument projects 24" above ground.
Marked NBTs - Sugar 8" N5°W, 20.5 links, scribed 1/16 BT.
Sugar 8" N51°E, 25.6 links, scribed 1/16 BT.

S498
T35N R12E
W 1/16 S 5
S 8
CPI-1977

Dated at Rhineland, Wis., this 1st day of June, 19 77

Signature Philip T. Hansen Title Registered Land Surveyor Registration No. S-498
(County Surveyor, Registered Land Surveyor, or other duly authorized official)

Office of Register of Deeds, County of Forest, I hereby certify that the within instrument was filed in this office for record on the 6th day of July, 19 77 at 3:30 o'clock P. M.

Eugene Stutzman
(Register of Deeds)

By _____ Deputy

DOCUMENT NUMBER
111814

FORM 985
Wisconsin Planning Library Co.
Madison, Wisconsin

43512 050030