

CERTIFIED LAND CORNER RESTORATION

Index No. D-9

State of Wisconsin }
County of Forest } ss.

History of original corner establishment:
No records on file of any previous survey.

I Philip T. Hansen, do hereby certify that on the 24th day of May, 1977, I ~~found~~ established ~~existence of~~ the S. 1/16 corner of Section 4 & 5 Township 35, North, Range 12 East, Fourth Principal Meridian, as described hereon; and that from this evidence I established a new monument and accessories as described hereon to perpetuate the original location of this corner.

Description of corner evidence found:

No evidence of any corner or witness monuments found after intensive search. Corner established by proportionate measurement, ran traverse north from Section Corner 4, 5, 8 and 9 to Section Corner 32, 33, 4 and 5. Computed distance 4805.92 ft. Established 1/4 corner at 39.0648 chains north on bearing N 2° 33' 52" W. Set S 1/16 corner at 19.532 chains intermediate.

Resident witnesses:


Glen Barker
Jim Claflin
Herb Wagoner

Description of monument and accessories I established to perpetuate the original location of this corner.

Set 1 1/2" iron pipe with 2" brass cap at 19.532 chains equidistant. Cap stamped: Monument projects 18" above ground. Marked NBTs - Sugar 9" S39°E, 19.9 links, scribed 1/16 BT. Sugar 8" N24°E, 33 links, scribed 1/16 BT.

S498
T35N R12E
S 1/16 S5 + S4
CPI-1977

FORM 985 Wisconsin Planning Agency Co. Madison, Wisconsin

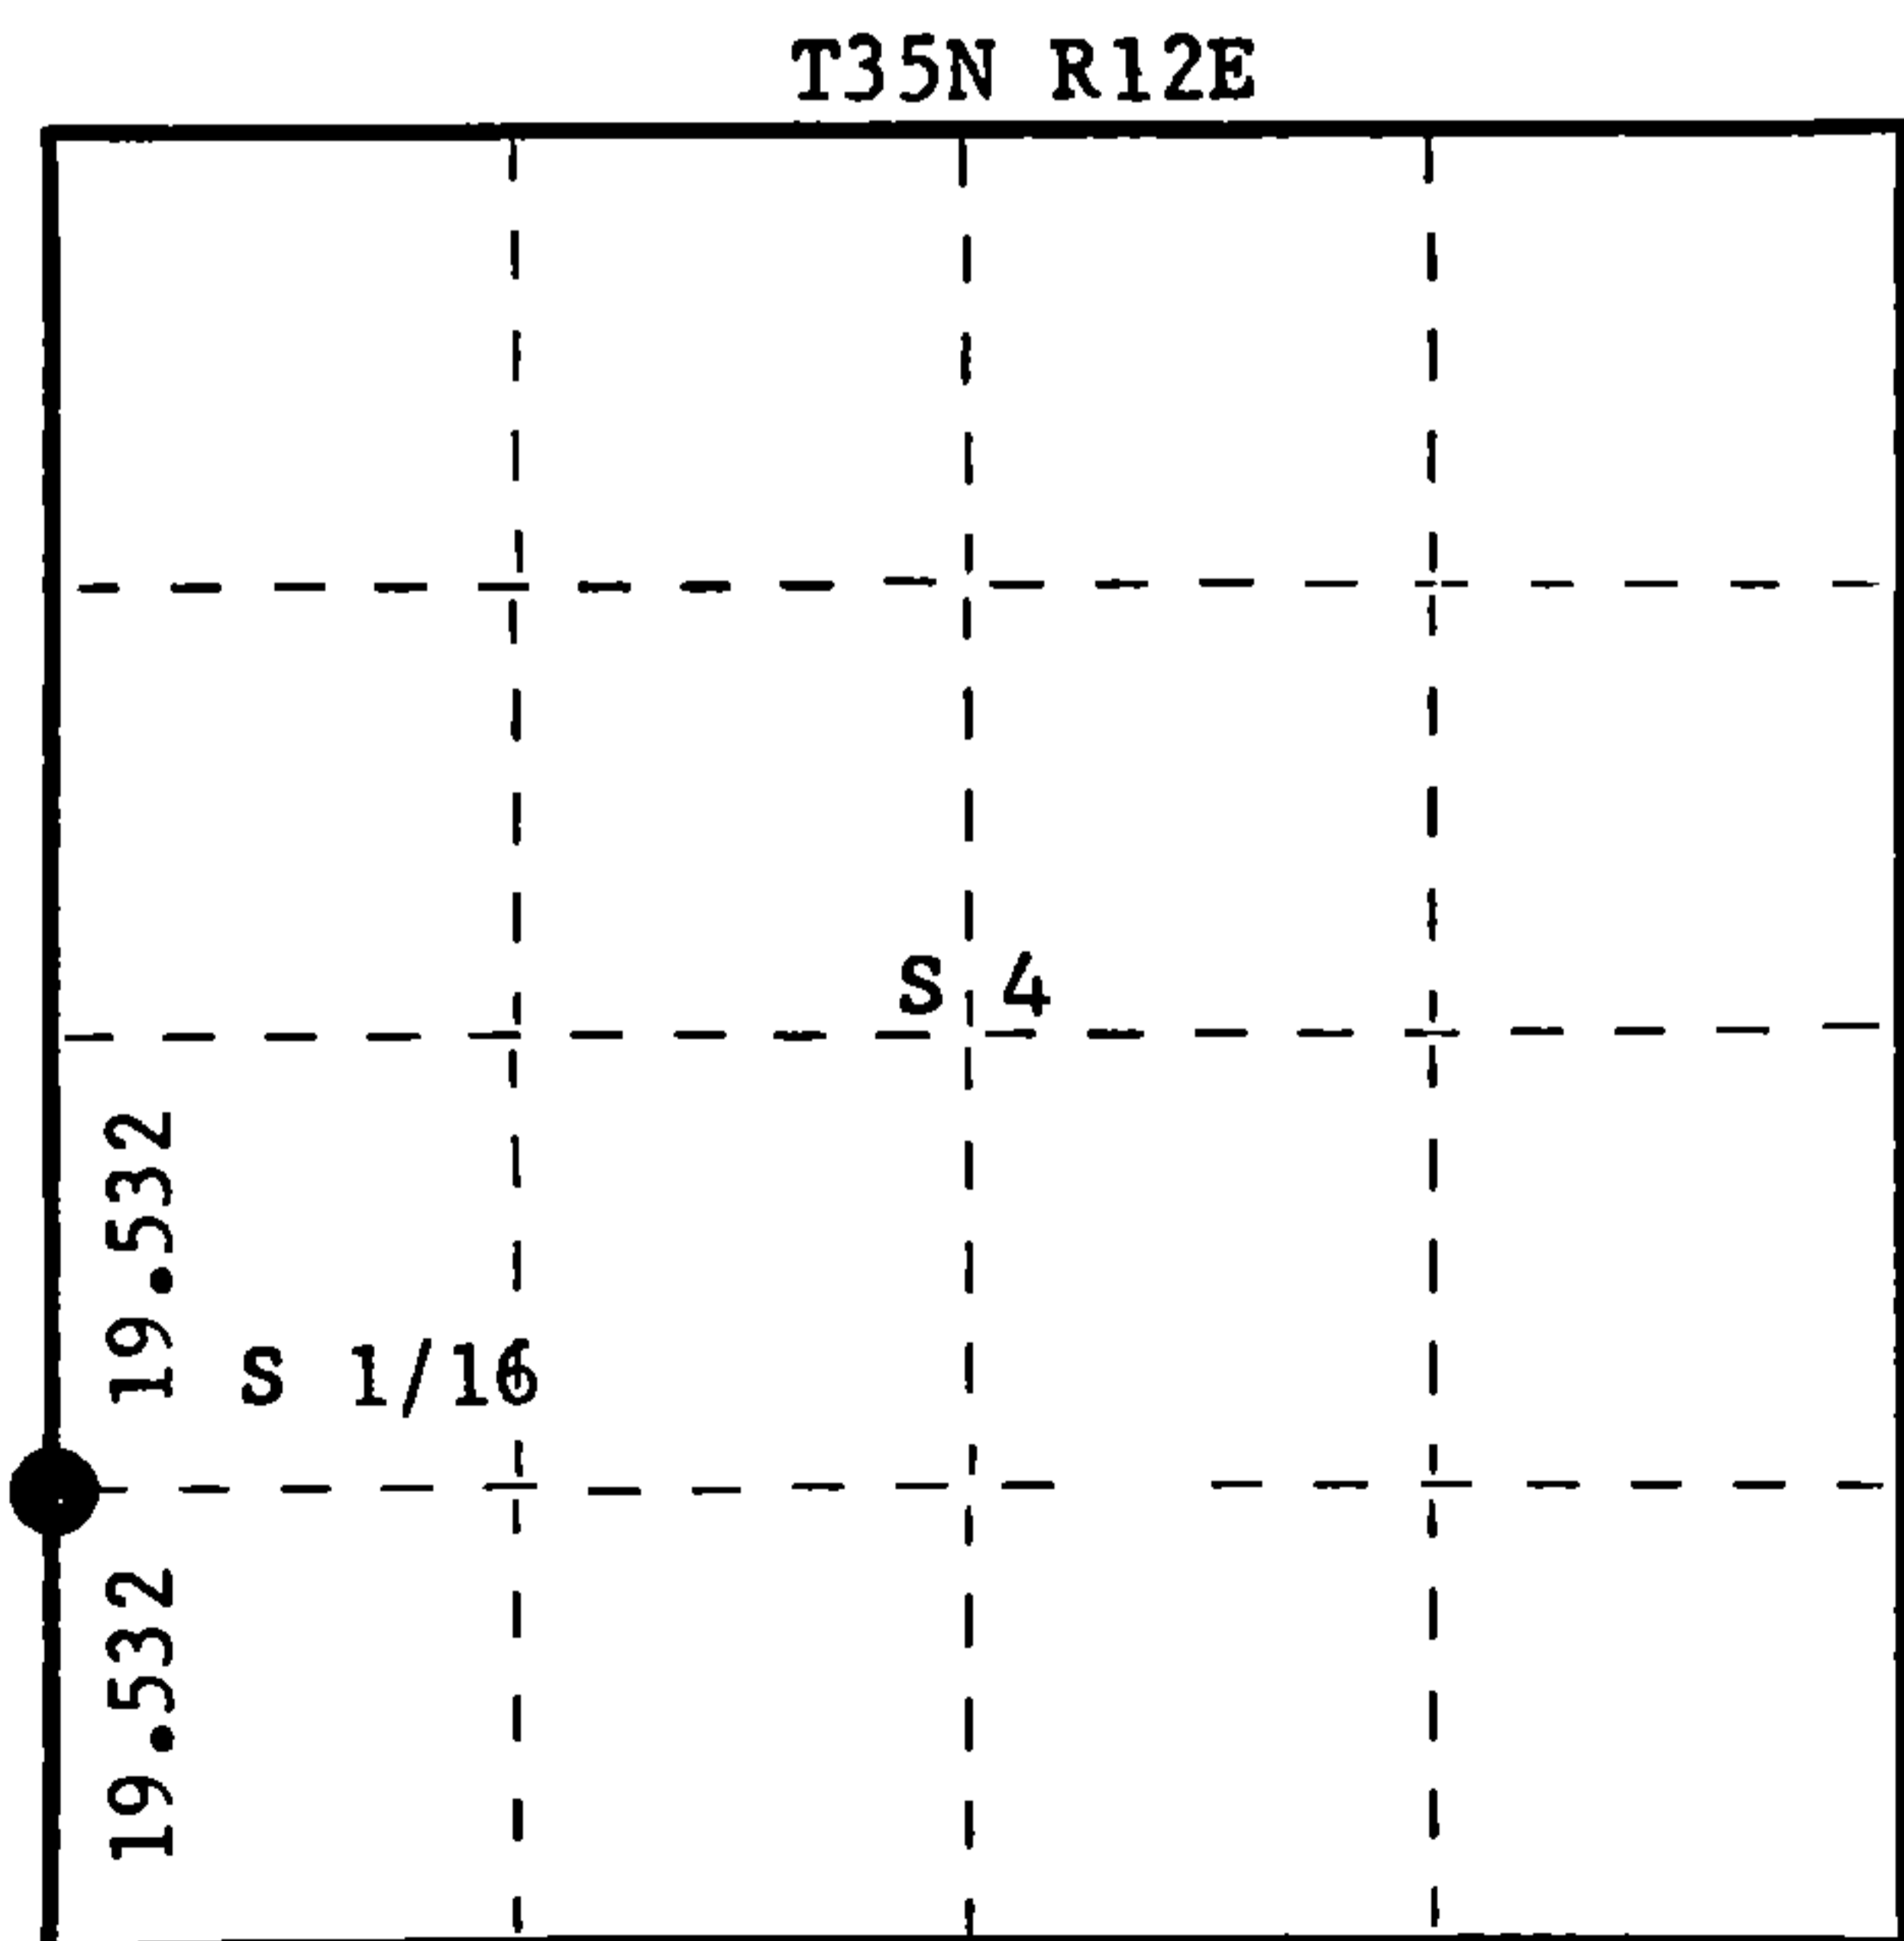

○ = Corner monument restored.

Dated at Rhineland, Wis., this 31st day of May, 1977.

Signature Philip T. Hansen Title Registered Land Surveyor Registration No. S-498
(County Surveyor, Registered Land Surveyor, or other duly authorized official)

Office of Register of Deeds, County of Forest, I hereby certify that the within instrument was filed in this office for record on the 6th day of July, 1977 at 3:30 o'clock P. M.

Eugene Statermy
(Register of Deeds)

By.....Deputy

DOCUMENT NUMBER
111813

43512051000