

CERTIFIED LAND CORNER RESTORATION

Index No. D-7

State of Wisconsin }
County of Forest } ss.


I Philip T. Hansen, do hereby certify that on the 17th day of July, 1977, I ~~found~~ established ~~the~~ SC 1/16 corner of Section 5 Township 35, North, Range 12 East, Fourth Principal Meridian, as described hereon; and that from this evidence I established a new monument and accessories as described hereon to perpetuate the original location of this corner.

Resident witnesses:


Glen Barker

Jim Claflin

Herb Wagoner

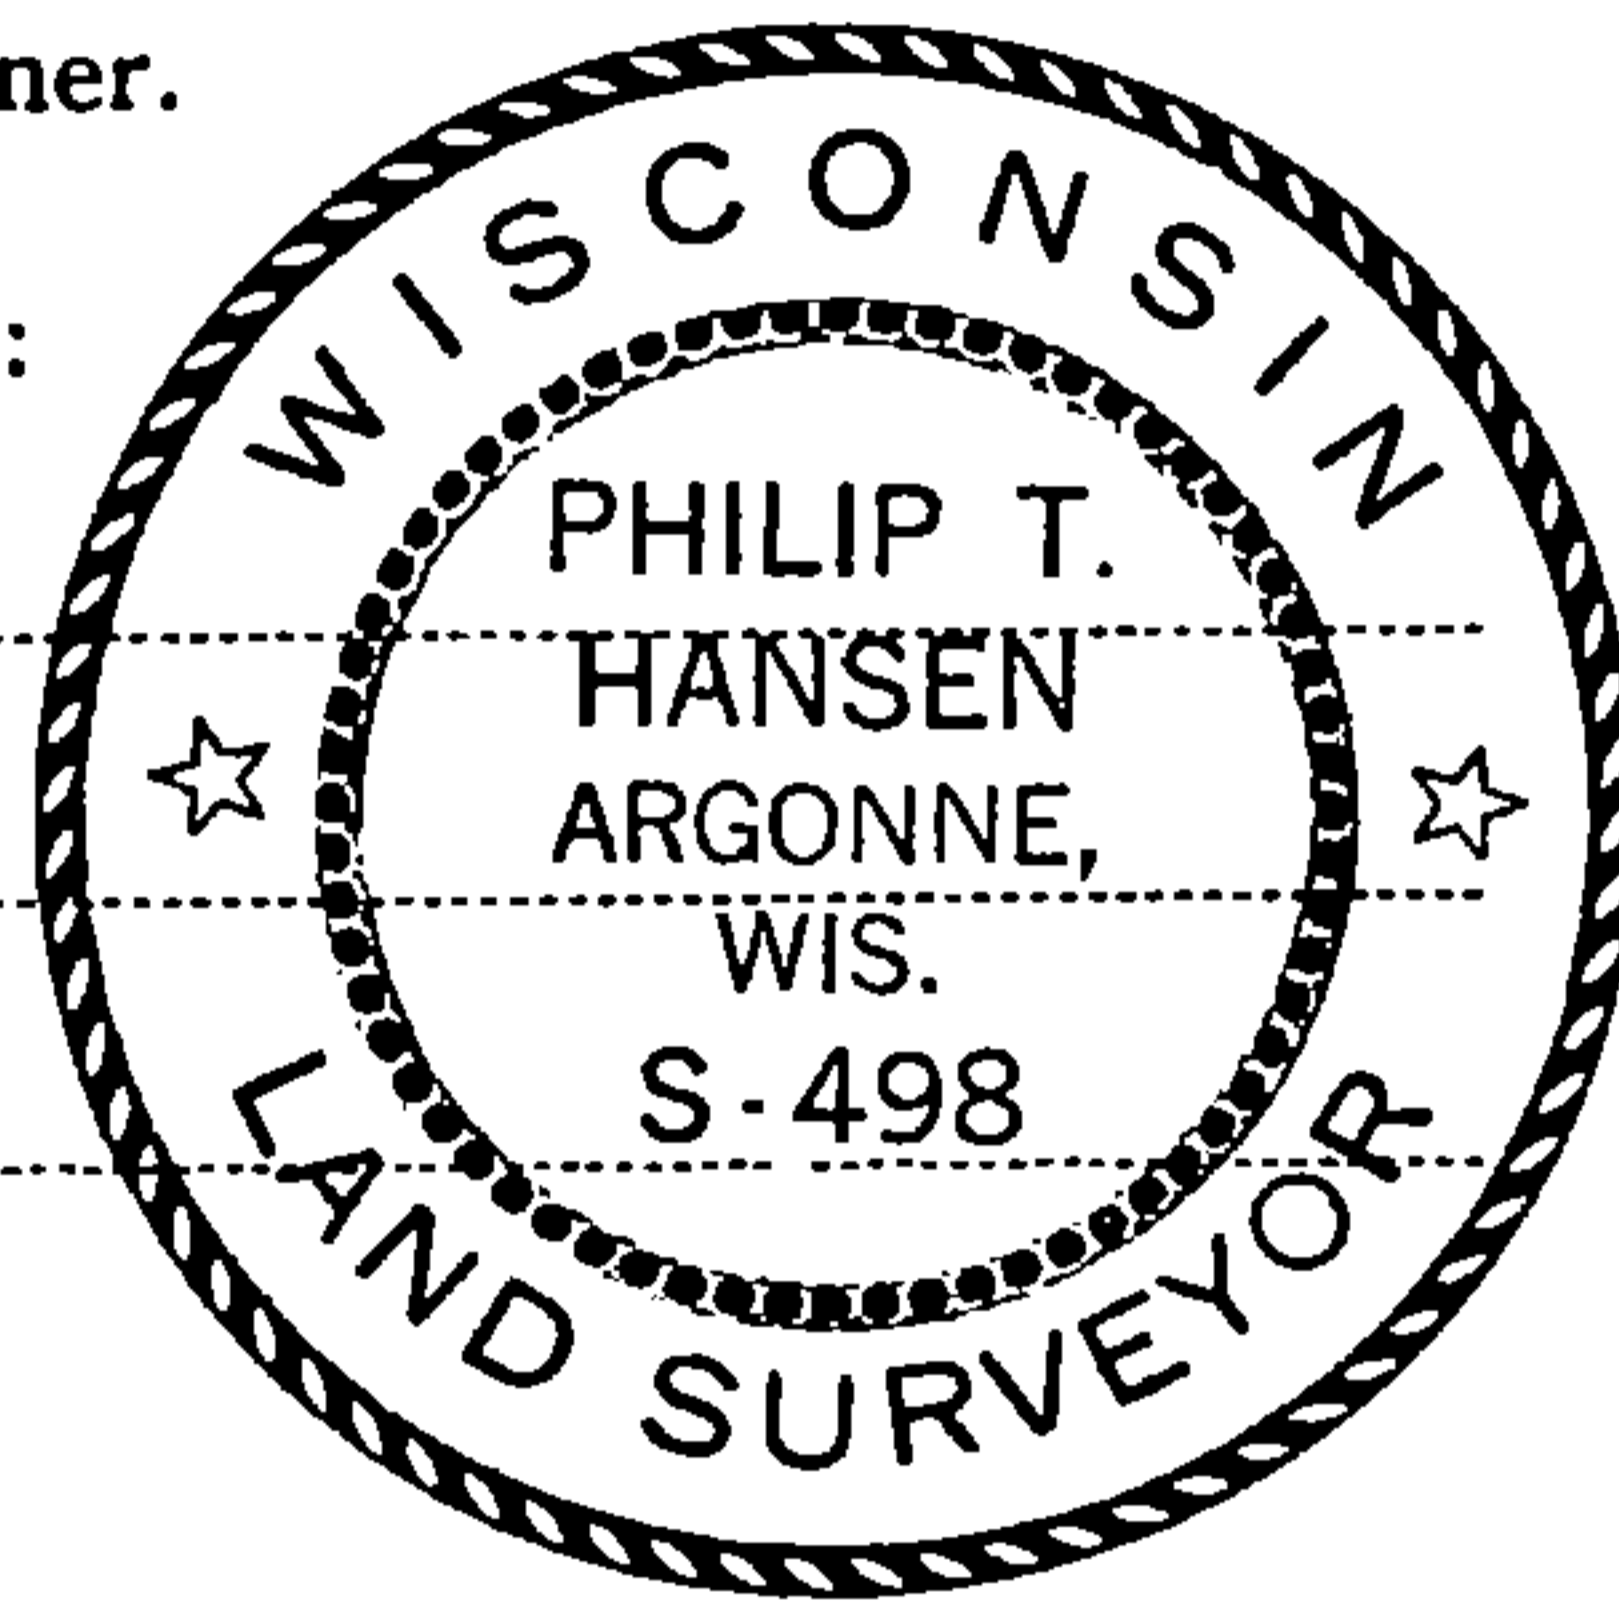

T35N R12E

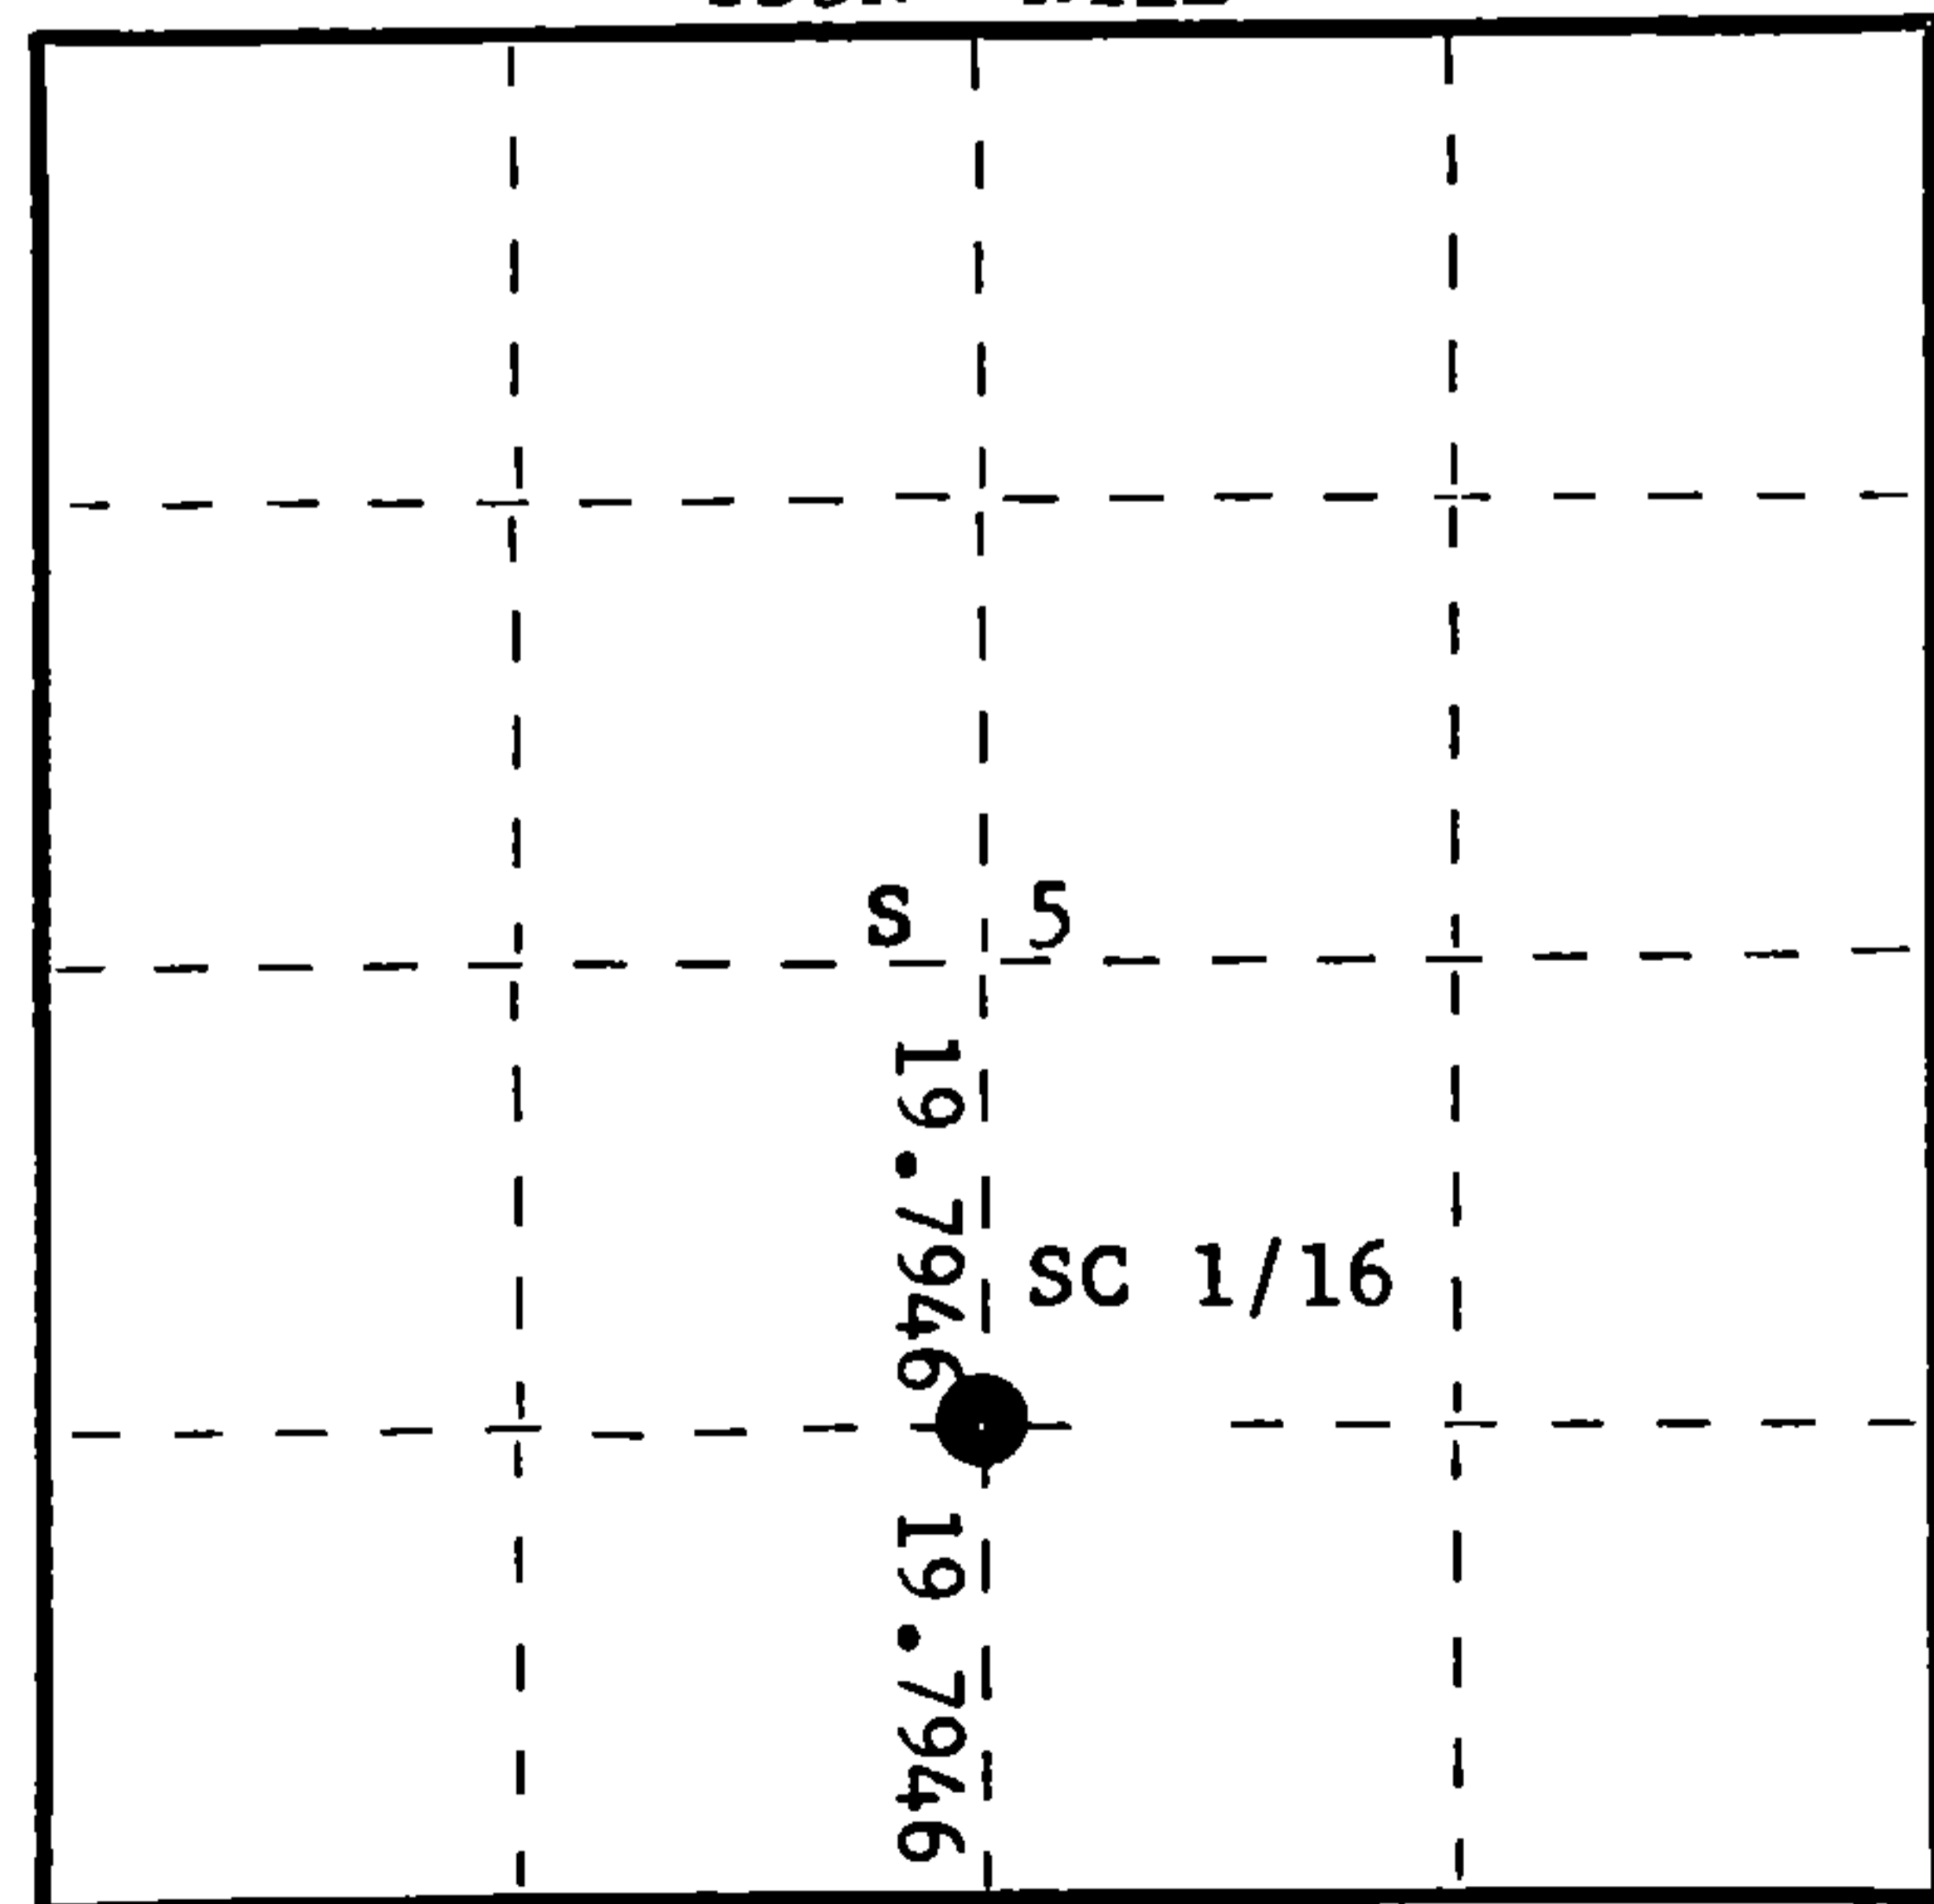

○ = Corner monument restored.

History of original corner establishment:

Corner established by subdivision from traverse computations. Ran traverse from previously established 1/4 corners to establish C 1/4 corner. Set SC 1/16 at 19.7946 chains S 2° 03' 38" E intermediate between C 1/4 and S 1/4 corner.

Description of corner evidence found:

No evidence of any corner set by previous survey.

Description of monument and accessories I established to perpetuate the original location of this corner.

Set 1 1/2" iron pipe with 2" brass cap, stamped:
Monument projects 2" above ground.

Marked NBTs - Sugar 6" N78°W, 44.3 links, scribed 1/16 BT.
Sugar 10" N38°E, 39 links, scribed 1/16 BT.

S498
T35N R12E
SC 1/16 S + 5
CPI-1977

Dated at Rhineland, Wis., this 21st day of July, 1977

Signature Philip T. Hansen Title Registered Land Surveyor Registration No. S-498
(County Surveyor, Registered Land Surveyor, or other duly authorized official)

Office of Register of Deeds, County of Forest, I hereby certify that the within instrument was filed in this office for record on the 9th day of August, 1977 at 11:45 o'clock A. M.

Eugene Stutzman
(Register of Deeds)

By _____ Deputy

DOCUMENT NUMBER

112062

FORM 985 H. C. MILLER CO., MILWAUKEE

43512051020