

CERTIFIED LAND CORNER RESTORATION

Index No. D-5

State of Wisconsin }
County of Forest } ss.


I, Philip T. Hansen, do hereby certify that on the 14th day of October, 19 76, I ~~found~~ ^{established} ~~evidence of the~~ ^{existence of the} S 1/16 corner of Section 5 & 6 Township 35, North, Range 12 East, Fourth Principal Meridian, as described hereon; and that from this evidence I established a new monument and accessories as described hereon to perpetuate the original location of this corner.

Resident witnesses:


Glen Barker

Jim Claflin

Herb Wagoner

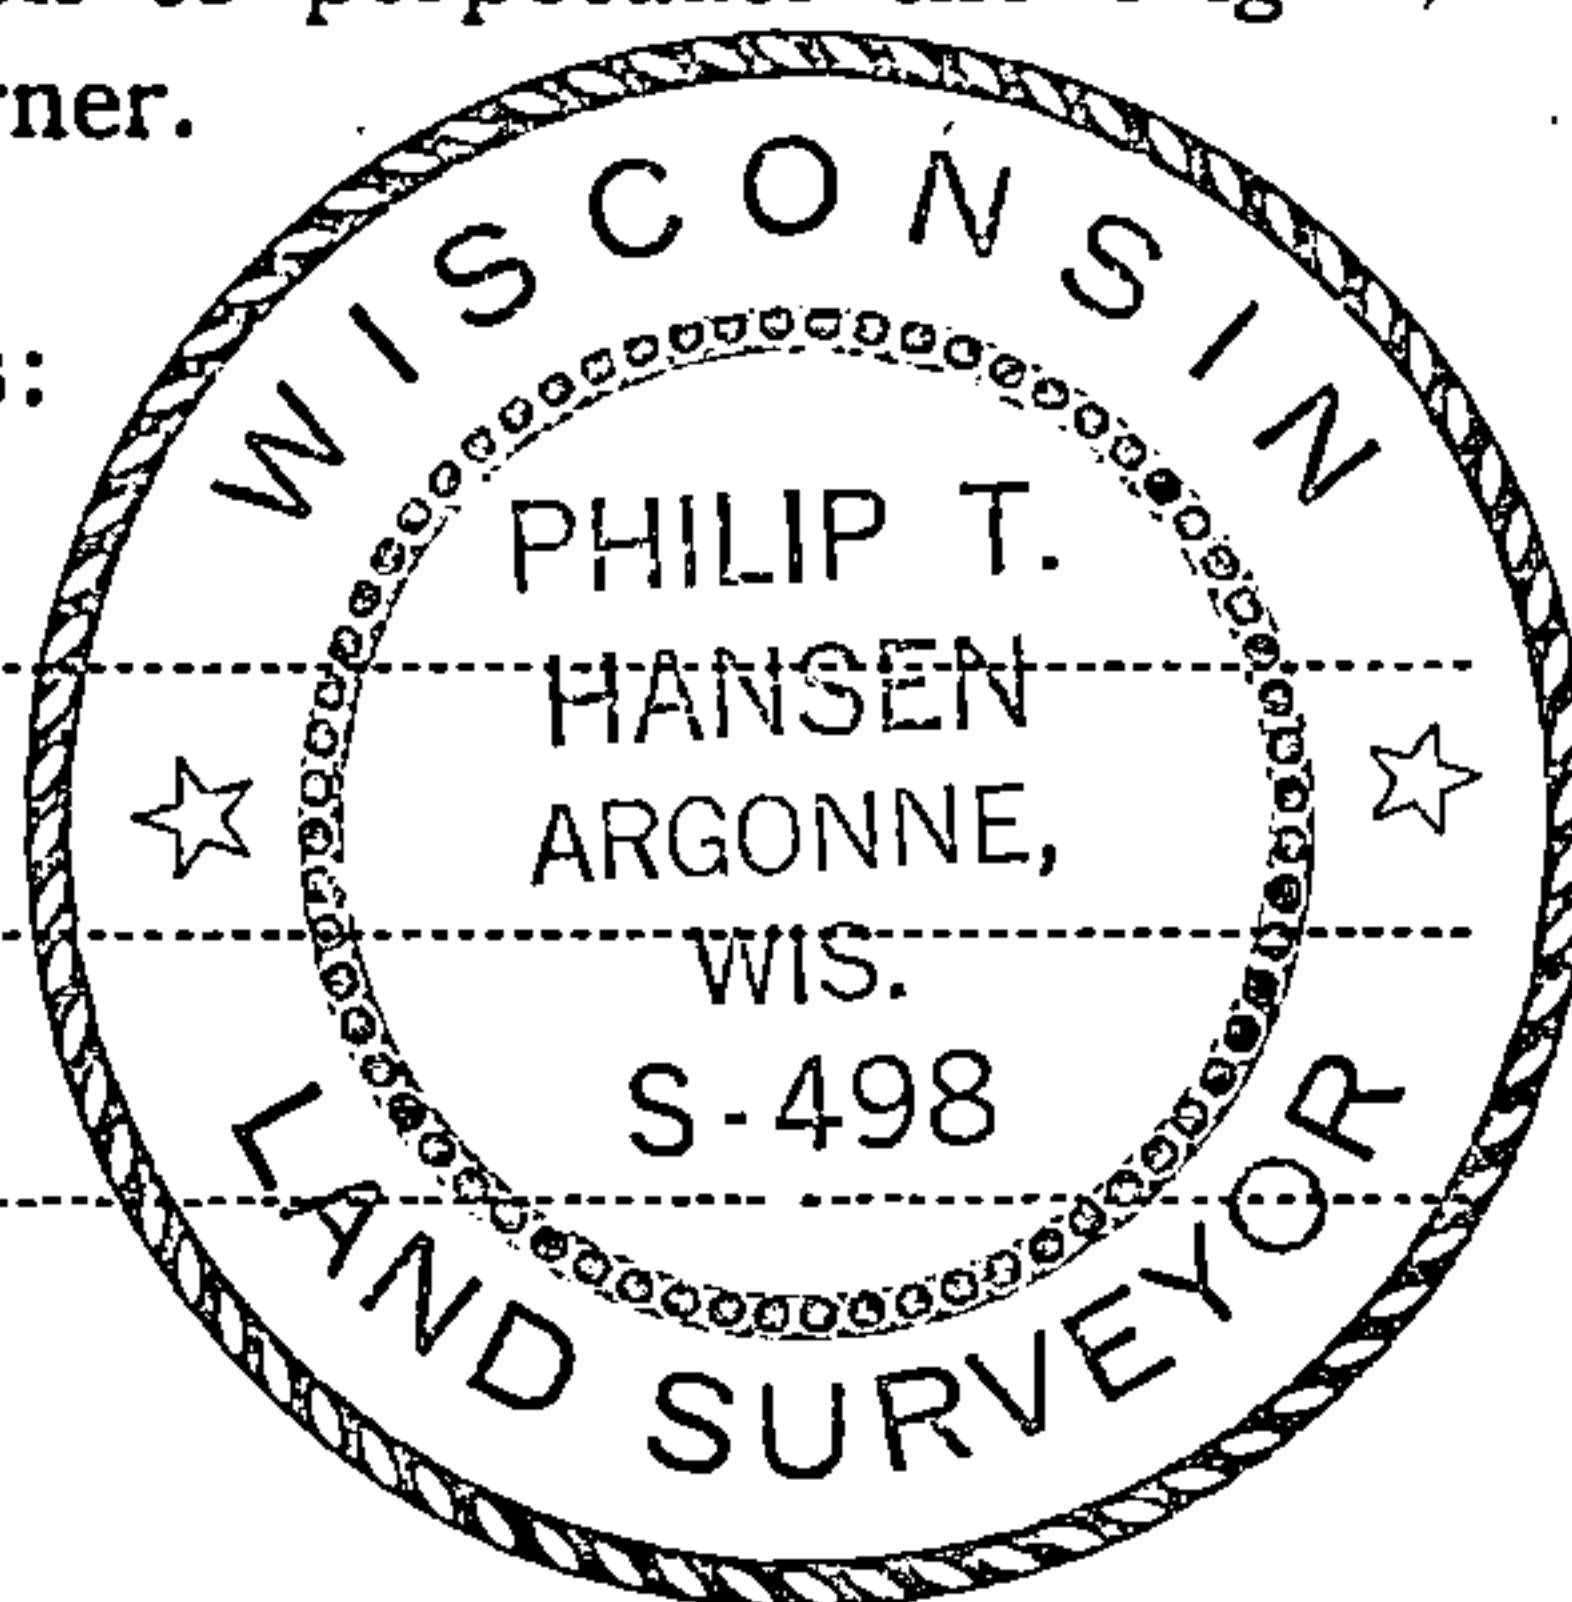

T35N R12E

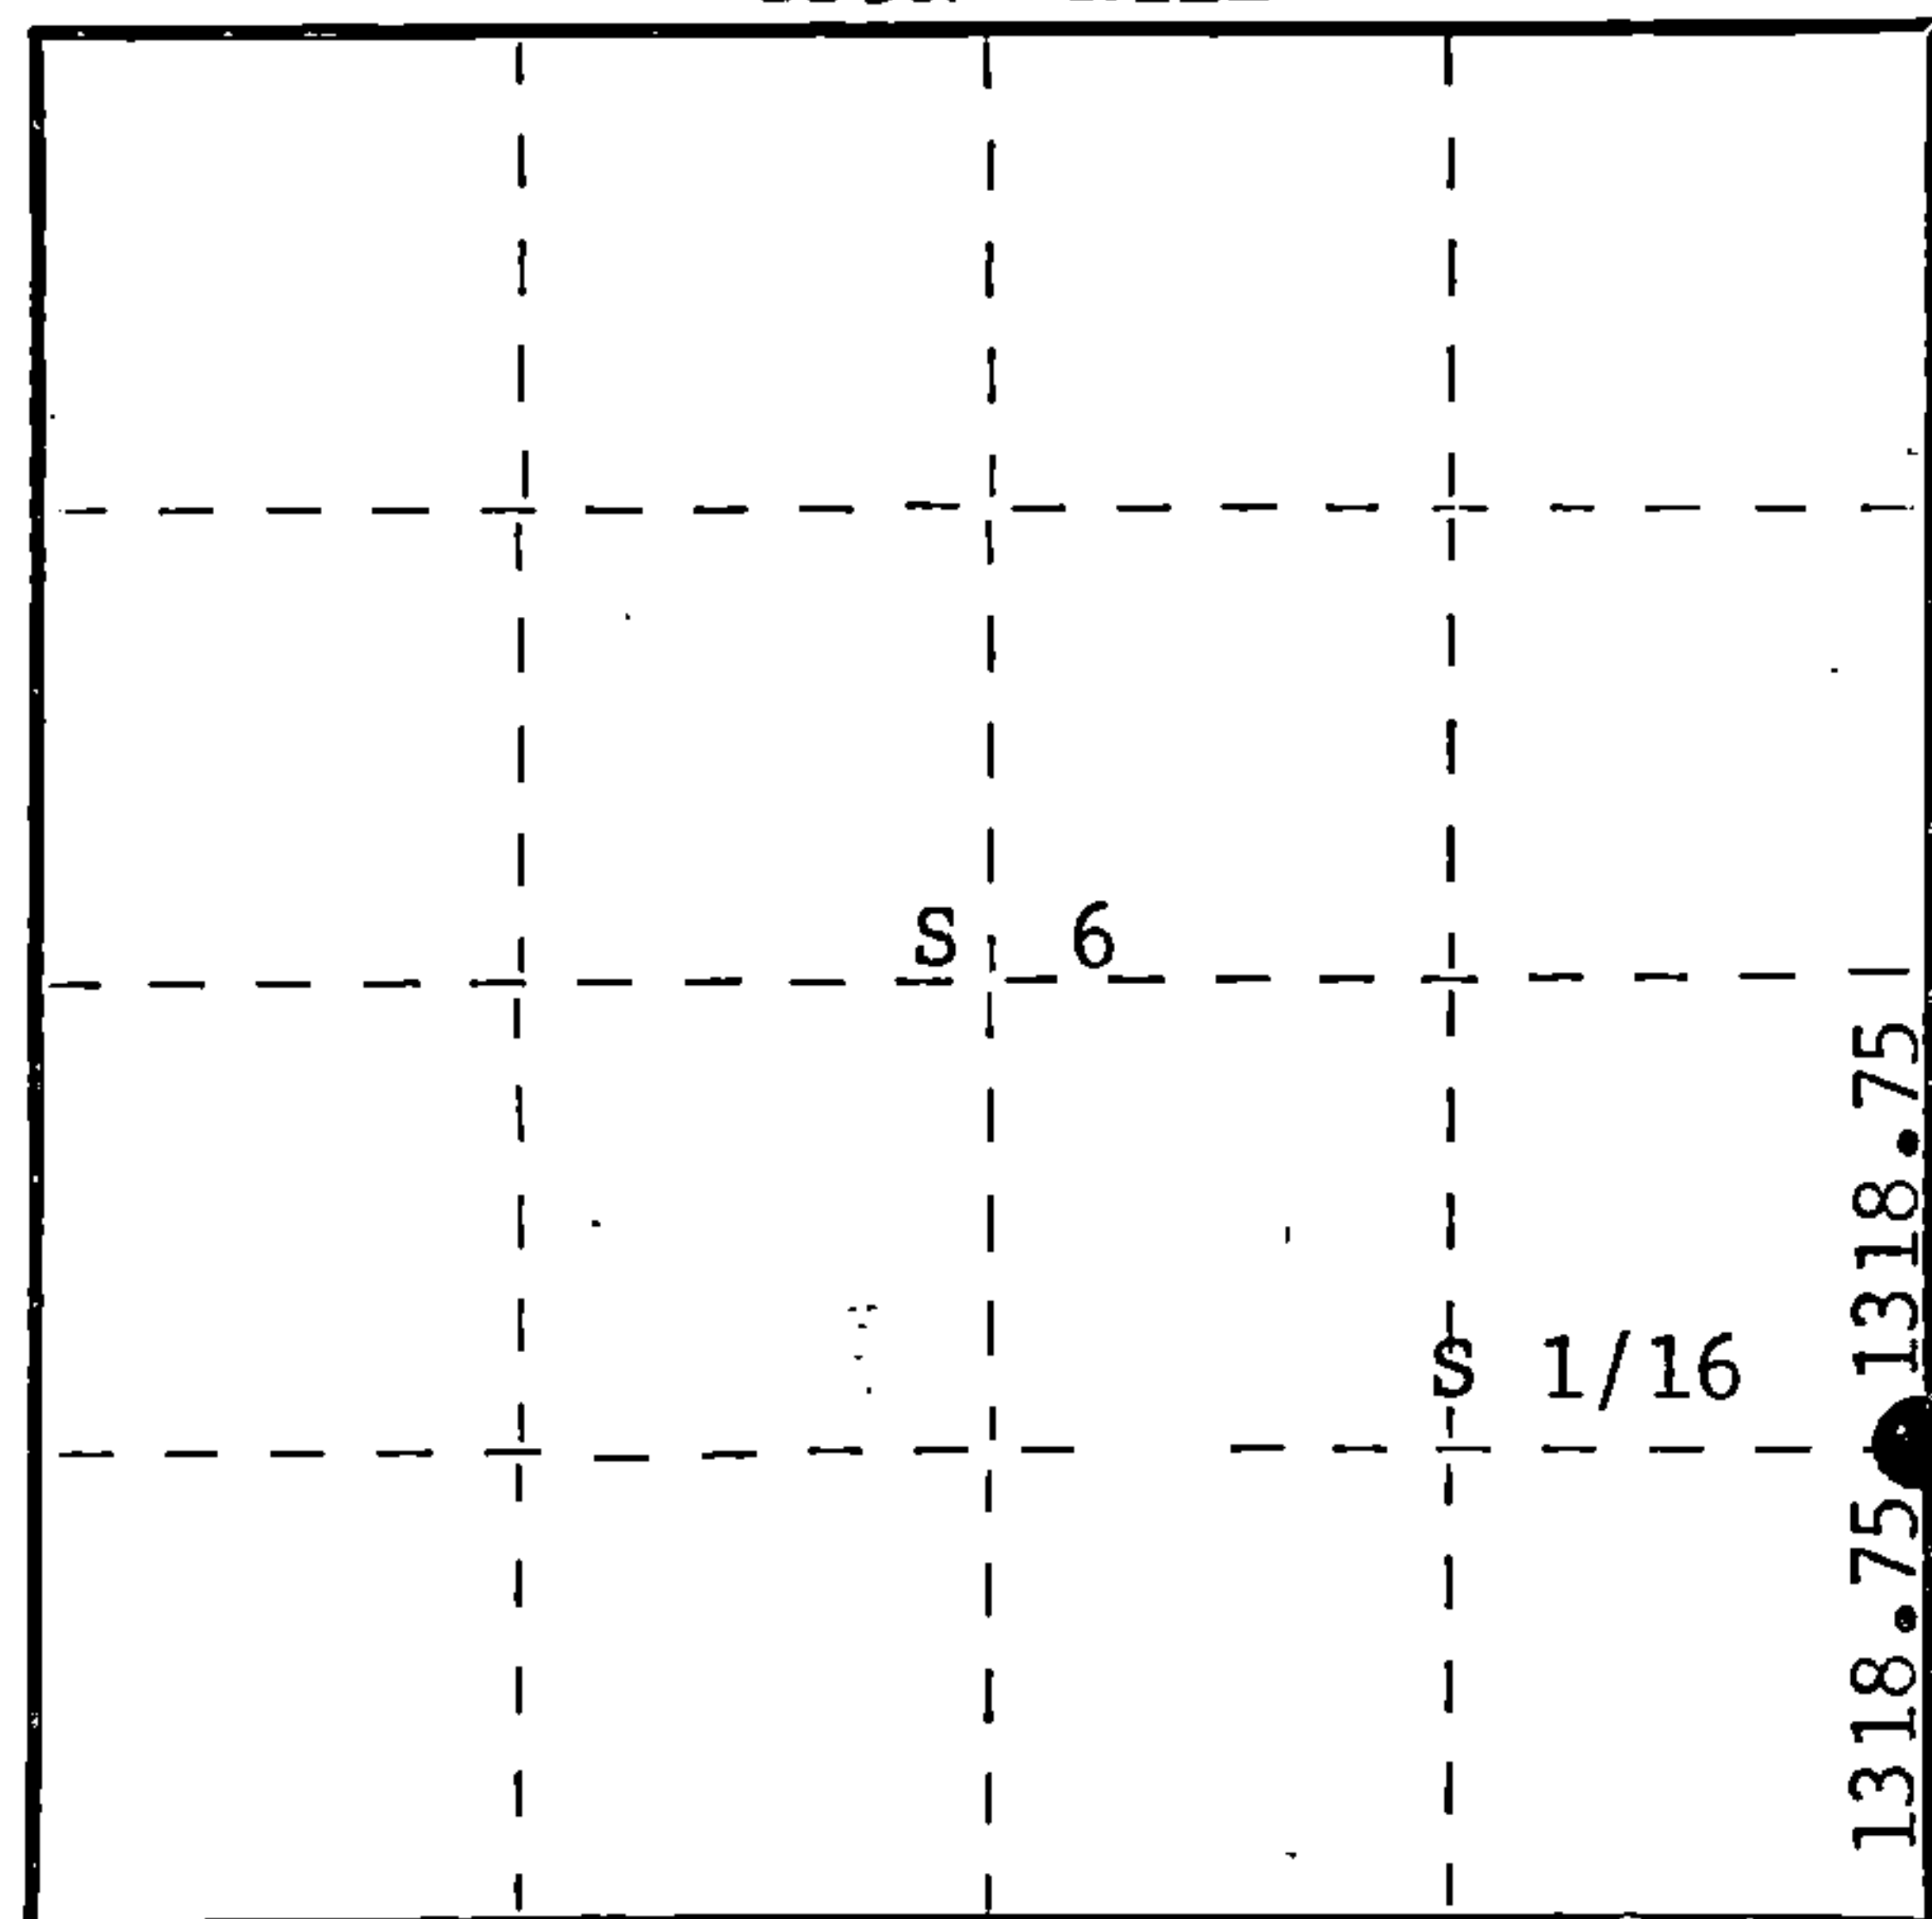

○ = Corner monument restored.

History of original corner establishment:
No records of any previous survey available.

Description of corner evidence found:

No evidence of Corner recovered. Found old fence line due east. Corner established by computed distance by traverse between Section Corner 5, 6, 7 and 8 north along section line road 2637.5 ft. to 1/4 corner, Section 5 & 6. Set Corner at 1318.75 ft. equidistant.

Description of monument and accessories I established to perpetuate the original location of this corner.

Set RR spike in Section Line road for true corner. Set 1 1/2" iron pipe with 2" brass cap for witness corner 50 links east. Cap stamped:

Monument projects 18" above ground.

Marked NBTs - Maple 7" S68°E, 112.6 links, scribed 1/16 BT.

Maple 6" S58°E, 97.7 links, scribed 1/16 BT.

Measurements and bearings made to true corner.

S498
T35N R12E
S 1/16 S6 | S5
W - 50 lks.
CPI-1976

Dated at Rhineland, Wis., this 2nd day of November, 19 76

Signature Philip T. Hansen Title Registered Land Surveyor Registration No. S-498
(County Surveyor, Registered Land Surveyor, or other duly authorized official)

Office of Register of Deeds, County of Forest, I hereby certify that the within instrument was filed in this office for record on the 9th day of November, 19 76 at 3:45 o'clock P. M.

Eugene Stutzman
(Register of Deeds)
By _____ Deputy

DOCUMENT NUMBER **110500**

FORM 985
Wisconsin Professional Land Surveyors
Milwaukee, Wisconsin

43512061000