

CERTIFIED LAND CORNER RESTORATION

Index No. B-5

State of Wisconsin }
County of Forest } ss.


I Philip T. Hansen, do hereby certify that on the 14th day of October, 1976, I ~~found~~ ^{established} evidence of the N 1/16 corner of Section 5 & 6 Township 35, North, Range 12 East, Fourth Principal Meridian, as described hereon; and that from this evidence I established a new monument and accessories as described hereon to perpetuate the original location of this corner.

Resident witnesses:


Glen Barker

Jim Claflin

Herb Wagoner

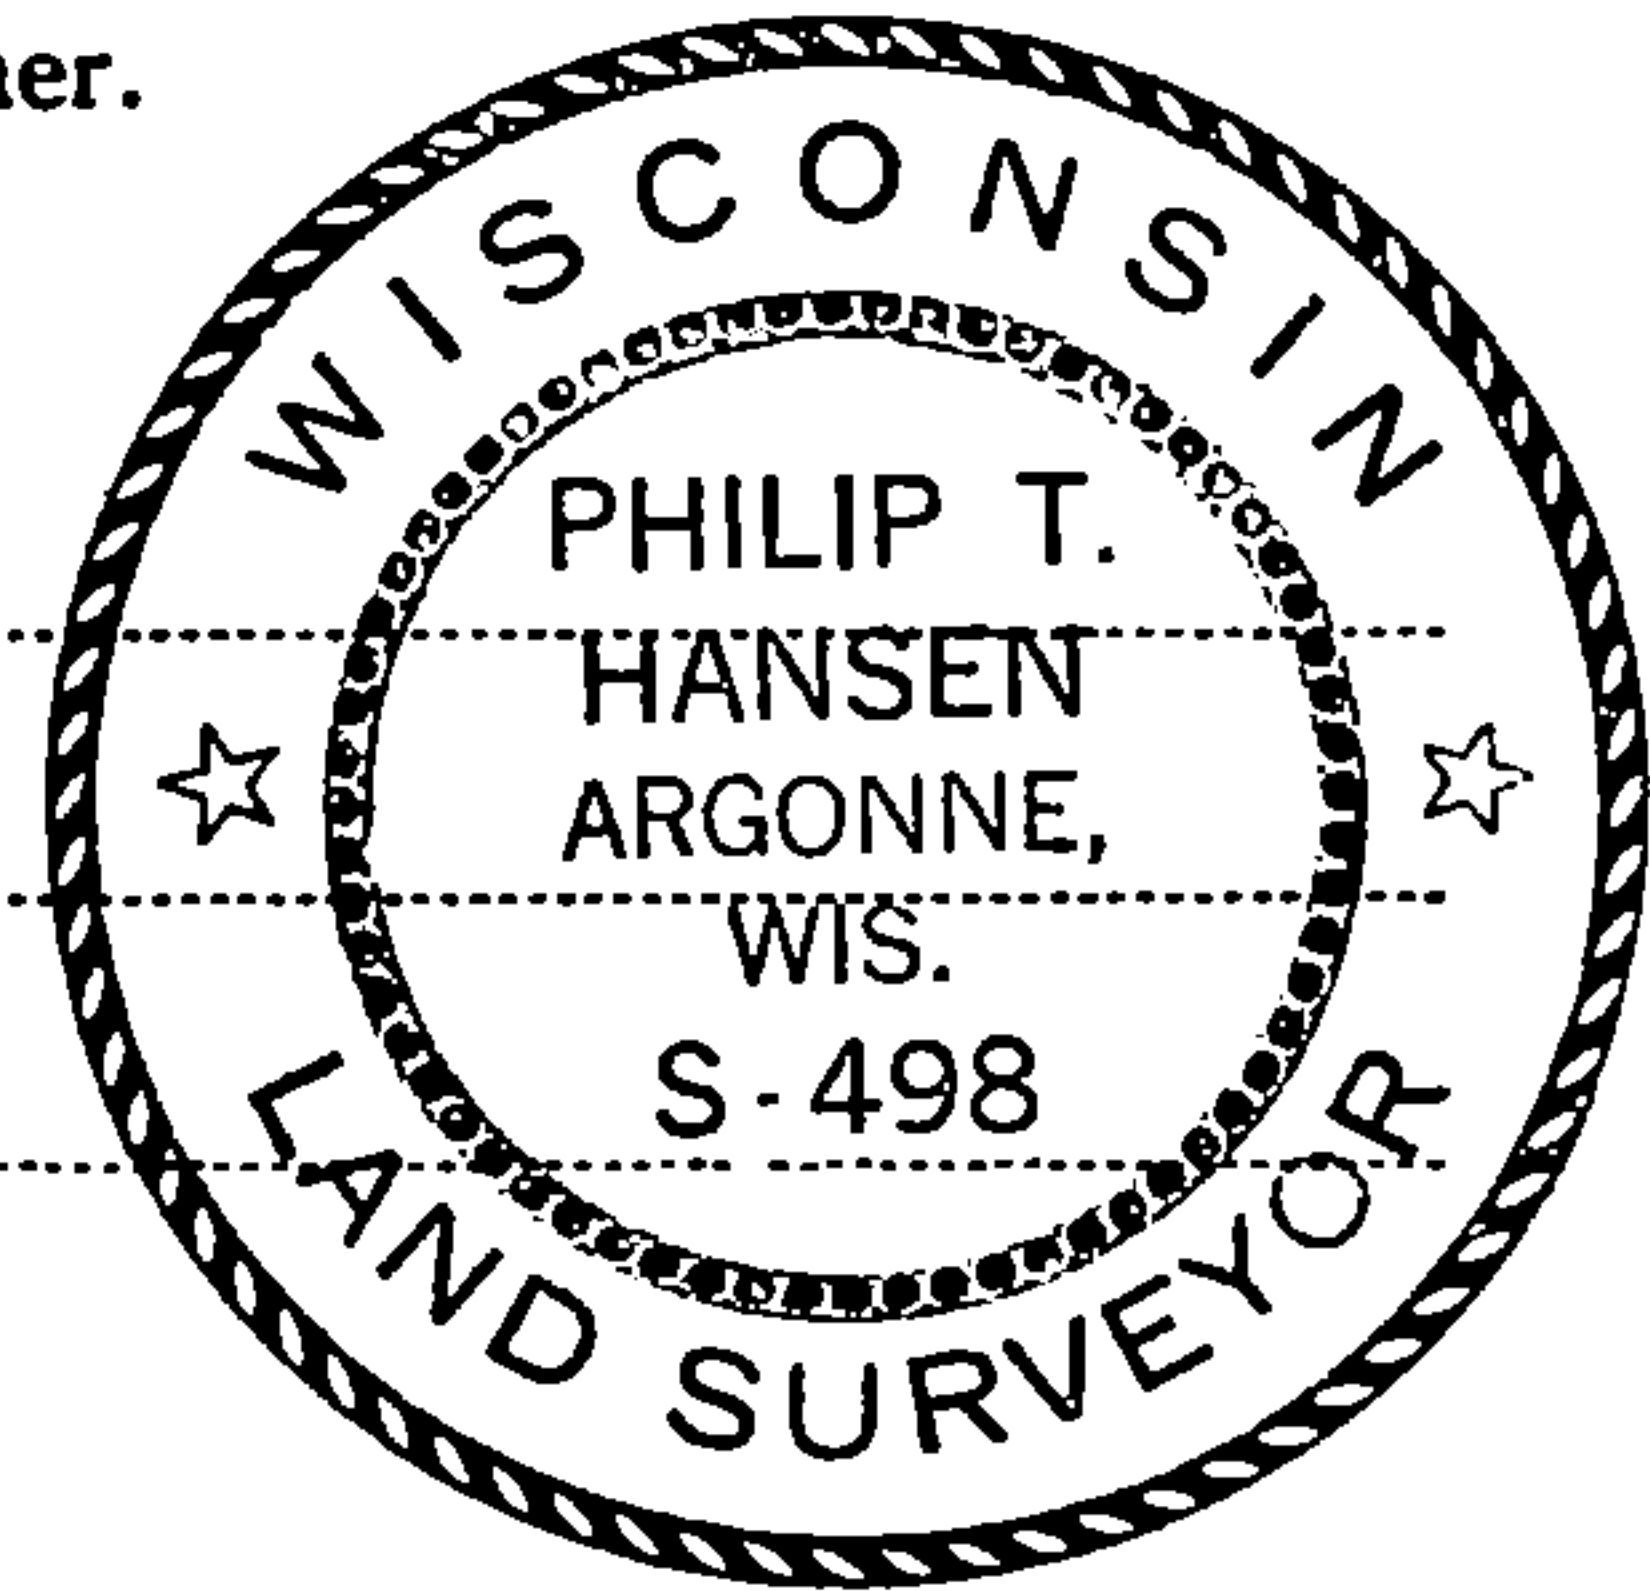

FORM 985
Wisconsin Planning & Surveying Co.
Madison, Wisconsin

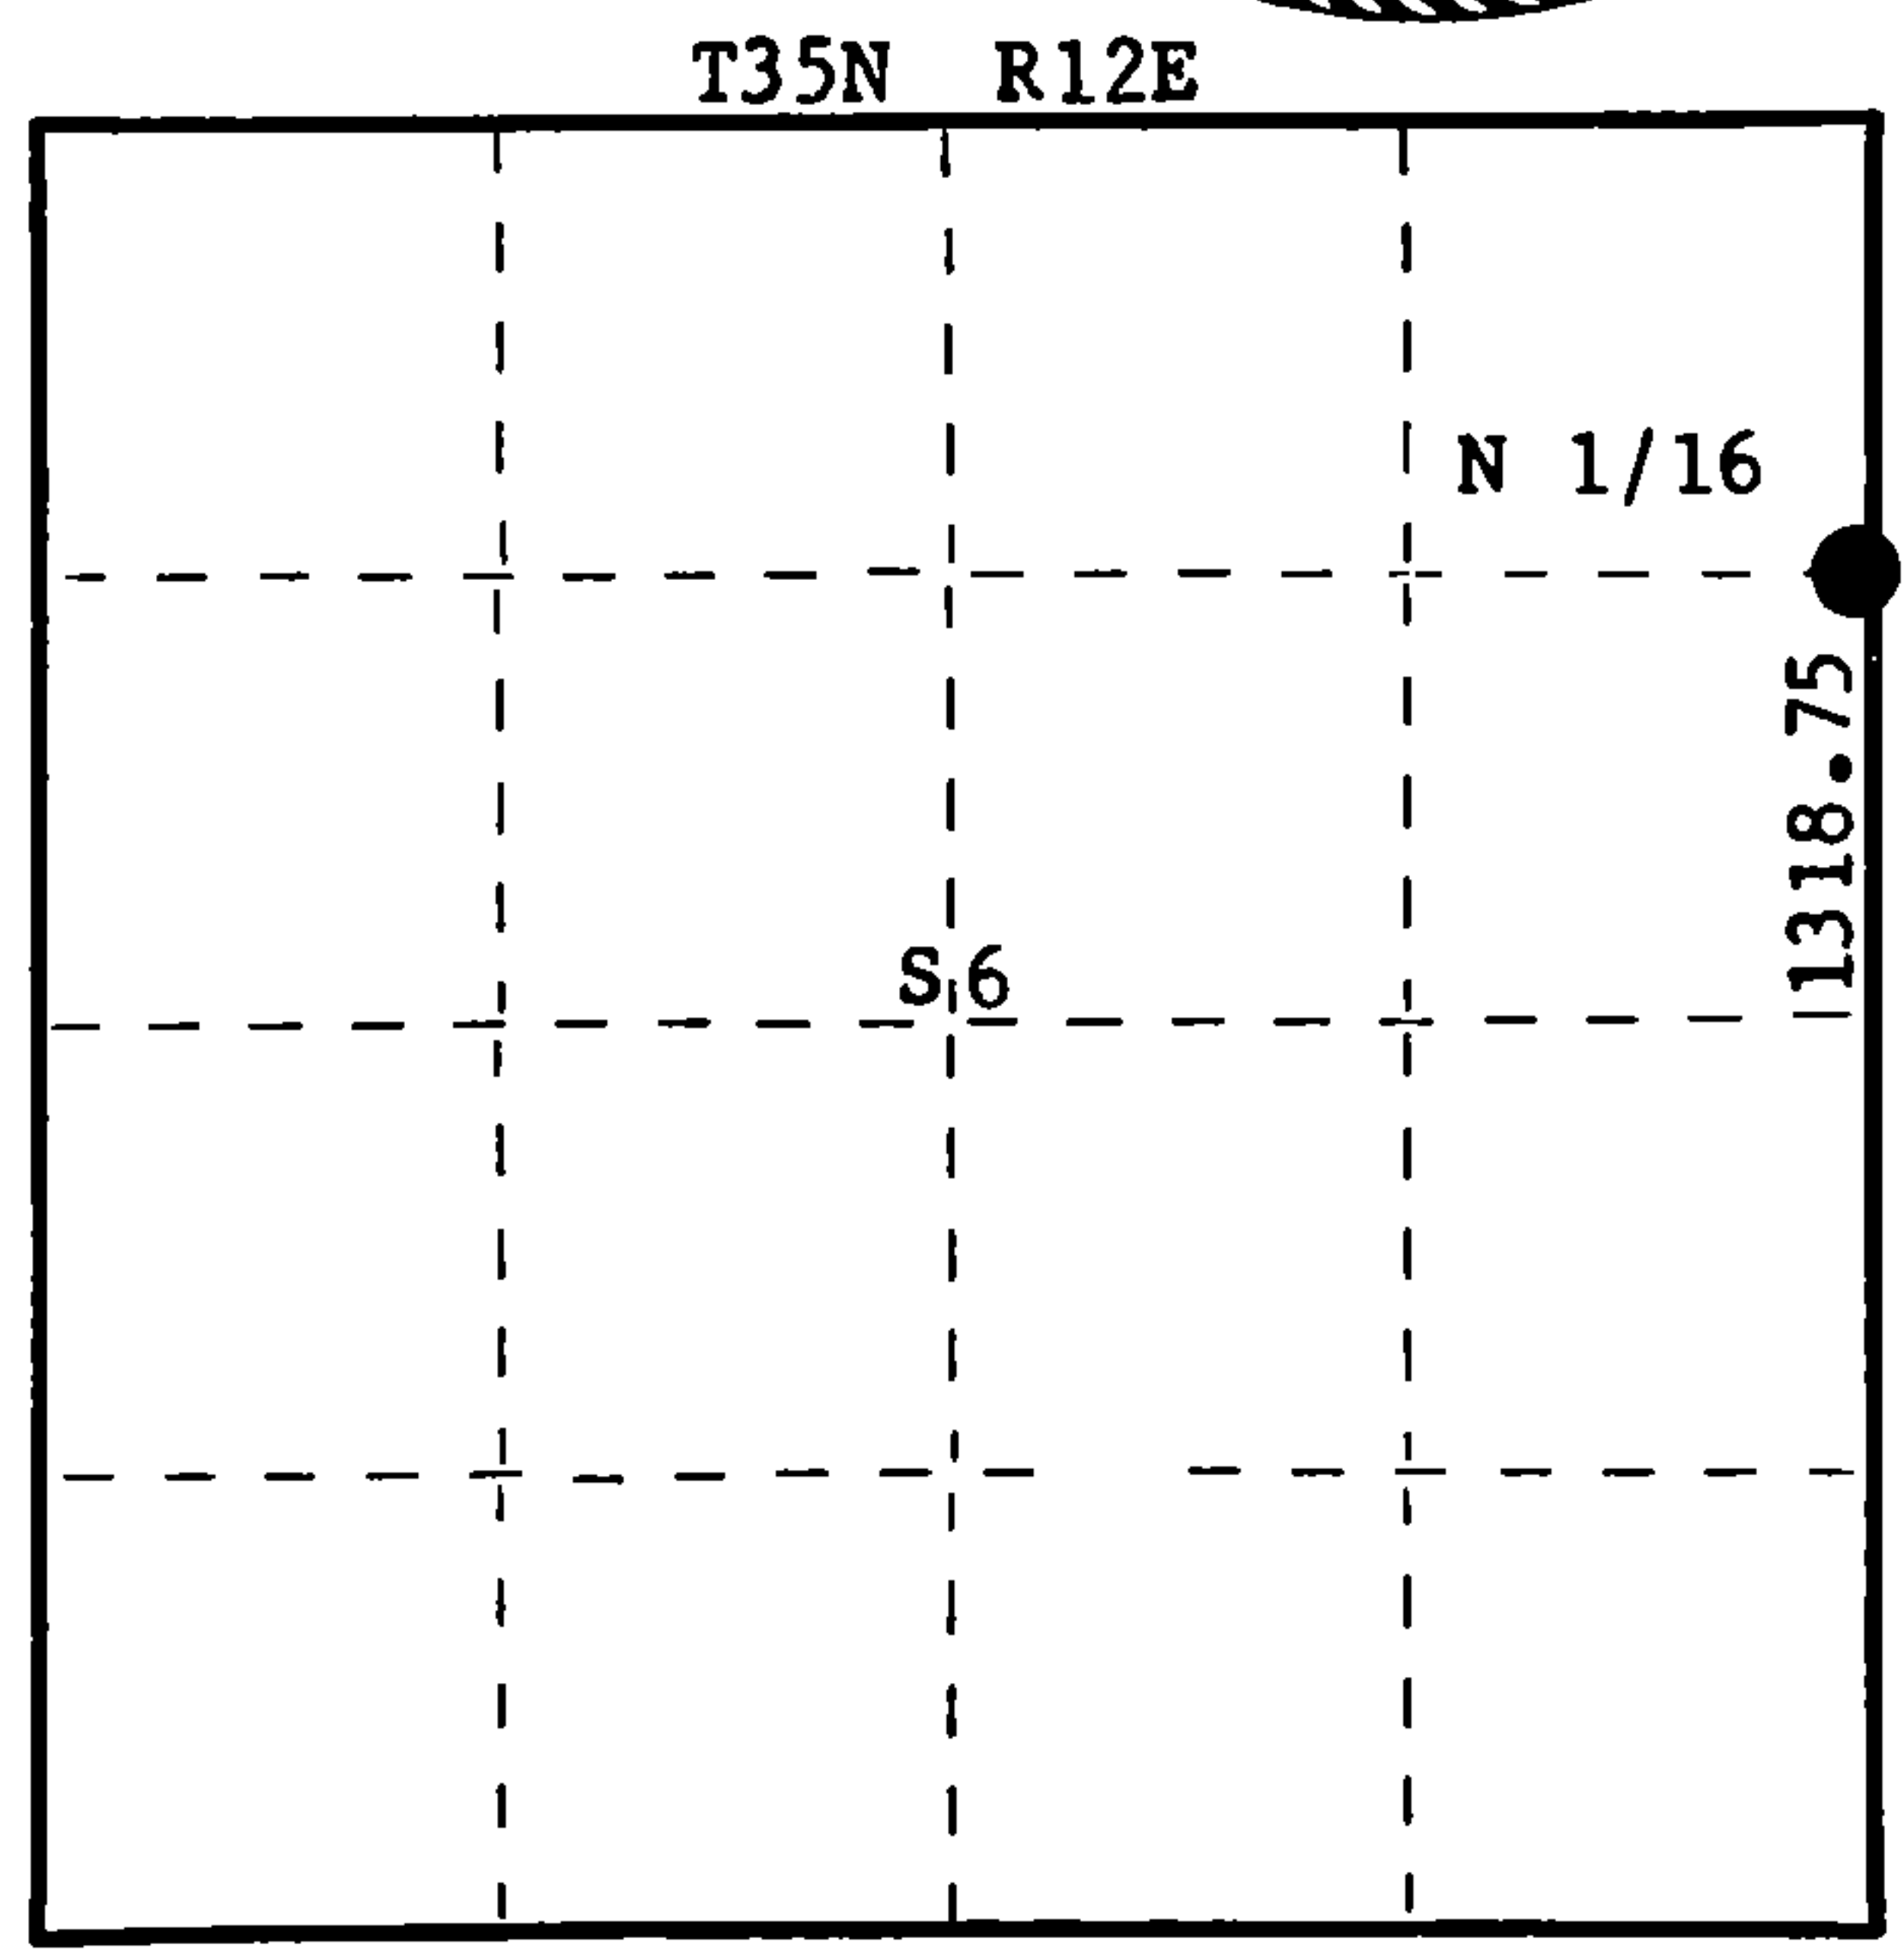

○ = Corner monument restored.

History of original corner establishment:
No evidence of records of any previous surveys.

Description of corner evidence found:
No evidence of any corner or BTs recovered.
From results of survey of traverse from section corner 5, 6, 7 and 8 to quarter corner at Section 5 & 6, computed total distance of 2637.50 ft. at N 1° 47' 26" W.
Set N 1/16 at 1318.75 ft. North of 1/4 corner on same bearing.

Description of monument and accessories I established to perpetuate the original location of this corner.
Drove RR spike in bed of town road for true corner, S 1° 47' 26" E, 957.277' (14.504 chs.) from section corner 5, 6, 31, 32.
Set 1½" iron pipe with brass cap 60 links west of true corner, cap stamped:
NBTs - Sugar 8" N77°W, 66.4 links, scribed 1/16 BT.
Sugar 6" S49°W, 80.7 links, scribed 1/16 BT.
Measurements and bearings to true corner.

S498
T35N R12E
N 1/16 6 | 5
E - 60 lks.
CPI - 1976

Dated at Rhineland, Wis., this 2nd day of November, 1977.

Signature Philip T. Hansen Title Registered Land Surveyor Registration No. S-498
(County Surveyor, Registered Land Surveyor, or other duly authorized official)

Office of Register of Deeds, County of Forest, I hereby certify that the within instrument was filed in this office for record on the 9th day of November, 1976 at 3:45 o'clock P. M.

Eugene Staszny
(Register of Deeds)
By _____ Deputy

DOCUMENT NUMBER **110499**

43512.063000