

CERTIFIED LAND CORNER RESTORATION

Index No. G-5


State of Wisconsin }
County of Forest } ss.

I Philip T. Hansen, do hereby certify that on the 17th day of June, 1977, I found evidence of the Quarter corner of Section 7 & 8 Township 35, North, Range 12 East, Fourth Principal Meridian, as described hereon; and that from this evidence I established a new monument and accessories as described hereon to perpetuate the original location of this corner.


Resident witnesses:

Glen Barker

Herb Wagoner

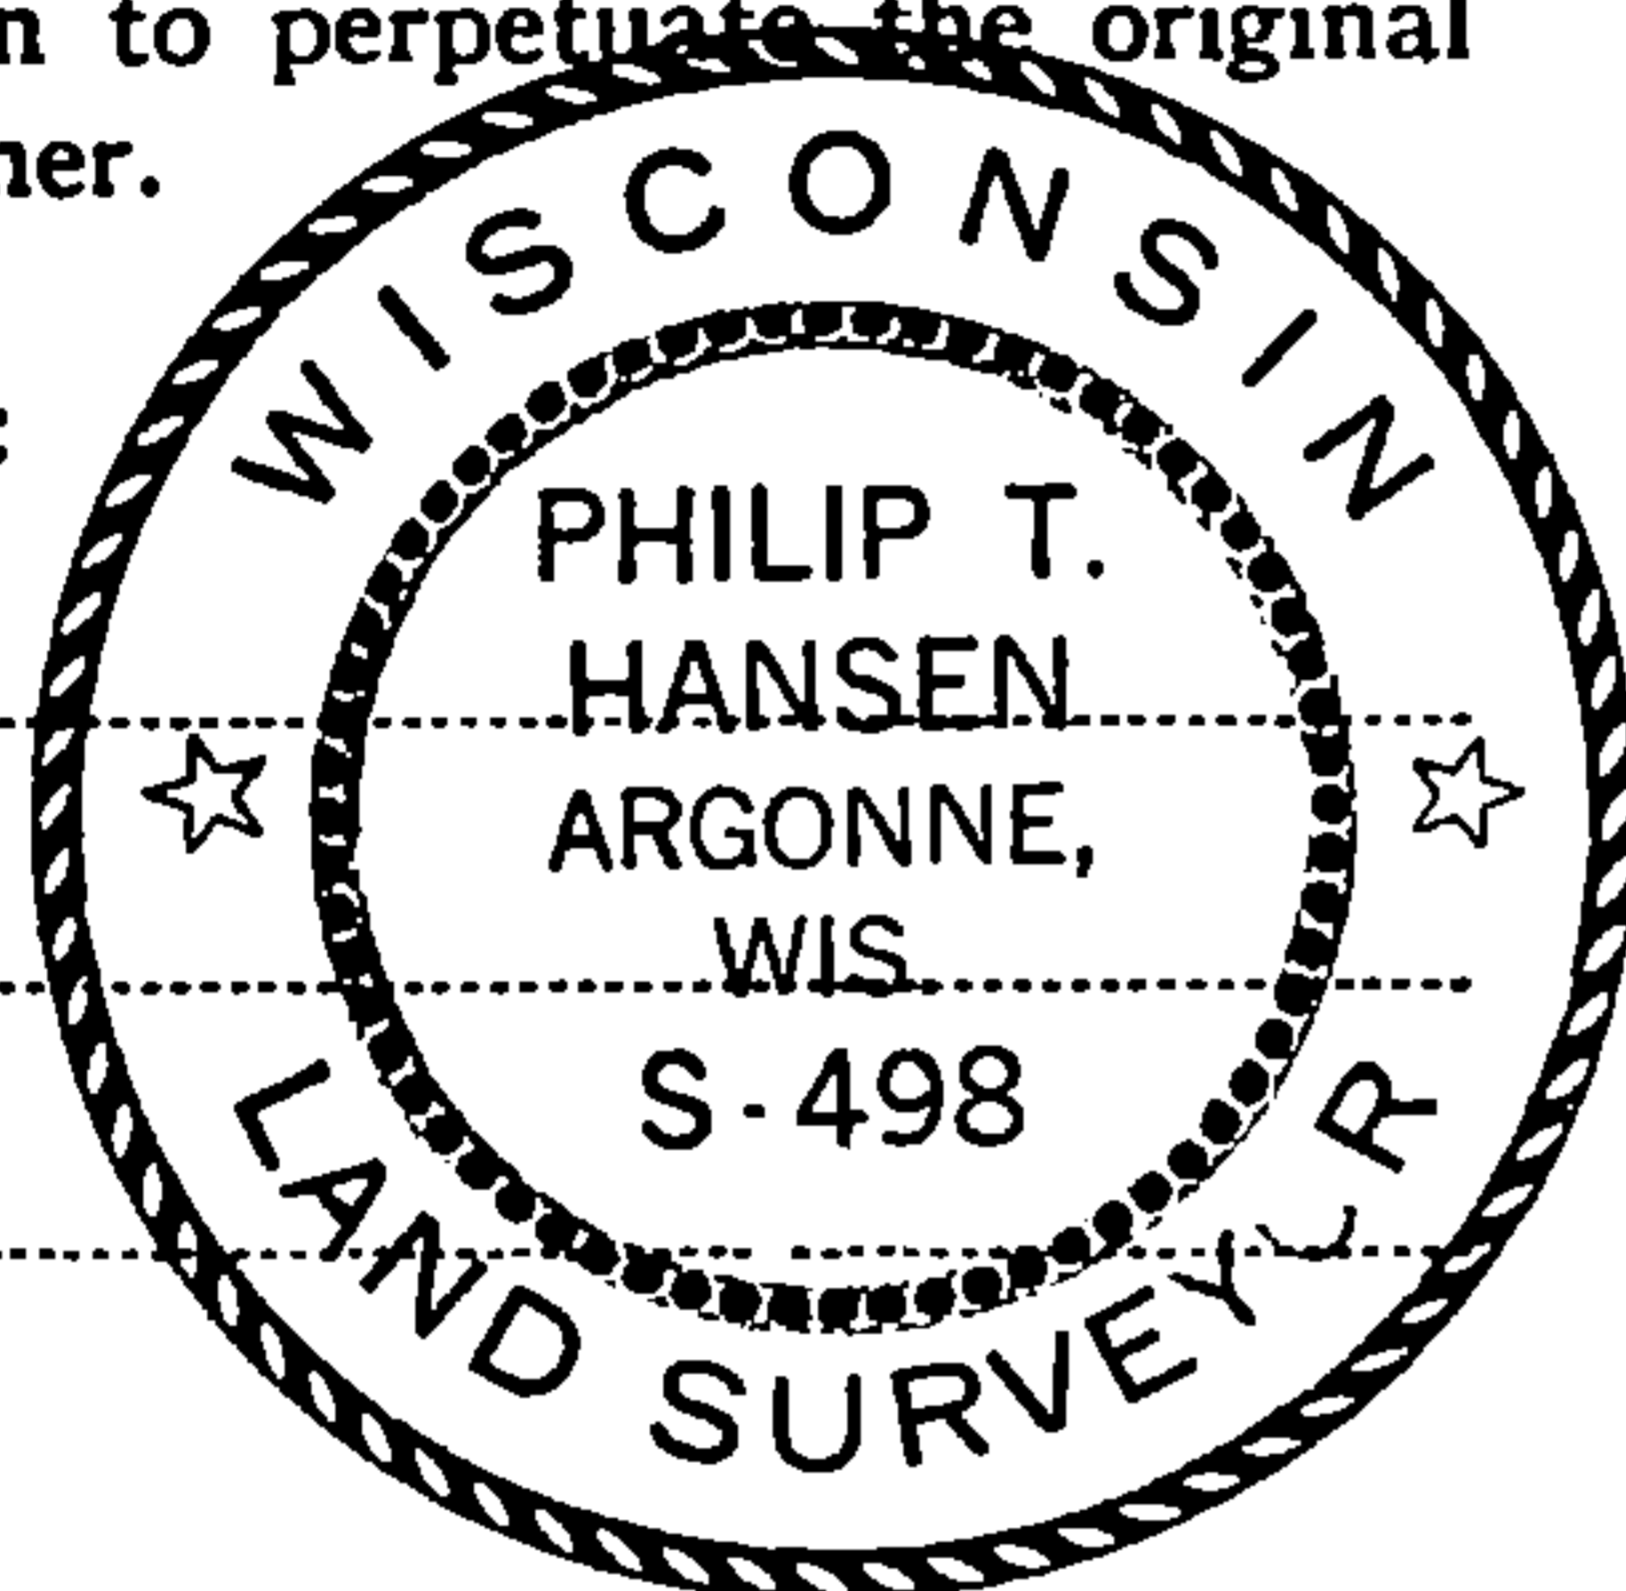

FORM 985

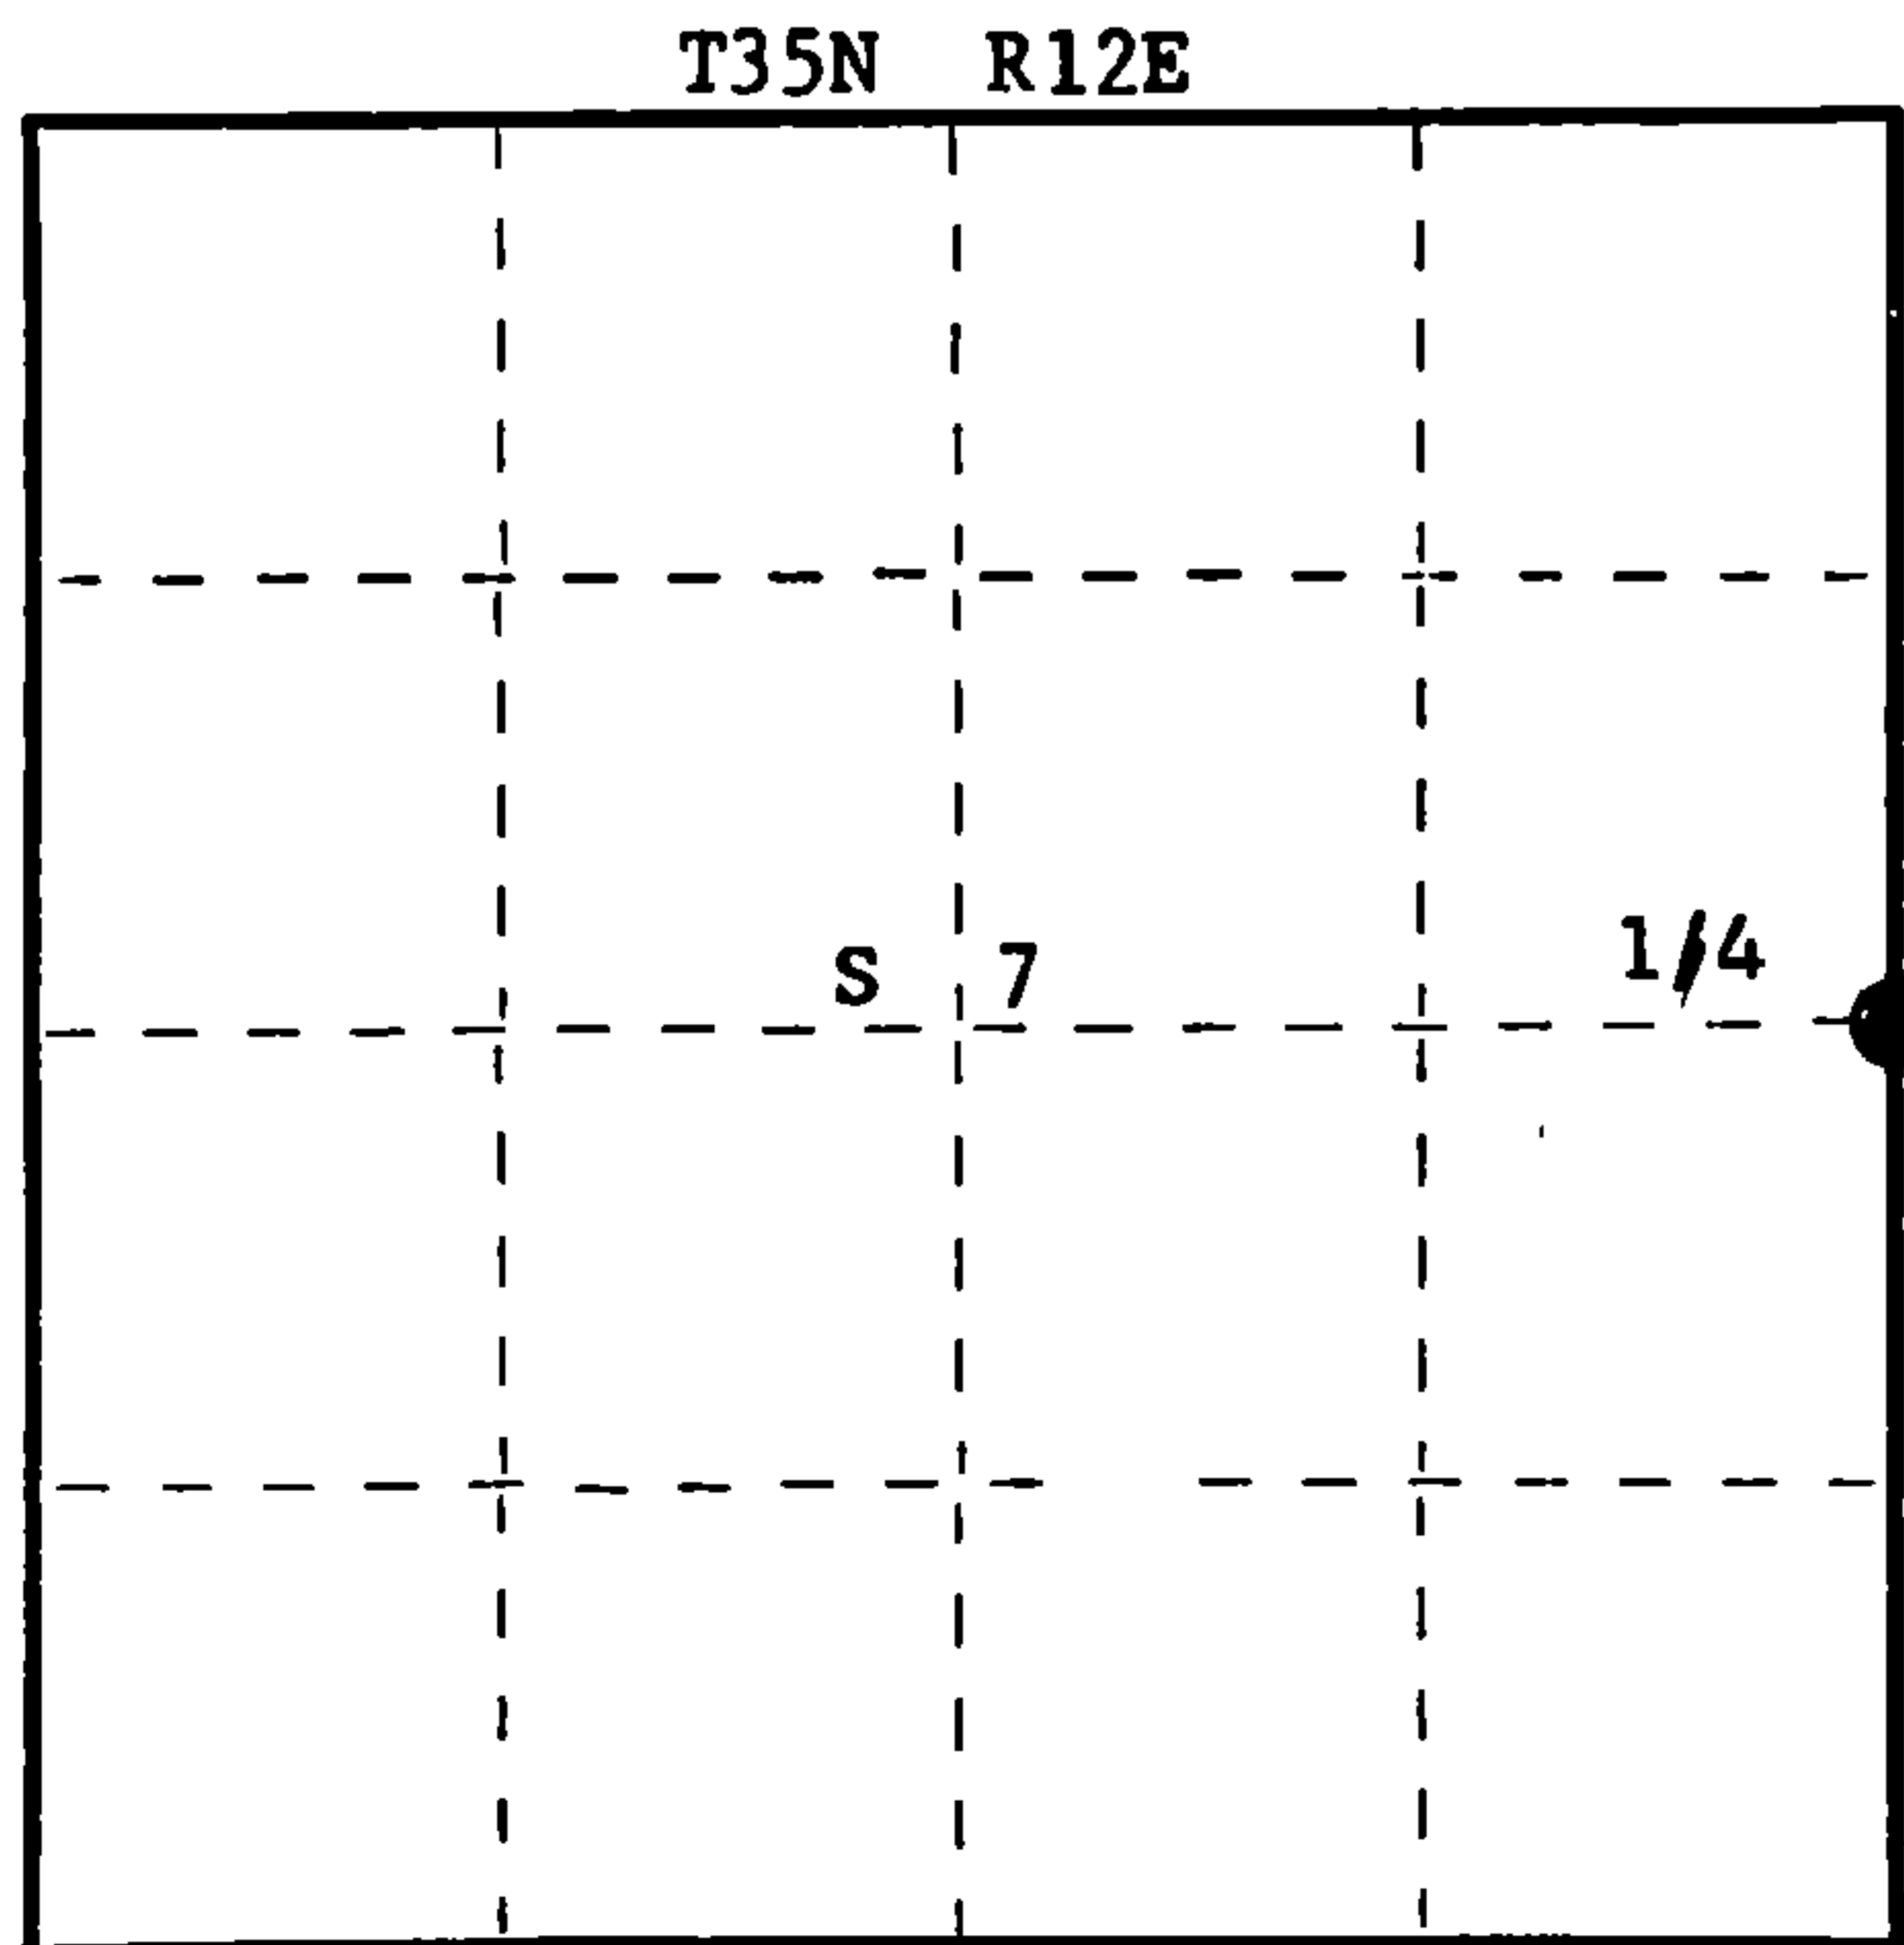

○ = Corner monument restored.

History of original corner establishment:

Corner established by J.L. Nowlin, Deputy Surveyor, in 1860, from which Sugar 15" bears S75°W, 6 links; Birch 8" N42°E, 22 links. No records of any subsequent survey.

Description of corner evidence found:

Recovered fence line running west from Cole Road, accepted the intersection of centerline of Cole Road with extended fence line east as the true corner for 1/4 corner. No evidence of any BTs, having been destroyed by road construction.

Description of monument and accessories I established to perpetuate the original location of this corner.

Set R.R. spike in centerline of Cole Road with fence line west for true corner. Set 2 1/2" Berntsen A-1 Federal Monument for witness corner 60 links east, stamped: Monument projects 18" above ground.

Marked NBTs - Sugar 8" S86°E, 62 links, scribed 1/4 BT.
Sugar 5" N36°E, 107.8 links, scribed 1/4 BT.
BO - Sign post (Cole & Tower Rd.) S8°E, 179.8 lks.

T35N R12E
1/4 7/8 W.C.

W - 60 lks to Cor.
S498 - 1977

Dated at Rhineland, Wis., this 20th day of June, 1977.

Signature Philip T. Hansen Title Registered Land Surveyor Registration No. S-498
(County Surveyor, Registered Land Surveyor, or other duly authorized official)

Office of Register of Deeds, County of Forest, I hereby certify that the within instrument was filed in this office for record on the 6th day of July, 1977 at 3:30 o'clock P. M.

Eugene Stutzman
(Register of Deeds)

By _____ Deputy

DOCUMENT NUMBER
111821

43512072000