

CERTIFIED LAND CORNER RESTORATION

Index No. G-9


State of Wisconsin }
County of Forest } ss.

I Philip T. Hansen, do hereby certify that on the 17th day of June, 1977, I found evidence of the Quarter corner of Section 8 & 9 Township 35, North, Range 12 East, Fourth Principal Meridian, as described hereon; and that from this evidence I established a new monument and accessories as described hereon to perpetuate the original location of this corner.


Resident witnesses:

Glen Barker

Herb Wagoner

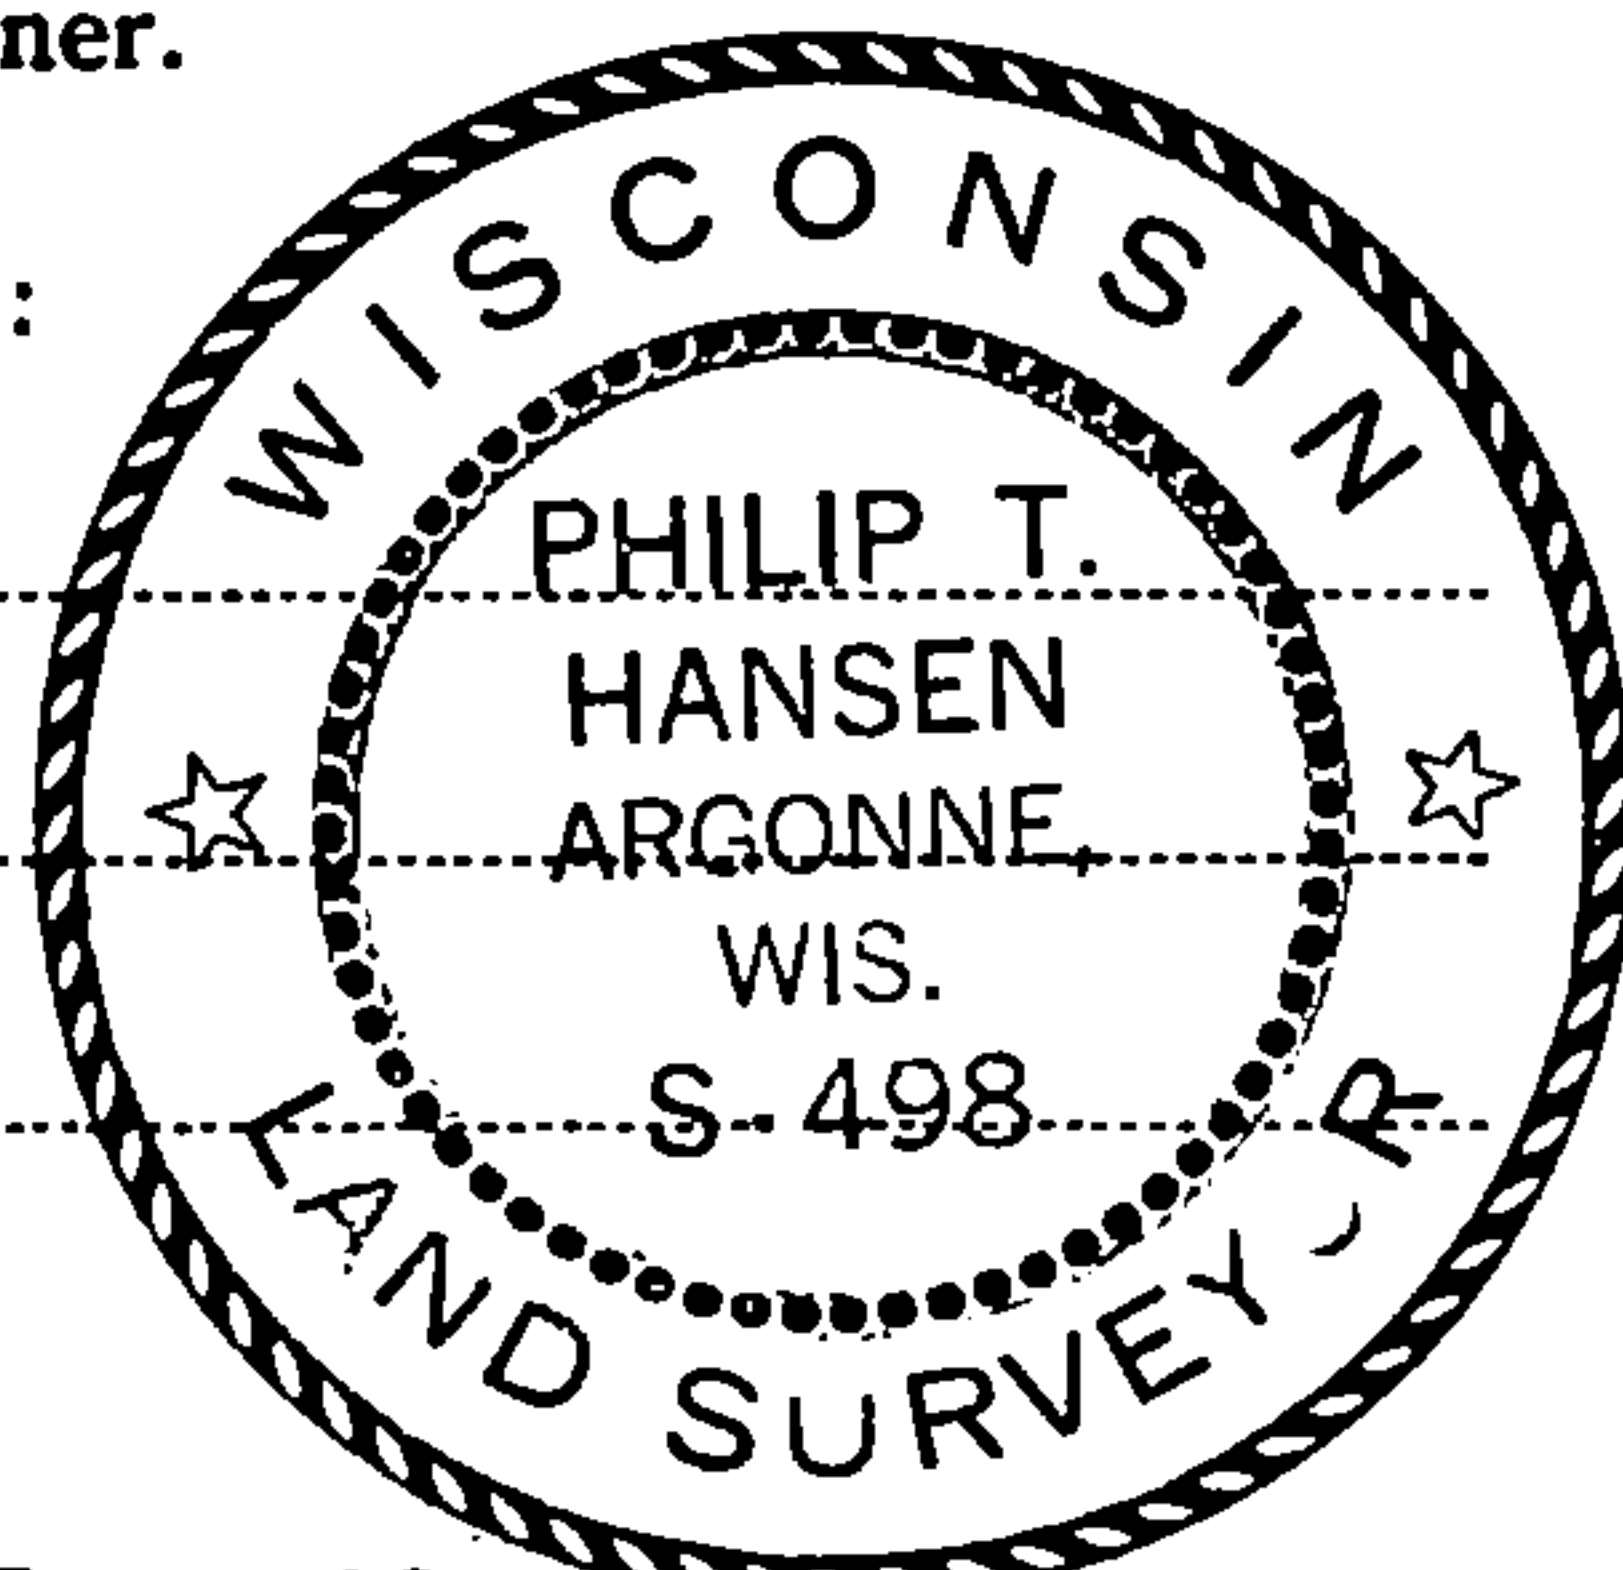

FORM 985 Wisconsin Planning & Surveying Co. Milwaukee, Wisconsin

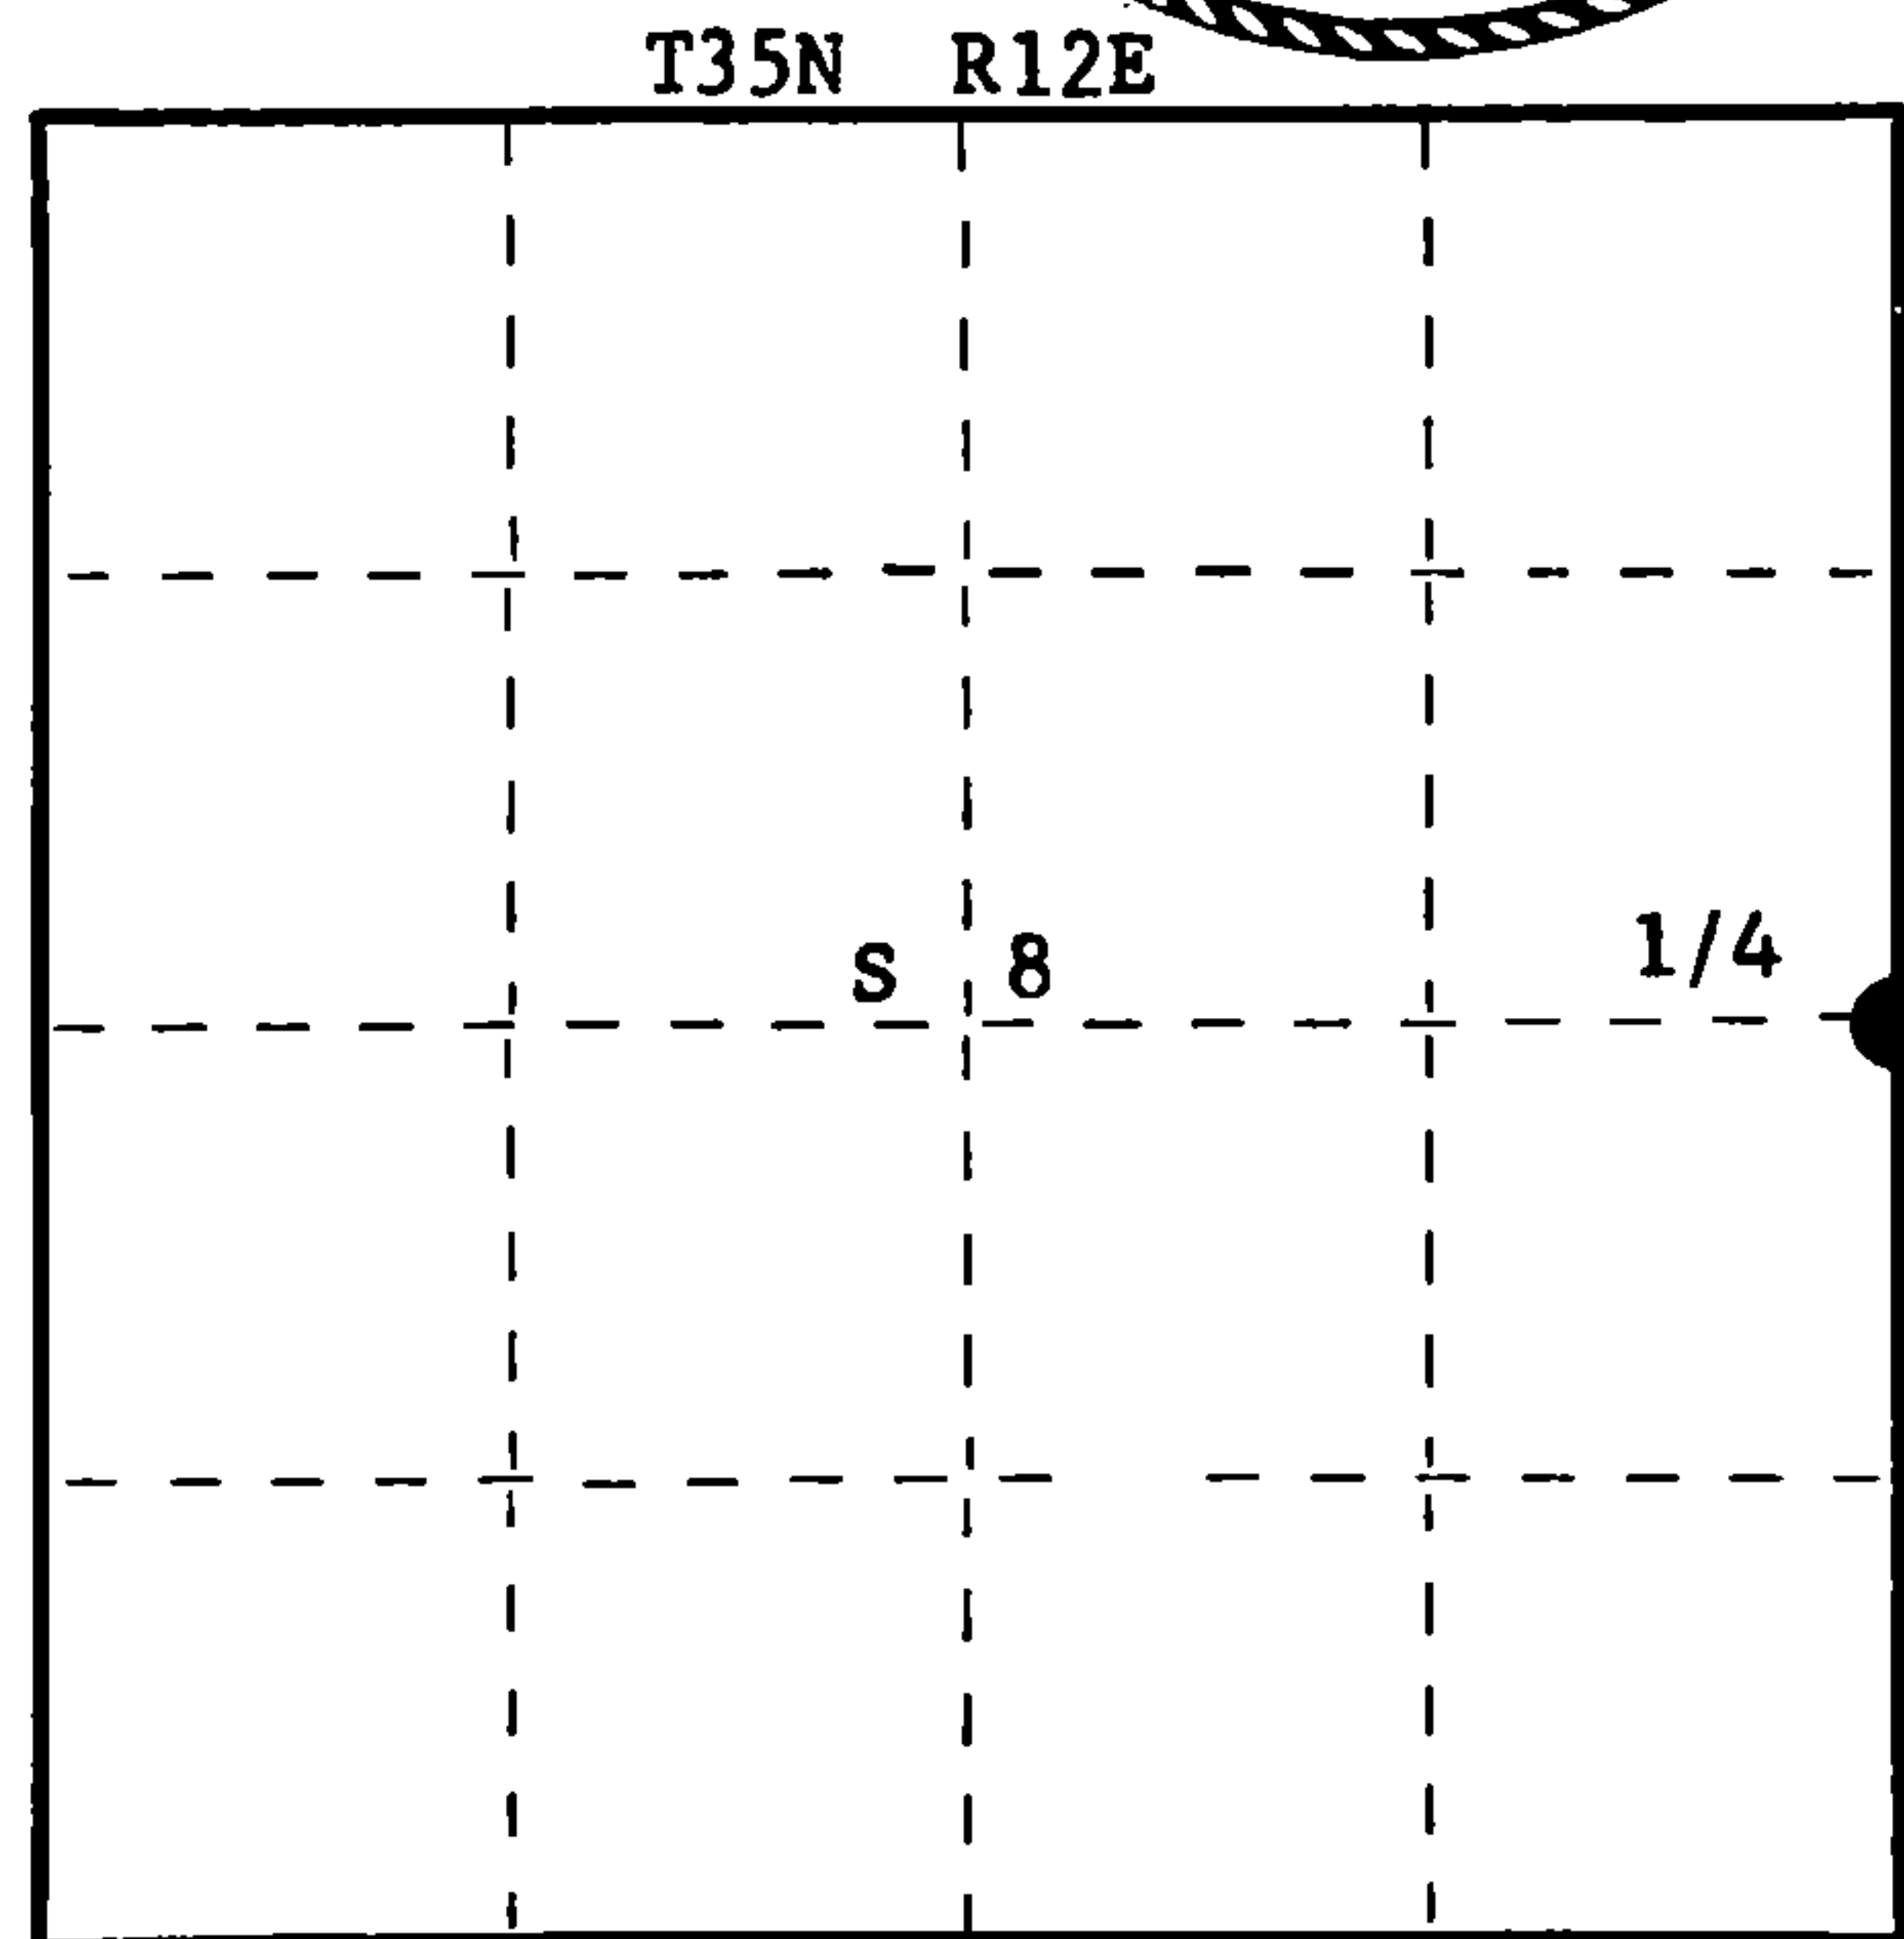

○ = Corner monument restored.

History of original corner establishment:

Corner established by J.L. Nowlin, Deputy Surveyor, in 1960, from which Sugar 8" bears N 24°E, 15 links; Lind 12" bears S77°W, 25 links. No records on any subsequent survey.

Description of corner evidence found:

Recovered very old 3" squared cedar post, scribed 1/4 S8 1/4 S9, leaning against a 14" Sugar Maple which sets in fence line N & S and to the South. Recovered pieces of old point at fence corner.

No evidence of any BTs.

Charles Robison, born and raised on adjoining farm had witnessed this corner standing about 3 ft. east of the Sugar Maple for many years.

Description of monument and accessories I established to perpetuate the original location of this corner.

Set 2 1/2" Berntsen A-1 Federal Monument, aluminum with magnet installed in cap and base in old location where remnants of old point were found. Cap stamped:

Monument projects 12" above ground.

Marked NBTs - Sugar 18" N50°W, 29.8 links, scribed 1/4 BT.
Sugar 10" S2°E, 46 links, scribed 1/4 BT.
Sugar 6" S34°E, 70.8 links, scribed 1/4 BT.

T35N R12E
1/4 S8 | S9
S498-1977

Dated at Rhineland, Wis., this 20th day of June, 1977.

Signature Philip T. Hansen Title Registered Land Surveyor Registration No. S-498
(County Surveyor, Registered Land Surveyor, or other duly authorized official)

Office of Register of Deeds, County of Forest, I hereby certify that the within instrument was filed in this office for record on the 6th day of July, 1977 at 3:30 o'clock P. M.

Eugene Staszny
(Register of Deeds)

By _____ Deputy

DOCUMENT NUMBER
111822

43512082000