

CERTIFIED LAND CORNER RESTORATION

Index No. G - 11


State of Wisconsin }
County of Forest } ss.

I Thomas R. Arnott, do hereby certify that on the 17th day of September, 1975, I found evidence of the 1/4 corner of sections 7 & 12 Township 35, North, Range 12 - 13 E, Fourth Principal Meridian, as described hereon; and that from this evidence I established a new monument and accessories as described hereon to perpetuate the original location of this corner.

Resident witnesses:

Herbert Wagoner

FORM 985 H. C. MILLER CO., MILWAUKEE

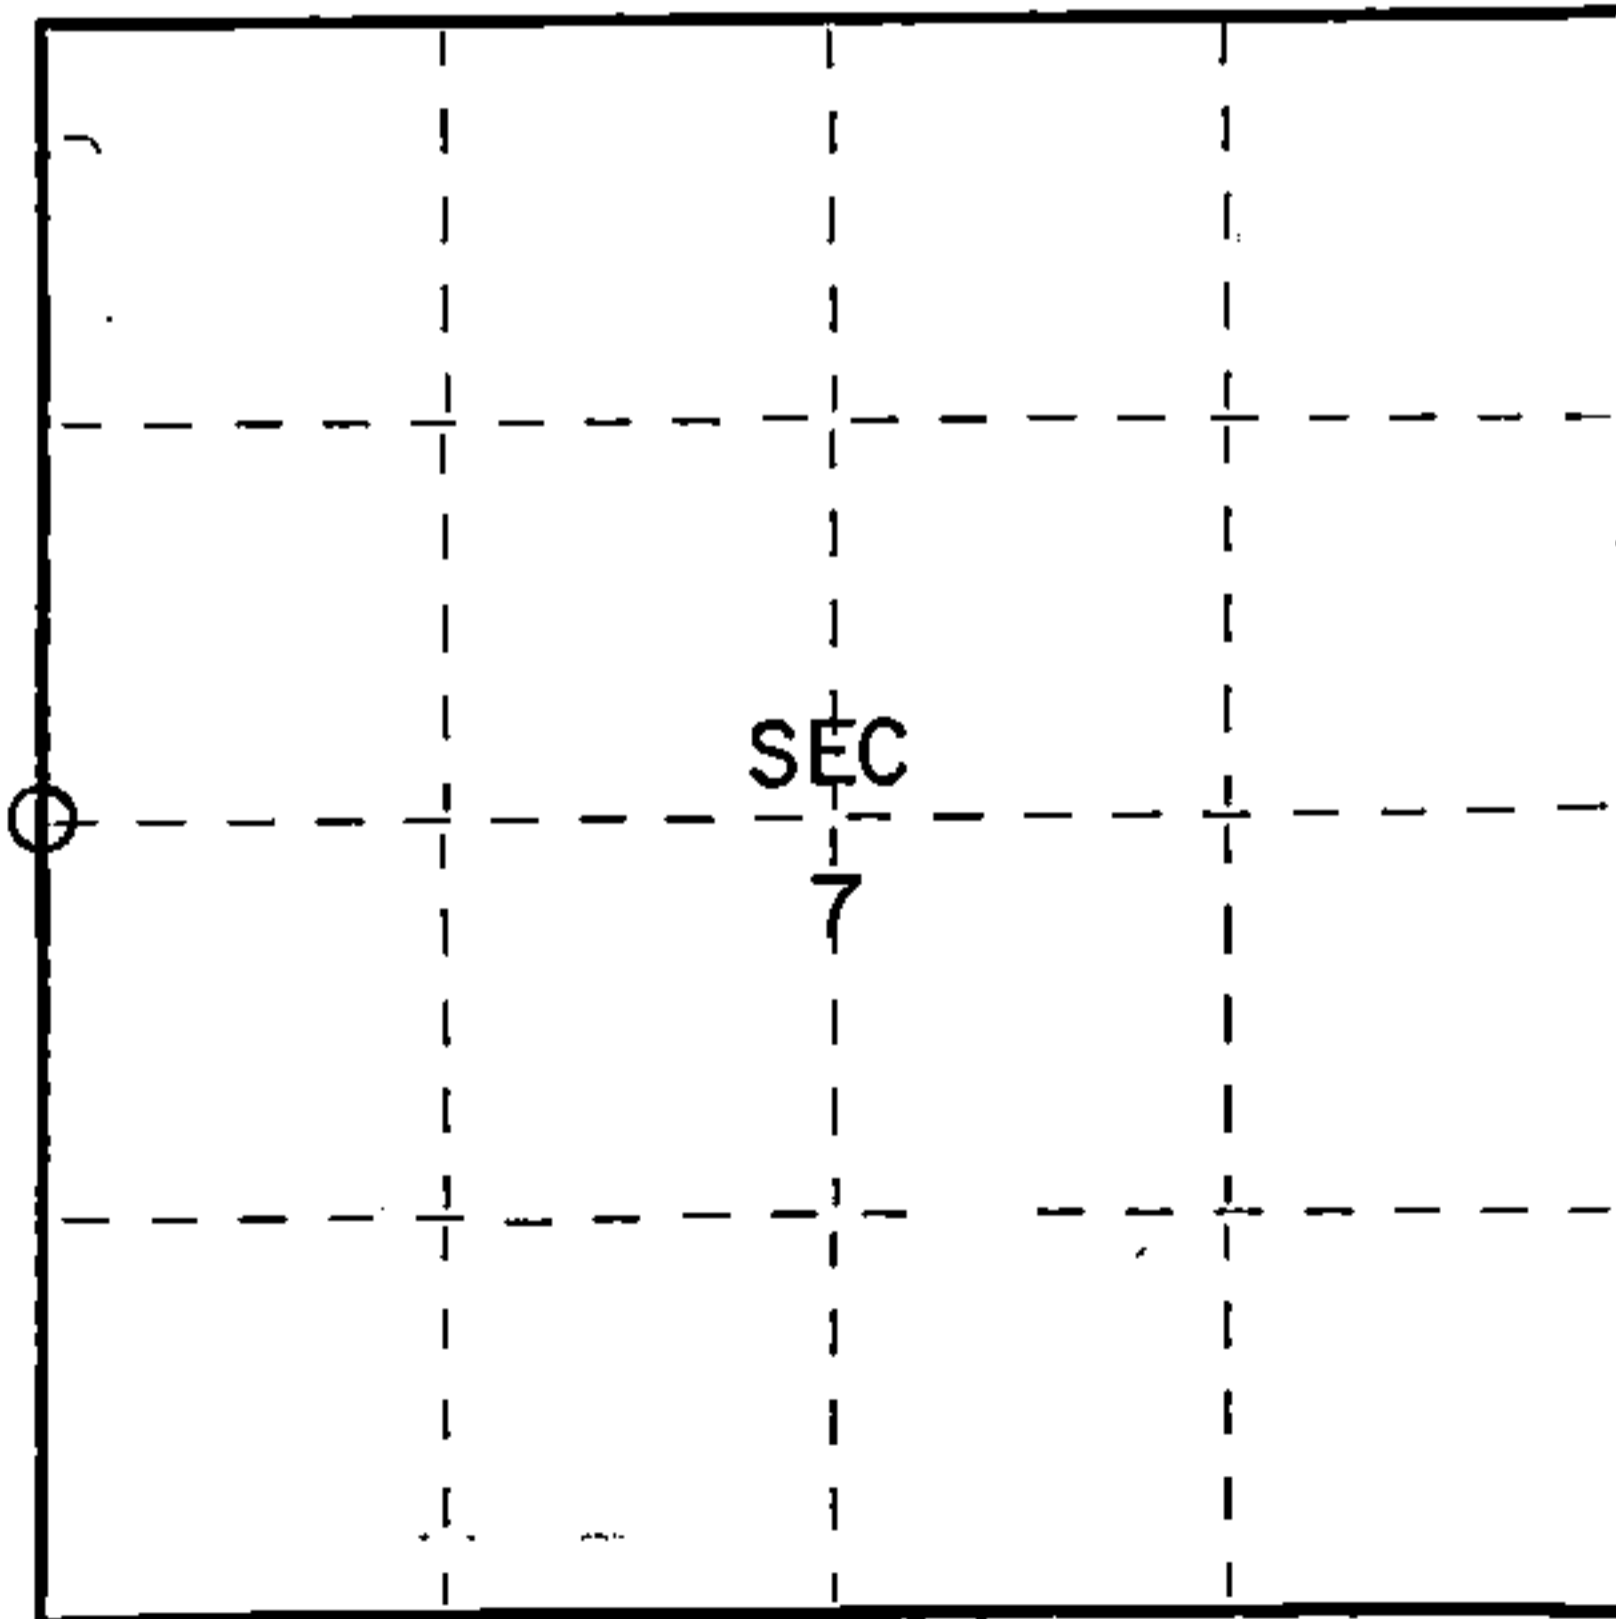

○ = Corner monument restored.

History of original corner establishment:

Lynn 16 N45E 47 Lks.
Lynn 16 S39W 34 Lks.

Description of corner evidence found:

1/2" iron pipe found 1" below road grade



Description of monument and accessories I established to perpetuate the original location of this corner.

Ties:

Forest County aluminum monument N85E 23.08 feet
Hemlock 24" N71 1/2 E 51.65 feet
W. Birch 16" S79 1/2 W 23.40 feet (BT found)

Dated at Crandon, Wis., this 30th day of October, 1975.

Signature Thomas R. Arnott Title Land Surveyor Registration No. S-887
(County Surveyor, Registered Land Surveyor, or other duly authorized official)

Office of Register of Deeds, County of Forest, I hereby certify that the within instrument was filed in this office for record on the 30th day of October, 1975 at 3 o'clock P. M.

Eugene Staszny Document Number 108122
(Register of Deeds)

By _____ Deputy

43512122000