

CERTIFIED LAND CORNER RESTORATION


Index No. **N 23**

State of Wisconsin }
County of Forest } ss.

I Charles E. Winkler, do hereby certify that on the 3rd day of December, 1980, I found evidence of the 1/4 corner of Sections 13 & 24 Township 35, North, Range 12 East, Fourth Principal Meridian, as described hereon; and that from this evidence I established a new monument and accessories as described hereon to perpetuate the original location of this corner.

Resident witnesses:

.....
.....
.....

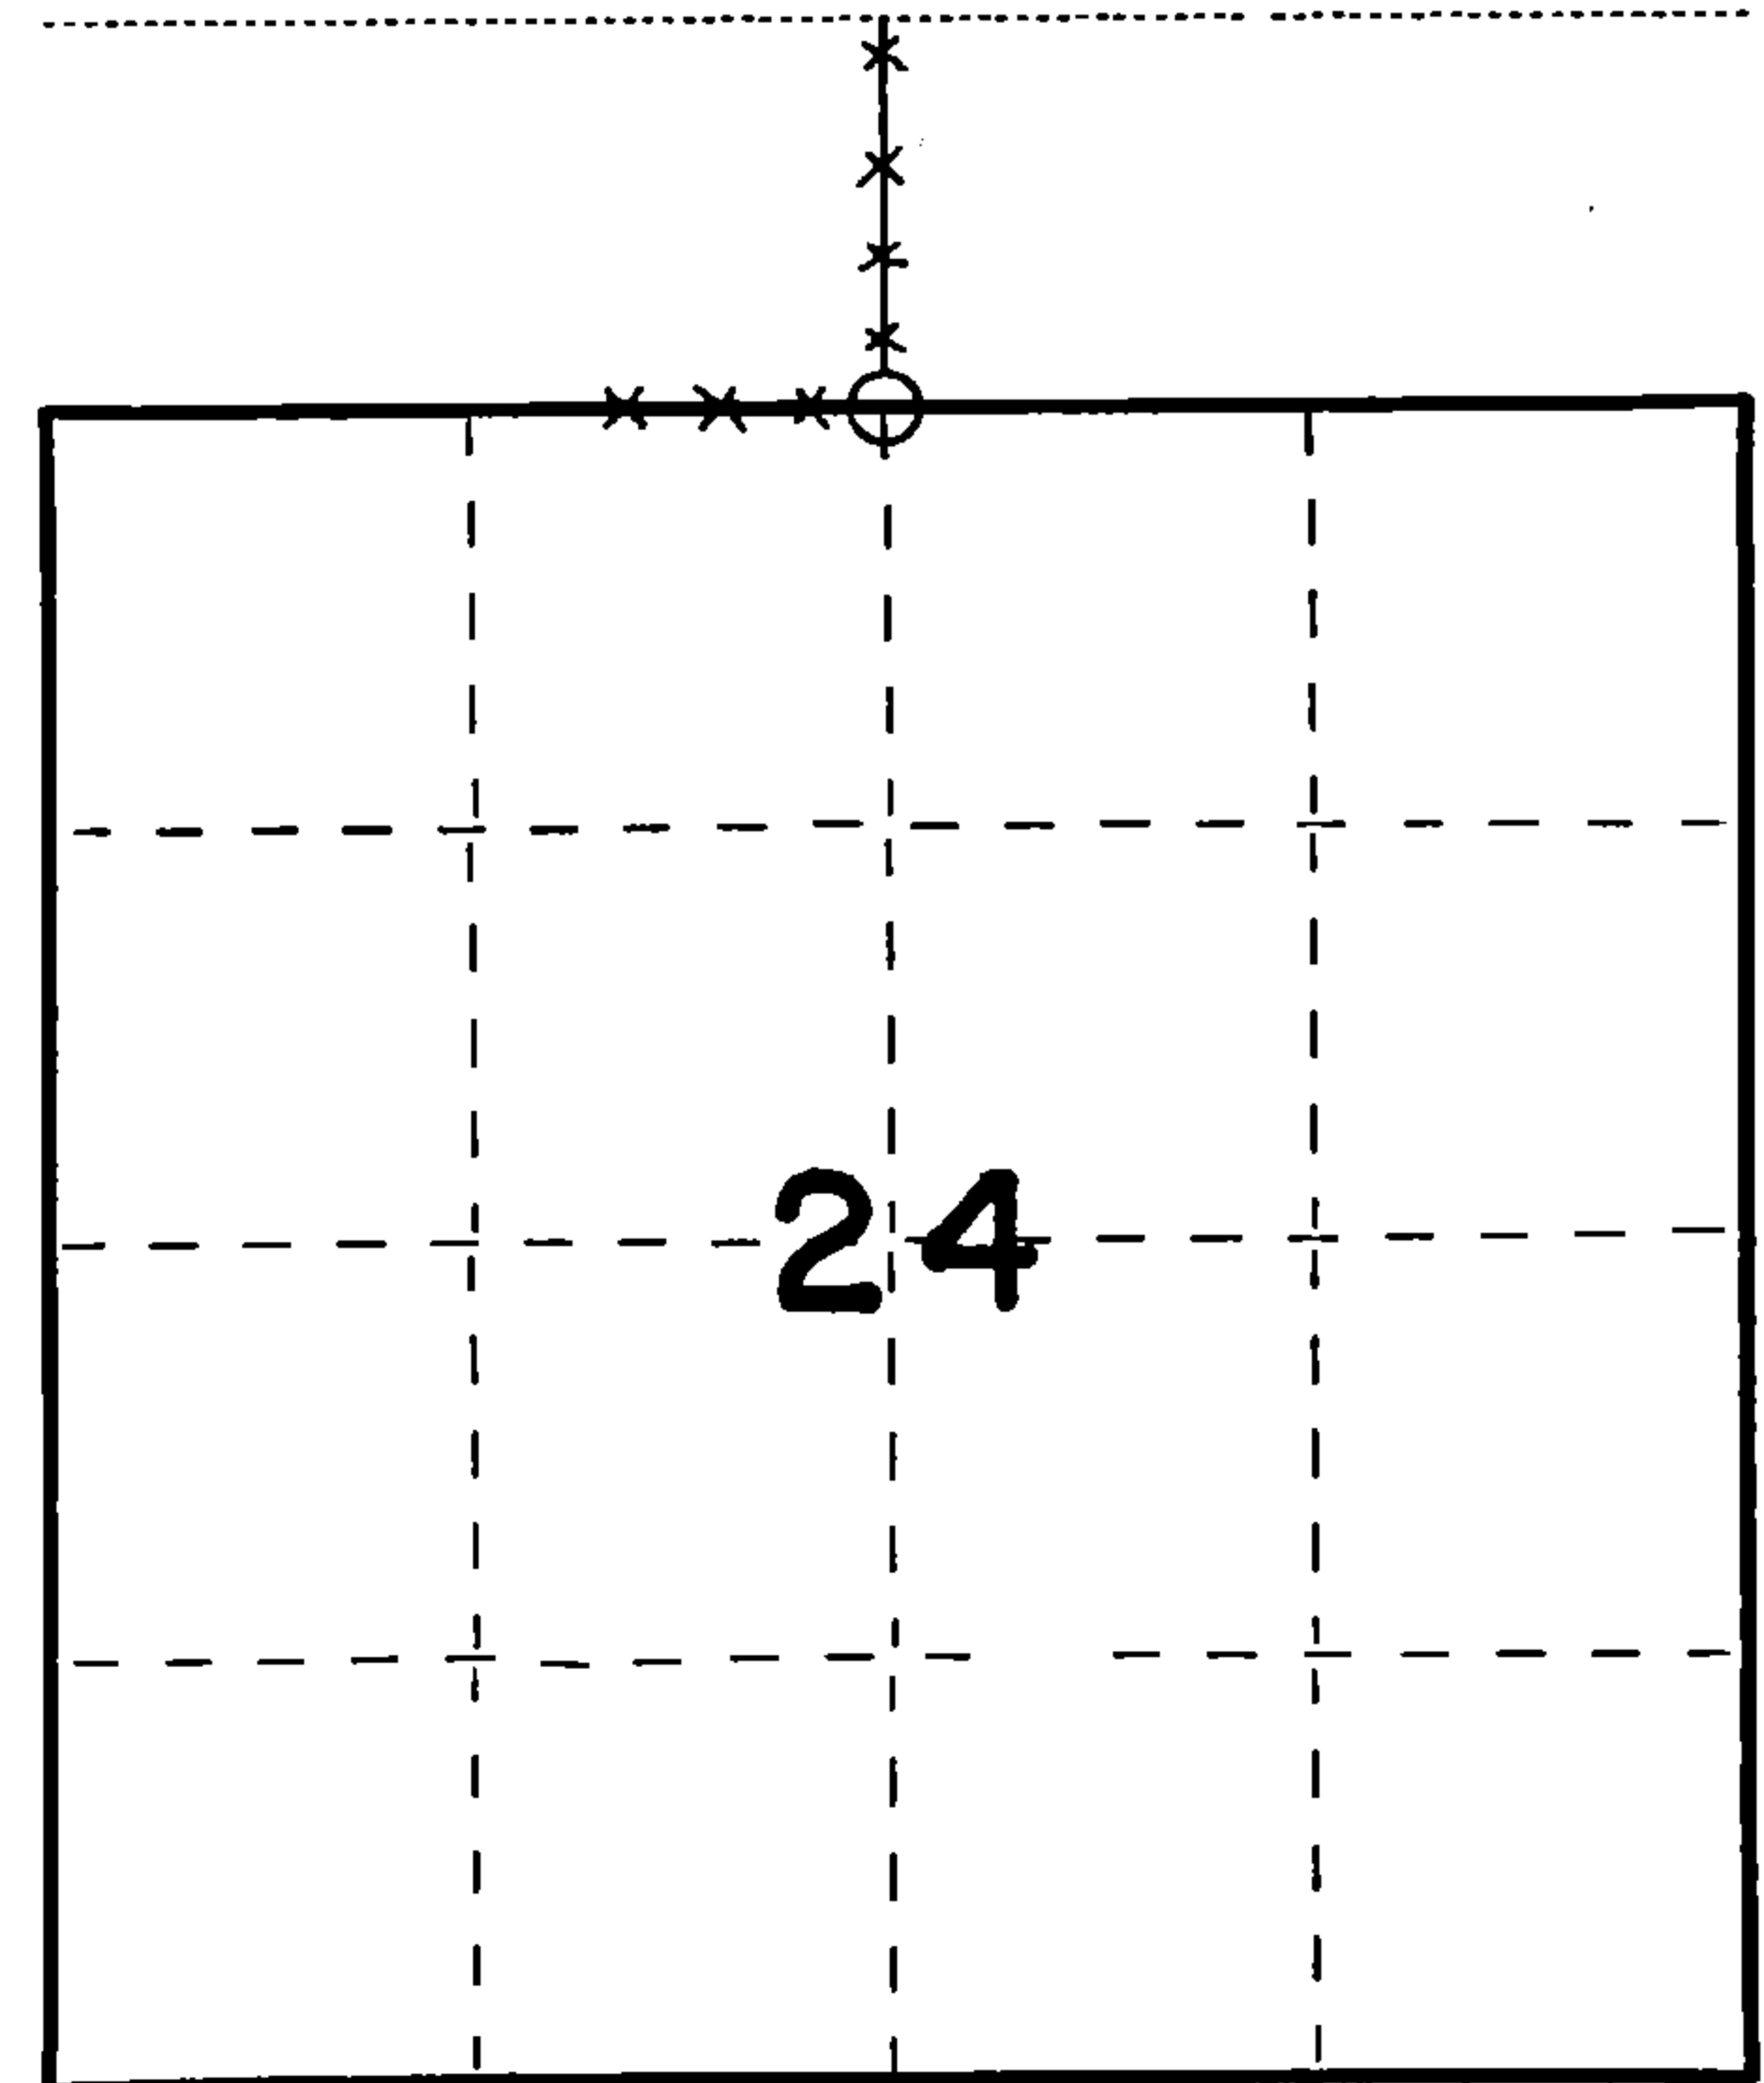

○ = Corner monument restored.

History of original corner establishment:

Original subdivision by James L. Nowlin, June 26 - July 7, 1865.
Wood post set by Nowlin, with the following bearing trees:
White Pine 20" N62°E, 20 links.
White Pine 30" N80°W, 34 links


Description of corner evidence found:

2" o.d. iron pipe found (painted orange) at base of corner fence post. Fence runs north and west from corner. 3" x 3" very old pointed post (painted orange) leaning against corner fence post. Fence appears to be 40 or more years old.

Description of monument and accessories I established to perpetuate the original location of this corner.

Replaced 2" iron pipe with new Forest County aluminum monument. New bearing trees (blazed but not scribed):

Triple Maple S34°W, 30.0 feet.
14" White Birch S68°E, 17.4 feet.
5" Maple N36°W, 25.5 feet.

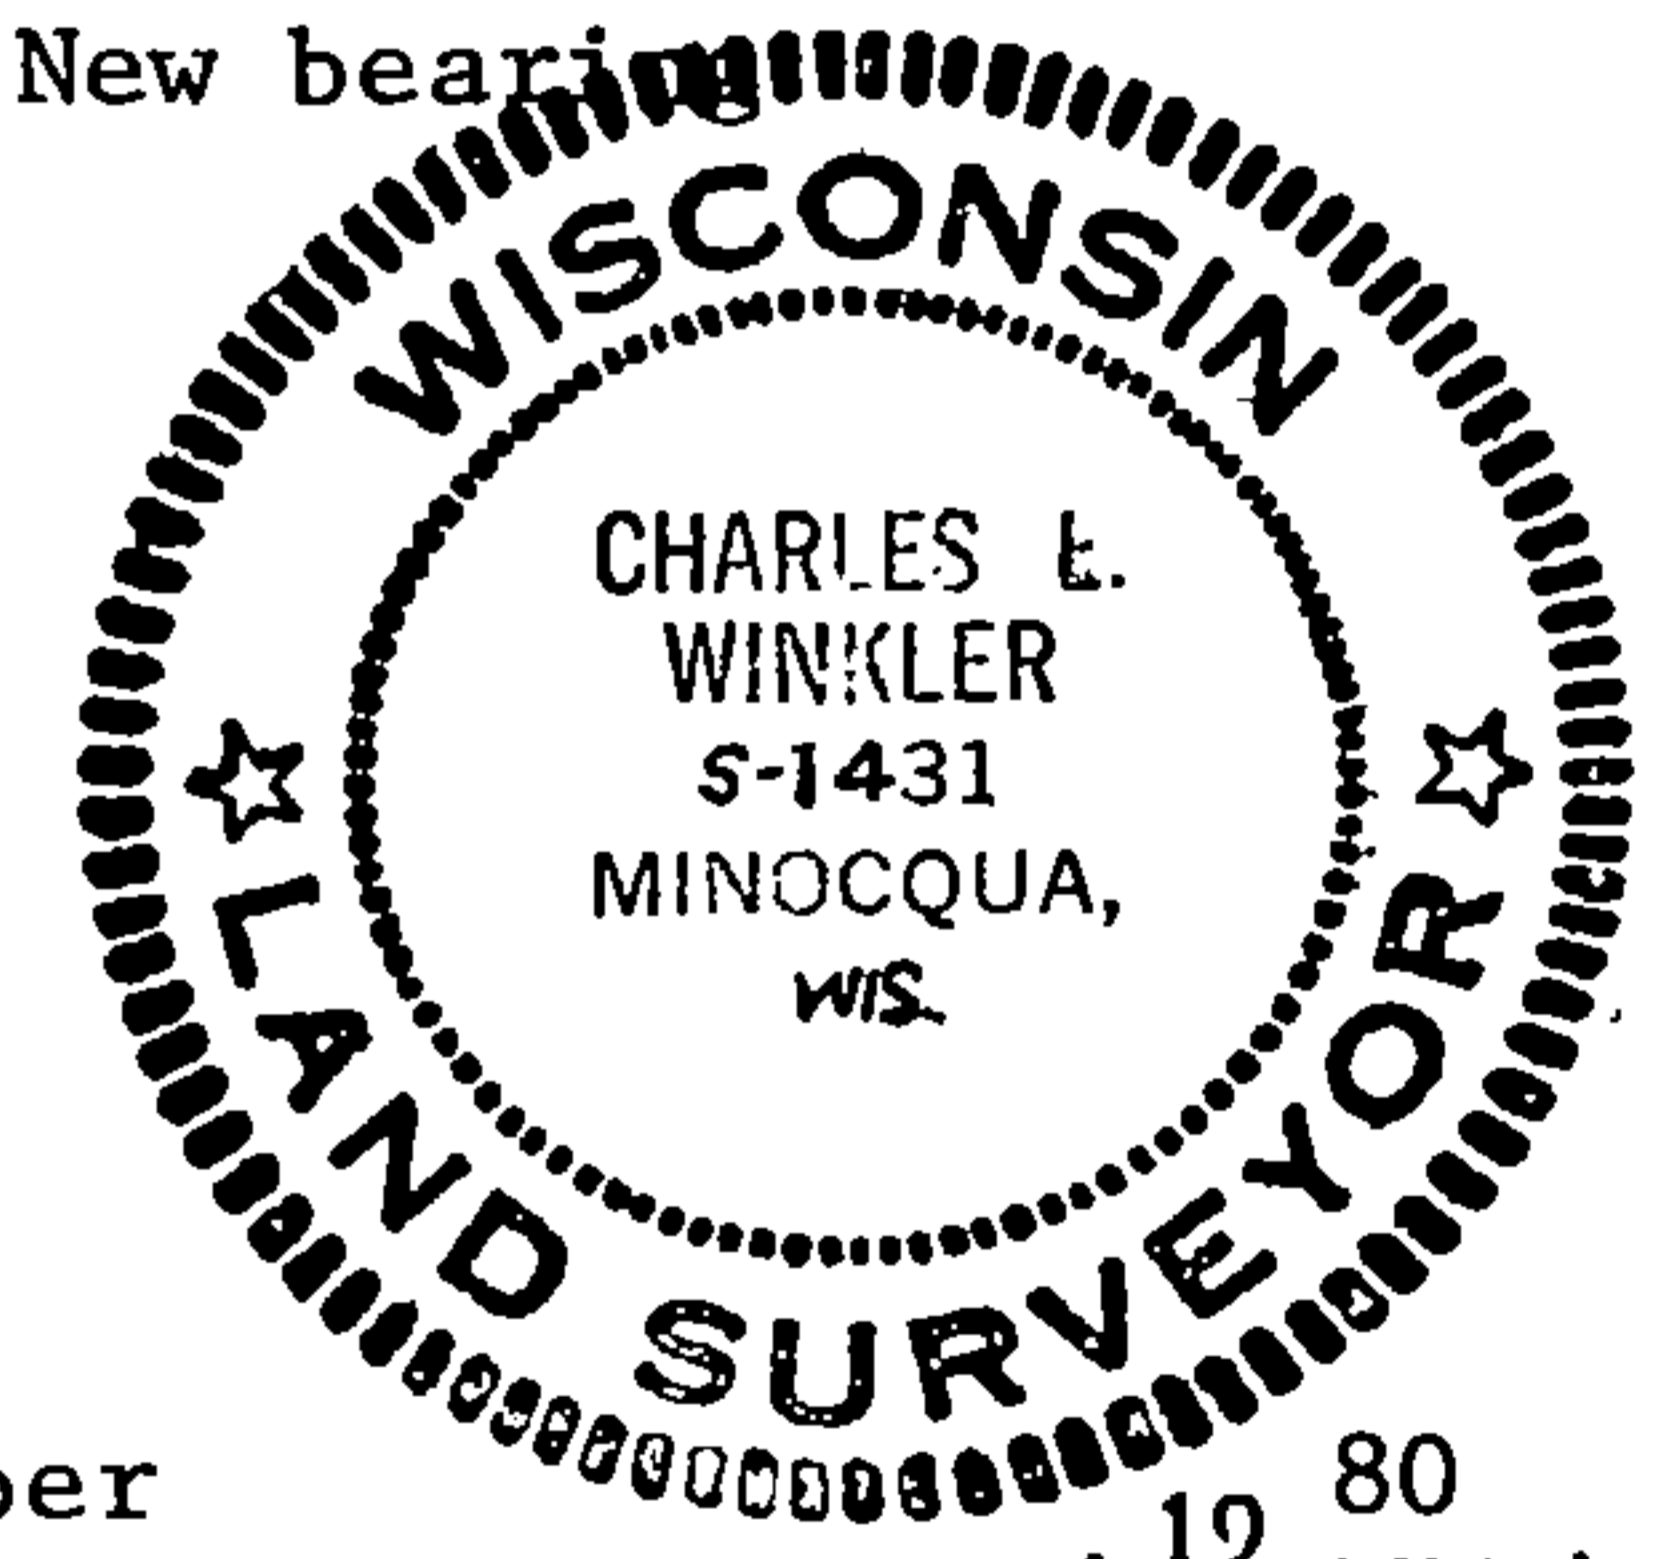

Dated at Minocqua, Wis., this 15th day of December, 1980

Signature *Charles E. Winkler* Title Registered Land Surveyor Registration No. S-1431
(County Surveyor, Registered Land Surveyor, or other duly authorized official)

Office of Register of Deeds, County of Forest, I hereby certify that the within instrument was filed in this office for record on the 17th day of December, 1980 at 10:30 o'clock A.M.

Eugene Stetson
(Register of Deeds)
By _____ Deputy

DOCUMENT NO. **119127**

FORM 985 H. C. MILLER CO., MILWAUKEE

43512130020