

CERTIFIED LAND CORNER RESTORATION

Index No. 13-XY

State of Wisconsin }  
County of Forest } ss.


I Philip T. Hansen, do hereby certify that on the 17th day of August, 1977, I ~~found~~ established ~~the~~ 1/32 between 1/2 corner corner of & S 1/16 corner Sec. 33 & 34 Township 35, North, Range 12 East, Fourth Principal Meridian, as described hereon; and that from this evidence I established a new monument and accessories as described hereon to perpetuate the original location of this corner.

Resident witnesses:

Glen Barker


Jim Claflin

Herb Wagoner

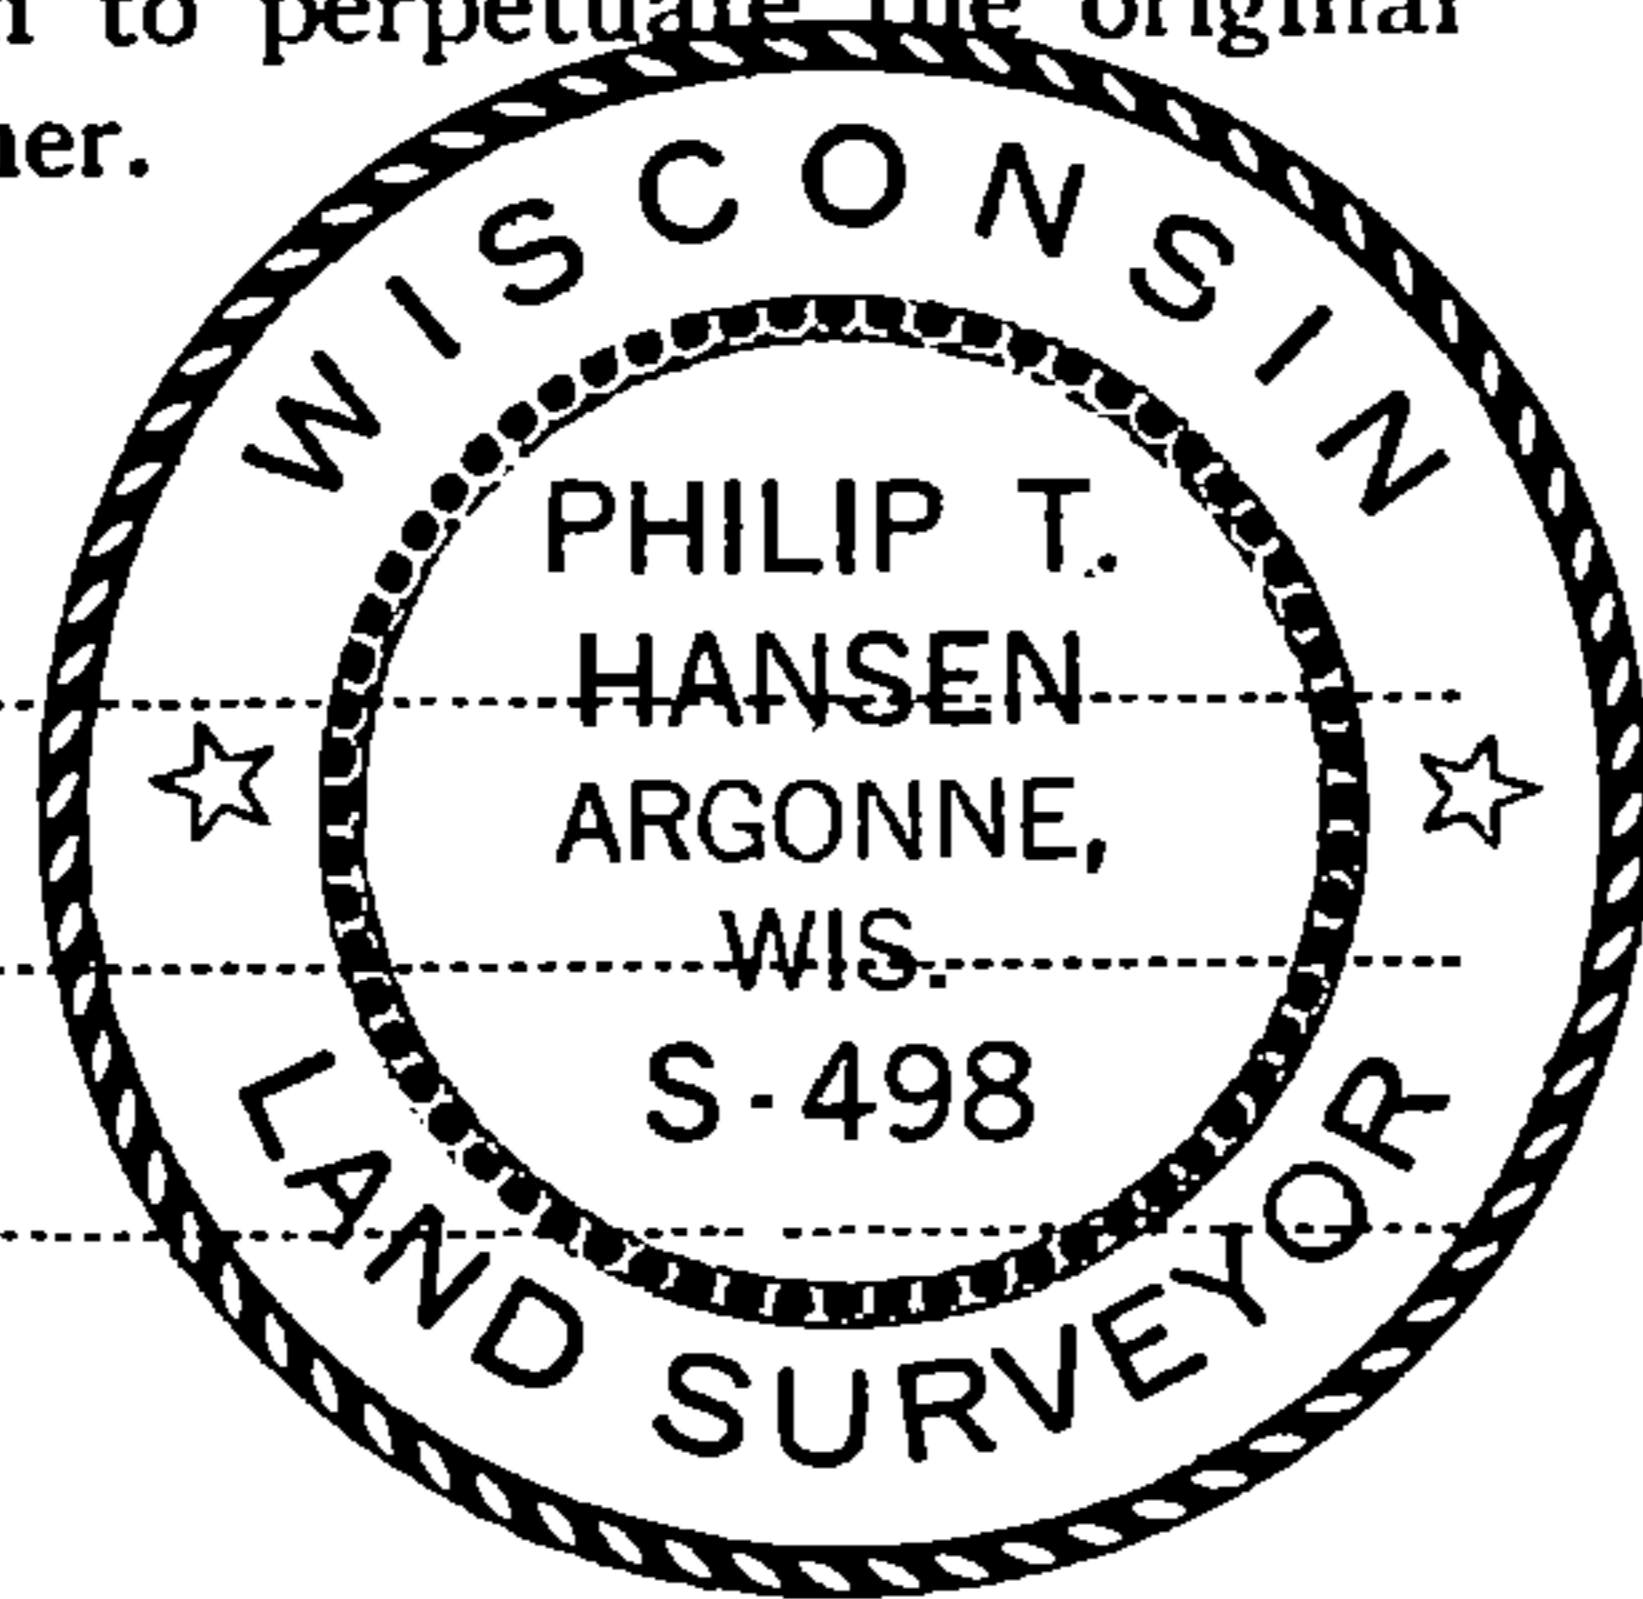

FORM 985 H. C. MILLER CO., MILWAUKEE

T35N R12E

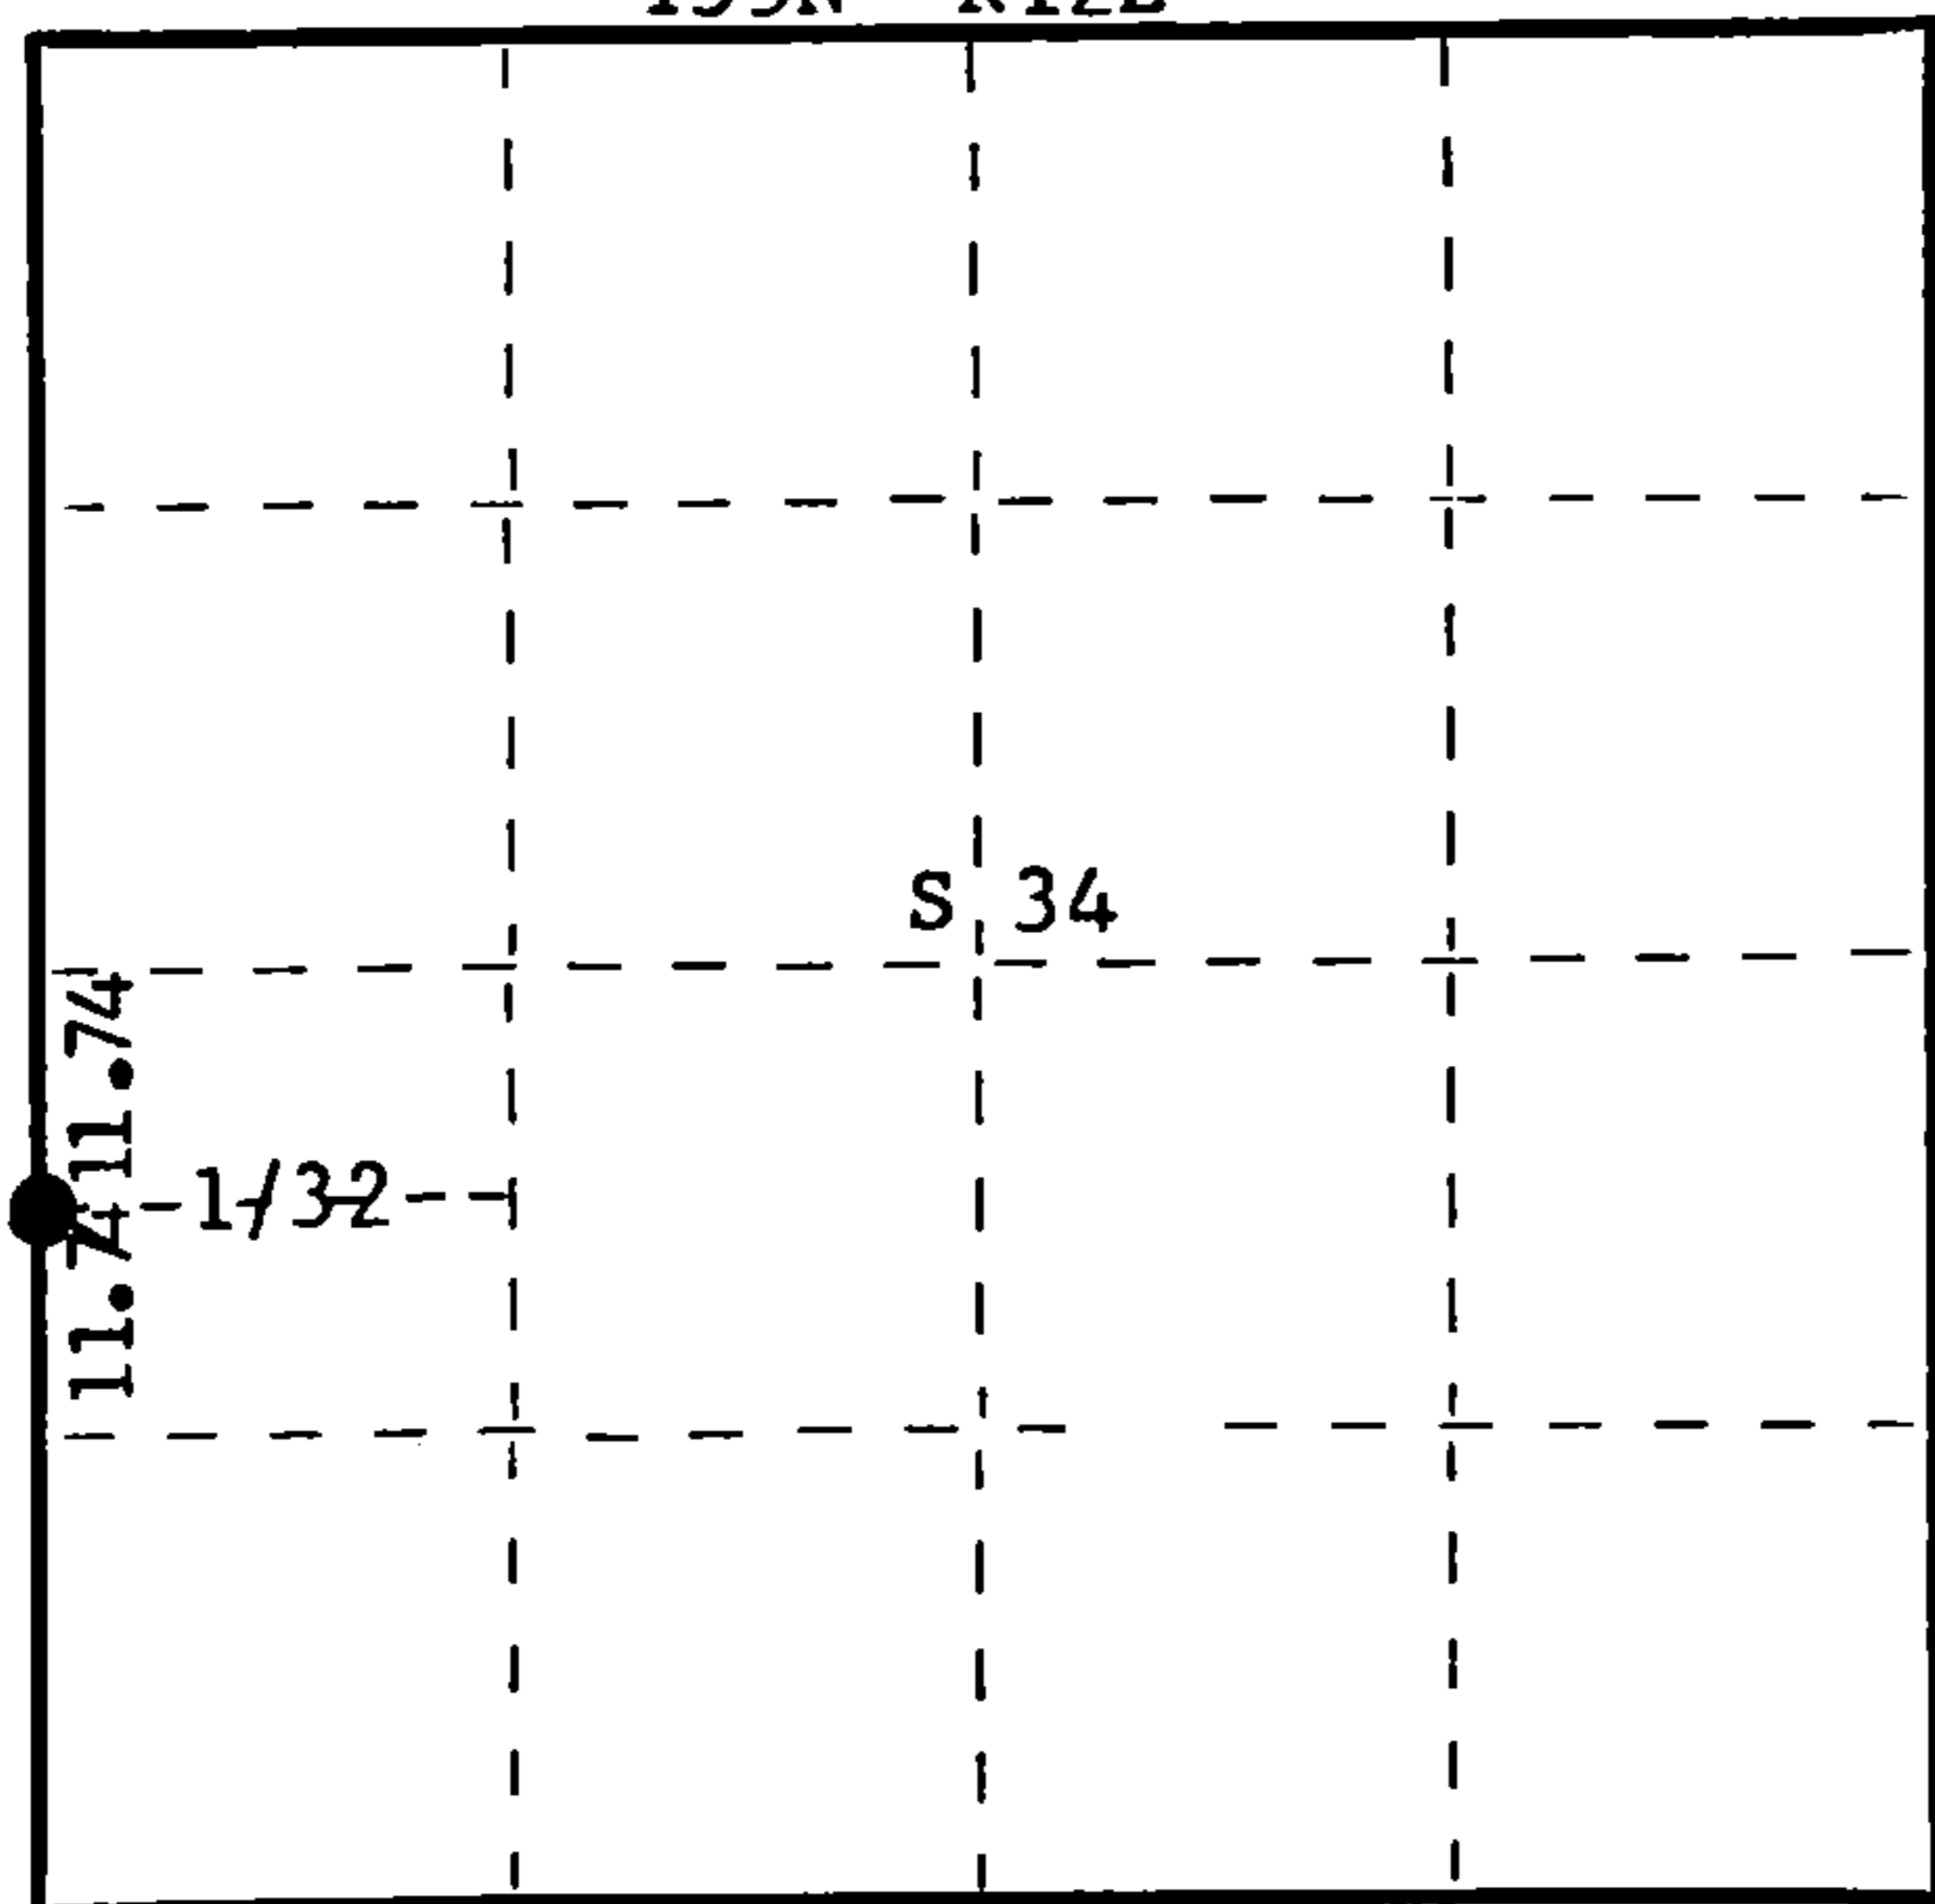

○ = Corner monument restored.

History of original corner establishment:

No record of any previous survey.

Description of corner evidence found:

No evidence of any corner recovered.

Corner set by proportional measurement.

From previously established 1/4 corner and S 1/16 corner, set by traverse and computations, Set 1/32 corner at 774.7325 feet (11.74 chains) S 9° 31' 33" W intermediate between 1/4 corner and S 1/16 corner.

Description of monument and accessories I established to perpetuate the original location of this corner.

Set 1 1/2" x 18" iron pipe in old section line road, 4" below surface.

Set 1 1/2" iron pipe with 2" brass cap for witness corner 25 links west.

Monument projects 24" above ground. Cap stamped:

Marked NBTs from true corner.

Tamarack 4" N10°W, 53.6 links, scribed 1/32 BT.

Tamarack 6" N32°E, 69.3 links, scribed 1/32 BT.

S498  
T36N R12E  
1/32 33 34 W.C.  
E 25 lks.  
CPI - 1977

Dated at Rhineland, Wis., this 19th day of August, 1977

Signature Philip T. Hansen Title Registered Land Survey Registration No. S-498  
(County Surveyor, Registered Land Surveyor, or other duly authorized official)

Office of Register of Deeds, County of Forest, I hereby certify that the within instrument was filed in this office for record on the 22nd day of AUGUST, 1977 at 3:30 o'clock P. M.

Eugene Stutzman  
(Register of Deeds)

DOCUMENT NUMBER 112166

By..... Deputy

43512331500