

CERTIFIED LAND CORNER RESTORATION


Index No. **X21**

State of Wisconsin }
County of Forest } ss.

I Stuart L. Foltz, do hereby
certify that on the 9th day
of March, 1977, I found
evidence of the one-quarter
corner of Sections 35 and 36
Township 35, North, Range
12 East, Fourth Principal Meridian,
as described hereon; and that from this evidence
I established a new monument and accessories
as described hereon to perpetuate the original
location of this corner.

Resident witnesses:

.....
.....
.....

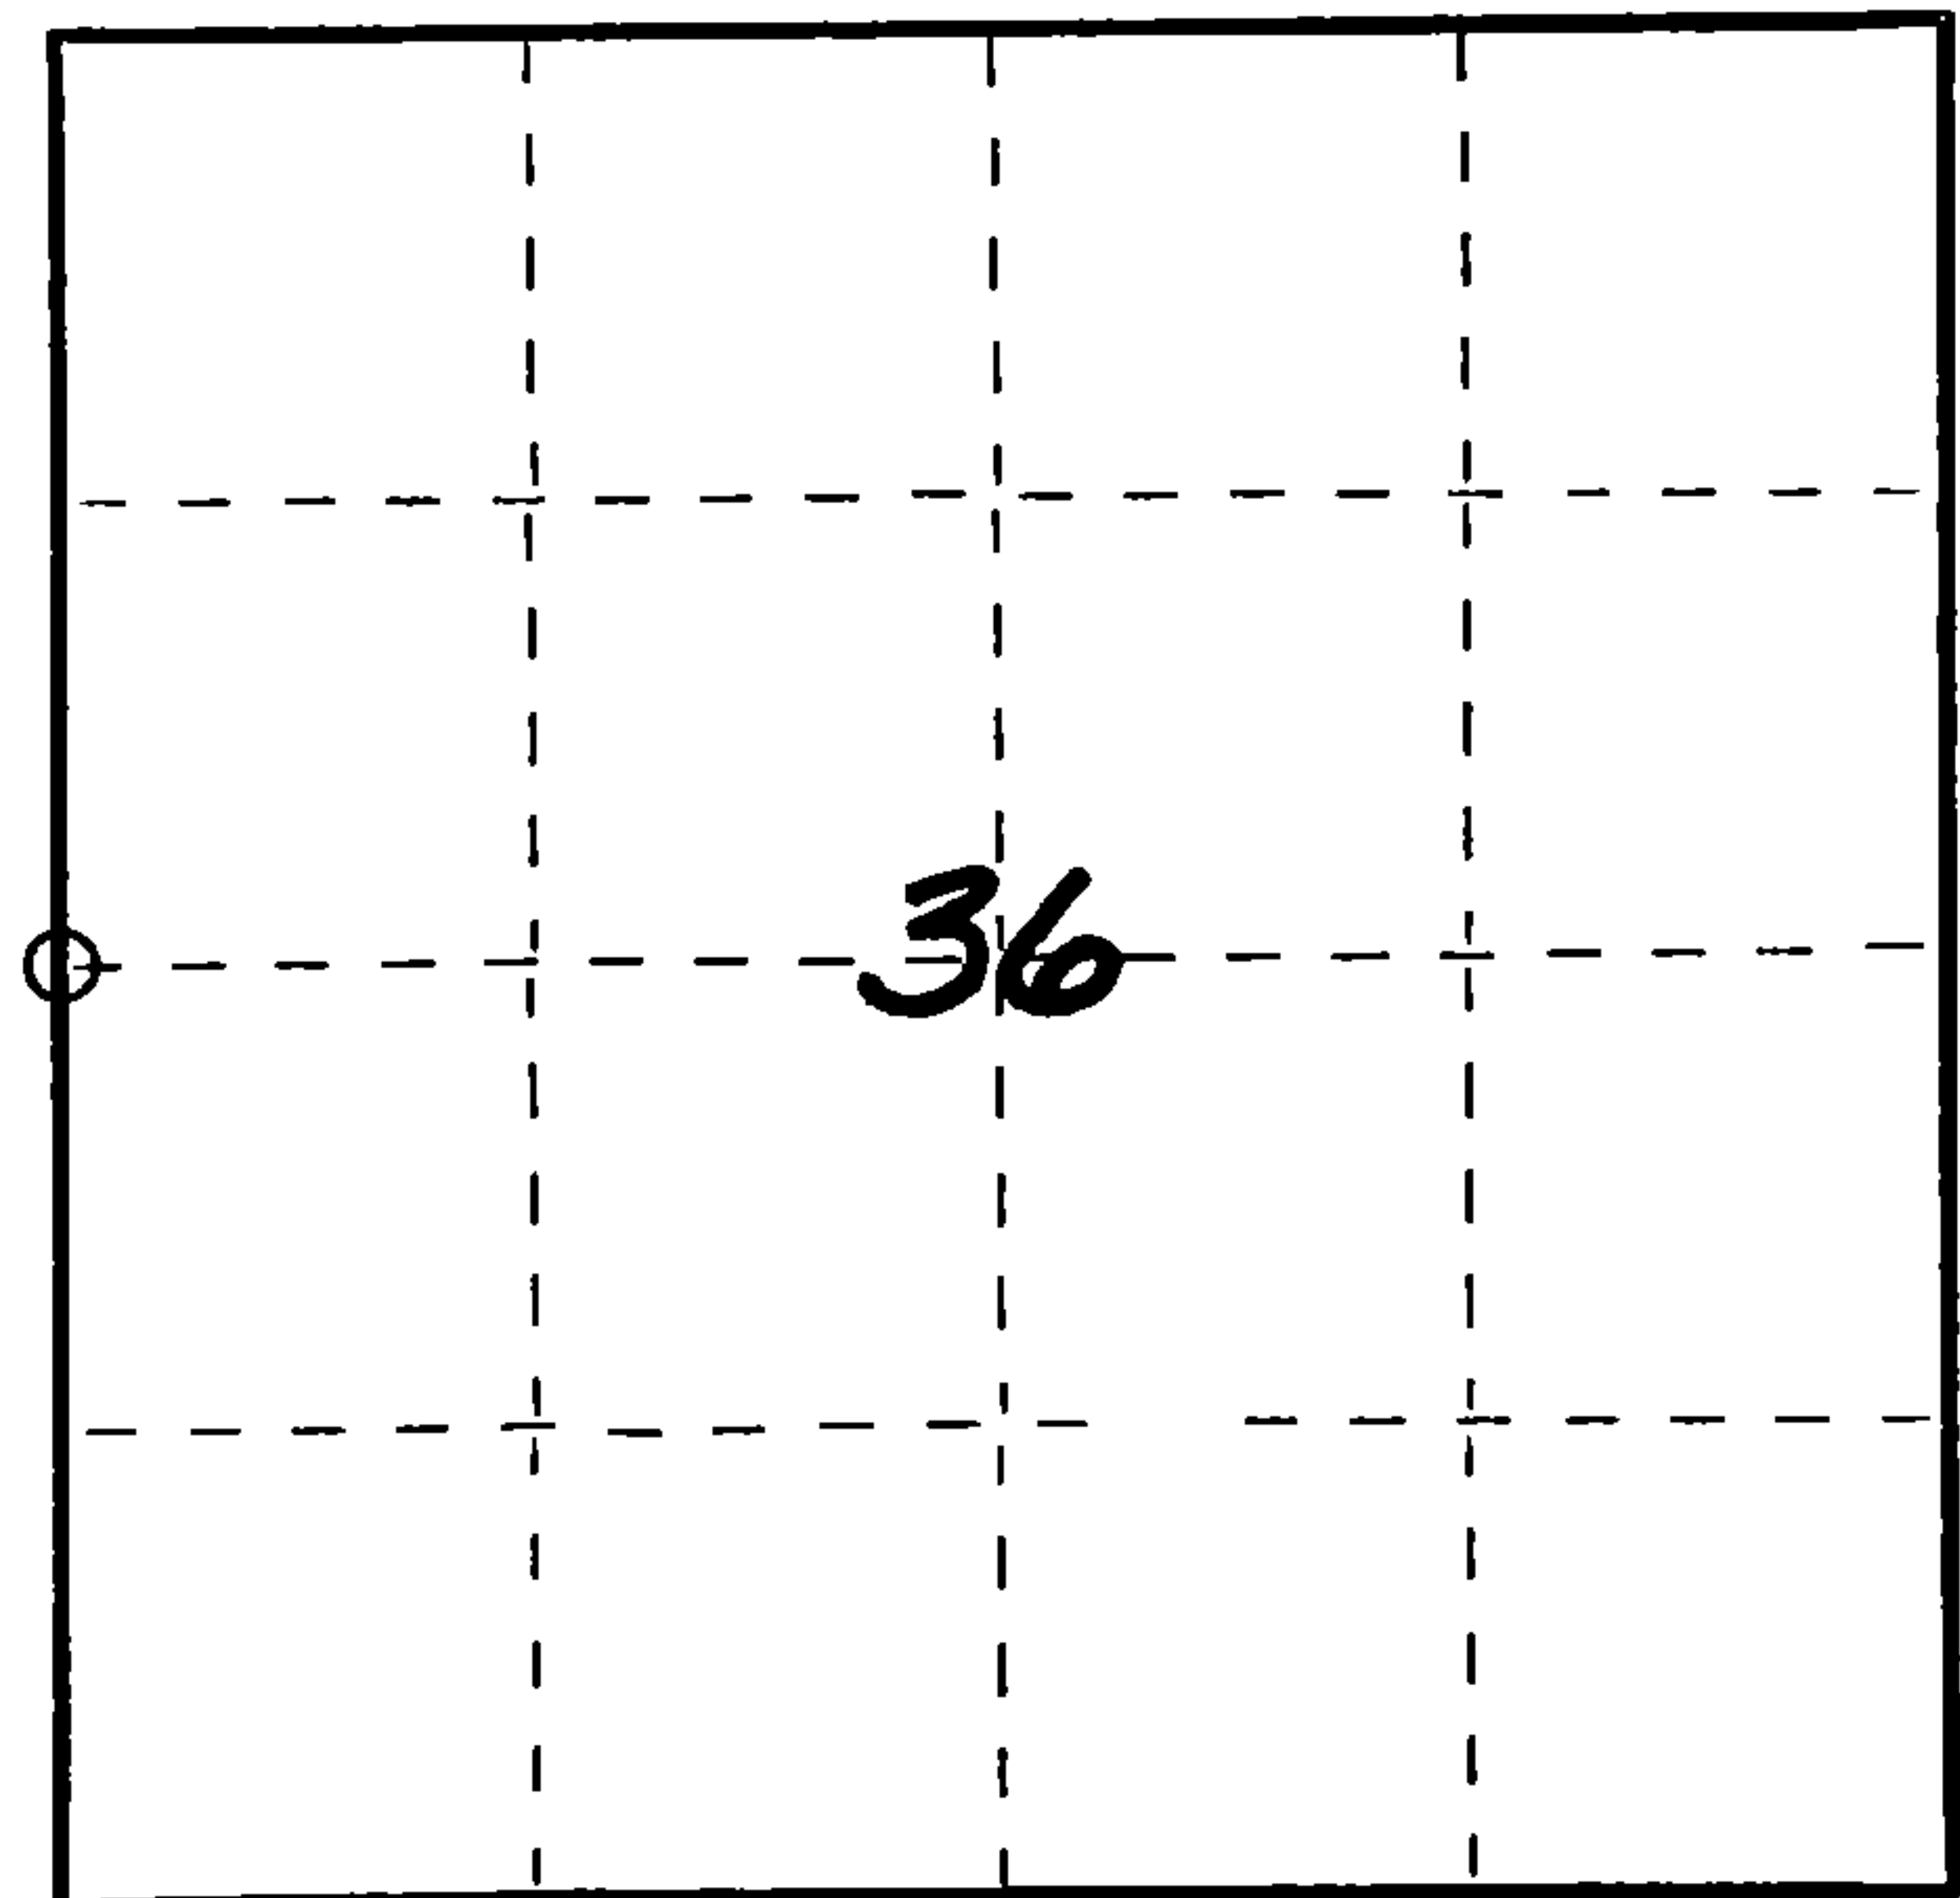

○ = Corner monument restored.

History of original corner establishment:

Date of original survey: June 26, 1865 to July 7, 1865
Original surveyor: James L. Nowlin
Original monument: Wood post
Original bearing trees: 24" Hemlock N76°W 8 lks. (5.28')
15" Lind S73°E 15 lks. (9.90')

Description of corner evidence found:
Found old squared post and stones, and 2 very old stumps. Stumps identified by
U.S. Forest Service using cellular structure as Hemlock and Basswood (Lind).
Crossed in corner location using these stumps, which are undoubtedly the remains
of the original bearing trees. Old squared post falls N72°E, 7.6' from crossed
in corner location, indicating it had probably fallen over a couple of times and
was stood up again on the wrong end, thereby getting shifted 2 post lengths from
its original location.
Fence line East and West and blue painted lines fit crossed in location acceptably
well.

Description of monument and accessories I established to perpetuate the original location of this corner.
Set Forest County aluminum monument (2" aluminum pipe with cast aluminum cap)
24" Hemlock stump (original) N80°W 5.5'
15" Basswood stump (original) S76°E 10'
Squared wood post & stones N72°E 7.6'
White Birch painted "1/4" found N49°E 23.8'

New bearing trees:
P.K. Nail with disc in 10" Maple S36°W 4.0'
P.K. Nail with disc in 9" Maple N55°W 16.8'
P.K. Nail with disc in 6" Maple N20°E 13.0'


Dated at Minocqua, Wis., this 30th day of June, 1977.

Signature Stuart L. Foltz Title Registered Land Surveyor Registration No. S-1170
(County Surveyor, Registered Land Surveyor, or other duly authorized official)

Office of Register of Deeds, County of Forest, I hereby certify that the within
instrument was filed in this office for record on the 6th day of July, 1977
at 9:30 o'clock A. M.

Eugene Staszny
(Register of Deeds)
By _____ Deputy

DOCUMENT NUMBER
111808

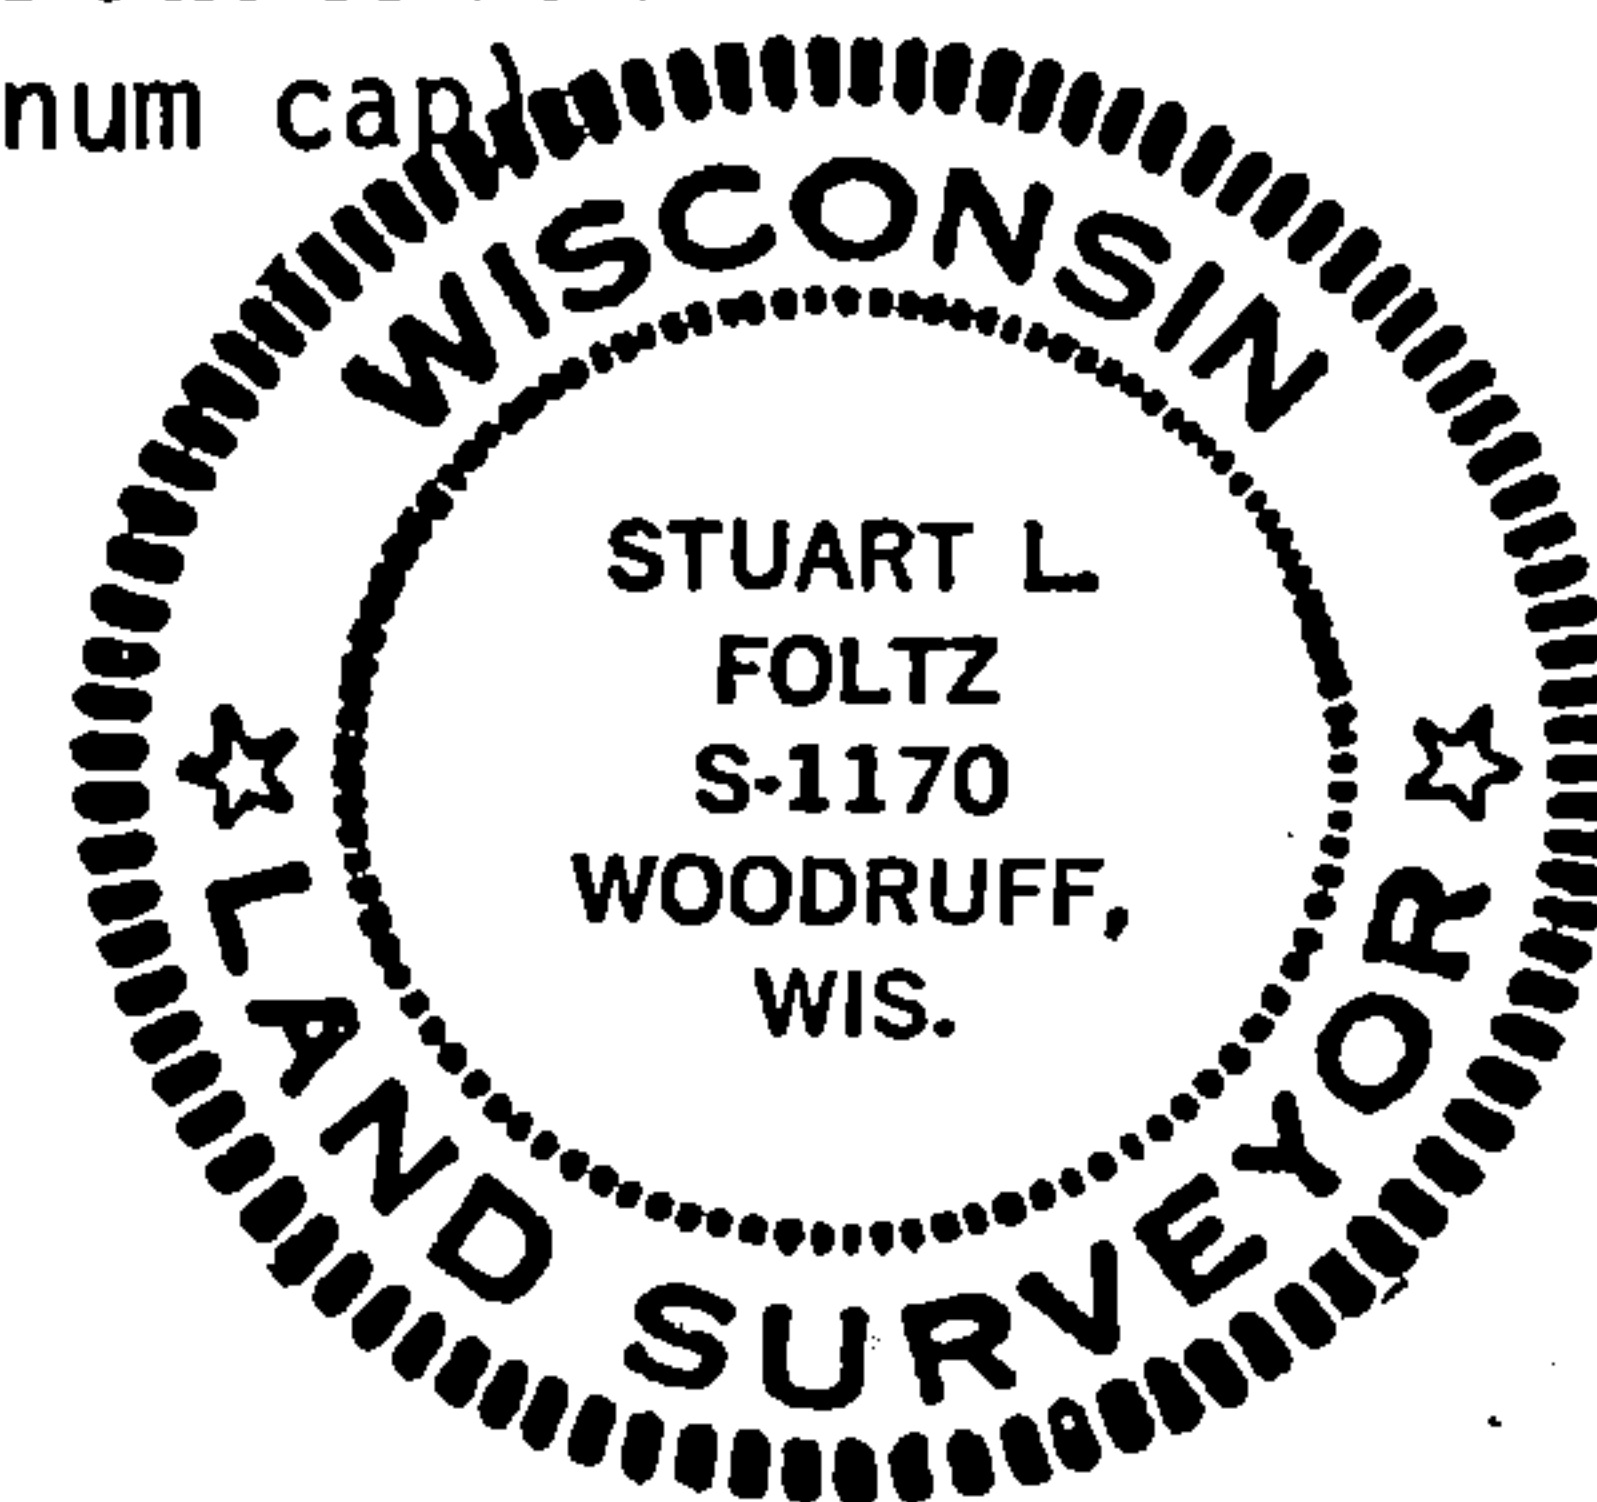

FORM 985 H. C. MILLER CO., MILWAUKEE

43512352000