

State of Wisconsin  
County of FOREST

ss. ESTABLISHMENT OF QUARTER - QUARTER SECTION CORNER BETWEEN ORIGINAL GOVERNMENT SURVEY CORNERS.

I NEAL SPERHAKE, do hereby certify that on the TWENTIETH day of OCTOBER, 19 64, I established the EAST ONE SIXTEENTH CORNER BETWEEN SECTIONS 5 AND 8, TOWNSHIP 35 NORTH, RANGE 13 EAST, Fourth Principal Meridian, as described hereon.

History: There is no record of this corner having ever been previously established.

Description of monument and accessories I established to perpetuate the location of this corner:


At the point determined for the location of the corner I emplaced a:

GALVANIZED IRON PIPE, THREE FEET LONG, ONE INCH IN DIAMETER, WITH ALUMINUM CAP DENOTED AS, "KIMBERLY CLARK CORP. T35N E 1/16 BTWN. 5 & 8 R13E SPERHAKE RLS 463 10/20/64."

The pipe is witnessed by:

- W. Birch 3 N 60°W 9 links. (SCRIBED S 5 BT).
- W. Birch 3 S 58°E 13½ links. (SCRIBED S 8 BT).

Description as to how corner was located: The corner of sections 4, 5, 8, 9, and the meander corner on the east side of Lake Metonga between sections 5 and 8 have been previously established with a distance between them of 27.23 chains. The original distance between these corners was 27.90 chains. Since the original distance between the corner of sections 4, 5, 8, 9, and the E 1/16th. between sections 5 and 8 was 20.00 chains, proportionately the corner would be 19.42 chains west of the corner of sections 4, 5, 8, 9, and 7.81 chains east of the meander corner and on a straight line between the two previously established corners. I have so placed the sixteenth corner.

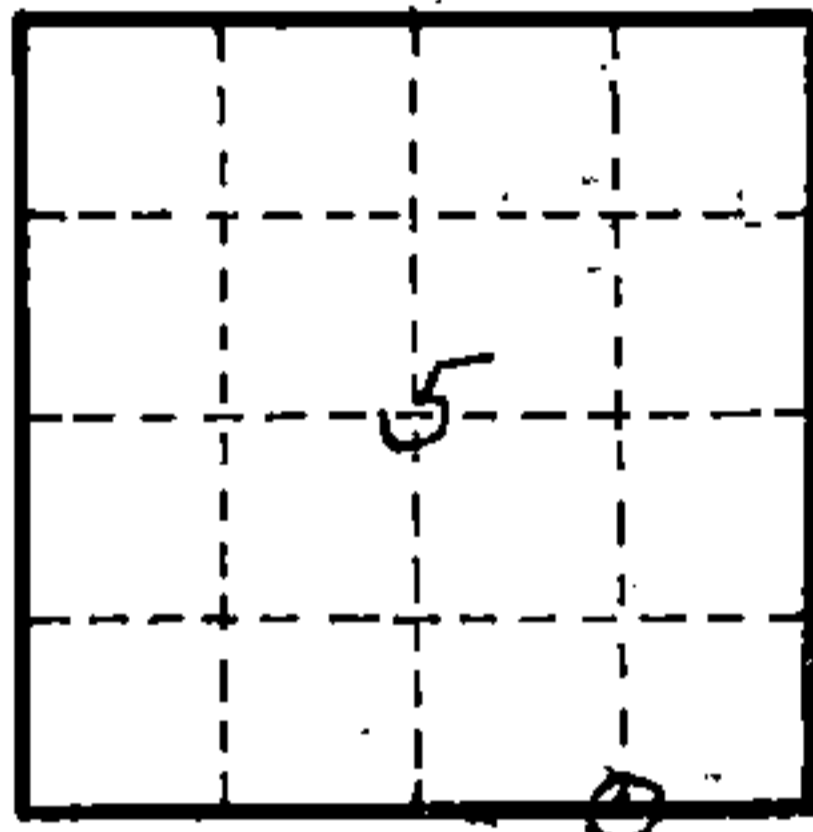

O = Corner monument restored

89582

FOREST COUNTY OFFICE  
FOREST COUNTY, WIS.  
JAN 12 1965  
Anna Peterson  
Register of Deeds

Resident witnesses \_\_\_\_\_

Dated at Crandon, Wisconsin, this 12th day of January, 19 65

Signature Neal Sperhake

Title Registered Land Surveyor Registration No. 463

~~Office of~~ Forest County ~~of~~ Wisconsin

I hereby certify that the within instrument was ~~filed in the~~ office for record on the 12th day of January 1965, and was ~~filed in~~ Book No. signed and ~~Page No.~~ sworn to of ~~County Records.~~ before me.

Surveyor's Seal

Signature Anna Peterson Title Notary Public

43513650070

Index No. 38