

State of Wisconsin

County of FOREST

ss. ESTABLISHMENT OF QUARTER - QUARTER SECTION CORNER BETWEEN ORIGINAL GOVERNMENT SURVEY CORNERS.

I NEAL SPERHAKE, do hereby certify that on the SECOND day of SEPTEMBER 19 64, I established the SOUTH ONE SIXTEENTH CORNER BETWEEN SECTIONS 5 AND 4, TOWNSHIP 35 NORTH, RANGE 13 EAST, Fourth Principal Meridian, as described hereon.

History: There is no record of this corner having ever been previously established.

Description of monument and accessories I established to perpetuate the location of this corner:


At the point determined for the location of the corner I emplaced a:

GALVANIZED IRON PIPE, THREE FEET LONG, ONE INCH IN DIAMETER, WITH ALUMINUM CAP DENOTED AS, "KIMBERLY CLARK CORP. T35N S 1/16 BTWN. 5 & 4 R13E SPERHAKE RLS 463 9/2/64."

The pipe is witnessed by:

- W. Birch 4 S 88°E 31 links. (SCRIBED S 4 BT).
- Oak 8 N 56°W 40½ links. (SCRIBED S 5 BT).


Description as to how corner was located: Since both the quarter corner ¼ mile north and the section corner ¼ mile south have been previously established with a distance between them of 39.71 chains, the 1/16th. corner was set 19.85½ chains from either corner and on a straight line between them.

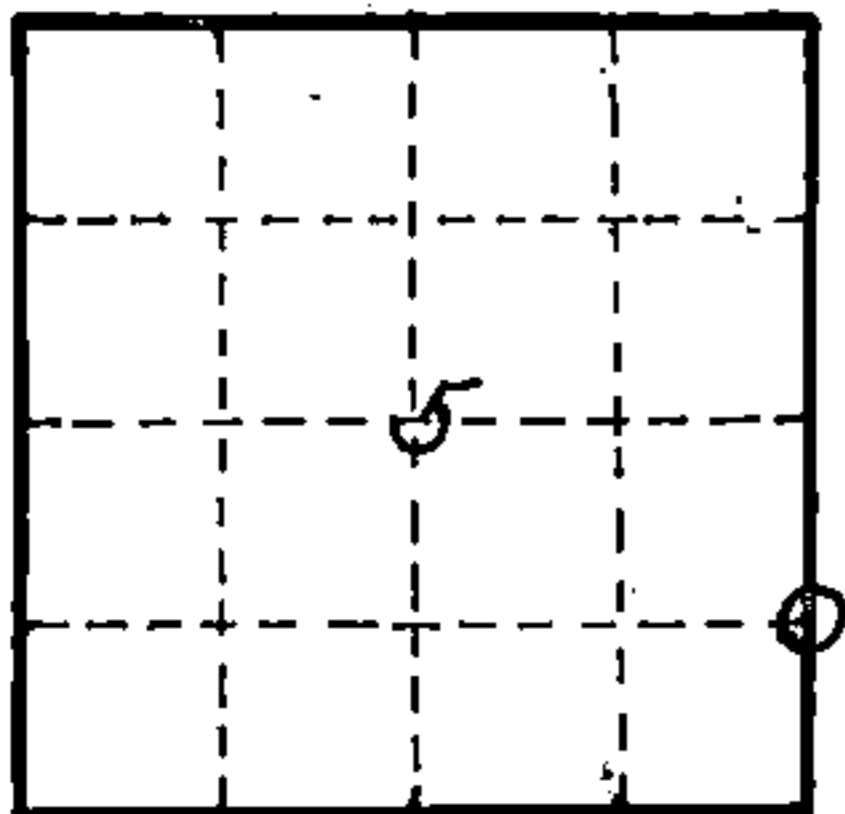

O = Corner monument restored

895???

REGISTRAR'S OFFICE FOREST COUNTY, WIS.

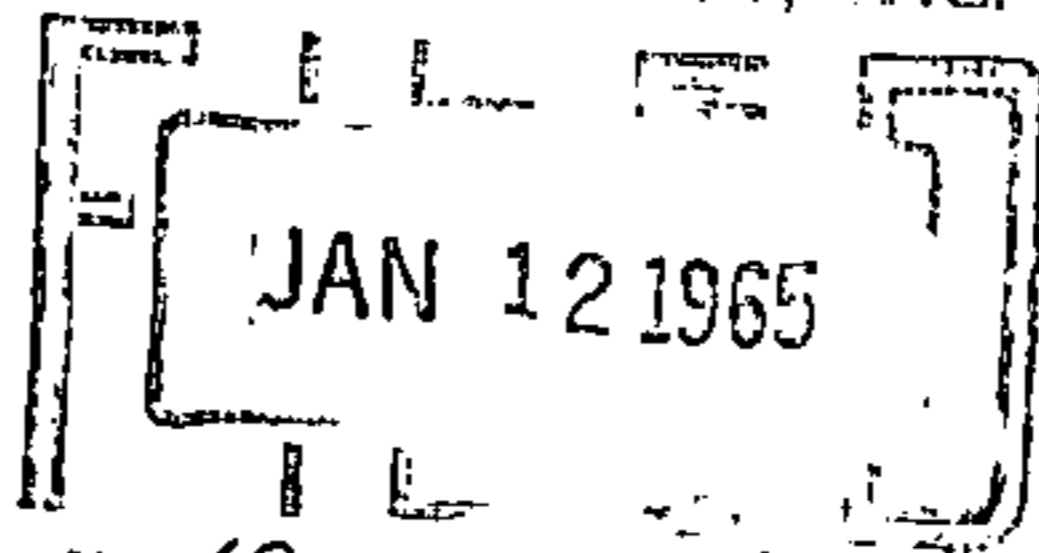

Anna Peterson, Registrar

Resident witnesses _____

Dated at Crandon, Wisconsin, this 12th day of January, 1965.

Signature Neal Sperhake

Title Registered Land Surveyor Registration No. 463

Office of Forest County of Wisconsin

I hereby certify that the within instrument was ~~filed in the~~ filed in the office of records on the 12th day of January 1965, and was ~~filed in the~~ filed in the Book No. _____ signed and ~~page~~ page No. _____ of County Records before me.

Surveyor's Seal

Signature Anna Peterson Title Notary Public

43513051000

Index No. 09