

State of Wisconsin
County of FOREST

ss. ESTABLISHMENT OF QUARTER - QUARTER SECTION CORNER BETWEEN ORIGINAL GOVERNMENT SURVEY CORNERS.

I NEAL SPERHAKE, do hereby certify that on the TWENTY-NINTH day of JULY, 1964, I established the WEST ONE SIXTEENTH CORNER BETWEEN SECTIONS 13 AND 24, TOWNSHIP 35 NORTH, RANGE 13 EAST, Fourth Principal Meridian, as described hereon.

History: There is no record of this corner having ever been previously established.

Description of monument and accessories I established to perpetuate the location of this corner:


At the point determined for the location of the corner I emplaced a:

GALVANIZED IRON PIPE, THREE FEET LONG, ONE INCH IN DIAMETER, WITH ALUMINUM CAP DENOTED AS, "KIMBERLY CLARK CORP. T35N W 1/16 BTWN. 13 & 24 SPERHAKE RLS 463 7/29/64."

The pipe is witnessed by:

- Poplar 7 N 12°W 23 links. (SCRIBED S 13 BT).
- Basswood 6 S 6°W 24 links. (SCRIBED S 24 BT).


Description as to how corner was located: Since both the section corner $\frac{1}{4}$ mile west and the quarter section corner $\frac{1}{4}$ mile east have been previously established with a distance between them of 39.63 chains, I set the W 1/16 corner $19.81\frac{1}{2}$ chains from either corner and on a straight line between them.

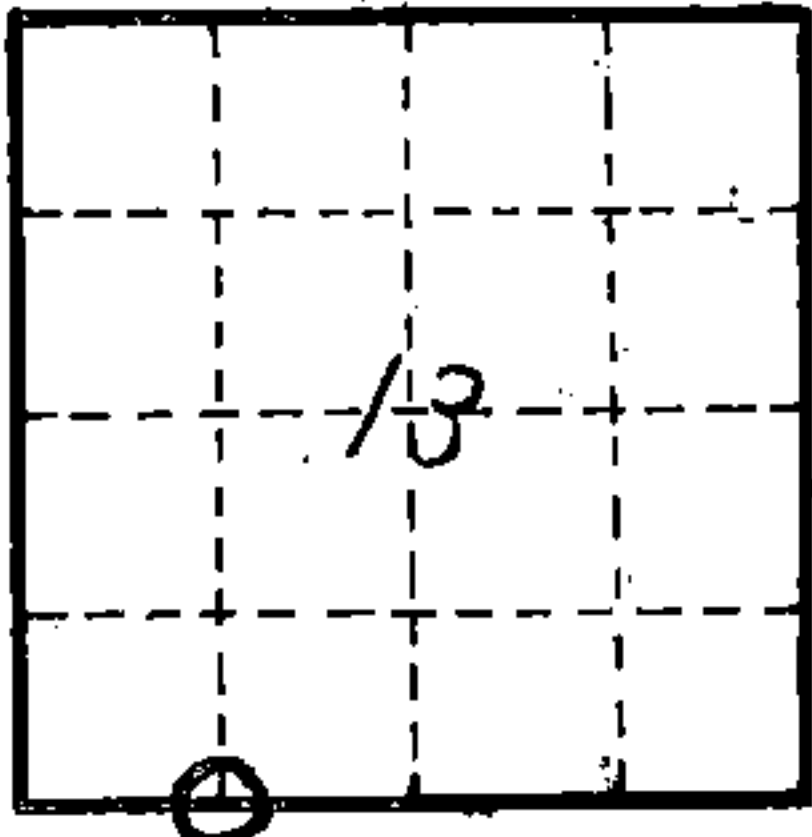

O = Corner monument restored

89591

REGISTRAR'S OFFICE
FOREST COUNTY, WIS.

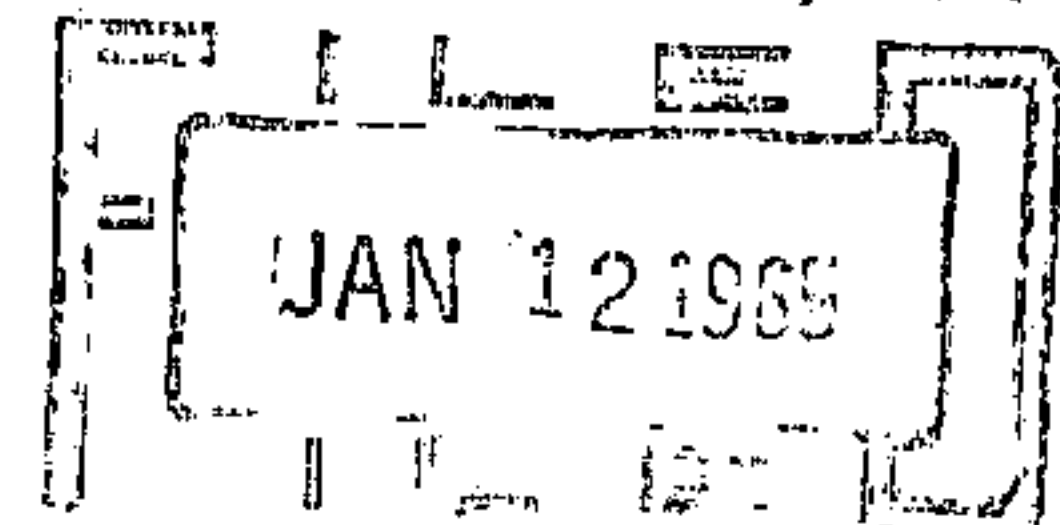

Anna Peterson

Resident witnesses _____

Dated at Crandon, Wisconsin, this 12th day of January, 1965.

Signature *Neal Sperhake*

Title Registered Land Surveyor Registration No. 463

~~Office of~~ Forest County ~~of~~ Wisconsin,

I hereby certify that the within instrument was ~~filed in the~~ ~~office for record~~ on the 12th day of January 1965, and was ~~filed in Book No.~~ signed and Page No. sworn to of ~~County Records~~ before me.

Surveyor's Seal

Signature *Anna Peterson* Title Notary Public

4351313 0030

Index No.

N22