

CERTIFIED LAND CORNER RESTORATION


Index No. RS 5

State of Wisconsin }
County of Forest } ss.

I Thomas R. Arnott, do hereby certify that on the 15 day of Nov., 1976, I found evidence of the section corner of sec. 19, 20, 29 & 30 Township 35, North, Range 13 E, Fourth Principal Meridian, as described hereon; and that from this evidence I established a new monument and accessories as described hereon to perpetuate the original location of this corner.

Resident witnesses:

.....
.....
.....

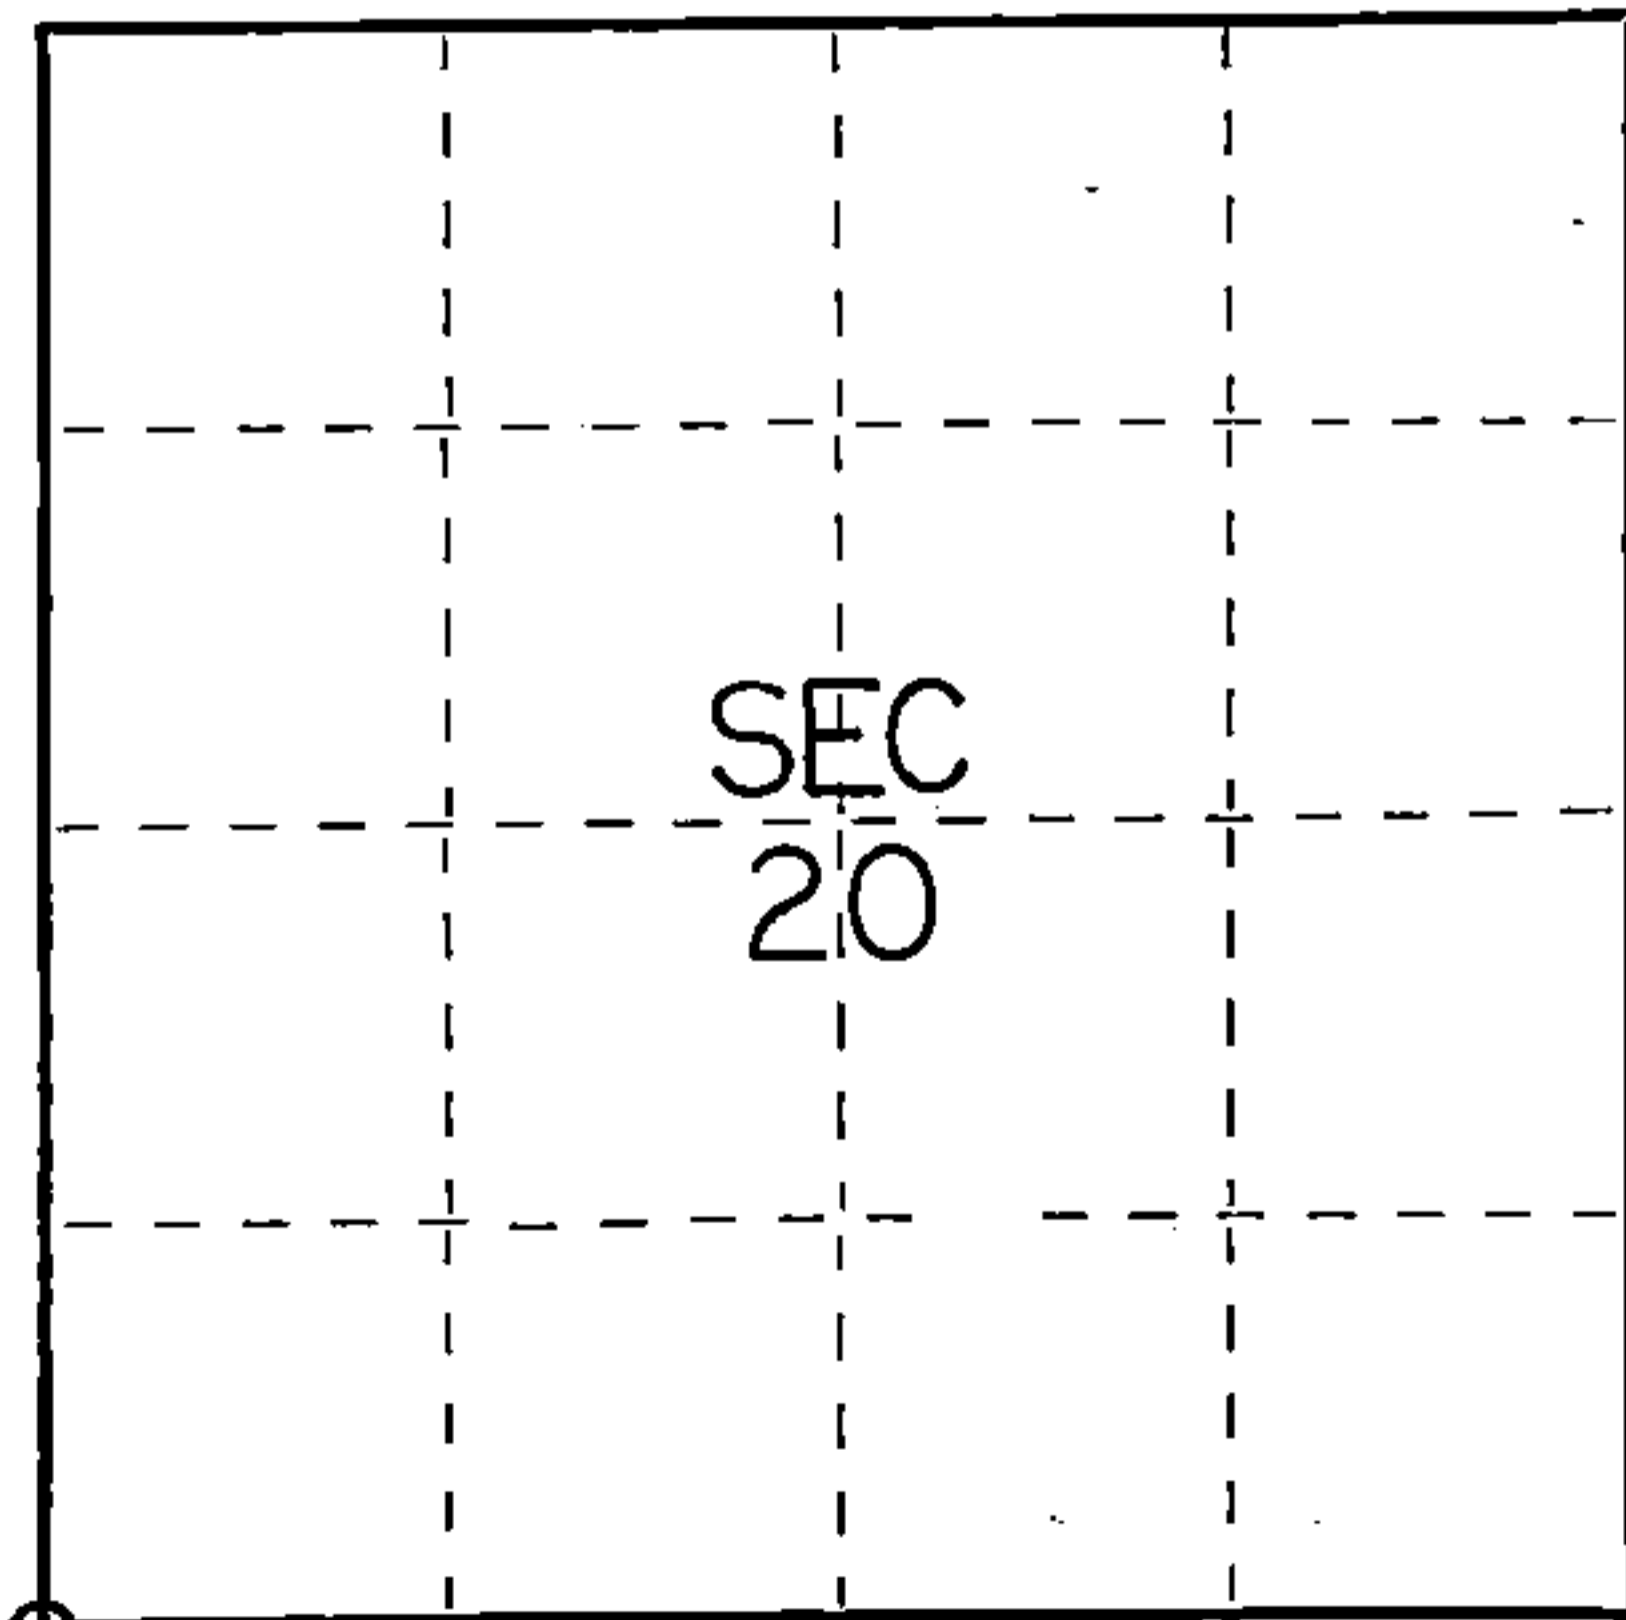

○ = Corner monument restored.

History of original corner establishment:

Original survey by James L. Nowlin Sept. 11 - Sept. 21, 1865.

Tamarac 3 S5E 17 Lks.
Tamarac 18 N67W 23 Lks.

Description of corner evidence found:

2" iron pipe 5' long with brass cap set by C.E. Walker in 1940.
Old wood post found

Description of monument and accessories I established to perpetuate the original location of this corner.

Left monument set by Walker.

Ties:

Cedar 6 N47E 9.49 feet
Cedar 8 S59E 6.73 feet
Cedar 8 S51W 15.40 feet



43513190000

Dated at Grandon, Wis., this 26 day of Nov., 1976.

Signature Thomas Arnott Title Surveyor Registration No. S-887
(County Surveyor, Registered Land Surveyor, or other duly authorized official)

Office of Register of Deeds, County of Forest, I hereby certify that the within instrument was filed in this office for record on the 26 day of Nov., 1976 at 3:30 o'clock P. M.

EUGENE STATEZNY

(Register of Deeds)

Document Number 110619

By Eileen Schmidt Deputy