

State of Wisconsin

County of FOREST

ss. ESTABLISHMENT OF QUARTER - QUARTER SECTION CORNER BETWEEN ORIGINAL GOVERNMENT SURVEY CORNERS.

I NEAL SPERHAKE, do hereby certify that on the THIRTIETH day of SEPTEMBER, 19 64, I established the EAST ONE SIXTEENTH CORNER BETWEEN SECTIONS 22 AND 27, TOWNSHIP 35 NORTH, RANGE 13 EAST, Fourth Principal Meridian, as described hereon.

History: There is no record of this corner having ever been previously established.

Description of monument and accessories I established to perpetuate the location of this corner:


At the point determined for the location of the corner I emplaced a:

GALVANIZED IRON PIPE, THREE FEET LONG, ONE INCH IN DIAMETER, WITH ALUMINUM CAP DENOTED AS, "KIMBERLY CLARK CORP. T35N E 1/16 BTWN. 22 & 27 R13E SPERHAKE RLS 463 9/30/64."

The pipe is witnessed by:


- Bass 5 N 20°W 96 links. (SCRIBED S22 BT).
- Elm 4 S 22°W 83 links. (SCRIBED S27 BT).

Description as to how corner was located: Since both the quarter section corner 1/4 mile west and the section corner 1/4 mile east have been previously established with a distance between them of 41.18 chains, the 1/16th. corner was set 20.59 chains from either corner and on a straight line between them.

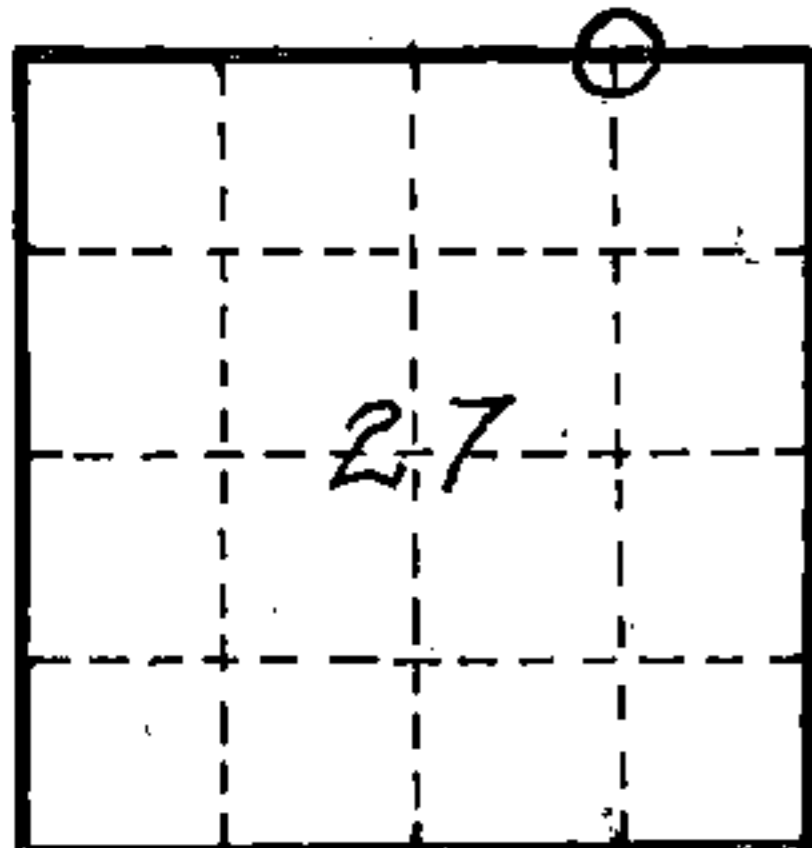

O = Corner monument restored

89609

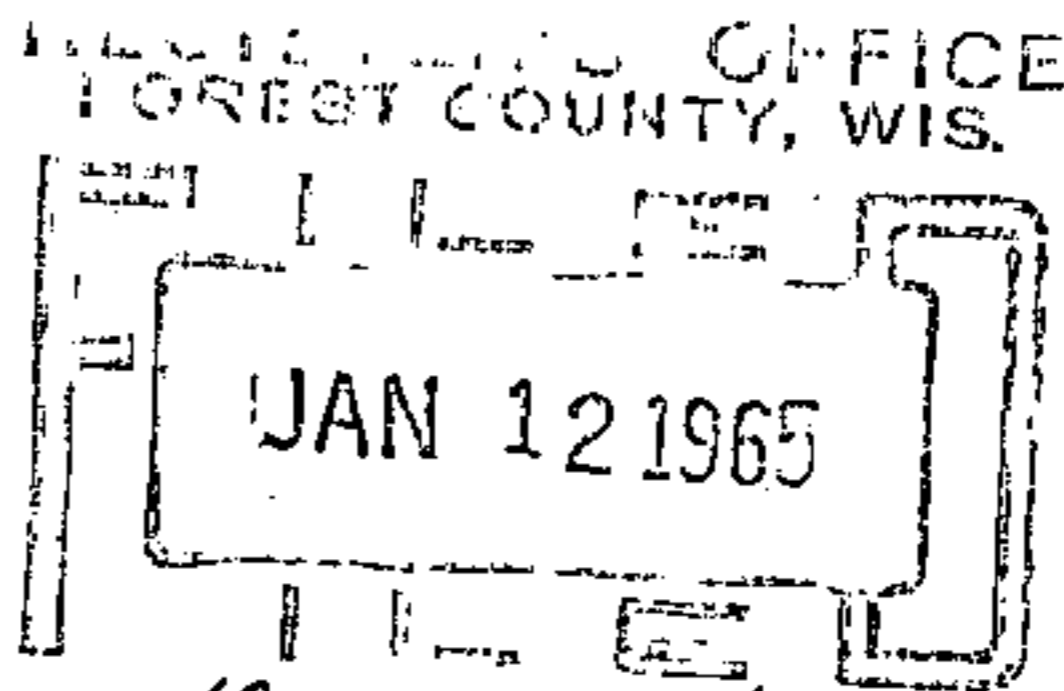

Resident witnesses _____

Dated at Crandon, Wisconsin, this 12th day of January, 19 65.

Signature Neal Sperhake

Title Registered Land Surveyor Registration No. 463

~~Office of~~ Forest County of ~~Wisconsin~~

I hereby certify that the within instrument was ~~filed in this~~ filed in this office for record, on the 12th day of January 19 65, and was ~~filed in Book No.~~ signed and Page No. sworn to of ~~County Records~~ before me.

Surveyor's Seal

Signature Anna Peterson Title Notary Public

43513220010

Index No. R16