

State of Wisconsin

County of FOREST

ss. ESTABLISHMENT OF QUARTER - QUARTER SECTION CORNER BETWEEN ORIGINAL GOVERNMENT SURVEY CORNERS.

I NEAL SPERHAKE, do hereby certify that on the SEVENTH day of OCTOBER, 1964, I established the SOUTH ONE SIXTEENTH CORNER BETWEEN SECTIONS 23 AND 24, TOWNSHIP 35 NORTH, RANGE 13 EAST, Fourth Principal Meridian, as described hereon.

History: There is no record of this corner having ever been previously established.

Description of monument and accessories I established to perpetuate the location of this corner:


At the point determined for the location of the corner I emplaced a:

GALVANIZED IRON PIPE, THREE FEET LONG, ONE INCH IN DIAMETER, WITH ALUMINUM CAP DENOTED AS, "KIMBERLY CLARK CORP. T35N S 1/16 BTWN. 23 & 24 R13E SPERHAKE RLS 463 10/7/64."

The pipe is witnessed by:

- Hemlock 16 S 26°W 47 links. (SCRIBED 1/16 S23 BT).
- Cherry 6 S 51°E 28 links. (SCRIBED 1/16 S24 BT).

Description as to how corner was located: Since both the quarter section corner 1/4 mile north and the section corner 1/4 mile south have both been previously established with a distance between them of 39.81 chains, the 1/16th. corner was set 19.90 1/2 chains from either corner and on a straight line between them.

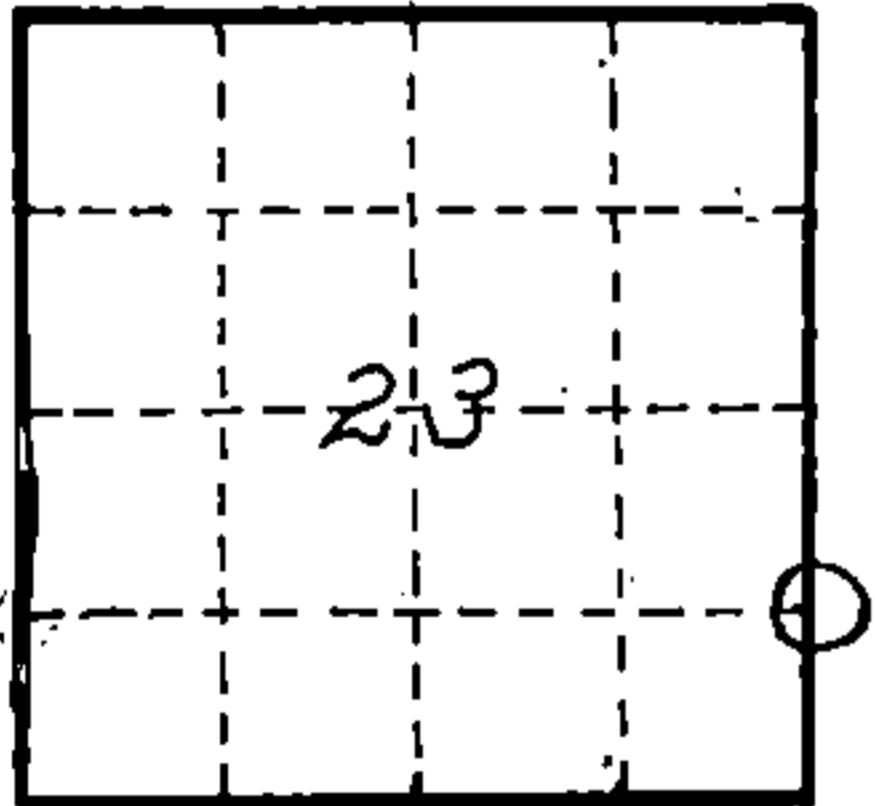

O = Corner monument restored

89595

REGISTERED OFFICE
FOREST COUNTY, WIS.
FILE
JAN 12 1965
FILE
10 o'clock A.M.
Anna Peterson Register of Deeds

Resident witnesses _____

Dated at Crandon, Wisconsin, this 12th day of January, 19 65

Signature Neal Sperhake

Title Registered Land Surveyor Registration No. 463

~~Office of~~ Forest County of Wisconsin, I hereby certify that the within instrument was ~~filed in the~~ filed in the ~~office for record~~ on the 12th day of January 1965, and was ~~filed in Book No.~~ signed and ~~Page No.~~ sworn to ~~in County records~~ before me.

Surveyor's Seal

Signature Anna Peterson Title Notary Public

43513231000

Index No. 021