

State of Wisconsin
County of FOREST

ss. ESTABLISHMENT OF QUARTER - QUARTER SECTION CORNER BETWEEN ORIGINAL GOVERNMENT SURVEY CORNERS.

I NEAL SPERHAKE, do hereby certify that on the THIRTIETH day of SEPTEMBER, 19 64, I established the EAST ONE SIXTEENTH CORNER BETWEEN SECTIONS 24 AND 25, TOWNSHIP 35 NORTH, RANGE 13 EAST, Fourth Principal Meridian. as described hereon.

History: There is no record of this corner having ever been previously established.

Description of monument and accessories I established to perpetuate the location of this corner:


At the point determined for the location of the corner I emplaced a:

GALVANIZED IRON PIPE, THREE FEET LONG; ONE INCH IN DIAMETER, WITH ALUMINUM CAP DENOTED AS, "KIMBERLY CLARK CORP. T35N E 1/16 BTWN. 24 & 25 R13E SPERHAKE RLS 463 9/30/64."

The pipe is witnessed by:

- Maple 8 N 6°E 77 links. (SCRIBED S24 BT).
- B. Cherry 4 S 2°W 41½ links. (SCRIBED S25 BT).


Description as to how corner was located: Since both the quarter section corner ¼ mile west and the section corner ¼ mile east have been previously established with a distance between them of 40.35 chains, the E 1/16th. corner was set 20.17½ chains from either corner and on a straight line between them.

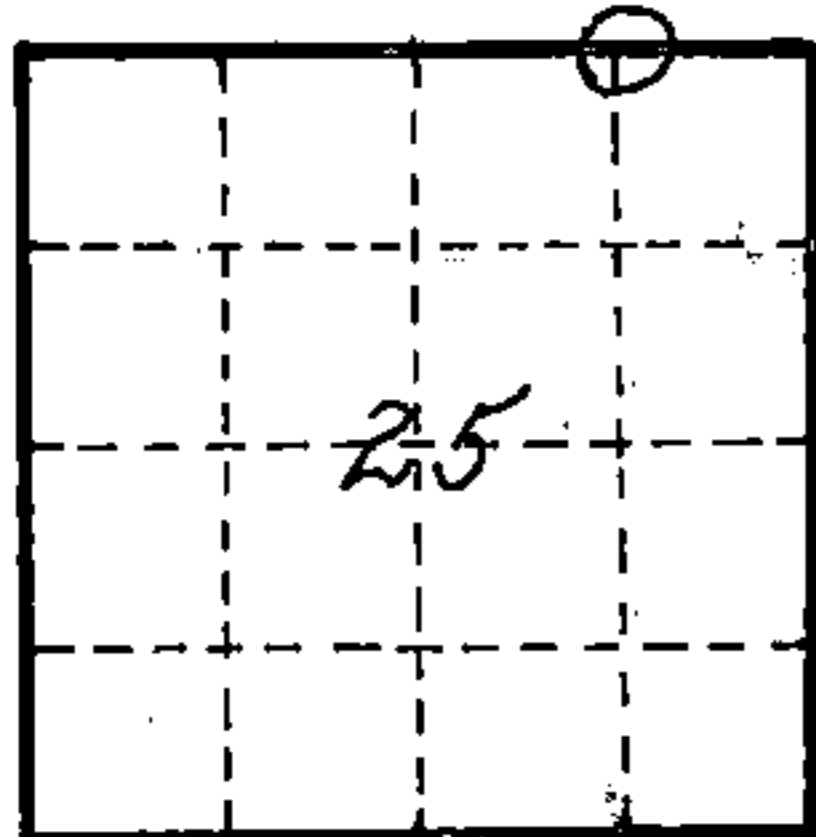

O = Corner monument restored

89601

REGISTERED LAND OFFICE
FOREST COUNTY, WIS.

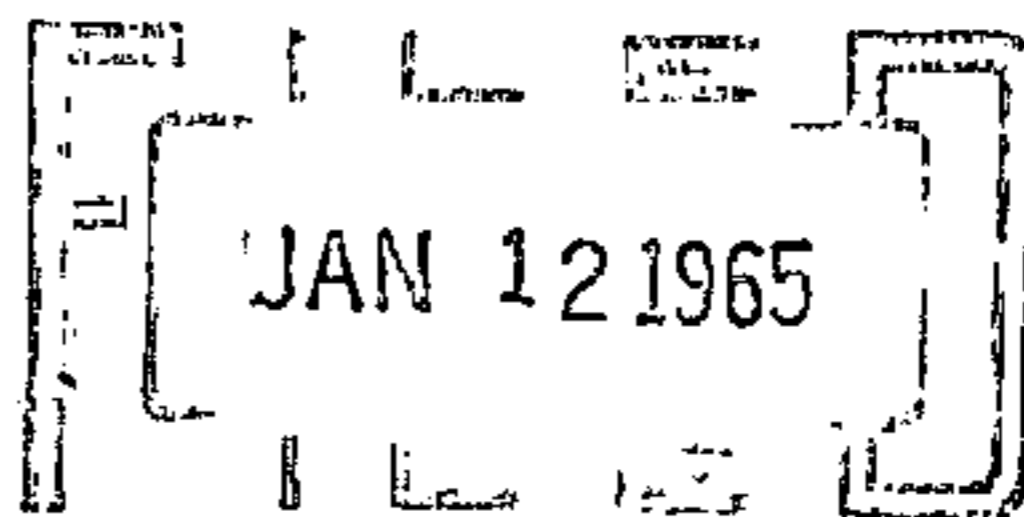

11.10 o'clock A.M.
Anna Peterson, Register of Deeds

Resident witnesses _____

Dated at Crandon, Wisconsin, this 12th day of January, 19 65.

Signature Neal Sperhake

Title Registered Land Surveyor Registration No. 463

Office of Forest County of Wisconsin,

I hereby certify that the within instrument was filed in the office for record on the 12th day of January 19 65, and was filed in Book No. signed and Page No. sworn to of County Records before me.

Surveyor's Seal

Signature Anna Peterson Title Notary Public

43513240010

Index No. **R24**