

ESTABLISHMENT OF QUARTER - QUARTER SECTION CORNER BETWEEN ORIGINAL GOVERNMENT SURVEY CORNERS

Index No. 107 U25  
U2!

STATE OF WISCONSIN

I NEAL SPERHAKE, do hereby certify that on the TWELFTH day of OCTOBER, 1962, I established the SOUTH ONE SIXTEENTH CORNER BETWEEN SECTIONS 25, TOWNSHIP 35 NORTH, RANGE 13 EAST, AND 30, TOWNSHIP 35 NORTH, RANGE 14 EAST, Fourth Principal Meridian, as described hereon.

Resident Witnesses:

Stanley Novak - Laona.  
Richard Piontek - Waubeno.  
David Pichotta - Waubeno.

This corner can also be described as either the South 1/8th, or the South Quarter-Quarter Section Corner between Sections 25, T35N-R13E, and 30, T35N-R14E, 4th P.M.

History:

There is no record of this corner having ever been previously established.

Description of monument and accessories I established to perpetuate the location of this corner.

At the point determined for the location of the corner I emplaced a:


"GALVANIZED IRON PIPE, THREE FEET LONG, ONE INCH IN DIAMETER, WITH AN ALUMINUM CAP DENOTED AS, 'KIMBERLY-CLARK CORP T35N S 1/16 BTWN 25 & 30 R13-14E SPERHAKE RLS 463 10-12-62".

The pipe is witnessed by:

Balsam 6 S45°E 9 links. (Scribed S30 BT).  
Maple 5 N83°W 16 links. (Scribed S25 BT).

Description as to how corner was located:

Since both the quarter section corner one quarter mile north, and the section corner one quarter mile south have been previously established, with a distance between them of 41.37 chains, the 1/16th cr. was set 20.68½ chains from either corner on a straight line between them

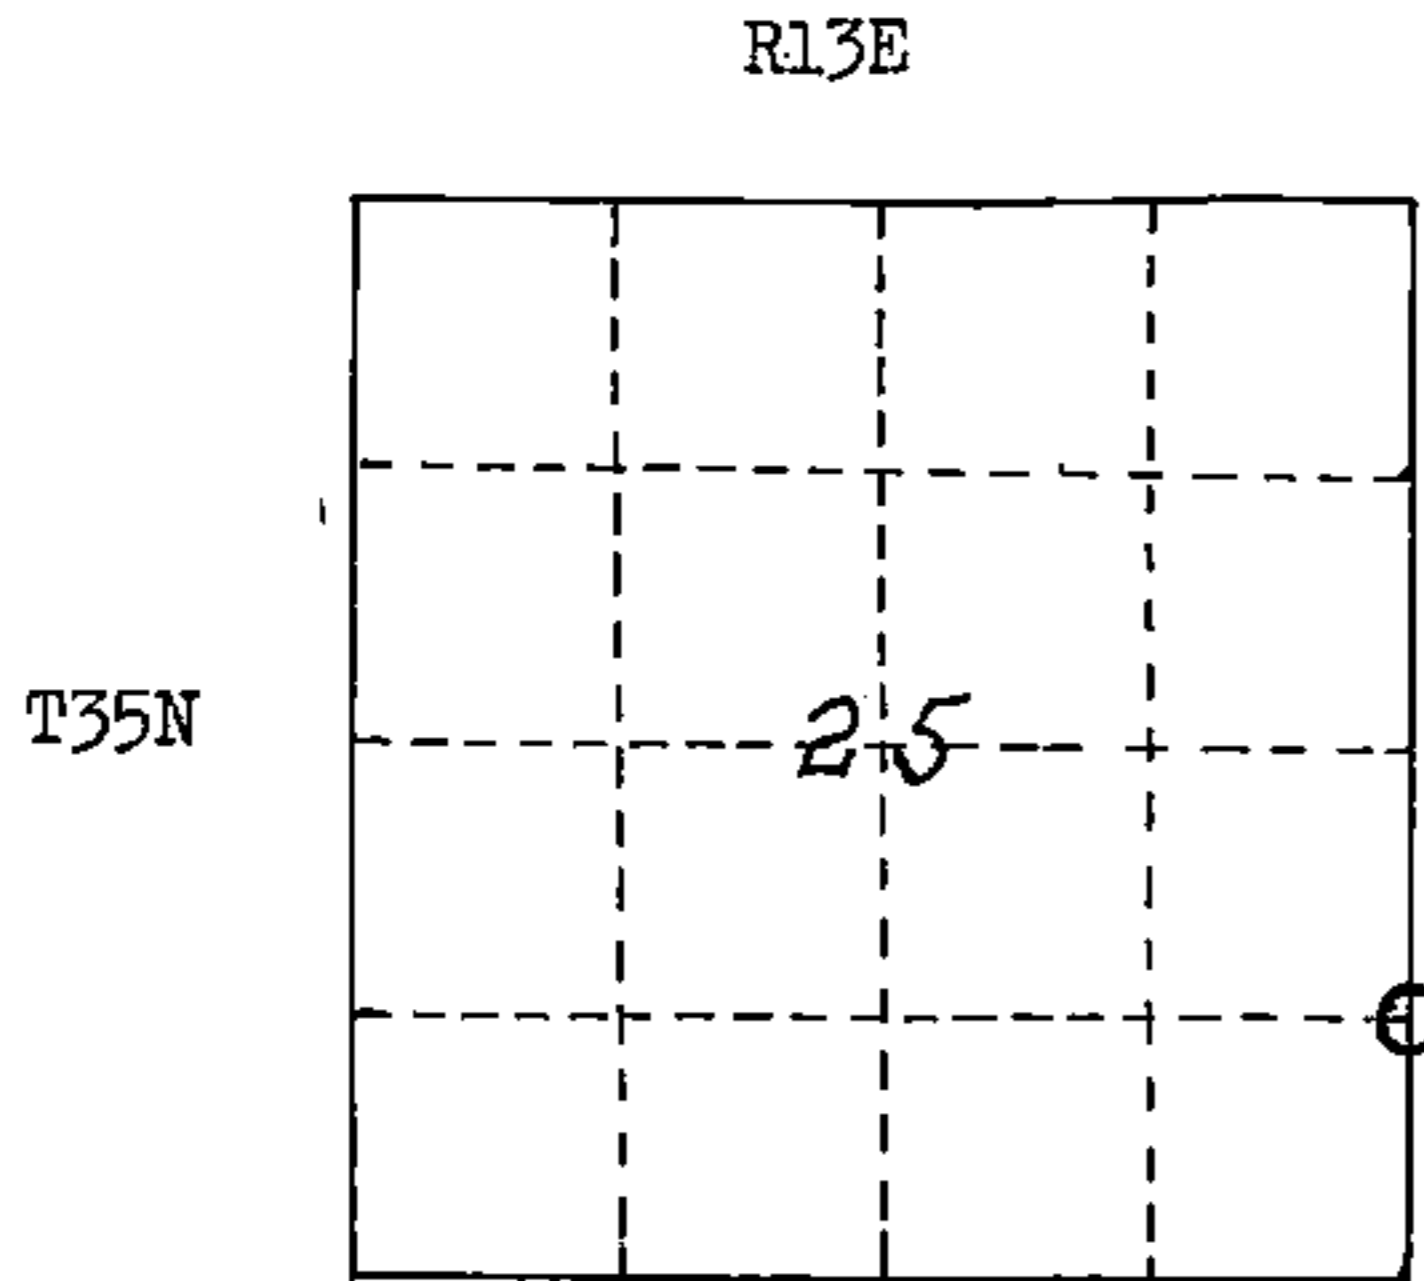

○ = Corner Monument Restored

Dated at Crandon, Wis., this 11th day of Feb., 19 63

Signature Neal Sperhake Title Registered Land Surveyor Registration No. S-463

Office of Register of Deeds, County of Forest, I hereby certify that the within instrument was filed in this office for record on the 11th day of Feb., 19 63

at 10 o'clock A M.

86836

Anna Peterson  
(Register of Deeds)

By \_\_\_\_\_ Deputy

Surveyors Seal

43513251000

Subscribed & sworn to before me this 11th day of Feb. 1963  
Anna Peterson  
Notary Public, Forest Co., Wis - Comm. expires 10/31/65