

State of Wisconsin

County of FOREST

ss. ESTABLISHMENT OF QUARTER - QUARTER SECTION CORNER BETWEEN ORIGINAL GOVERNMENT SURVEY CORNERS.

I NEAL SPERHAKE, do hereby certify that on the TWENTIETH day of OCTOBER, 19 64, I established the EAST ONE SIXTEENTH CORNER BETWEEN SECTIONS 27 AND 34, TOWNSHIP 35 NORTH, RANGE 13 EAST, Fourth Principal Meridian, as described hereon.

History: There is no record of this corner having ever been previously established.

Description of monument and accessories I established to perpetuate the location of this corner:


At the point determined for the location of the corner I emplaced a:

GALVANIZED IRON PIPE, THREE FEET LONG, ONE INCH IN DIAMETER, WITH ALUMINUM CAP DENOTED AS, "KIMBERLY CLARK CORP. T35N E 1/16 BTWN. 27 & 34 R13E SPERHAKE RLS 463 10/20/64."

The pipe is witnessed by:

- Hemlock 13 N 68°E 40 1/2 links. (SCRIBED S27 BT).
- Maple 9 S 30°E 21 links. (SCRIBED S34 BT).


Description as to how corner was located: Since both the quarter section corner 1/4 mile west and the section corner 1/4 mile east have been previously established with a distance between them of 40.65 1/2 chains, the 1/16th. corner was set 20.32 3/4 chains from either corner and on a straight line between them.

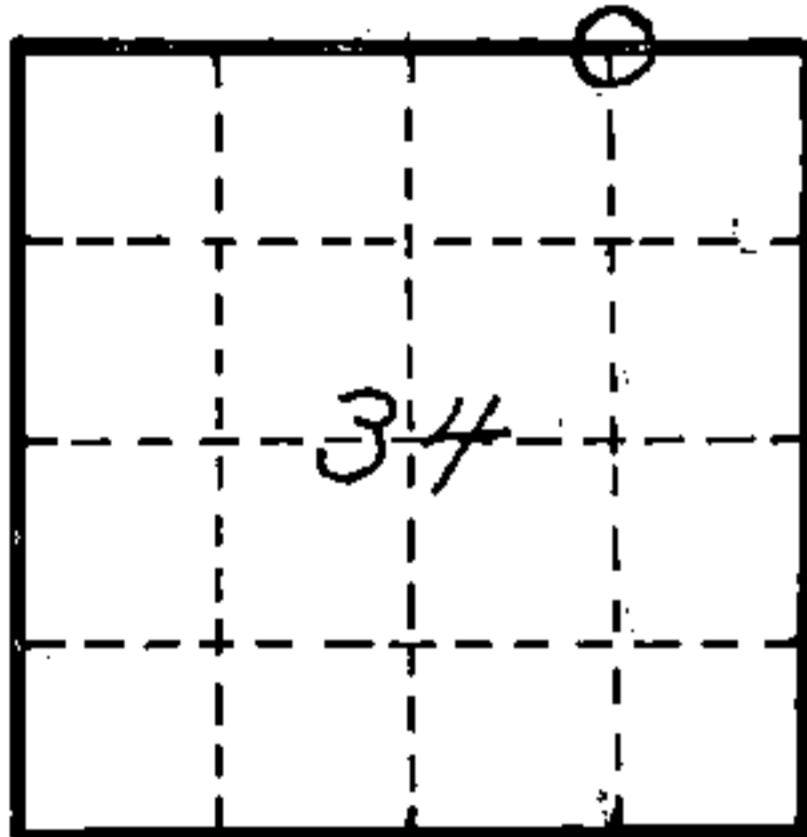

O = Corner monument restored

89613

NOTARY PUBLIC OFFICE FOREST COUNTY, WIS.

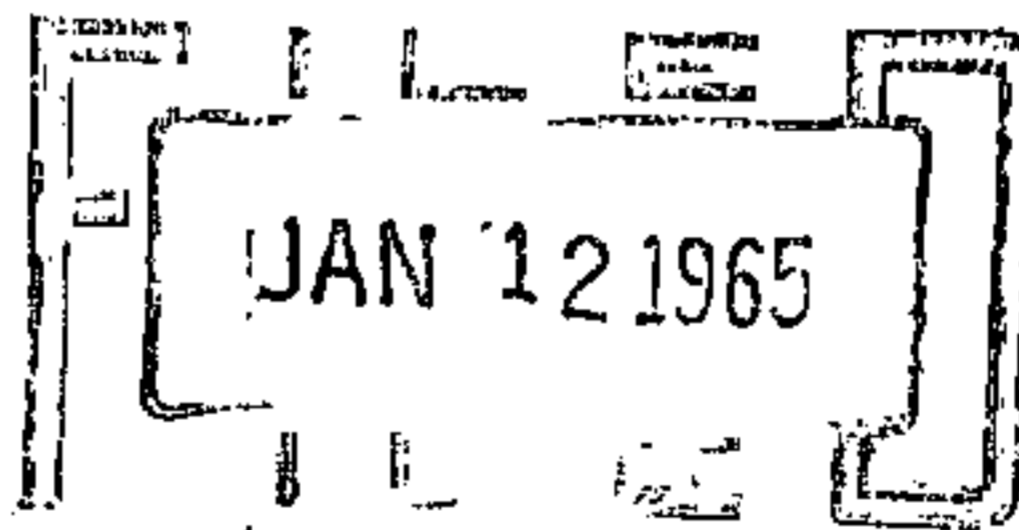

Anna Peterson, Notary Public

Resident witnesses _____

Dated at Crandon, Wisconsin, this 12th day of January, 19 65.

Signature Neal Sperhake

Title Registered Land Surveyor Registration No. 463

~~State of~~ Forest County ~~of~~ Wisconsin

I hereby certify that the within instrument was ~~filed for record~~ filed for record on the 12th day of January 1965, and was ~~filed in Book No.~~ signed and ~~Page No.~~ sworn to ~~in County Records.~~ before me.

Surveyor's Seal

Signature Anna Peterson Title Notary Public

43513270010

Index No. V116