

CERTIFIED LAND CORNER RESTORATION

Index No. V-5-5

State of Wisconsin }
County of Forest } ss.

History of original corner establishment:

Original Subdivision by James L. Nowlin Sept. 11 - Sept 21, 1865

Lind 12 N32W 10 Lks.
Lind 14 N56E 27 Lks.

I Thomas R. Arnott, do hereby certify that on the 20th day of September, 1975, I found evidence of the section corner of sections 29, 30, 31 & 32 Township 35, North, Range 13 E, Fourth Principal Meridian, as described hereon; and that from this evidence I established a new monument and accessories as described hereon to perpetuate the original location of this corner.

Description of corner evidence found:

2" iron pipe 5' long with brass cap set by C.E. Walker in 1940

Resident witnesses:

Herbert Wagoner

Description of monument and accessories I established to perpetuate the original location of this corner.


Left monument set by Walker:

Ties:

Maple 8" N70W 18.82 feet
Maple 6" S4E 18.60 feet (BT found)
Maple 8" S74W 32.22 feet (BT found)



FORM 985 H. C. MILLER CO., MILWAUKEE

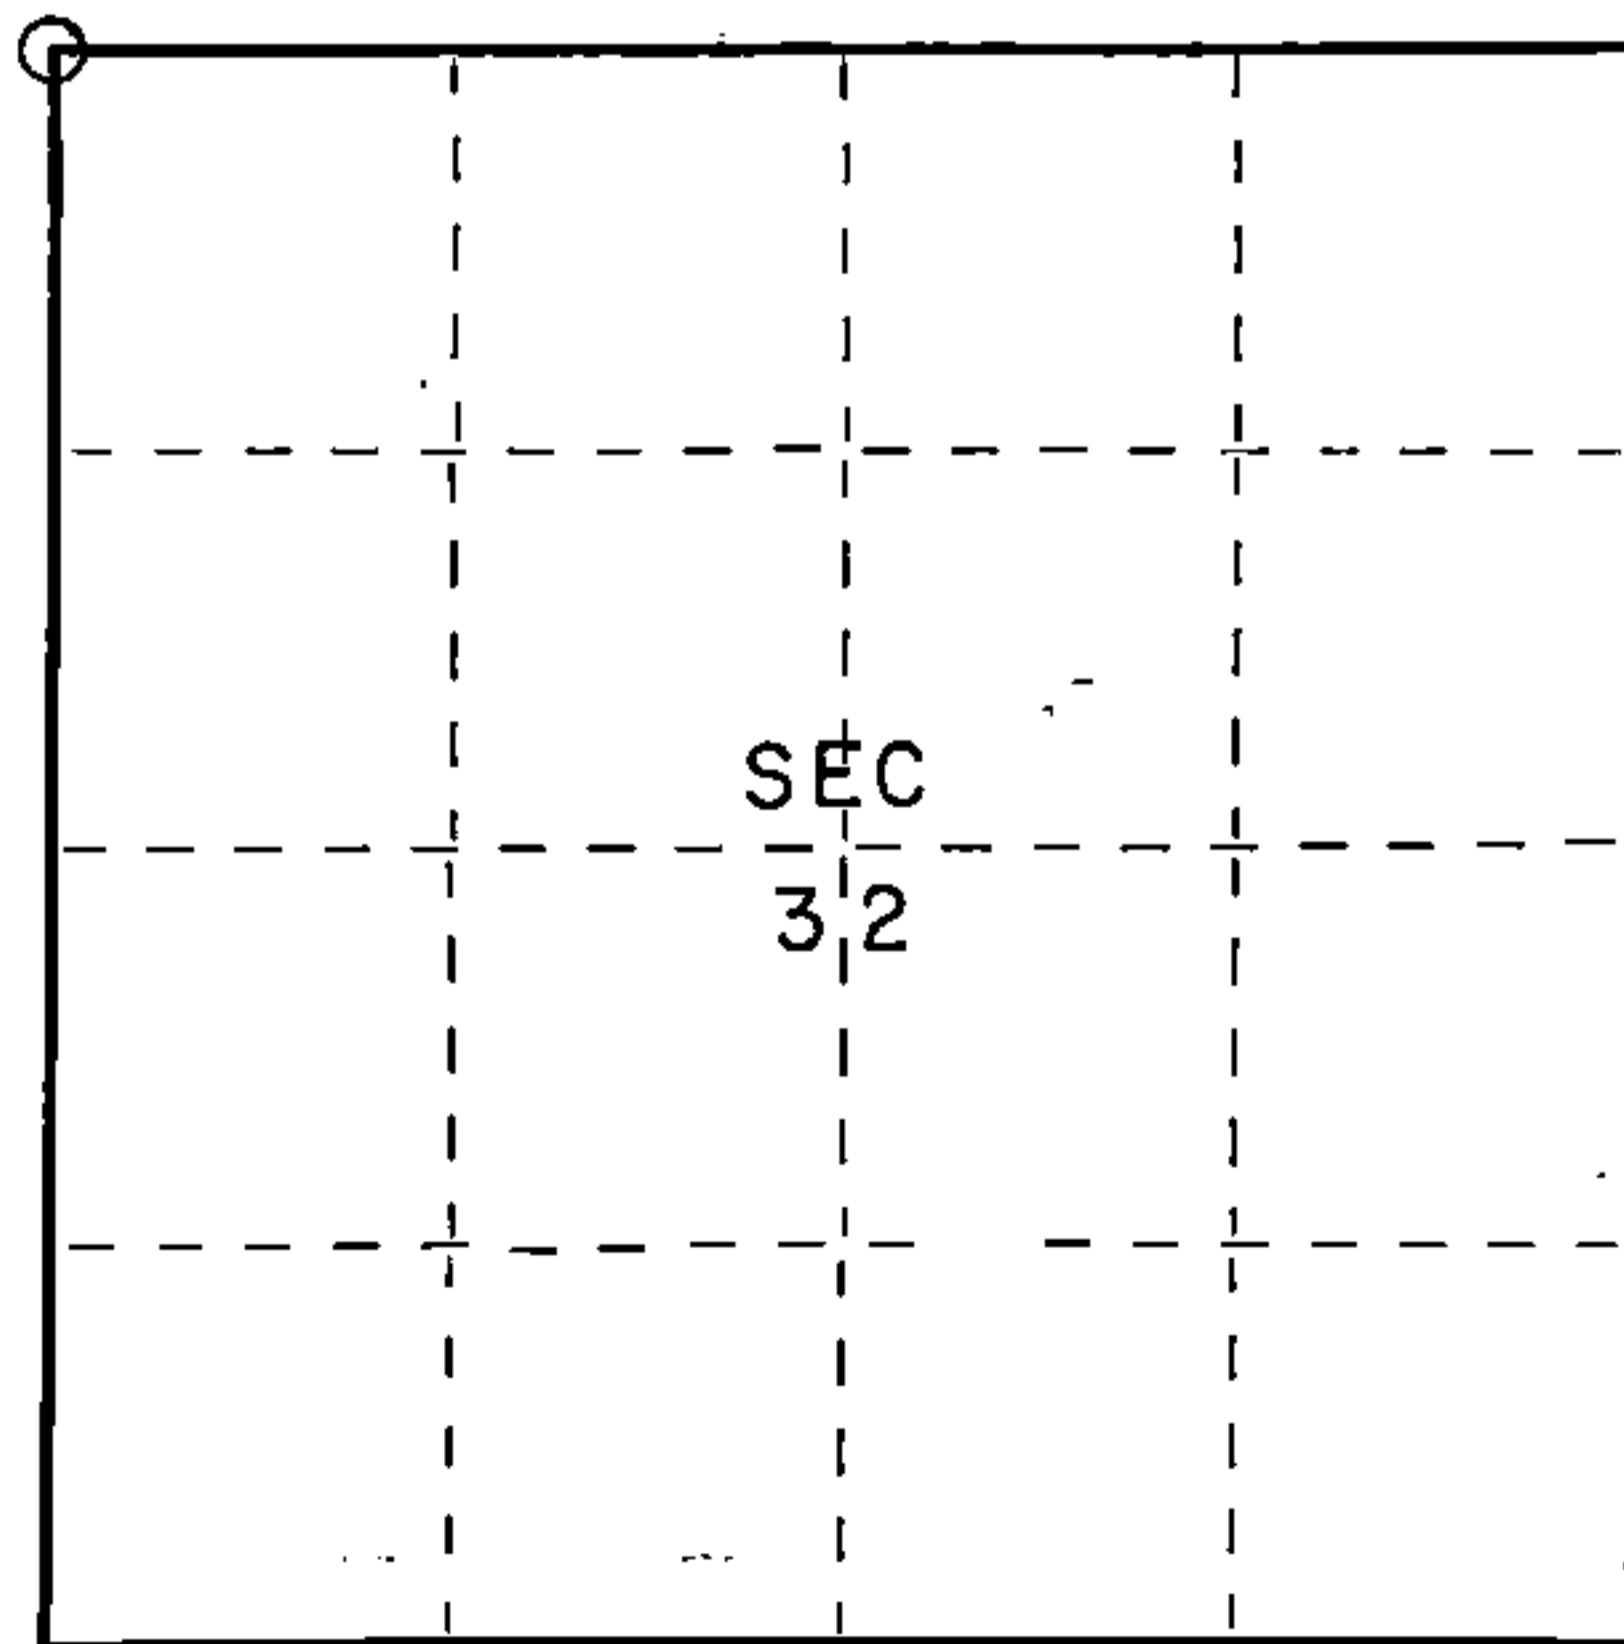

○ = Corner monument restored.

Dated at Crandon, Wis., this 30th day of October, 1975.

Signature Thomas R. Arnott Title Land Surveyor Registration No. S-887
(County Surveyor, Registered Land Surveyor, or other duly authorized official)

Office of Register of Deeds, County of Forest, I hereby certify that the within instrument was filed in this office for record on the 30th day of October, 1975 at 1 o'clock P. M.

Eugene Stutzman Document Number 108111
(Register of Deeds)

By _____ Deputy

43513300000