

CERTIFIED LAND CORNER RESTORATION

Index No. TS5


State of Wisconsin }
County of Forest } ss.

I Thomas R. Arnott, do hereby certify that on the 25 day of Oct., 1976, I found evidence of the 1/4 corner of sec. 29 & 30 Township 35, North, Range 13 E, Fourth Principal Meridian, as described hereon; and that from this evidence I established a new monument and accessories as described hereon to perpetuate the original location of this corner.

Resident witnesses:

.....
.....
.....

FORM 985 H. C. MILLER CO., MILWAUKEE

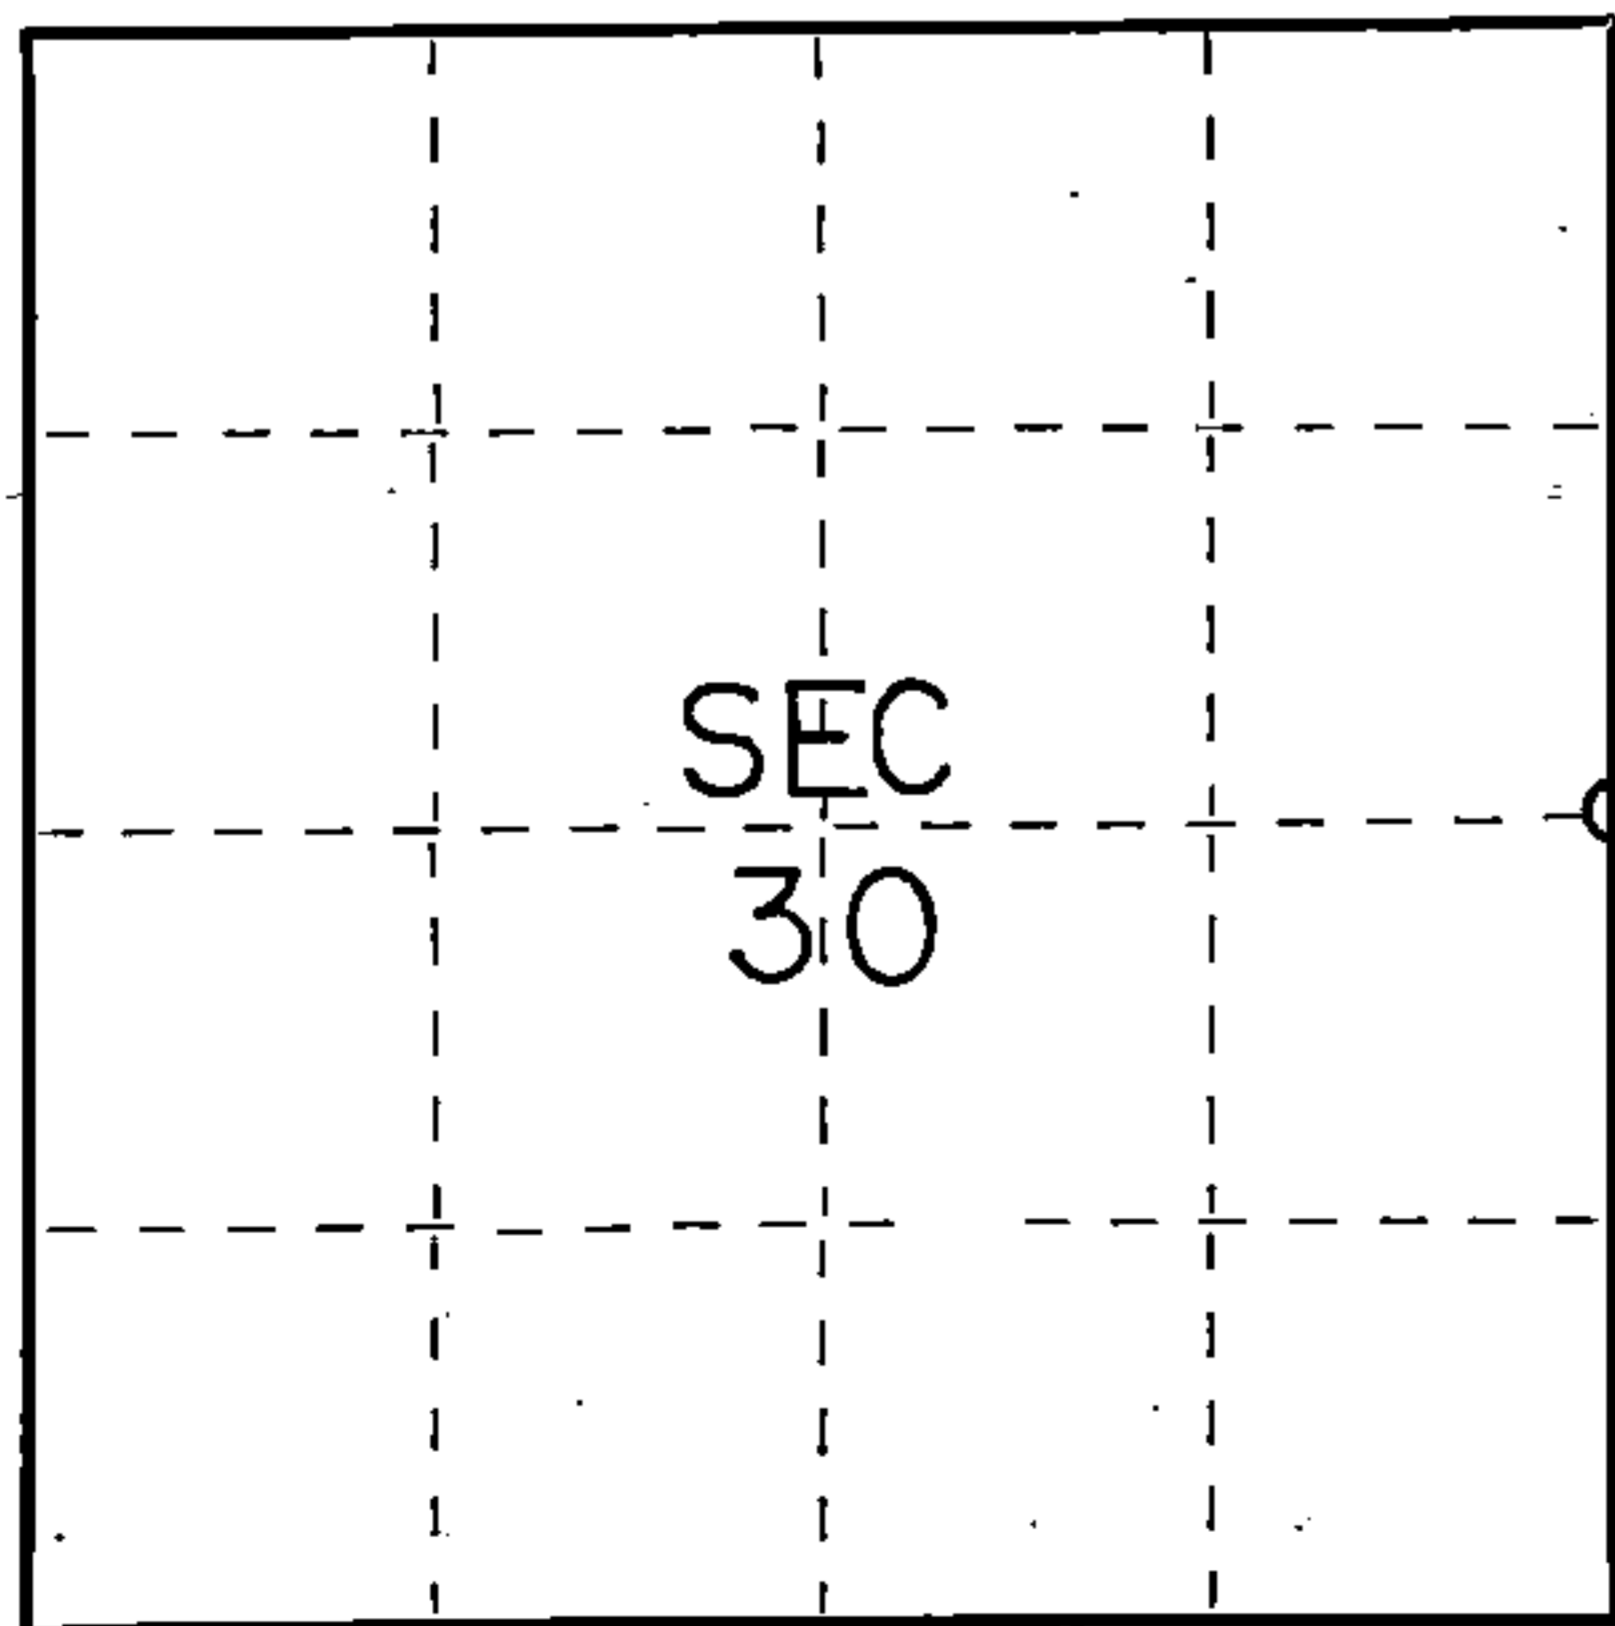

○ = Corner monument restored.

History of original corner establishment:

Original survey by James L. Nowlin Sept. 11 - Sept. 21, 1865

Birch 8 S30E 10 Lks.
Cedar 12 N35W 35 Lks.

Description of corner evidence found:


2" iron pipe 5' long with brass cap set by C.E. Walker in 1940.

Description of monument and accessories I established to perpetuate the original location of this corner.

Left monument set by Walker.

Ties:

Maple 16 S24E 22.76 feet
Spruce 14 S58W 31.76 feet

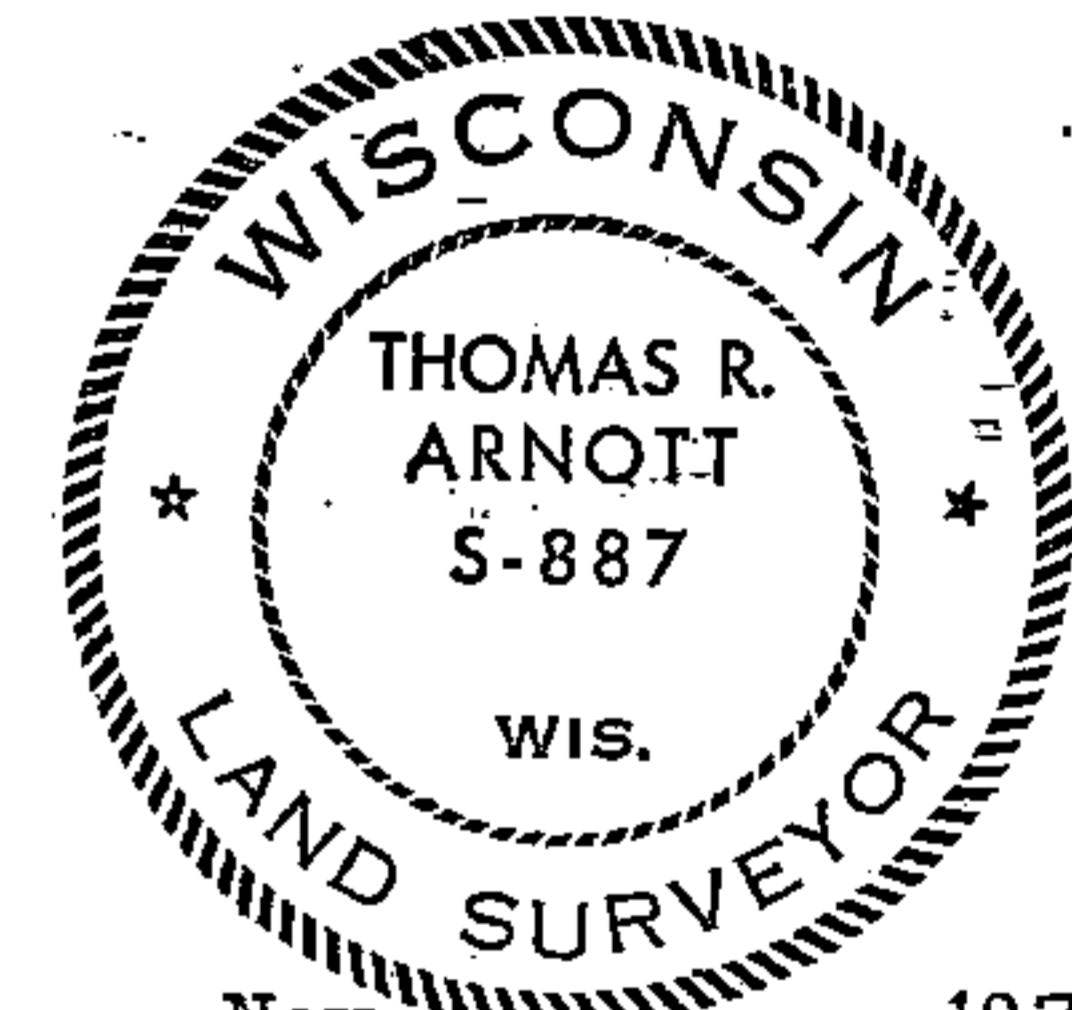

Dated at Crandon, Wis., this 26 day of Nov., 1976.

Signature _____ Title Surveyor Registration No S-887
(County Surveyor, Registered Land Surveyor, or other duly authorized official)

Office of Register of Deeds, County of Forest, I hereby certify that the within instrument was filed in this office for record on the 26 day of Nov., 1976 at 3:30 o'clock P.M.

EUGENE STATEZNY

(Register of Deeds)

Document Number **110623**

By Eileen Schmidt Deputy

43513302000