

CERTIFIED LAND CORNER RESTORATION

Index No. 2755


State of Wisconsin }  
County of Forest } ss.

I Thomas R. Arnott, do hereby certify that on the 21st day of September, 1975, I found evidence of the section corner of sections 5, 6, 31, & 32 Township 34 - 35, North, Range 13 E, Fourth Principal Meridian, as described hereon; and that from this evidence I established a new monument and accessories as described hereon to perpetuate the original location of this corner.

Resident witnesses:

Herbert Wagoner

FORM 985 H. G. MILLER CO., MILWAUKEE

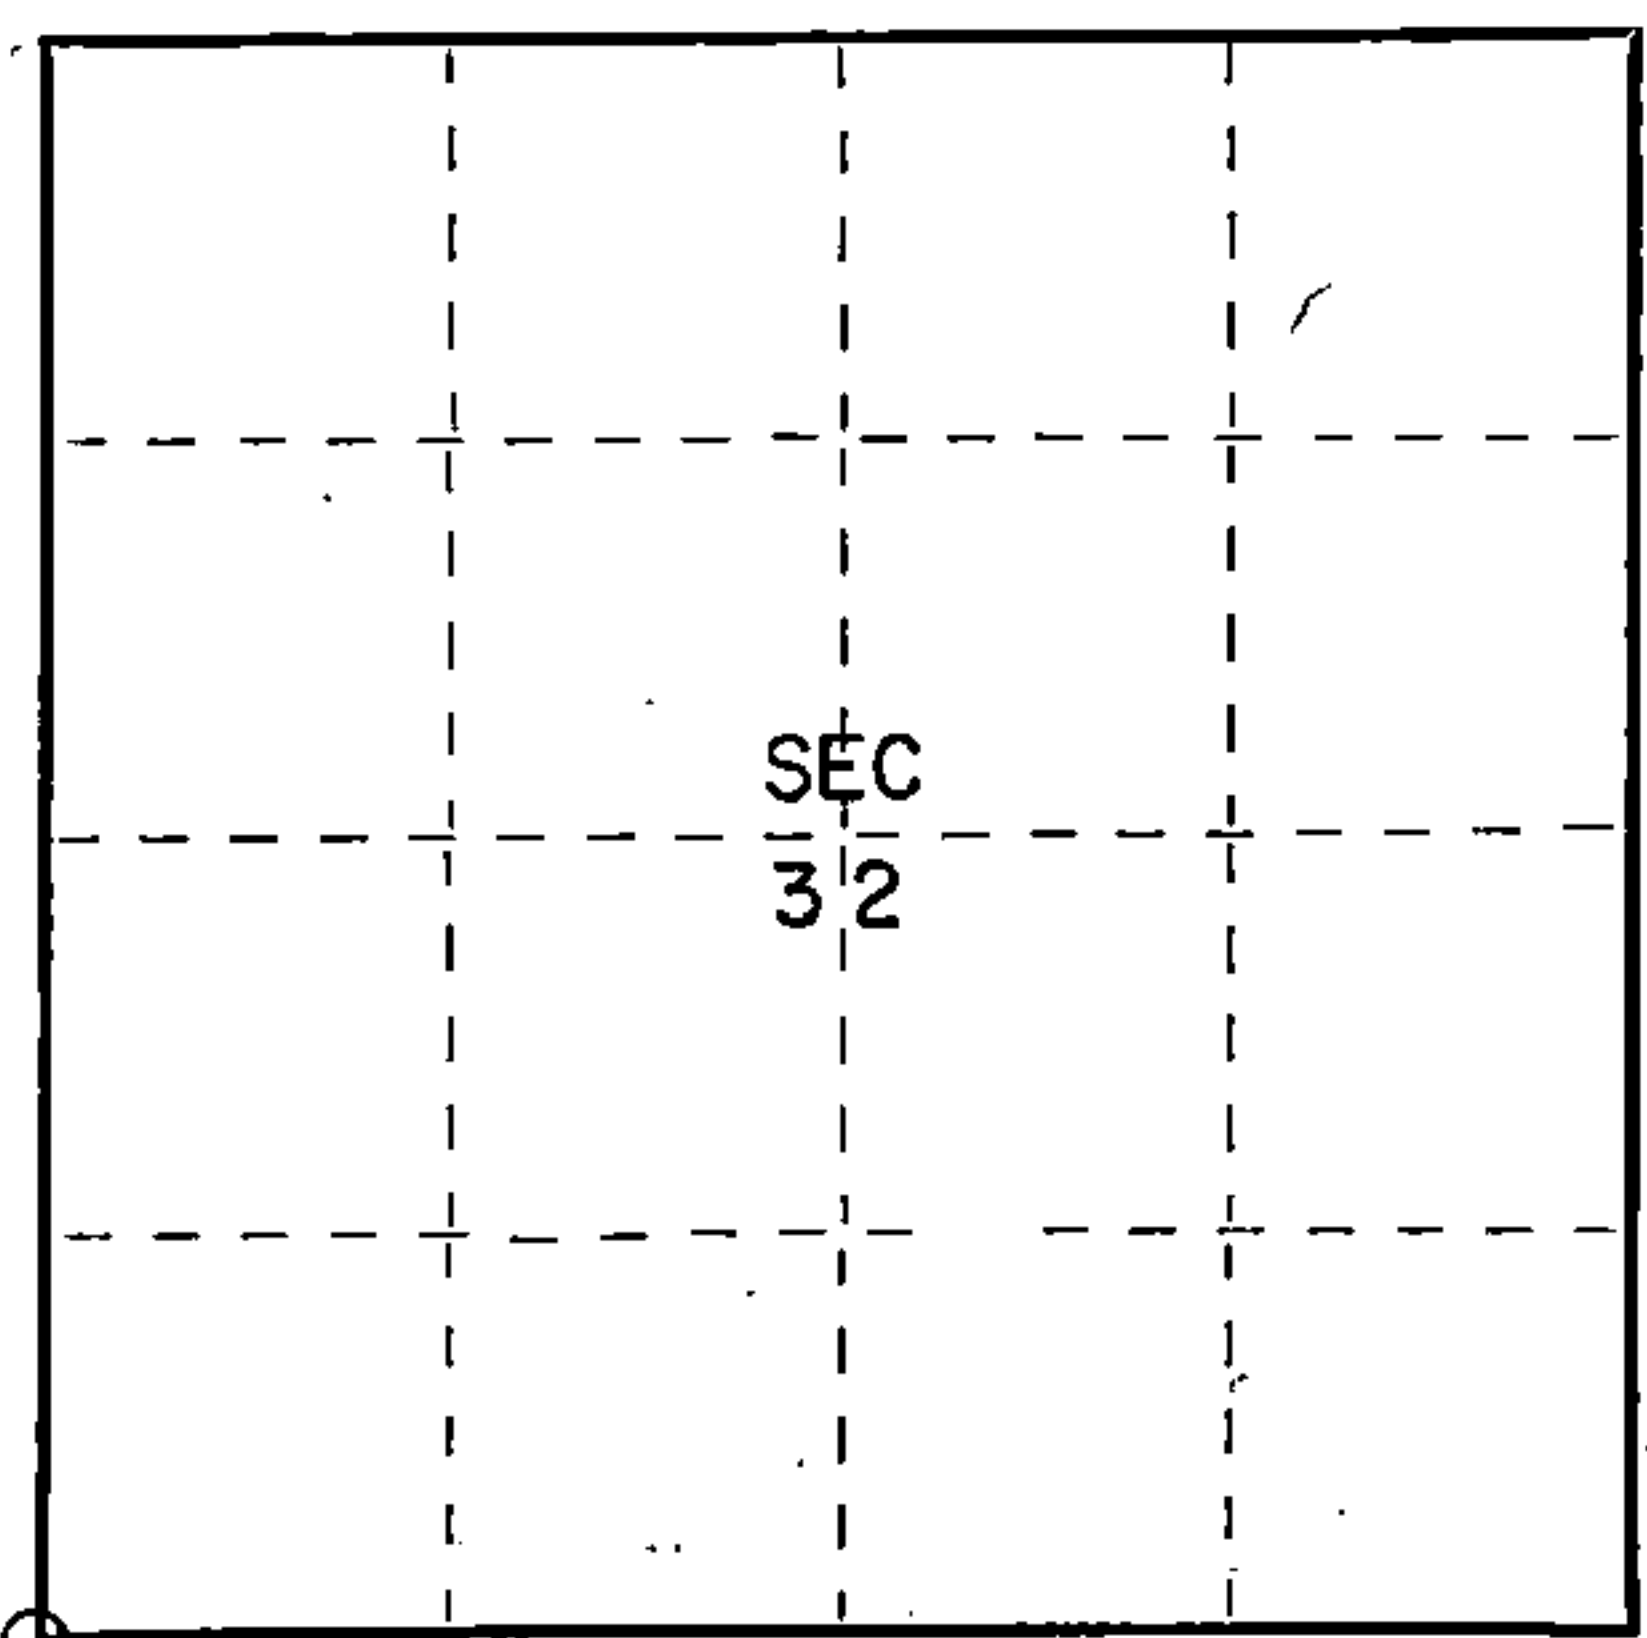

○ = Corner monument restored.

History of original corner establishment:

Elm	12	N75E	27 Lks.
Y. Birch	14	N35W	57 Lks.
Elm	12	S54W	19 Lks.
Sugar	18	S75E	15 Lks.

Description of corner evidence found:


2" iron pipe found  
wood post found

Description of monument and accessories I established to perpetuate the original location of this corner.

Reset corner with new Forest County aluminum monument

Ties:

Maple	6"	N8E	21.00 feet
Maple	6"	S76E	12.71 feet (BT found)
Elm	6"	S76W	9.35 feet (BT found)

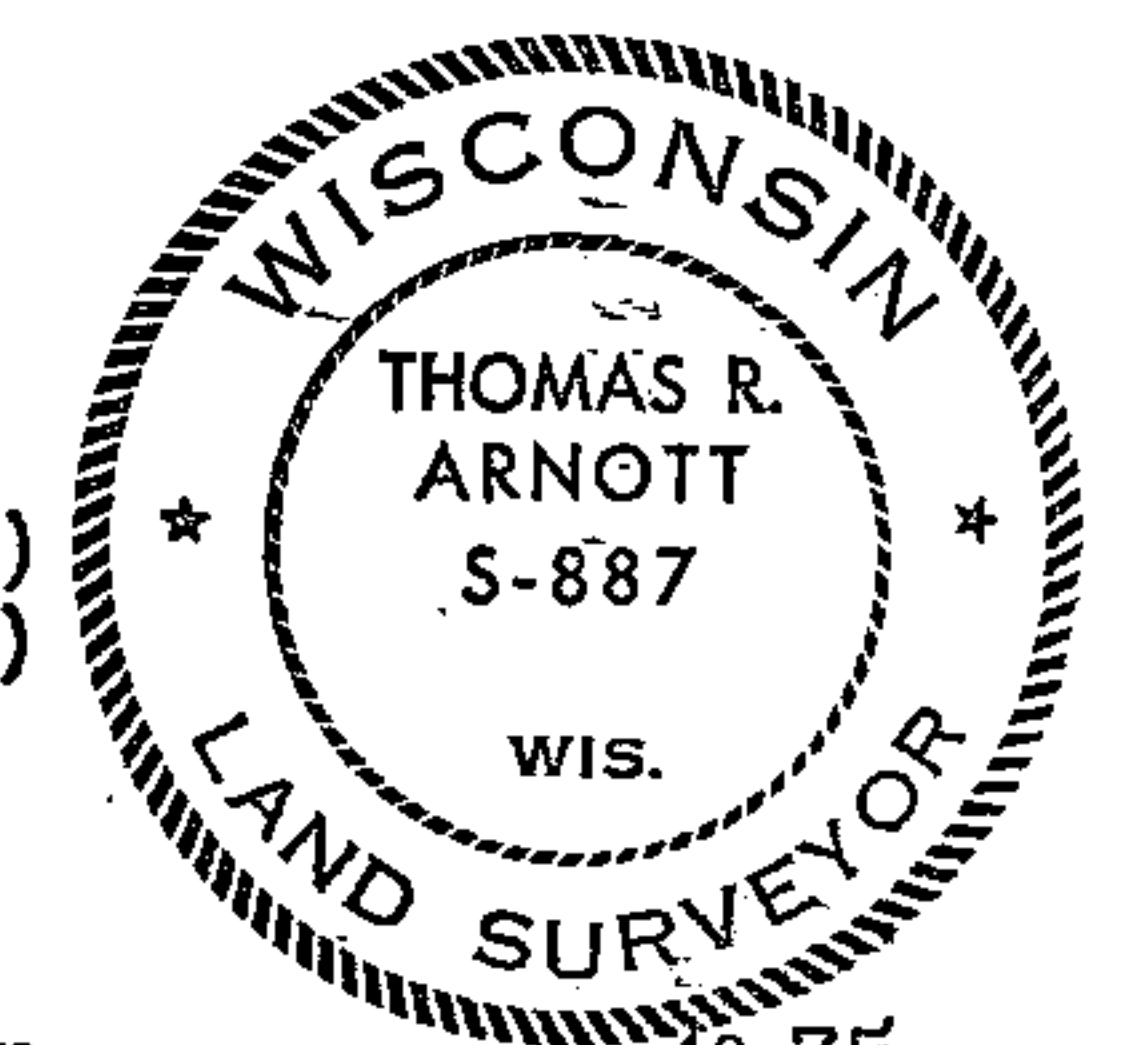

A 351331 0000

Dated at Crandon, Wis., this 30th day of October, 1975.

Signature Thomas R. Arnott Title Land Surveyor Registration No. S-887  
(County Surveyor, Registered Land Surveyor, or other duly authorized official)

Office of Register of Deeds, County of Forest, I hereby certify that the within instrument was filed in this office for record on the 30th day of October, 1975 at 3 o'clock P.M.

Eugene Staszny Document Number 108127  
(Register of Deeds)

By \_\_\_\_\_ Deputy