

STATE OF WISCONSIN

I NEAL SPERHAKE, do hereby certify that on the ELEVENTH day of DECEMBER, 1962, I restored the SOUTHWEST SECTION CORNER of SECTION 36, TOWNSHIP 35 NORTH, RANGE 13 EAST, Fourth Principal Meridian, as described hereon.

Resident Witnesses:

Richard Piontek - Waubeno.

History of original corner establishment:

This corner was established during the original survey of this township, as noted in the Original Field Notes for the Original Survey of T35N-R13E, 4th p.m.

Description of monument and accessories I established to perpetuate the location of this corner:

At the point determined for the location of the corner I emplaced a:


"GALVANIZED IRON PIPE, THREE FEET LONG, ONE INCH IN DIAMETER, WITH ALUMINUM CAP DENOTED AS: 'KIMBERLY-CLARK CORP T34-35N 35, 36, 1, 2, R13E SPERHAKE RLS 463 12-11-62".

The pipe is witnessed by:

- Hemlock 12 N68°E 35 links. (Scribed S36 NBT).
- Aspen 7 S32°E 18 links. (Scribed S 1 NBT).
- W. Birch 7 S23°W 70 links. (Scribed S 2 NBT).
- B. Cherry 4 N76°W 53½ links. (Scribed S35 NBT).


Description as to how corner was located:

No evidence of original corner present. Thus, set by proportionate measurement. To the east the 1/4 corner between 1 and 36 has been previously established. To the west, the corner common to 34, 35, 2, 3, has been previously established. The distance between the corners is 120.04 chains. Thus, set the corner of 35, 36, 1, 2, 40.01 chains east of the 1/4 between 36 and 1, on a straight line between the known corners.

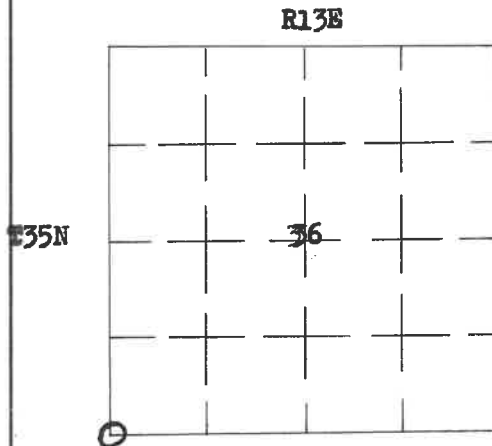

0 = Corner monument restored

REGISTER'S OFFICE
FOREST COUNTY, WIS.

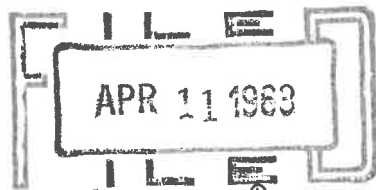

At 2 o'clock P.M.
Karl A. Unger Register of Deeds
Dep.

Dated at Crandon, Wis., this 11th day of April, 1963

Signature Neal Sperhake Title Registered Land Surveyor Registration No. S-463

~~Office of Registrar of Deeds~~, County of Forest, I hereby certify that the within instrument was ~~filed in this office for record~~ signed and sworn to on the 11th day of April, 1963

at o'clock M.

Adeline De Noble
Notary ~~(Registrar of Deeds)~~ Public
Forest County, Wisconsin My Commission Expires February 6, 1966
~~My~~ My commission expires February 6, 1966 Deputy

Surveyor's Seal

43513350000