

ESTABLISHMENT OF QUARTER - QUARTER SECTION CORNER BETWEEN ORIGINAL GOVERNMENT SURVEY CORNERS  
86991

Index No. 132  
724

STATE OF WISCONSIN

County of FOREST

This corner can also be described as either the "EAST 1/8 TH OR THE EAST QUARTER-QUARTER SECTION CORNER BETWEEN SECTIONS 1, T34N-R13E, AND, 36, T35N-R13E, 4TH P.M.

History:

There is no record of this corner having ever been previously established.

Description of monument and accessories I established to perpetuate the location of this corner:

At the point determined for the location of the corner I emplaced a:

"GALVANIZED IRON PIPE, THREE FEET LONG, ONE INCH IN DIAMETER, WITH AN ALUMINUM CAP DENOTED AS, 'KIMBERLY-CLARK CORP T34-35N E 1/16 BTWN 1 & 36 R13E SPERHAKE RLS 463 12-11-62".

The pipe is witnessed by:

- Y. Birch 5 N23°E 27½ links. (Scribed S36 BT).
- Maple 10 S 7°W 13 links. (Scribed S 1 BT).


Description as to how corner was located:

Since both the quarter section corner one quarter mile west, and the section corner one quarter mile east have been previously established, with a distance between them of 40.19 chains, the 1/16th corner was set 20.09½ chains from either corner, on a straight line between them.

I NEAL SPERHAKE, do hereby certify that on the ELEVENTH day of DECEMBER, 1962, I established the EAST ONE SIXTEENTH CORNER BETWEEN SECTIONS 1, TOWNSHIP 34 NORTH, RANGE 13 EAST, AND, 36, TOWNSHIP 35 NORTH, RANGE 13 EAST, Fourth Principal Meridian, as described hereon.


Resident Witnesses:

Richard Piontek - Waubesa.  
R13E

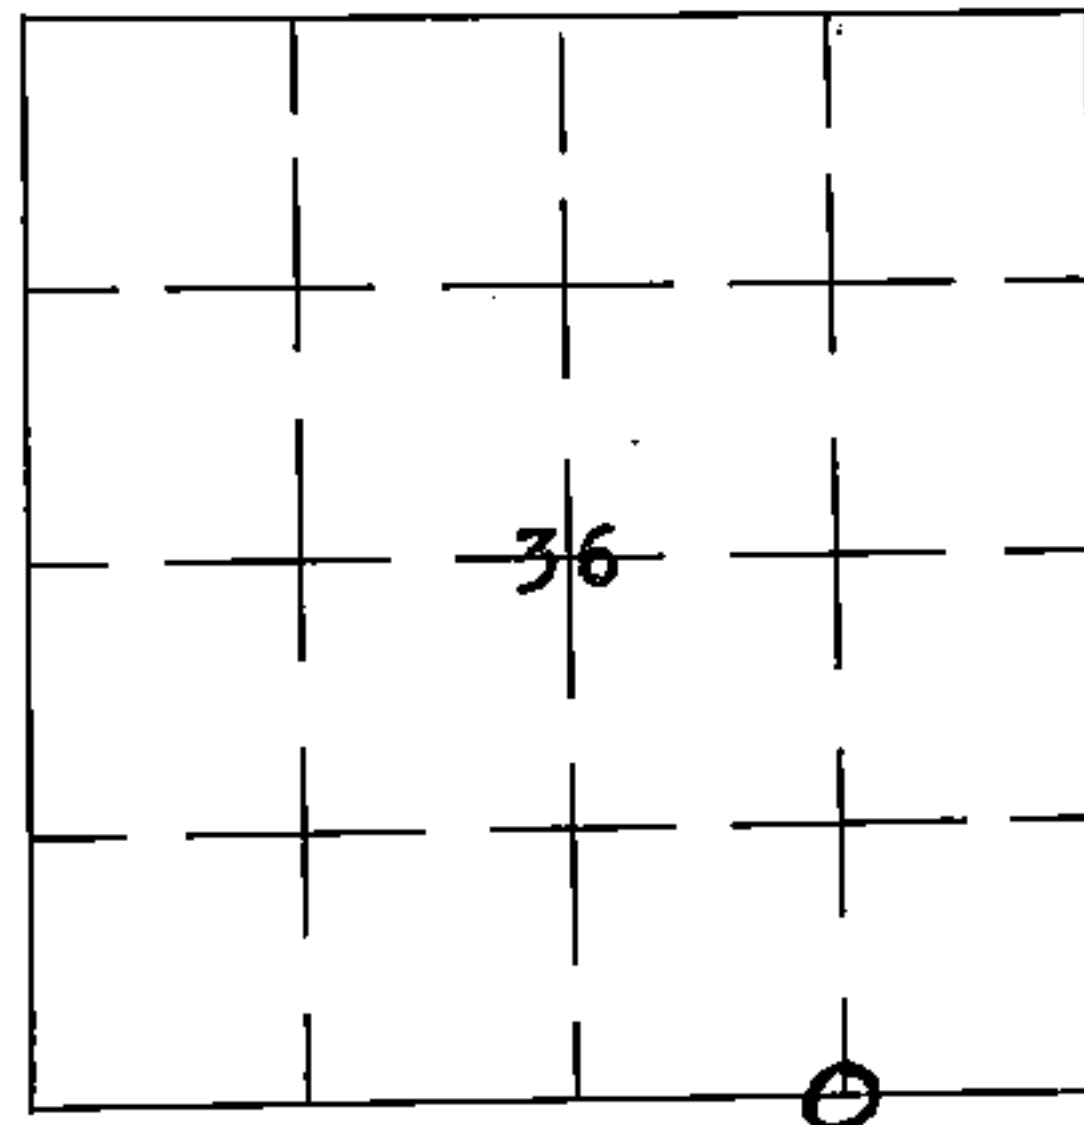

0 = Corner monument established

REGISTER'S OFFICE  
FOREST COUNTY, WIS.

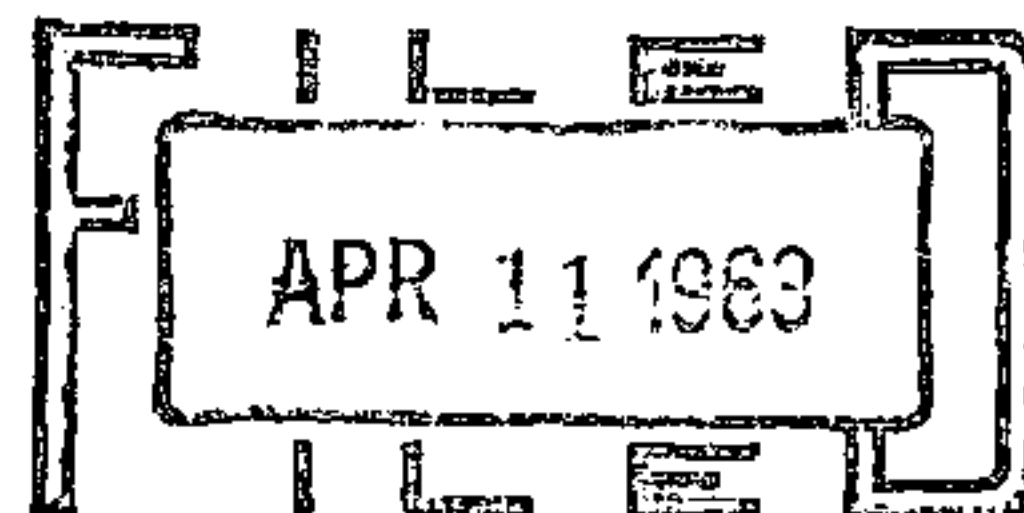

At 7 o'clock P.M.  
Karla A. Anger Register of Deeds

Dated at Crandon Wis., this 11th day of April, 19 63

Signature [Signature] Title Registered Land Surveyor Registration No. S-463

~~Office of Register of Deeds~~, County of Forest I hereby certify that the within signed and sworn to instrument was ~~filed in this office for records~~ on the 11th day of April, 19 63

~~at~~ at ~~at~~ at ~~at~~ at

Adeline De Noble  
Notary (Register of Deeds) Public  
Forest County, Wisconsin

My commission expires February 6, 1966

A 3513360010

Surveyor's Seal